

INDEX OF SHEETS

SEE SHEET 2


VAOT STANDARDS

SEE SHEET 2


STATEWIDE PARK-AND-RIDE SIGNAGE REPLACEMENT CMG PARK(34)

THIS PROJECT CONSISTS OF ADDING NEW SIGNS AND REPLACING VARIOUS SIGNS AT 26 STATE OWNED PARK-AND-RIDE FACILITIES.

PARK-AND-RIDES ARE LOCATED IN: BERLIN, BRADFORD, CAMBRIDGE, CHARLOTTE, COLCHESTER, EAST BARRE, FERRISBURGH, GEORGIA, HARTLAND, MANCHESTER, MIDDLESEX, MONTPELIER, MORRISVILLE, RANDOLPH, ROYALTON, RUTLAND AIRPORT (CLARENDON), SHARON, SOUTH BARRE, SPRINGFIELD, ST. ALBANS, ST. JOHNSBURY, THETFORD, WATERBURY, WEATHERSFIELD, WEST DANVILLE & WILLIAMSTOWN

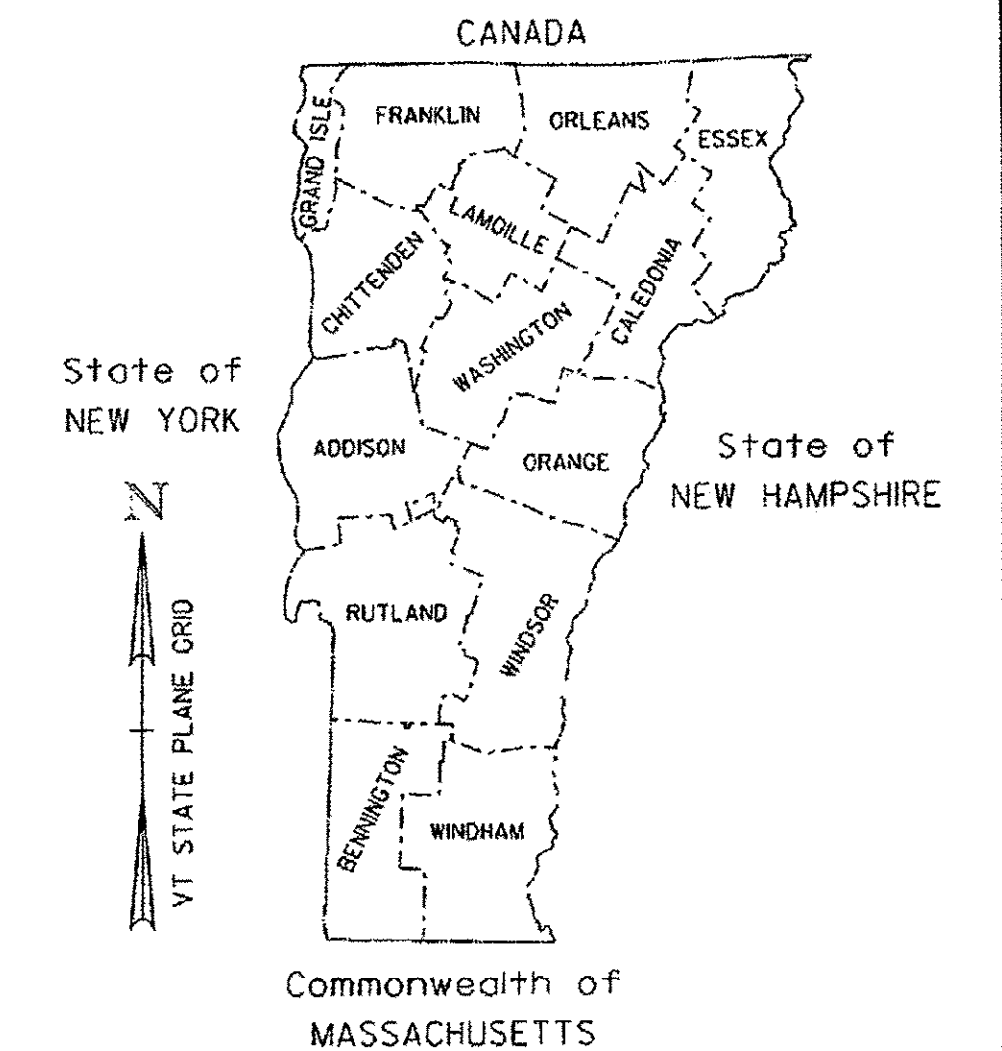

RECORD PLANS	
CONTRACTOR:	L&D SAFETY MARKINGS CORP.-BERLIN, VT
RESIDENT ENGINEER:	JEFF COTA
CONSTRUCTION BEGAN:	OCTOBER 8, 2012
CONSTRUCTION COMPLETE:	OCTOBER 31, 2012
RECORD PLANS BY:	JEFF COTA & JENNA HYDE
I HEREBY CERTIFY THAT ALL THE CONSTRUCTION REQUIRED BY THIS SET OF DRAWINGS HAS BEEN ACCOMPLISHED AS INDICATED HEREIN.	
BY _____	RESIDENT ENGINEER
DATE <u>4/23/14</u>	
NOTE: Any further information concerning final quantities, amounts or other details relative to this project may be found at Central Files in the electronic archives.	

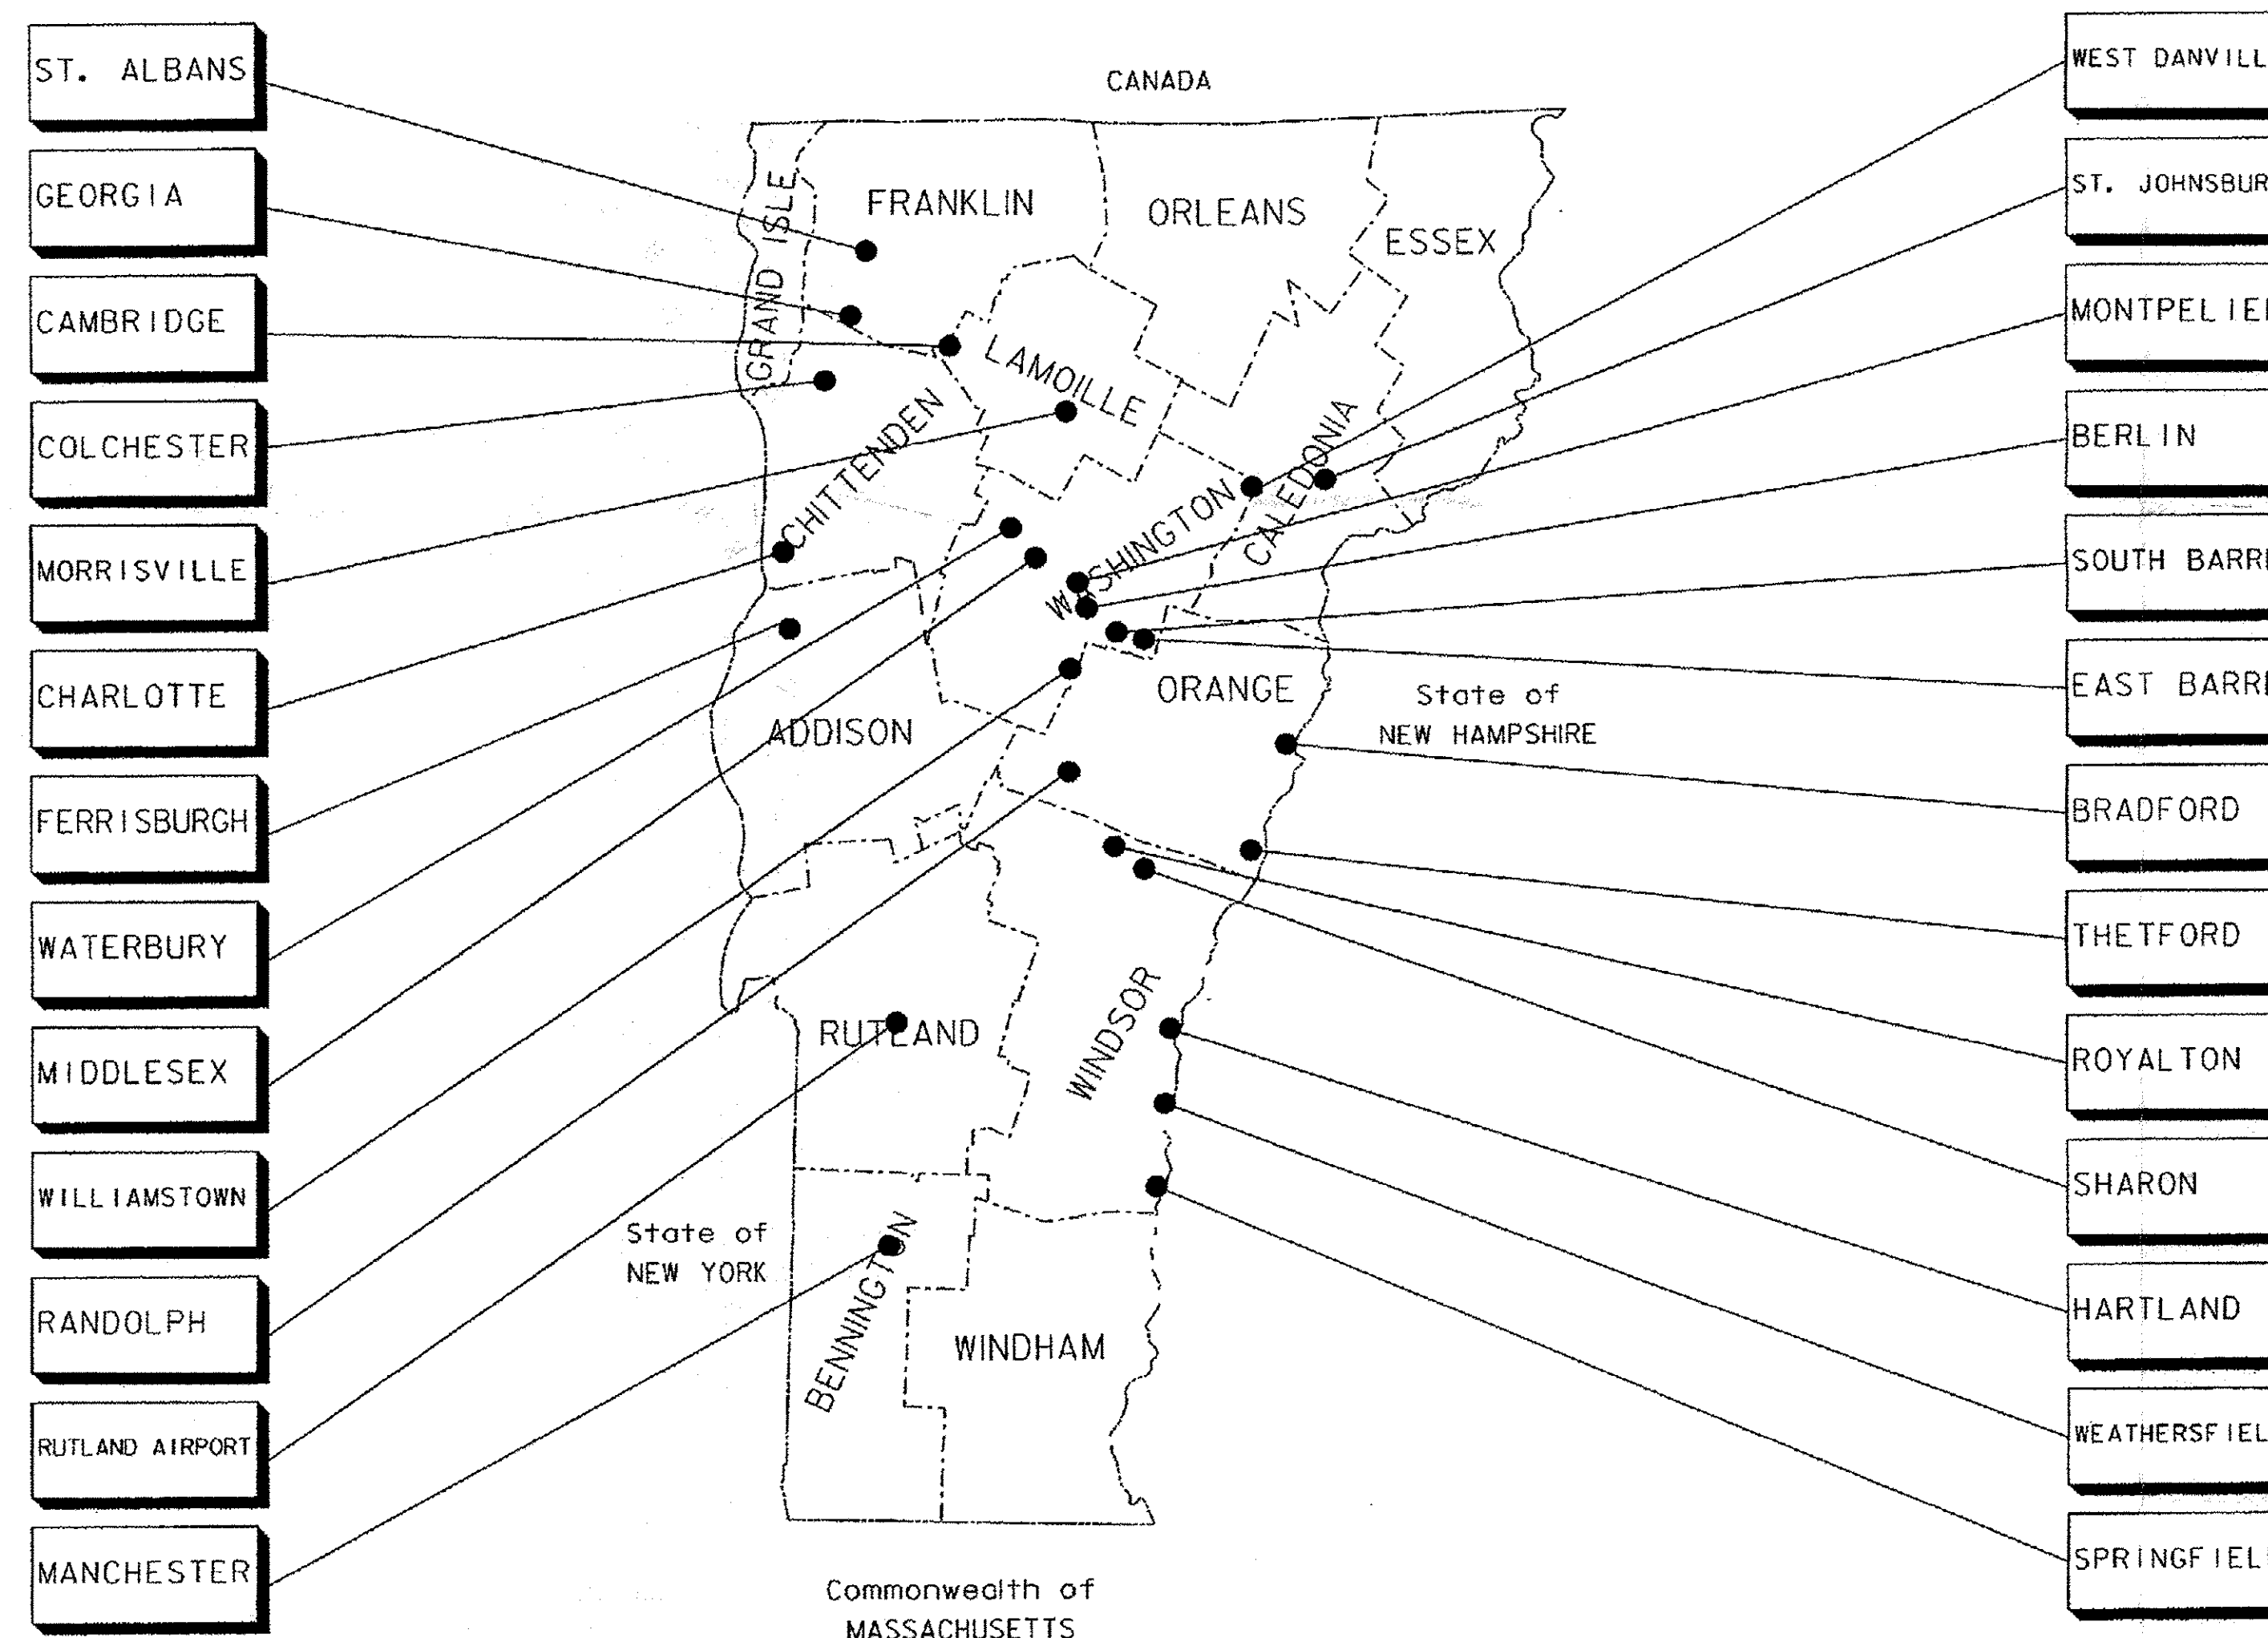

PROJECT LOCATIONS
NOT TO SCALE

QUALITY ASSURANCE PROGRAM: LEVEL 4

CONVENTIONAL SYMBOLS

COUNTY LINE	
TOWN LINE	
LIMITS OF ACCESS	
POINT OF ACCESS	
FENCE LINE	
STONE WALL	
TRAVELED WAY	
GUARD RAIL	
RAILROAD	
SURVEY LINE	
CULVERT	
POWER POLE	
TELEPHONE POLE	
TREES	
CONTROL OF ACCESS	
PROPERTY LINE	
R.O.W. TAKING LINE	
SLOPE RIGHTS	
TOP OF CUT	
TOE OF SLOPE	

SURVEYED BY : N/A
SURVEYED DATE : N/A

DATUM
VERTICAL N/A
HORIZONTAL N/A

Stantec
Stantec Consulting Services Inc.
55 Green Mountain Drive
South Burlington VT U.S.A. 05403
Tel. 802.864.0223
Fax. 802.864.0165
www.stantec.com

THESE PLANS ARE SUBJECT TO SUCH ENGINEERING CHANGES AS MAY BE REQUIRED BY THE FEDERAL HIGHWAY ADMINISTRATION OR THE DIRECTOR OF PROGRAM DEVELOPMENT.
CONSTRUCTION IS TO BE CARRIED ON IN ACCORDANCE WITH THESE PLANS AND THE STANDARD SPECIFICATIONS FOR CONSTRUCTION DATED 2011, AS APPROVED BY THE FEDERAL HIGHWAY ADMINISTRATION ON JULY 20, 2011 FOR USE ON THIS PROJECT, INCLUDING ALL SUBSEQUENT REVISIONS AND SUCH REVISED SPECIFICATIONS AND SPECIAL PROVISIONS AS ARE INCORPORATED IN THESE PLANS.

DIRECTOR OF PROGRAM DEVELOPMENT	
APPROVED	DATE <u>6-27-12</u>
PROJECT MANAGER : WAYNE DAVIS	
PROJECT NAME : STATEWIDE	
PROJECT NUMBER : CMG PARK (34)	
SHEET 1 OF 69 SHEETS	

