


675.50 REMOVING SIGNS

AS SHOWN - 11

675.60 ERECTING SALVAGED SIGNS

AS SHOWN - 4

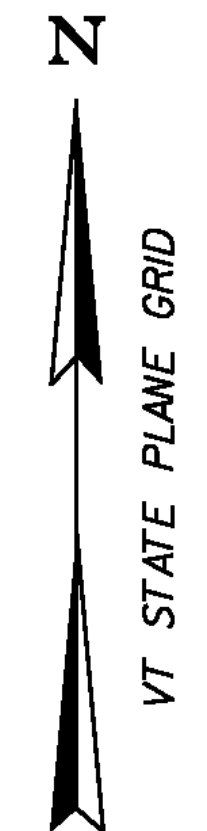

CARPOOL INFO
 VERMONT
 Connecting Communities
 1-800-685-NECK (74328)

LOCATE NEW SIGN NEAR THE NORTHWEST CORNER OF THE PARK-AND-RIDE FACING TOWARD THE LOT ENTRANCE.

SIGN LEGEND

N = NEW
 R = REMOVE
 R&S = REMOVE AND SALVAGE
 S = SALVAGE SIGN
 RET = RETAIN
 B-B = BACK TO BACK

- NOTES:**
1. ALL EXISTING SIGNS NOT SHOWN SHALL BE RETAINED, REMOVED OR REPLACED AS DIRECTED BY THE RESIDENT ENGINEER.
 2. ALL SIGN LOCATIONS SHOWN ON THESE PLANS ARE APPROXIMATE, TRUE LOCATIONS TO BE VERIFIED IN THE FIELD.
 3. EXISTING SIGN LOCATION MAY BE MODIFIED TO INCREASE VISIBILITY OR EFFECTIVENESS AT THE DISCRETION OF THE RESIDENT ENGINEER.
 4. PLACE SALVAGED BUS STOP SIGN AND BUS SCHEDULE ON A NEW POST ON THE NORTH SIDE OF THE BUS SHELTER FACING EAST.

WATERBURY PARK-AND-RIDE
 NOT TO SCALE

PROJECT NAME: STATEWIDE
 PROJECT NUMBER: CMG PARK(34)
 FILE NAME: ...\\Plot Files\\Waterbury_ptf.dgn PLOT DATE: 6/21/2012
 PROJECT LEADER: G. GOYETTE DRAWN BY: E. ALLING
 DESIGNED BY: E. ALLING CHECKED BY: G. GOYETTE
WATERBURY SHEET 35 OF 69

