

INDEX OF SHEETS

- 1 TITLE SHEET
- 2 CRACK SEALING TYPICAL
- 3 QUANTITY SHEET
- 4 LOCATION LAYOUT
- 5 CRACK SEALING LOCATION DETAIL
- 6 - 13 INTERCHANGE DETAIL SHEETS
- 14 CRACK SEALING CONTROL SECTION DETAIL SHEET

STANDARDS


E-100	CONSTRUCTION APPROACH SIGNS	01/02/04
E-101	CONSTRUCTION SIGN DETAIL	05/30/03
E-102A	CONSTRUCTION SIGN DETAIL	05/01/04
E-102	CONSTRUCTION SIGN DETAIL	06/30/03
E-103	MAINLINE TRAFFIC CONTROL, DIVIDED HIGHWAY ONE LANE CLOSED	03/01/04
E-105	TRAFFIC CONTROL FOR CONSTRUCTION VEHICLE U-TURNS ON DIVIDED HIGHWAY	05/01/04
E-106	TRAFFIC CONTROL MISCELLANEOUS DETAILS	03/01/04
E-110	MAJOR MAINTENANCE OPERATION LANE CLOSURE	08/08/95

STATE OF VERMONT AGENCY OF TRANSPORTATION



PROPOSED IMPROVEMENT STATEWIDE CRACK SEALING


WORK TO BE PERFORMED UNDER THIS PROJECT INCLUDES THE ROUTING AND SEALING OF CRACKS IN BITUMINOUS CONCRETE PAVEMENT ON EXISTING STATE, U.S., AND INTERSTATE HIGHWAYS AND THE APPROPRIATE TRAFFIC CONTROL.

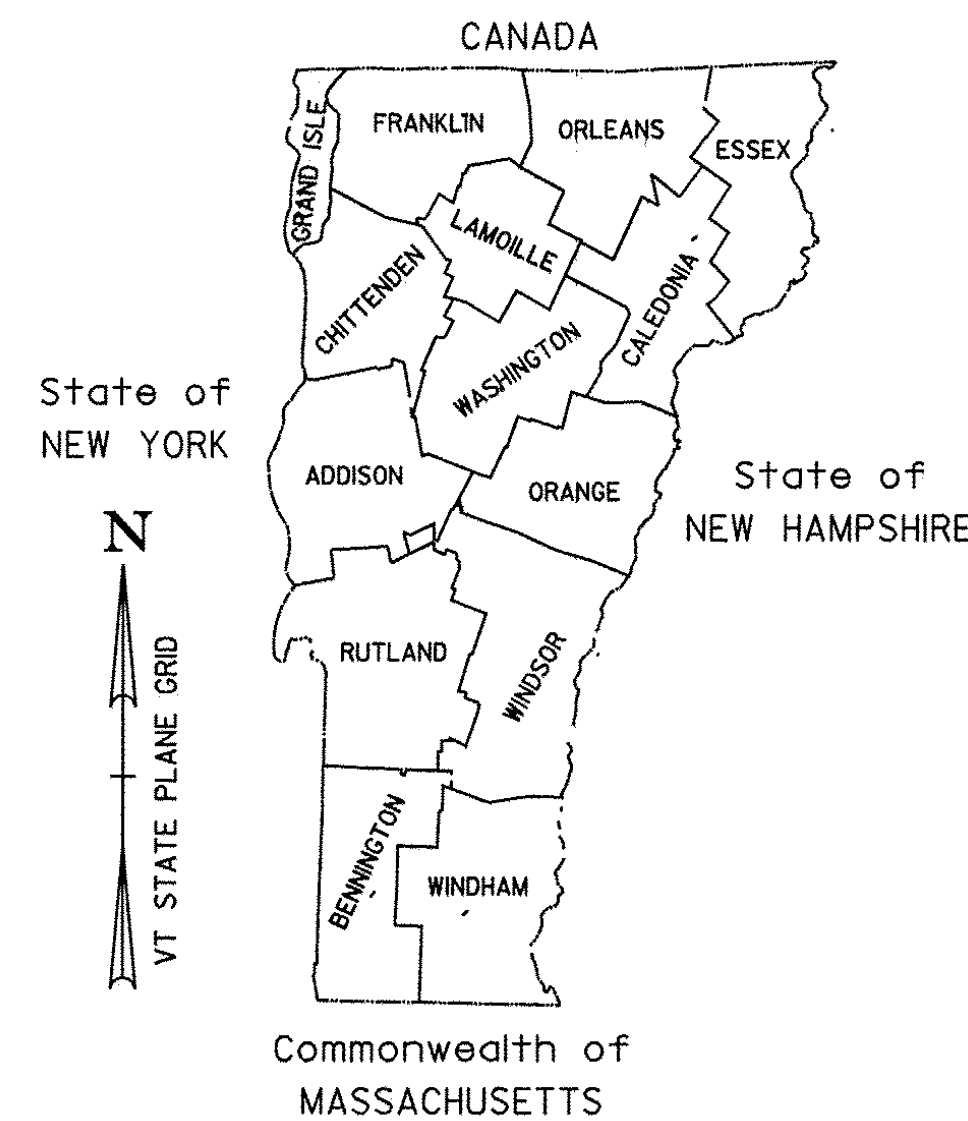

RECORD PLANS


CONTRACTOR: ANNSEAL, INC. - BIBLE SCHOOL PARK, NY
 RESIDENT ENGINEER: AL JONES
 CONSTRUCTION BEGAN: JUNE 21, 2010
 CONSTRUCTION COMPLETE: AUGUST 9, 2010
 RECORD PLANS BY: AL JONES & AMOS KEMPTON
 I HEREBY CERTIFY THAT ALL THE CONSTRUCTION REQUIRED BY THIS SET OF DRAWINGS HAS BEEN ACCOMPLISHED AS INDICATED HEREIN.
 BY al jones RESIDENT ENGINEER
 DATE 7/29/11

NOTE: Any further information concerning final quantities, amounts or other details relative to this project may be found at Central Files in the electronic archives.

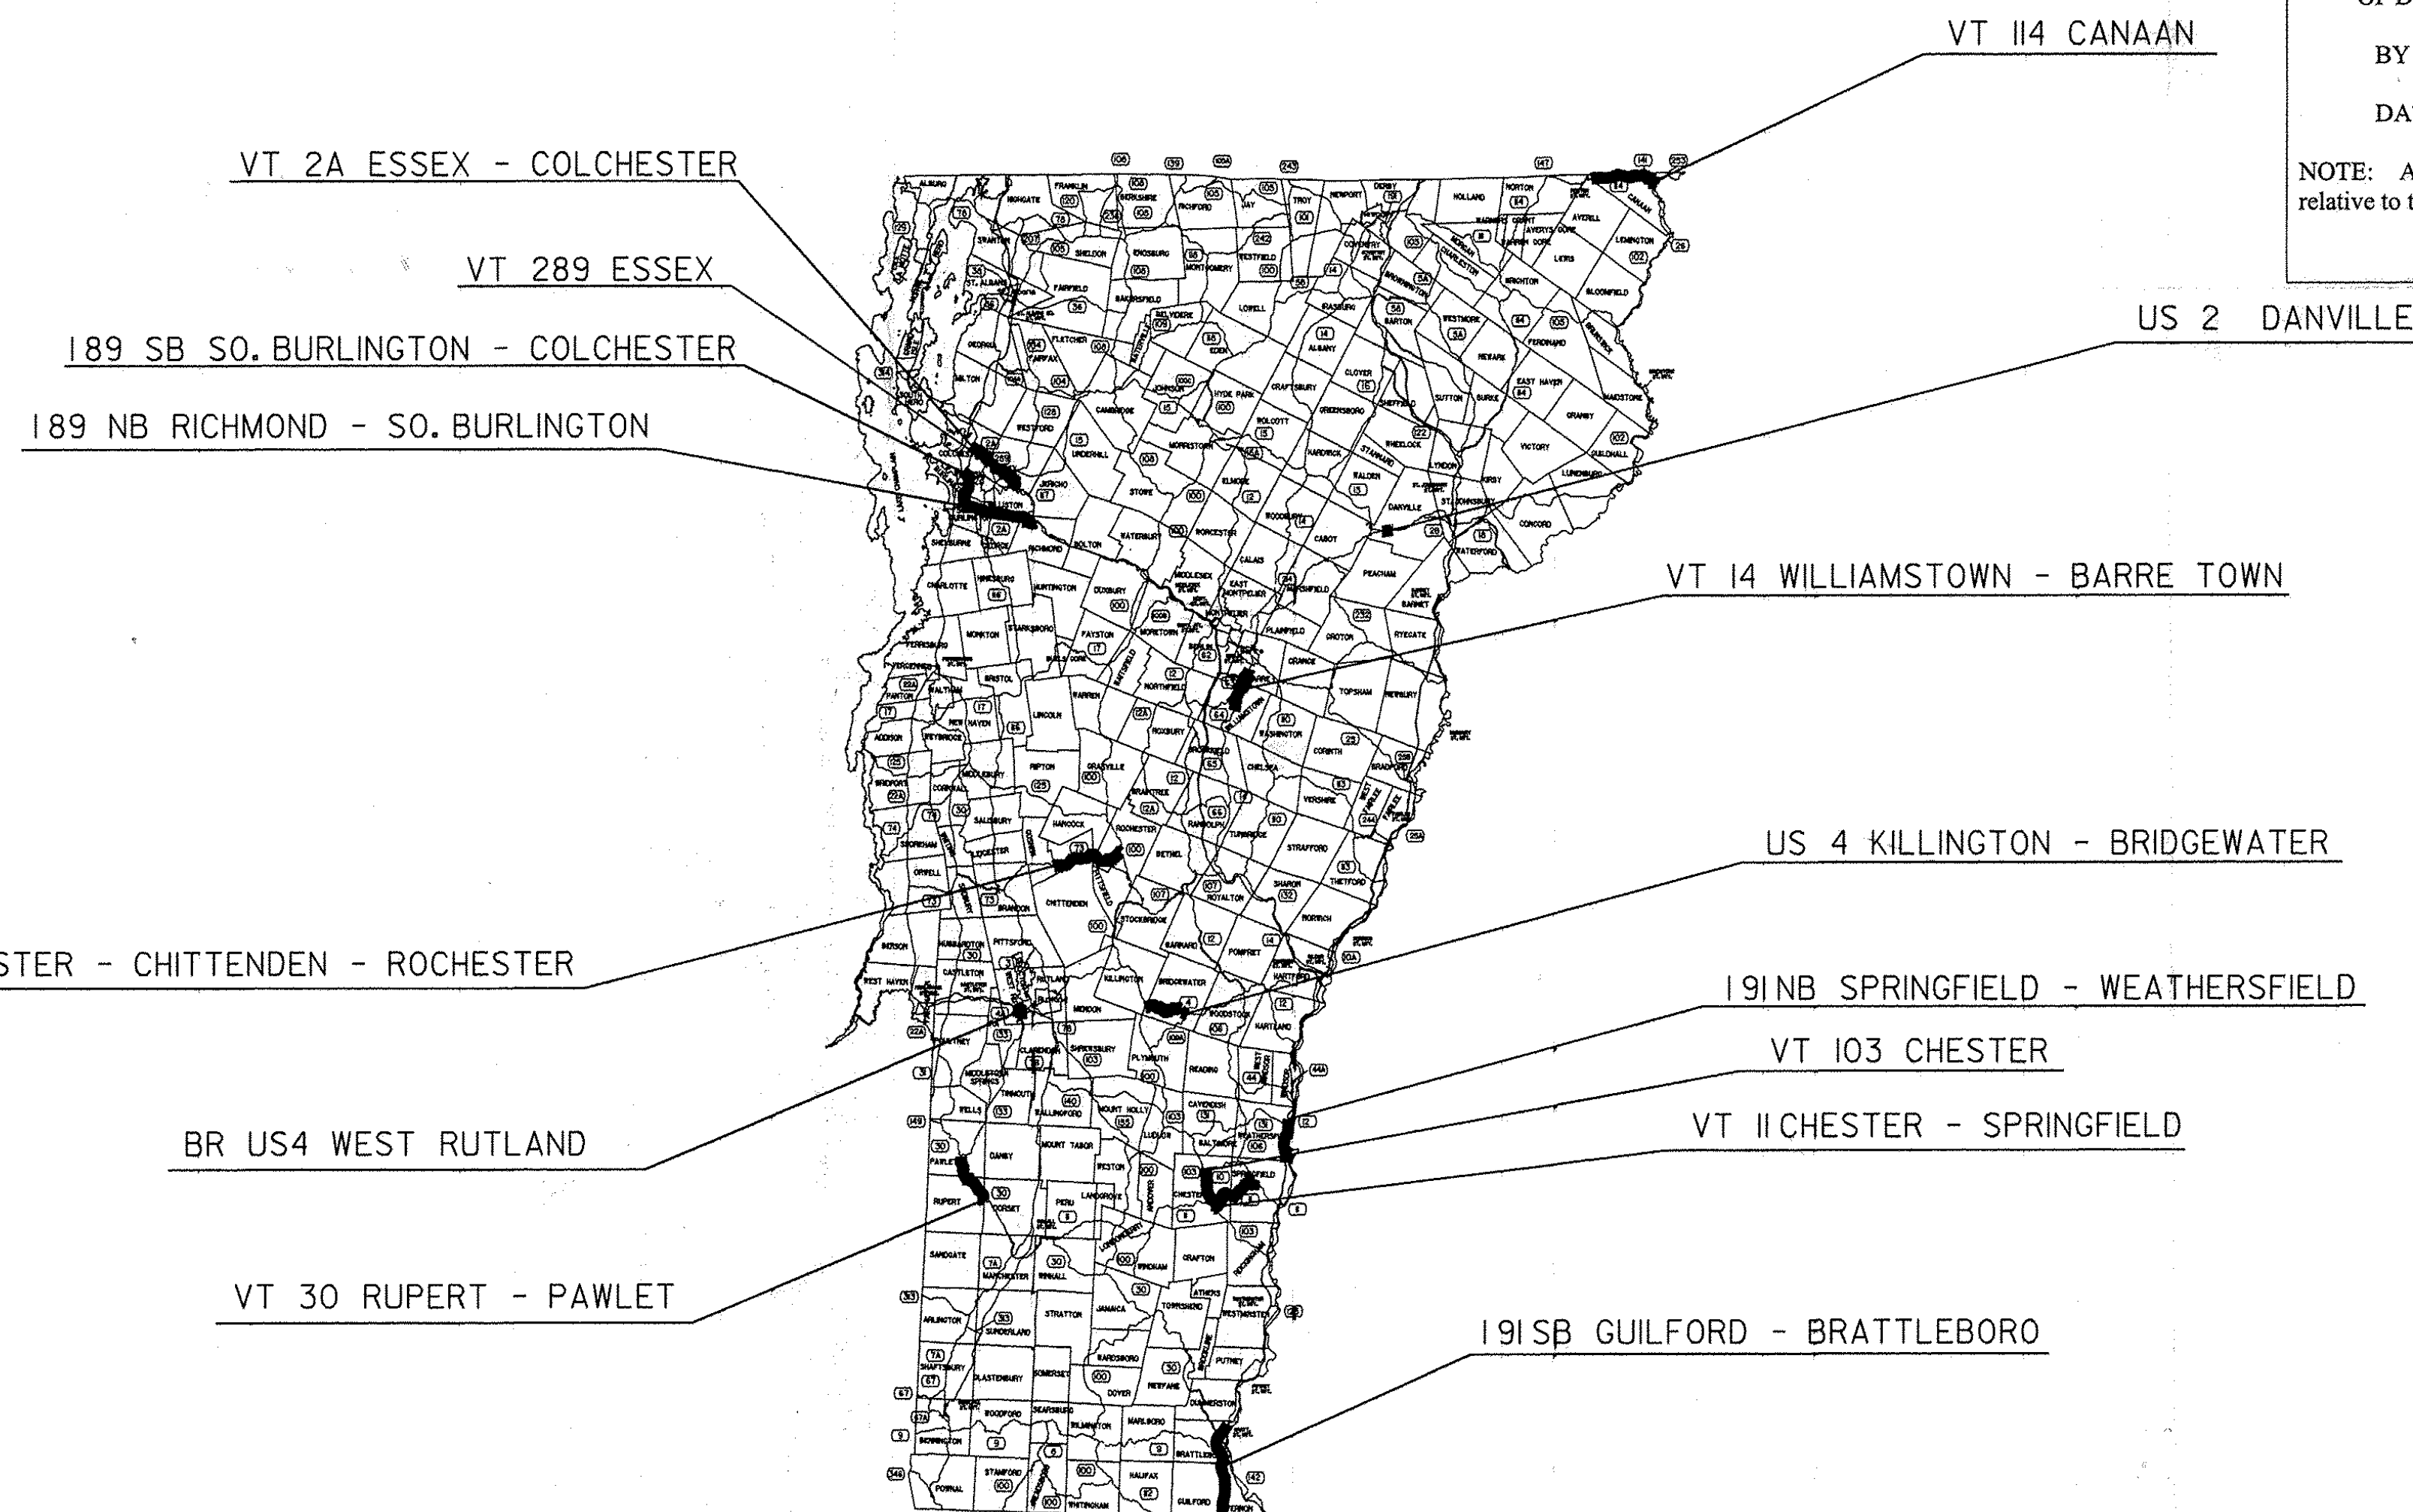

CONVENTIONAL SYMBOLS

COUNTY LINE	——— COUNTY LINE ———
TOWN LINE	——— TOWN LINE ———
LIMITS OF ACCESS	—○—○—○—○—
POINT OF ACCESS	X
FENCE LINE	X — X — X — X —
STONE WALL	○ ○ ○ ○ ○ ○ ○ ○ ○ ○
TRAVELED WAY	———
GUARD RAIL	———
RAILROAD	———
SURVEY LINE	———
CULVERT	———
POWER POLE	⊠
TELEPHONE POLE	⊠
TREES	⊠
CONTROL OF ACCESS	———
PROPERTY LINE	———
R.O.W. TAKING LINE	———
SLOPE RIGHTS	SR
TOP OF CUT	△
TOE OF SLOPE	○

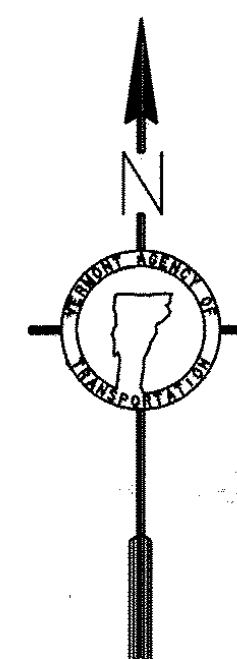

SURVEYED BY : N/A
 SURVEYED DATE : N/A

DATUM
 VERTICAL N/A
 HORIZONTAL N/A



THESE PLANS ARE SUBJECT TO SUCH ENGINEERING CHANGES AS MAY BE REQUIRED BY THE FEDERAL HIGHWAY ADMINISTRATION OR THE DIRECTOR OF PROGRAM DEVELOPMENT.
 CONSTRUCTION IS TO BE CARRIED ON IN ACCORDANCE WITH THESE PLANS AND THE STANDARD SPECIFICATIONS FOR CONSTRUCTION DATED 2006, AS APPROVED BY THE FEDERAL HIGHWAY ADMINISTRATION ON JUNE 15, 2006 FOR USE ON THIS PROJECT, INCLUDING ALL SUBSEQUENT REVISIONS AND SUCH REVISED SPECIFICATIONS AND SPECIAL PROVISIONS AS ARE INCORPORATED IN THESE PLANS.

DIRECTOR OF PROGRAM DEVELOPMENT
 APPROVED [Signature] DATE 2-25-10
 PROJECT MANAGER : MIKE FOWLER
 PROJECT NAME : STATEWIDE
 PROJECT NUMBER : STP CRACK (28)
 SHEET 1 OF 14 SHEETS