


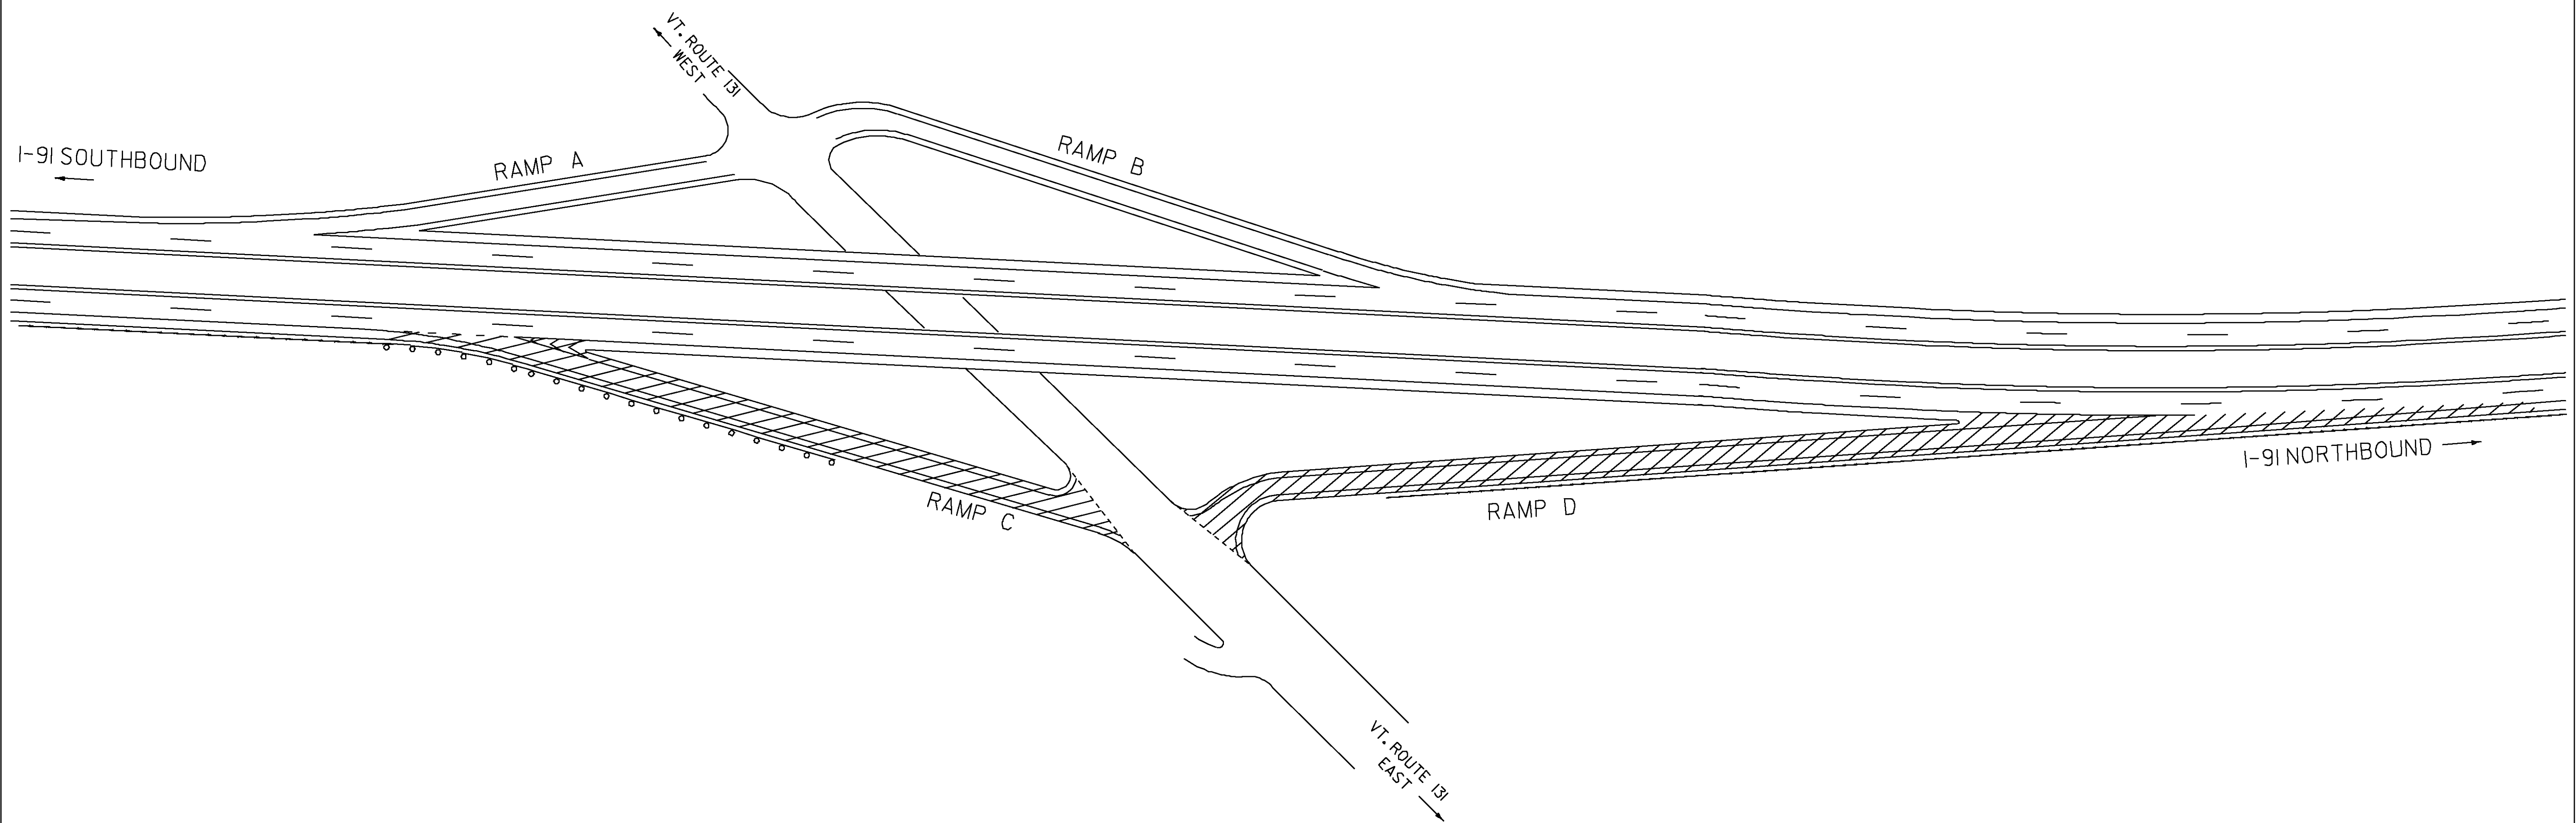


ASCUTNEY INTERCHANGE #8

I-91

NOT TO SCALE

RAMPS REQUIRING CRACK SEALING

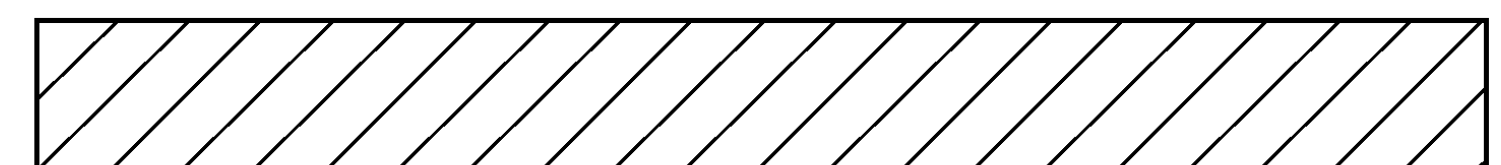

INTERCHANGE
DETAIL
SHEET # 1

PROJECT NAME: STATEWIDE
PROJECT NUMBER: STP CRAK(28)

FILE NAME: p09k336.dgn
PROJECT LEADER: FOWLER
DESIGNED BY: LOCKE
p09k336Int1.i

PLOT DATE: 26-FEB-2010
DRAWN BY: LOCKE
CHECKED BY: PAVT MGMT
SHEET 6 OF 14