


WILLISTON INTERCHANGE #12
I-89

NOT TO SCALE

RAMPS REQUIRING CRACK SEALING

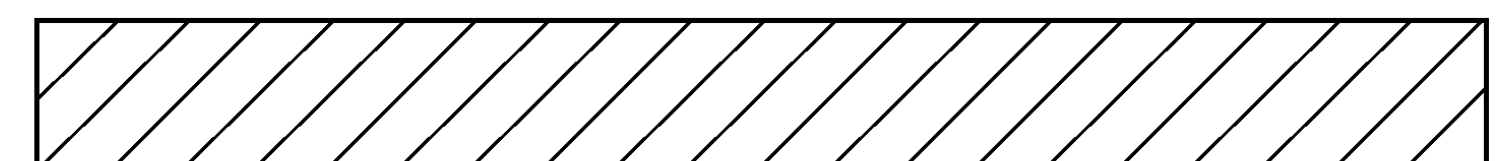

INTERCHANGE
DETAIL
SHEET # 5

PROJECT NAME: STATEWIDE
PROJECT NUMBER: STP CRAK(28)

FILE NAME: p09k336.dgn
PROJECT LEADER: FOWLER
DESIGNED BY: LOCKE
p09k336Int5.1

PLOT DATE: 26-FEB-2010
DRAWN BY: LOCKE
CHECKED BY: PAVT MGMT
SHEET 10 OF 14