


STATE OF VERMONT AGENCY OF TRANSPORTATION

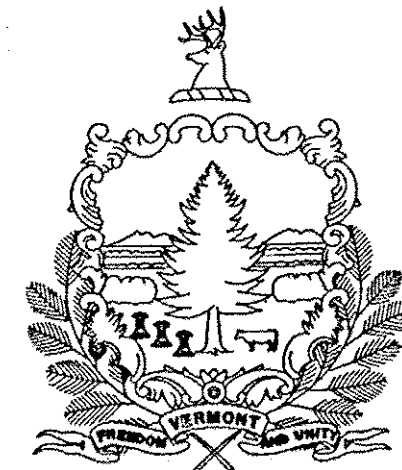

PROPOSED IMPROVEMENT TOWNS OF ST ALBANS, SWANTON, SHELDON, ENOSBURG AND BERKSHIRE COUNTY OF FRANKLIN VERMONT ROUTE 105



SIGN REPLACEMENT - 25.730 MILES ON VT 105 BEGINNING AT ST. ALBANS TOWN M.P. 0.000 EXTENDING
EASTERLY TO BERKSHIRE M.P. 3.700 INCLUDING 1,040 MILES OF ENOSBURG
CLASS I TOWN HIGHWAY

LENGTH OF ROADWAY = 25.730 MILES
LENGTH OF PROJECT = 25.730 MILES

WORK TO BE PERFORMED UNDER THIS PROJECT INCLUDES THE REMOVAL OF EXISTING SIGNS AND POSTS
AND THE INSTALLATION OF NEW SIGNS AND SIGN POSTS AND INCIDENTAL ITEMS.

INDEX OF SHEETS
SEE SHEET 2

RECORD PLANS	
CONTRACTOR:	F. R. LAFAYETTE, INC. - ESSEX JUNCTION, VT
RESIDENT ENGINEER:	JEFF COTA
CONSTRUCTION BEGAN:	AUGUST 17, 2011
CONSTRUCTION COMPLETE:	JANUARY 10, 2012
RECORD PLANS BY:	JEFF COTA & JENNA HYDE
I HEREBY CERTIFY THAT ALL THE CONSTRUCTION REQUIRED BY THIS SET OF DRAWINGS HAS BEEN ACCOMPLISHED AS INDICATED HEREIN.	
BY _____	RESIDENT ENGINEER
DATE <u>10/15/12</u>	
NOTE: Any further information concerning final quantities, amounts or other details relative to this project may be found at Central Files in the electronic archives.	

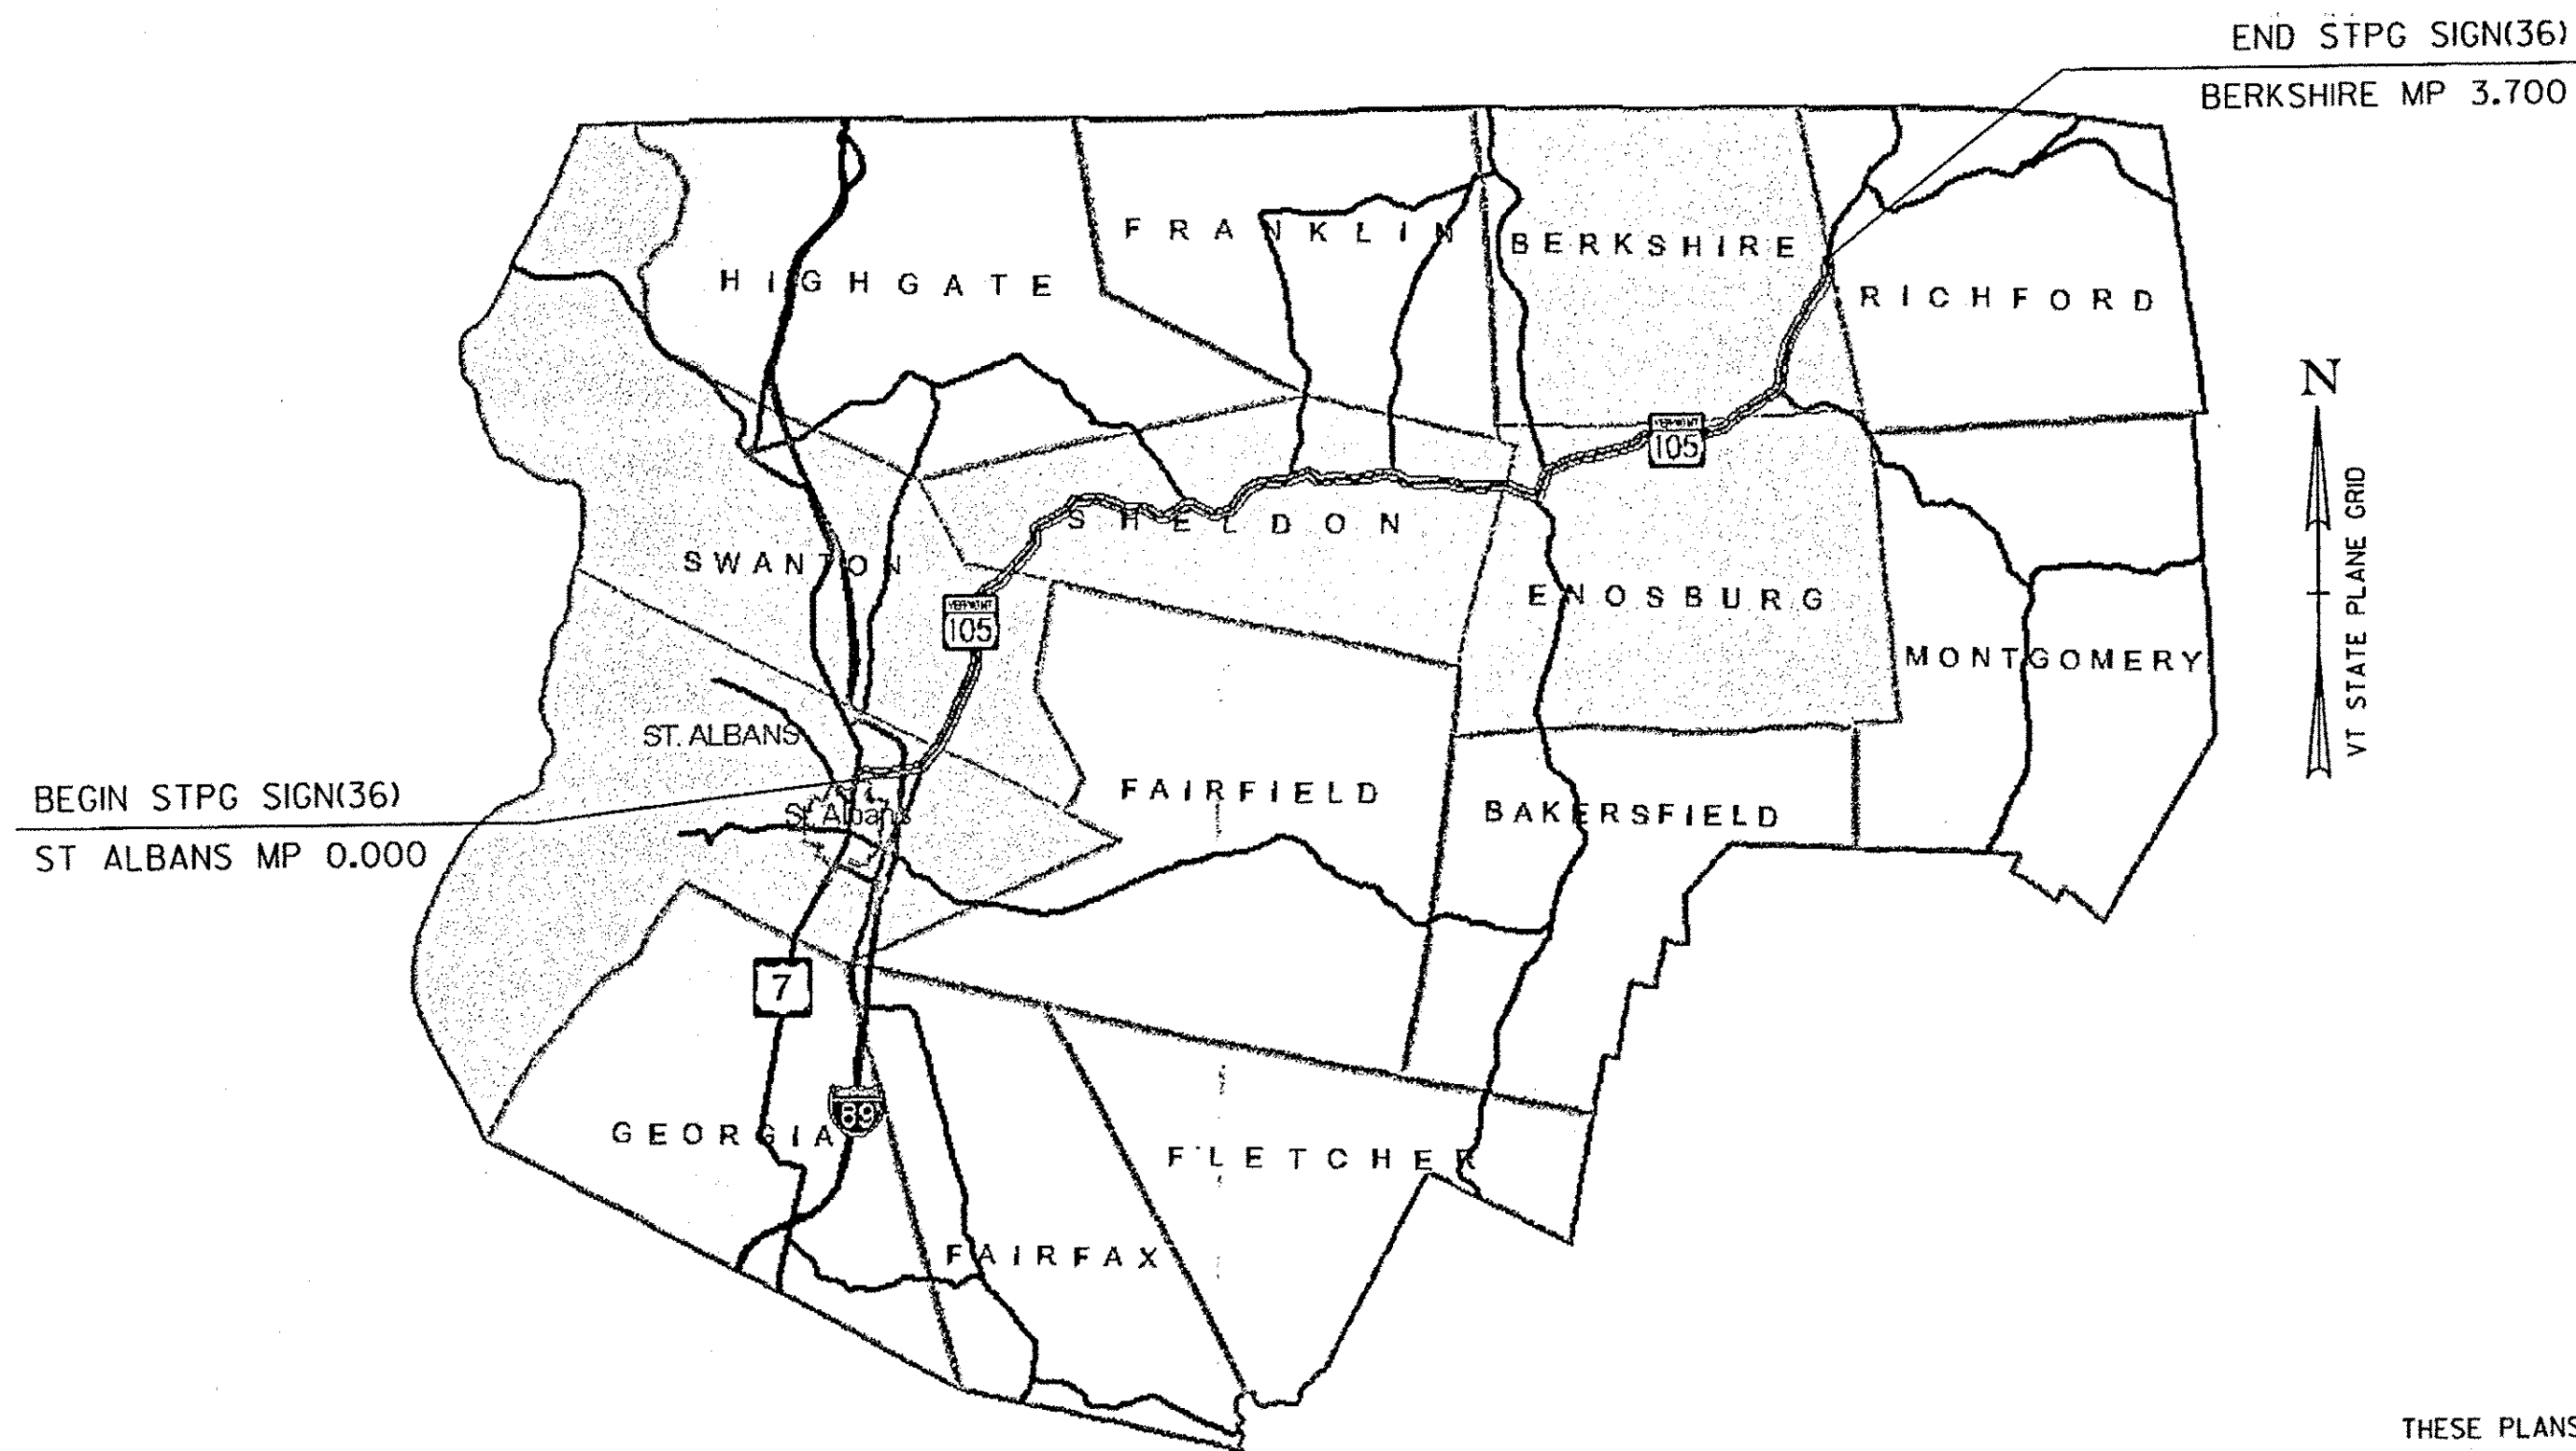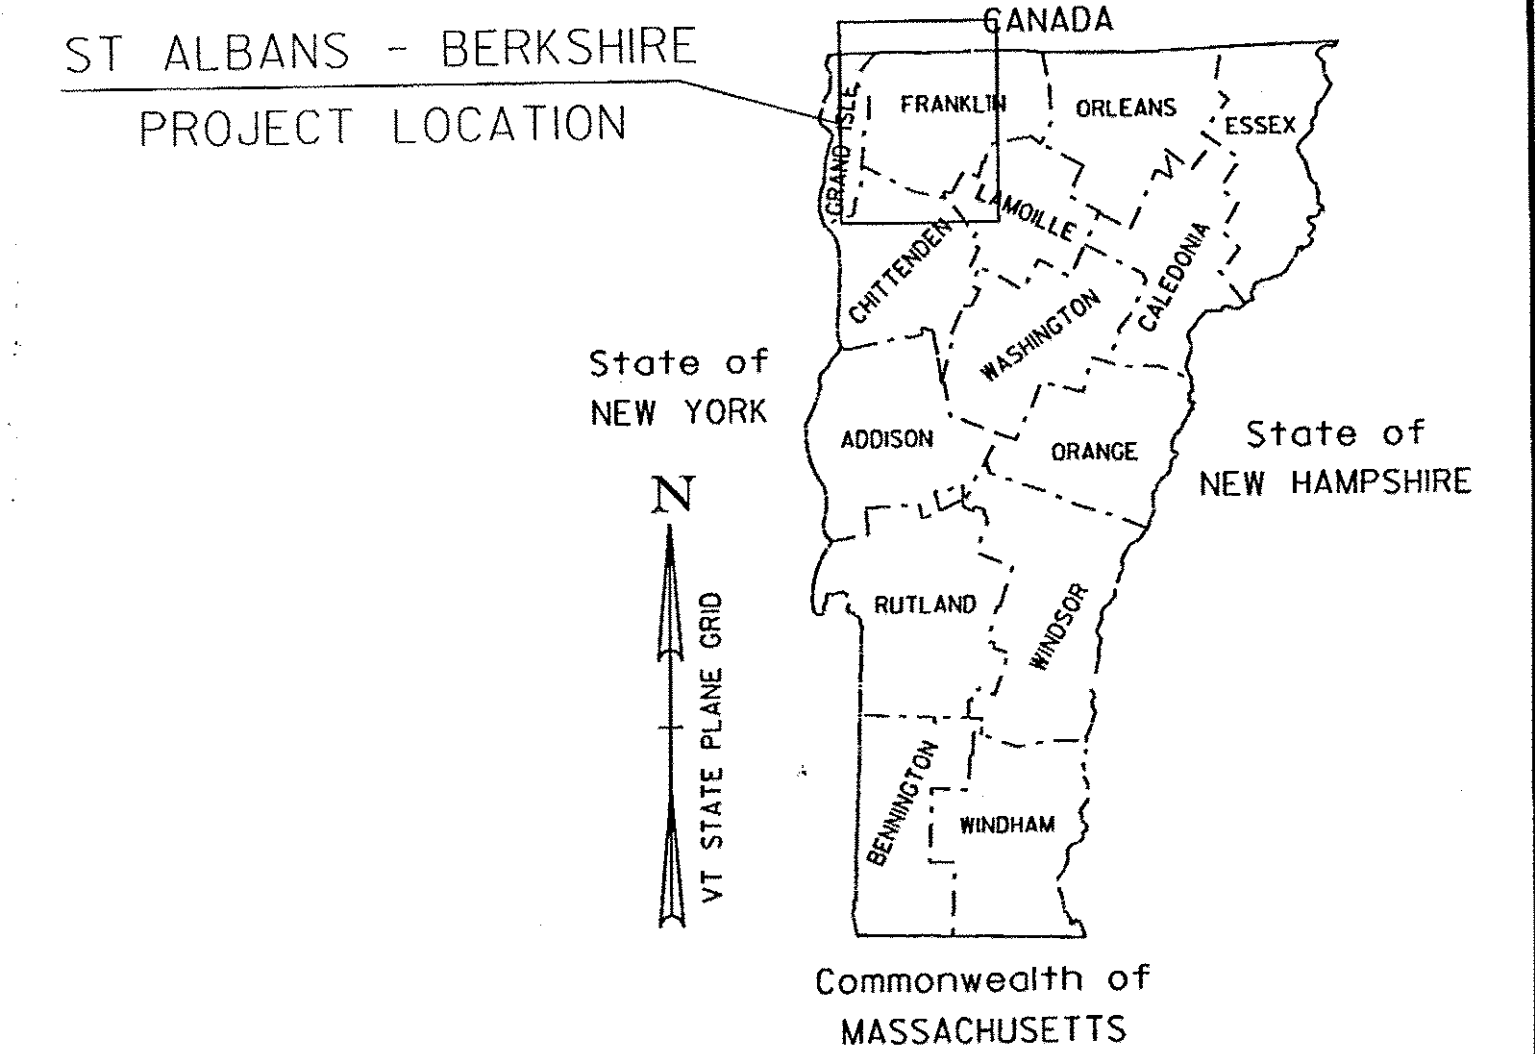

QUALITY ASSURANCE PROGRAM: LEVEL 3

CONVENTIONAL SYMBOLS	
COUNTY LINE	
TOWN LINE	
LIMITS OF ACCESS	
POINT OF ACCESS	
FENCE LINE	
STONE WALL	
TRAVELED WAY	
GUARD RAIL	
RAILROAD	
SURVEY LINE	
CULVERT	
POWER POLE	
TELEPHONE POLE	
TREES	
CONTROL OF ACCESS	
PROPERTY LINE	
R.O.W. TAKING LINE	
SLOPE RIGHTS	
TOP OF CUT	
TOE OF SLOPE	

SURVEYED BY :	N/A
SURVEYED DATE :	N/A
DATUM	
VERTICAL	N/A
HORIZONTAL	N/A

NOT TO SCALE

THESE PLANS ARE SUBJECT TO SUCH ENGINEERING CHANGES AS MAY BE REQUIRED BY THE FEDERAL HIGHWAY ADMINISTRATION OR THE DIRECTOR OF PROGRAM DEVELOPMENT.
CONSTRUCTION IS TO BE CARRIED ON IN ACCORDANCE WITH THESE PLANS AND THE STANDARD SPECIFICATIONS FOR CONSTRUCTION DATED 2006, AS APPROVED BY THE FEDERAL HIGHWAY ADMINISTRATION ON JUNE 15, 2006 FOR USE ON THIS PROJECT, INCLUDING ALL SUBSEQUENT REVISIONS AND SUCH REVISED SPECIFICATIONS AND SPECIAL PROVISIONS AS ARE INCORPORATED IN THESE PLANS.

DIRECTOR OF PROGRAM DEVELOPMENT	
APPROVED	DATE <u>5-24-11</u>
PROJECT MANAGER :	AMY GAMBLE
PROJECT NAME :	ST. ALBANS - BERKSHIRE
PROJECT NUMBER :	STPG SIGN (36)
SHEET 1 OF 109 SHEETS	