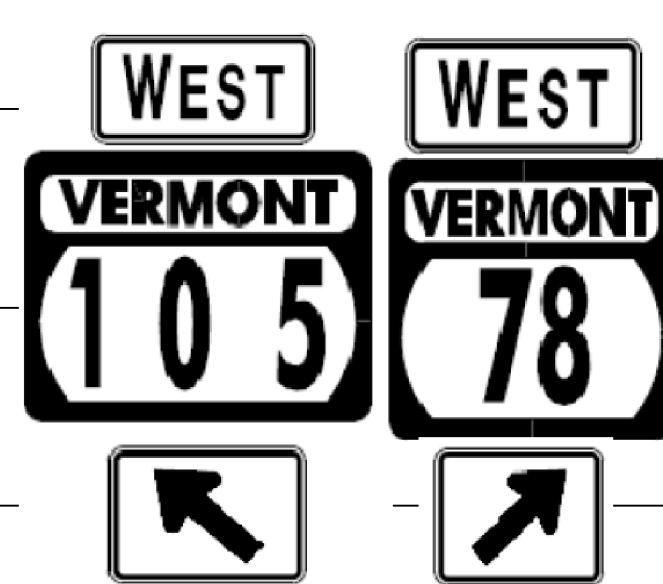

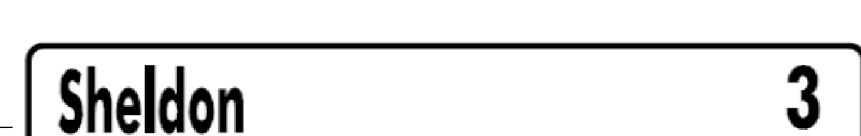
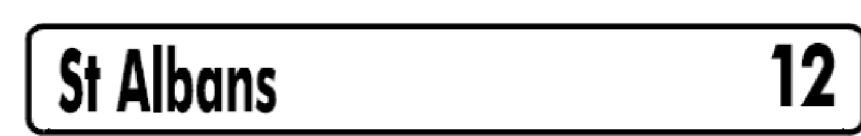



DIRECTION	MILEPOINT	LOCATION CODE (SHEET 2)	SIGN CODE	WIDTH (IN)	HEIGHT (IN)	SHEETING REMARKS	SIGN LEGEND	NEW SIGNS		EXISTING SIGNS				EXIST POST		NUMBER OF NEW POSTS	SQUARE STEEL (IN)			TUBULAR STEEL Ø (IN)				SIGN FRAME REQUIRED	REMARKS	SIGN DETAIL LOCATION			
								"A"	"B"	RETAIN	SALVAGE FROM	SALVAGE TO	REMOVE	RETAIN	REMOVE		1.75	2.00	2.50	FOUNDATION	3.00	3.50	4.00			5.00	SHSM	PROJECT SHEET #	STANDARD SHEET #
																	(LB / FT)				(LB / FT)								
<b>SHELDON VT105 WB</b>							FY-FLUORESCENT YELLOW FYG-FLUORESCENT YELLOW GREEN																"SHSM"-STANDARD HIGHWAY SIGNS AND MARKINGS						
		F	M3-4	24	12			2.00							2		X						#2A	GREEN ON WHITE	X				
		F	M1-5	30	24			5.00																		E-136B			
		F	M6-2L	21	15			2.19																	GREEN ON WHITE	X			
		F	M3-4	24	12			2.00																	GREEN ON WHITE	X			
		F	M1-5	24	24			4.00																			E-136B		
		F	M6-2R	21	15			2.19																	GREEN ON WHITE	X			
WB	4.410	F	R2-1	24	30								1		X														
		F	R2-1	24	30			5.00							1		X									X			
WB	4.320	F	M3-4	24	12																								
		F	M1-5	30	24																								
		F	VD2-1	72	12			6.00							2			X							INSTALL ON 2 1/2" SLIP BASES		4		
		F	VD2-1	72	12			6.00																			4		
		F	M3-4	24	12			2.00																	INSTALL ON LEFT POST. GREEN ON WHITE	X			
		F	M1-5	30	24			5.00																			E-136B		
WB	4.300	F	RL-90	24	24		BICYCLE					1		X															
<b>SIGN SUMMARY SHEET</b>							SHEET TOTALS		41.38	0.00	1	0	0	3	0	0	5	75.0	0	0.0	<del>0.0</del> 2.0	0.0	0.0	PROJECT NAME: <b>St Albans - Berkshire</b> PROJECT NUMBER: <b>STPG SIGN(36)</b>					
VERMONT AGENCY OF TRANSPORTATION							TOWN DIRECTIONAL TOTALS		488.5	0.0	48	7	7	103	0	0	81	1215.0	0	0.0				FILE NAME: <b>SheldonWB.xls</b> PLOT DATE: <b>5/17/2011</b> PROJECT MANAGER: <b>A. Gamble</b> DRAWN BY: <b>T. Guazzoni</b> DESIGNED BY: <b>T. Guazzoni</b> CHECKED: <b>A. Gamble</b> SHELDON WB SHEET 10 SHEET <b>58</b> OF <b>109</b>					