

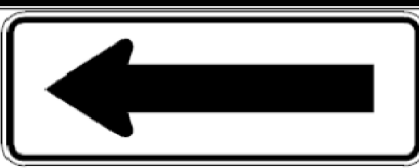






DIRECTION	MILEPOINT	LOCATION CODE (SHEET 2)	SIGN CODE	WIDTH (IN)	HEIGHT (IN)	SHEETING REMARKS	SIGN LEGEND	NEW SIGNS		EXISTING SIGNS				EXIST POST		NUMBER OF NEW POSTS	SQUARE STEEL (IN)			TUBULAR STEEL Ø (IN)				SIGN FRAME REQUIRED	REMARKS	SIGN DETAIL LOCATION			
								"A"	"B"	RETAIN	SALVAGE FROM	SALVAGE TO	REMOVE	RETAIN	REMOVE		1.75	2.00	2.50	FOUNDATION	3.00	3.50	4.00			5.00	SHSM	PROJECT SHEET #	STANDARD SHEET #
																	(LB / FT)				(LB / FT)								
<b>SHELDON VT105 WB</b>							FY-FLUORESCENT YELLOW FYG-FLUORESCENT YELLOW GREEN															"SHSM"-STANDARD HIGHWAY SIGNS AND MARKINGS							
		G	VR-017	24	30			5.00							1		X							WOODS HILL RD (TH-5)		7			
WB	1.010	H	R1-1	30	30								1											HAD TO USE OLD POSTS. SEE NOTE BELOW					
		H	R1-1	30	30			6.25						<del>1</del>		X								WOODS HILL RD (TH-5)	X				
WB	1.010	F	W1-6	48	24								1											HAD TO USE OLD POSTS. THEY WERE IN PAVEMENT, DID NOT WANT TO DISTURB.					
		F	W1-6	48	24			8.00						<del>2</del>		X										X			
WB	0.950	F	R2-1	24	30								1														X		
		F	R2-1	24	30			5.00							1		X											X	
WB	0.843	F	W1-2MR	30	30		MODIFIED RIGHT CURVE						1																
		F	W13-1	18	18		40 MPH PLAQUE						1																
WB	0.785	F	W1-2McR	36	36			9.00							2		X								INSTALL 300' +/- WEST OF EXISTING LOCATION		5		
		F	W1-2McR	18	18			2.25																	HAD TO USE OLD POSTS. THEY WERE IN PAVEMENT, DID NOT WANT TO DISTURB.			X	
WB	0.586	F	R2-1	24	30								1																
		F	R2-1	24	30			5.00							1		X											X	
<b>SIGN SUMMARY SHEET</b>							<b>SHEET TOTALS</b>	40.50	0.00	0	0	<del>1</del>	<del>7</del>	0	0	<del>5</del>	<del>8</del>	120.0	0	0.0	0.0	0.0	0.0		PROJECT NAME: <b>St Albans - Berkshire</b>				
								SF	SF	EA	EA	EA	EA	EA	EA	EA	FT	EA	LB	LB	LB	LB		PROJECT NUMBER: <b>STPG SIGN(36)</b>					
							<b>TOWN DIRECTIONAL TOTALS</b>	488.5	0.0	48	7	7	103	0	0	81		1215.0	0			0.0				FILE NAME: <b>SheldonWB.xls</b>			
VERMONT AGENCY OF TRANSPORTATION																								PLOT DATE: <b>5/17/2011</b>					
																							DRAWN BY: <b>T. Guazzoni</b>						
																							CHECKED BY: <b>A. Gamble</b>						
																							SHEET <b>65</b> OF <b>109</b>						