

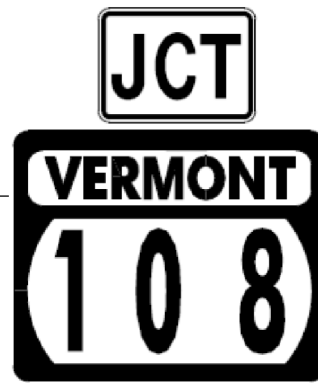



DIRECTION	MILEPOINT	LOCATION CODE (SHEET 2)	SIGN CODE	WIDTH (IN)	HEIGHT (IN)	SHEETING REMARKS	SIGN LEGEND	NEW SIGNS		EXISTING SIGNS				EXIST POST		NUMBER OF NEW POSTS	SQUARE STEEL (IN)			TUBULAR STEEL Ø (IN)				SIGN FRAME REQUIRED	REMARKS	SIGN DETAIL LOCATION			
								"A"	"B"	RETAIN	SALVAGE FROM	SALVAGE TO	REMOVE	RETAIN	REMOVE		1.75	2.00	2.50	FOUNDATION	3.00	3.50	4.00			5.00	SHSM	PROJECT SHEET #	STANDARD SHEET #
																	(LB / FT)				(LB / FT)								
<b>ENOSBURG VT105 EB</b>							FY-FLUORESCENT YELLOW FYG-FLUORESCENT YELLOW GREEN															"SHSM"-STANDARD HIGHWAY SIGNS AND MARKINGS							
<b>BEGIN CLASS 1 SECTION - VILLAGE OF ENOSBURG FALLS"</b>																													
EB	0.527	A	W11-2	30	30	FYG		6.25							1		X						INSTALL 200' +/- WEST OF EXISTING ROUTE MARKER ASSEMBLY	X					
		A	W7-3A	24	18	FYG		3.00 2.00																X					
EB	0.560	A	UNK.	UNK	UNK		EVANGALIST CHURCH																RETURN SIGN TO VILLAGE						
EB	0.565	A	M2-1	21	15																								
		A	M1-5A	30	24																								
		A	M2-1	21	15			2.19								1		X						GREEN ON WHITE	X				
		A	M1-5A	30	24			5.00																		E-136B			
EB	0.615	A	W11-2	30	30		PEDESTRIAN																						
		A	W16-7pL	24	12		LEFT DIAGONAL ARROW																						
EB	0.620	C	VR-017	24	30			5.00															CHURCH ST (TH-105). INSTALL ON RT SIDE OF CHURCH ST.		7				
EB	0.630	D	R1-1	30	30																								
		C	D3-1	UNK	UNK																								
		A	D3-1	UNK	UNK																								
		C	D3-1	24	8			1.33															INSTALL ABOVE STOP SIGN		6				
<b>SIGN SUMMARY SHEET</b>							<b>SHEET TOTALS</b>	<del>22.77</del> 24.77	0.00	2	0	0	6	0	0	3	45.0	0	0.0	0.0	0.0	0.0	PROJECT NAME: <b>St Albans - Berkshire</b>						
							SF	SF	EA	EA	EA	EA	EA	EA	EA	EA	FT	EA	LB	LB	LB	LB	PROJECT NUMBER: <b>STPG SIGN(36)</b>						
VERMONT AGENCY OF TRANSPORTATION							<b>TOWN DIRECTIONAL TOTALS</b>	393.9	0.0	25	4	4	94	0	0	58	870.0	2	235.6				FILE NAME: <b>EnosburgEB.xls</b>	PLOT DATE: <b>5/17/2011</b>					
																						DESIGNED BY: <b>T. Guazzoni</b>	CHECKED: <b>A. Gamble</b>						
																						ENOSBURG EB SHEET 3	SHEET <b>68</b>	OF <b>109</b>					