

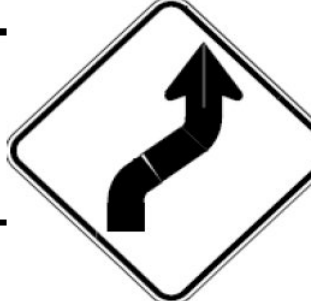




| DIRECTION                        | MILEPOINT | LOCATION CODE (SHEET 2) | SIGN CODE | WIDTH (IN) | HEIGHT (IN) | SHEETING REMARKS | SIGN LEGEND  | NEW SIGNS |     | EXISTING SIGNS |              |            |        | EXIST POST |        | NUMBER OF NEW POSTS | SQUARE STEEL (IN) |      |      | TUBULAR STEEL Ø (IN) |           |      |   |      | SIGN FRAME REQUIRED | REMARKS | SIGN DETAIL LOCATION  |   |                  |  |  |  |  |  |   |
|----------------------------------|-----------|-------------------------|-----------|------------|-------------|------------------|--|-----------|-----|----------------|--------------|------------|--------|------------|--------|---------------------|-------------------|------|------|----------------------|-----------|------|---|------|---------------------|---------|---|---|------------------|--|--|--|--|--|---|
|                                  |           |                         |           |            |             |                  |  | "A"       | "B" | RETAIN         | SALVAGE FROM | SALVAGE TO | REMOVE | RETAIN     | REMOVE |                     | 1.75              | 2.00 | 2.50 | FOUNDATION           | 3.00      | 3.50 | 4.00  | 5.00 |                     |         | SHSM  | PROJECT SHEET #   | STANDARD SHEET # |  |  |  |  |  |   |
|                                  |           |                         |           |            |             |                  |  |           |     |                |              |            |        |            |        |                     | (LB / FT)         |      |      |                      | (LB / FT) |      |   |      |                     |         |   |   |                  |  |  |  |  |  |   |
| <b>ENOSBURG VT105 WB</b>         |           |                         |           |            |             |                  | FY-FLUORESCENT YELLOW<br>FYG-FLUORESCENT YELLOW GREEN                                |           |     |                |              |            |        |            |        |                     |                   |      |      |                      |           |      | "SHSM"-STANDARD HIGHWAY<br>SIGNS AND MARKINGS |      |                     |         |   |   |                  |  |  |  |  |  |   |
| WB                               | 4.015     | F                       | VW-622    | 36         | 36          |                  | RECREATIONAL TRAIL   |           |     |                                  |           | F                       | VW-622P   | 24         | 18          |                  | ALL SEASON PLAQUE  |           |     | WB                               | 3.830     | F                       | VW-622A   | 36         | 36          |                  | RECREATIONAL TRAIL   |           |     |                                  |           | F                       | W1-7      | 24         | 12          |                  | <---> DOUBLE ARROW   |           |     |                                  |           | F                       | W11-15a   | 30         | 30          |                  |   | 6.25      |     |                X |
|                                  |           | F                       | W16-7pL   | 24         | 12          |                  |  | 2.00      |     |                X |
| WB                               | 3.775     | F                       | W1-4R     | 30         | 30          |                  | RIGHT REVERSE CURVE  |           |     | WB                               | 3.690     | F                       | W1-4R     | 30         | 30          |                  |  | 6.25      |     |                X |
| WB                               | 3.535     | F                       | VW-622    | 36         | 36          |                  | RECREATIONAL TRAIL   |           |     |                                  |           | F                       | VW-622P   | 24         | 18          |                  | ALL SEASON PLAQUE  |           |     | WB                               | 3.390     | F                       | W1-1L     | 30         | 30          |                  |  |                                  |           | F                       | W13-1     | 18         | 18          |                  |  |                                  |           | F                       | W1-1L     | 30         | 30          |                  |   | 6.25      |     |                X |
|                                  |           | F                       | W13-1     | 18         | 18          |                  |   | 2.25      |     |                X |
| WB                               | 3.370     | F                       | VW-622A   | 36         | 36          |                  | RECREATIONAL TRAIL   |           |     | <b>SIGN SUMMARY SHEET</b>        |           |                         |           |            |             |                  | SHEET TOTALS   |           |     |                |              | 23.00      | 0.00   | 0          | 0      | 0                   | 10                | 0    | 0    | 3                    | 45.0      | 0    | 0.0   | 0.0  | 0.0                 | 0.0     | PROJECT NAME: <b>St Albans - Berkshire</b><br>PROJECT NUMBER: <b>STPG SIGN(36)</b>  |   |                  |  |  |  |  |  |   |
| VERMONT AGENCY OF TRANSPORTATION |           |                         |           |            |             |                  | TOWN DIRECTIONAL TOTALS  |           |     |                |              | 359.7      | 0.0    | 23         | 0      | 0                   | 89                | 0    | 0    | 51                   | 765.0     | 2    | 171.0   |      |                     |         | FILE NAME: <b>EnosburgWB.xls</b><br>PROJECT MANAGER: <b>A. Gamble</b><br>DESIGNED BY: <b>T. Guazzoni</b><br>ENOSBURG WB SHEET 2 | PLOT DATE: <b>5/17/2011</b><br>DRAWN BY: <b>T. Guazzoni</b><br>CHECKED: <b>A. Gamble</b><br>SHEET <b>82</b> OF <b>109</b> |                  |  |  |  |  |  |   |