
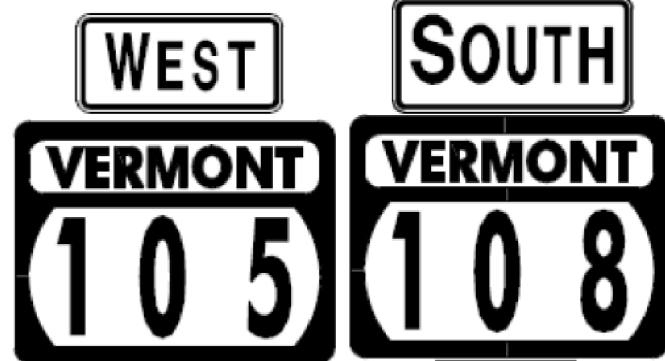



DIRECTION	MILEPOINT	LOCATION CODE (SHEET 2)	SIGN CODE	WIDTH (IN)	HEIGHT (IN)	SHEETING REMARKS	SIGN LEGEND	NEW SIGNS		EXISTING SIGNS				EXIST POST		NUMBER OF NEW POSTS	SQUARE STEEL (IN)			TUBULAR STEEL Ø (IN)				SIGN FRAME REQUIRED	REMARKS	SIGN DETAIL LOCATION			
								"A"	"B"	RETAIN	SALVAGE FROM	SALVAGE TO	REMOVE	RETAIN	REMOVE		1.75	2.00	2.50	FOUNDATION	3.00	3.50	4.00			5.00	SHSM	PROJECT SHEET #	STANDARD SHEET #
																	(LB / FT)				(LB / FT)								
ENOSBURG VT105 WB							FY-FLUORESCENT YELLOW FYG-FLUORESCENT YELLOW GREEN															"SHSM"-STANDARD HIGHWAY SIGNS AND MARKINGS							
		E	W1-6L	48	24			8.00							2		X								X				
WB	1.190	F	M3-4	24	12			2.00							2 4		X						#2B	GREEN ON WHITE. INSTALL 425' +/- EAST OF EXISTING SIGN LOCATION	X	6			
		F	M1-5	30	24			5.00																		E-136B			
		F	M3-3	24	12			2.00																	X				
		F	M1-5	30	24			5.00																		E-136B			
WB	1.110	F	M3-4	24	12		WEST																						
		F	M1-5	30	24		VERMONT 105																						
		F	M3-3	24	12		SOUTH																						
		F	M1-5	30	24		VERMONT 108																						
WB	1.095	F	W11-2	30	30		PEDESTRIAN																						
WB	1.035	G	VR-017	24	30		LEGAL LOAD LIMIT 24000 LBS				1																		
WB	1.030	H	R1-1	30	30		STOP				1																		
		G	D3-1	UNK.	UNK.																								
		F	D3-1	UNK.	UNK.																								
		G	D3-1	24	8			1.33																					
SIGN SUMMARY SHEET							SHEET TOTALS		23.33	0.00	2	0	0	7	0	0	4 3	45.0	0	0.0	0.0	0.0	0.0	PROJECT NAME: St Albans - Berkshire PROJECT NUMBER: STPG SIGN(36)					
VERMONT AGENCY OF TRANSPORTATION							SF	SF	EA	EA	EA	EA	EA	EA	EA	EA	EA	FT	EA	LB	LB	LB	LB	FILE NAME: EnosburgWB.xls PROJECT MANAGER: A. Gamble DESIGNED BY: T. Guazzoni ENOSBURG WB SHEET 8					
TOWN DIRECTIONAL TOTALS							359.7	0.0	23	0	0	89	0	0	51	765.0	2		171.0						PLOT DATE: 5/17/2011 DRAWN BY: T. Guazzoni CHECKED: A. Gamble SHEET 88 OF 109				