


TEMPORARY 4" WHITE LINE, PAINT
 DURABLE 4" WHITE LINE (OPTION BID ITEM)
 80+50 TO 86+50 SOLID LT
 80+50 TO 83+10 SOLID RT
 83+90 TO 85+36 SOLID RT
 86+15 TO 86+50 SOLID RT

TEMPORARY 4" YELLOW LINE, PAINT
 DURABLE 4" YELLOW LINE (OPTION BID ITEM)
 80+50 TO 83+30 SOLID LT & RT
 83+70 TO 85+55 SOLID LT & RT
 85+95 TO 86+50 SOLID LT & RT

6 INCH UNDERDRAIN PIPE
 80+50 TO 81+75 RT
 85+00 TO 86+50 LT
 STEEL BEAM GUARDRAIL, GALVANIZED
 W/8 FEET POSTS
 85+67 TO 86+50 RT
 ANCHOR FOR STEEL BEAM RAIL
 85+67 RT

REMOVAL AND DISPOSAL OF GUARDRAIL
 85+89 TO 86+50 RT
 DELINEATOR WITH STEEL POST
 85+67 RT

REMOVING SIGNS
 AS SHOWN - 4
 ERECTING SALVAGED SIGNS
 AS SHOWN - 4

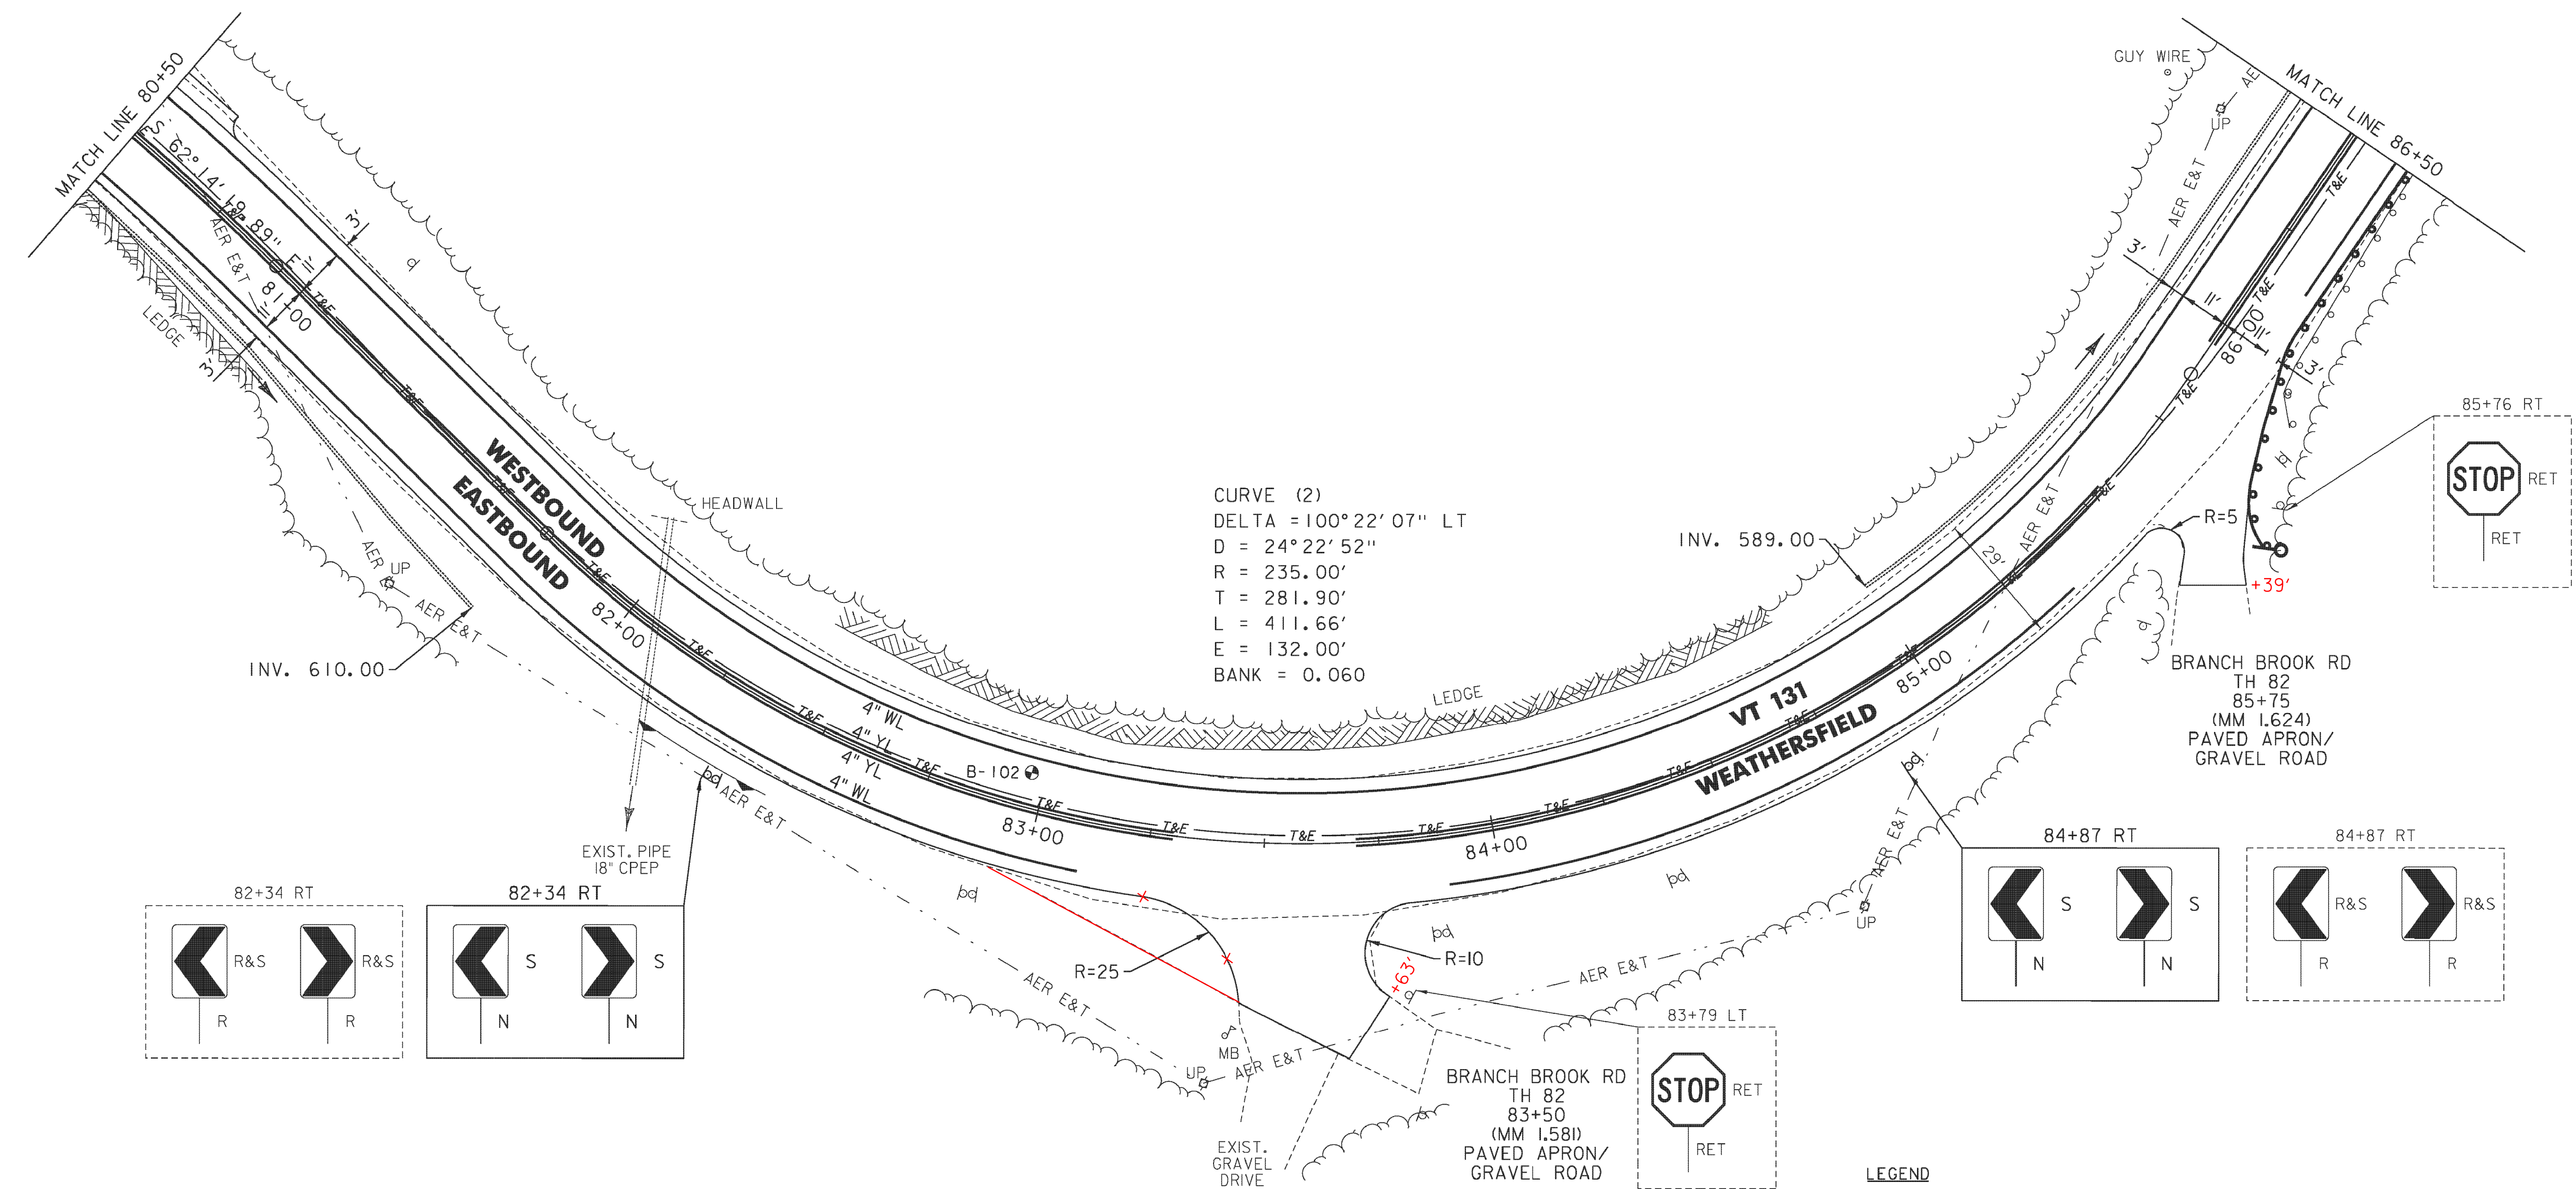

NOT TO SCALE

ROADWAY LAYOUT SHEET 3

PROJECT NAME:	WEATHERSFIELD	FILE NAME:	I0c228.dgn	PLOT DATE:	3/7/2013
PROJECT NUMBER:	STP 2913(1)	PROJECT LEADER:	PTS	DRAWN BY:	WWG
		DESIGNED BY:	NLL	CHECKED BY:	PTS
		IPARM FILE NAME:	pI0C228.36	SHEET	36 OF 234