

TEMPORARY 4" WHITE LINE, PAINT  
 DURABLE 4" WHITE LINE (OPTION BID ITEM)  
 109+50 TO 118+83 SOLID LT  
 109+50 TO 121+50 SOLID RT  
 118+83 TO 119+13 SOLID LT (TH 11)  
 119+34 TO 119+64 SOLID LT (TH 11)  
 119+64 TO 121+50 SOLID LT

TEMPORARY 4" YELLOW LINE, PAINT  
 DURABLE 4" YELLOW LINE (OPTION BID ITEM)  
 109+50 TO 119+05 SOLID LT & RT  
 119+23 DOUBLE SOLID LT (TH 11)  
 119+45 TO 121+50 SOLID LT & RT


TEMPORARY 24" STOP BAR, PAINT  
 DURABLE 24" STOP BAR (OPTION BID ITEM)  
 119+02 TO 119+23 LT (TH 11)  
 TEMPORARY LETTER OR SYMBOL, PAINT  
 DURABLE LETTER OR SYMBOL (OPTION BID ITEM)  
 119+17 LT - "STOP" (TH 11)

6 INCH UNDERDRAIN PIPE  
 113+50 TO 115+30 RT


STONE FILL, TYPE I  
 GEOTEXTILE UNDER STONE FILL  
 115+00 TO 116+00 LT  
 STEEL BEAM GUARDRAIL, GALVANIZED  
 W/8 FEET POSTS  
 112+25 TO 117+25 LT

ANCHOR FOR STEEL BEAM RAIL  
 112+25 LT  
 117+25 LT

REMOVAL AND DISPOSAL OF GUARDRAIL  
 112+29 TO 116+72 LT  
 DELINEATOR WITH STEEL POST  
 112+25 LT  
 117+25 LT

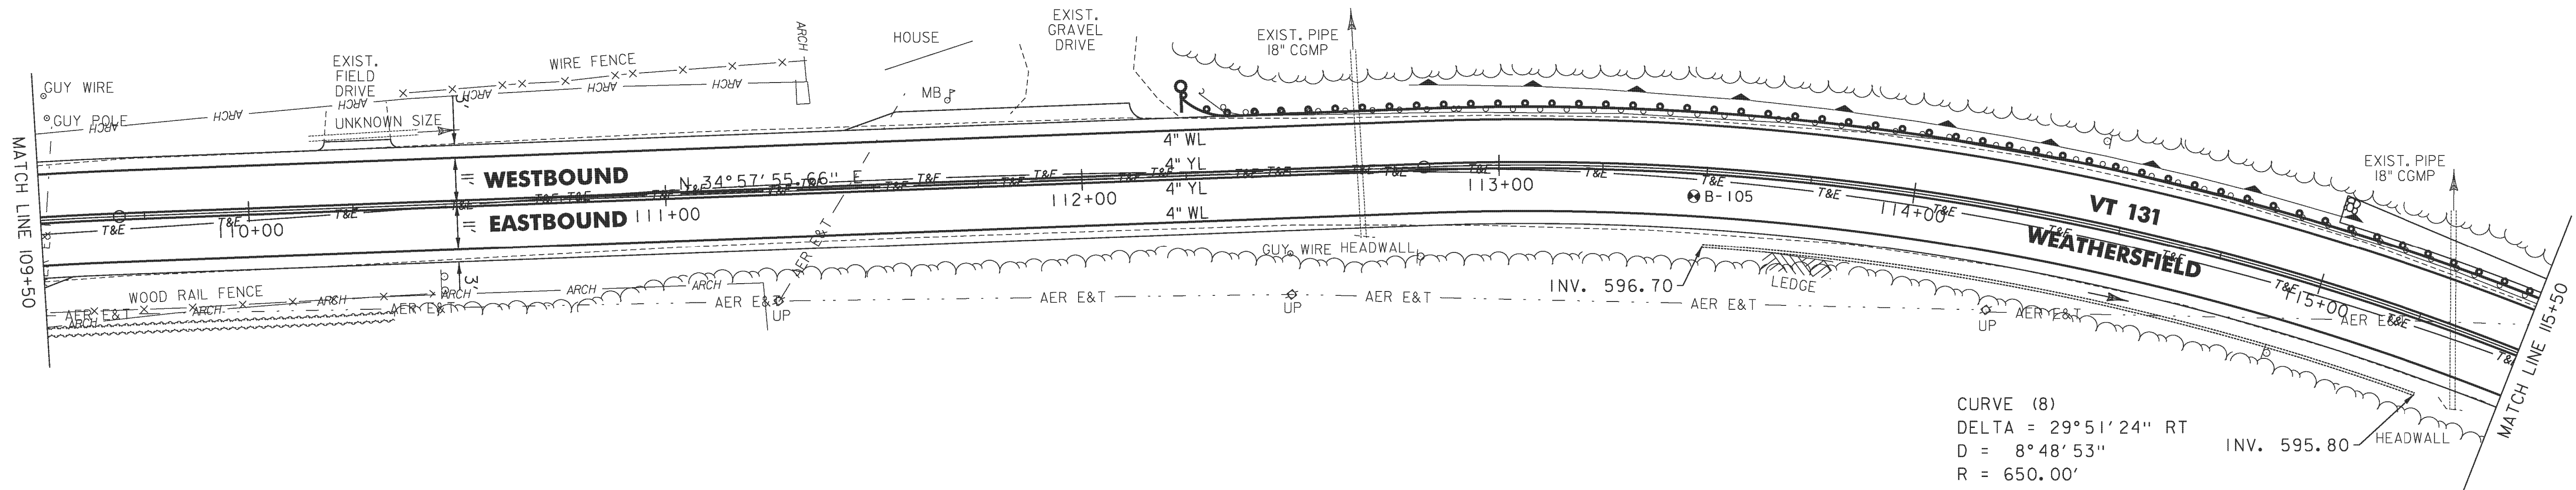

CURVE (8)  
 DELTA = 29°51'24" RT  
 D = 8°48'53"  
 R = 650.00'  
 T = 173.30'  
 L = 338.71'  
 E = 22.70'  
 BANK = 0.063

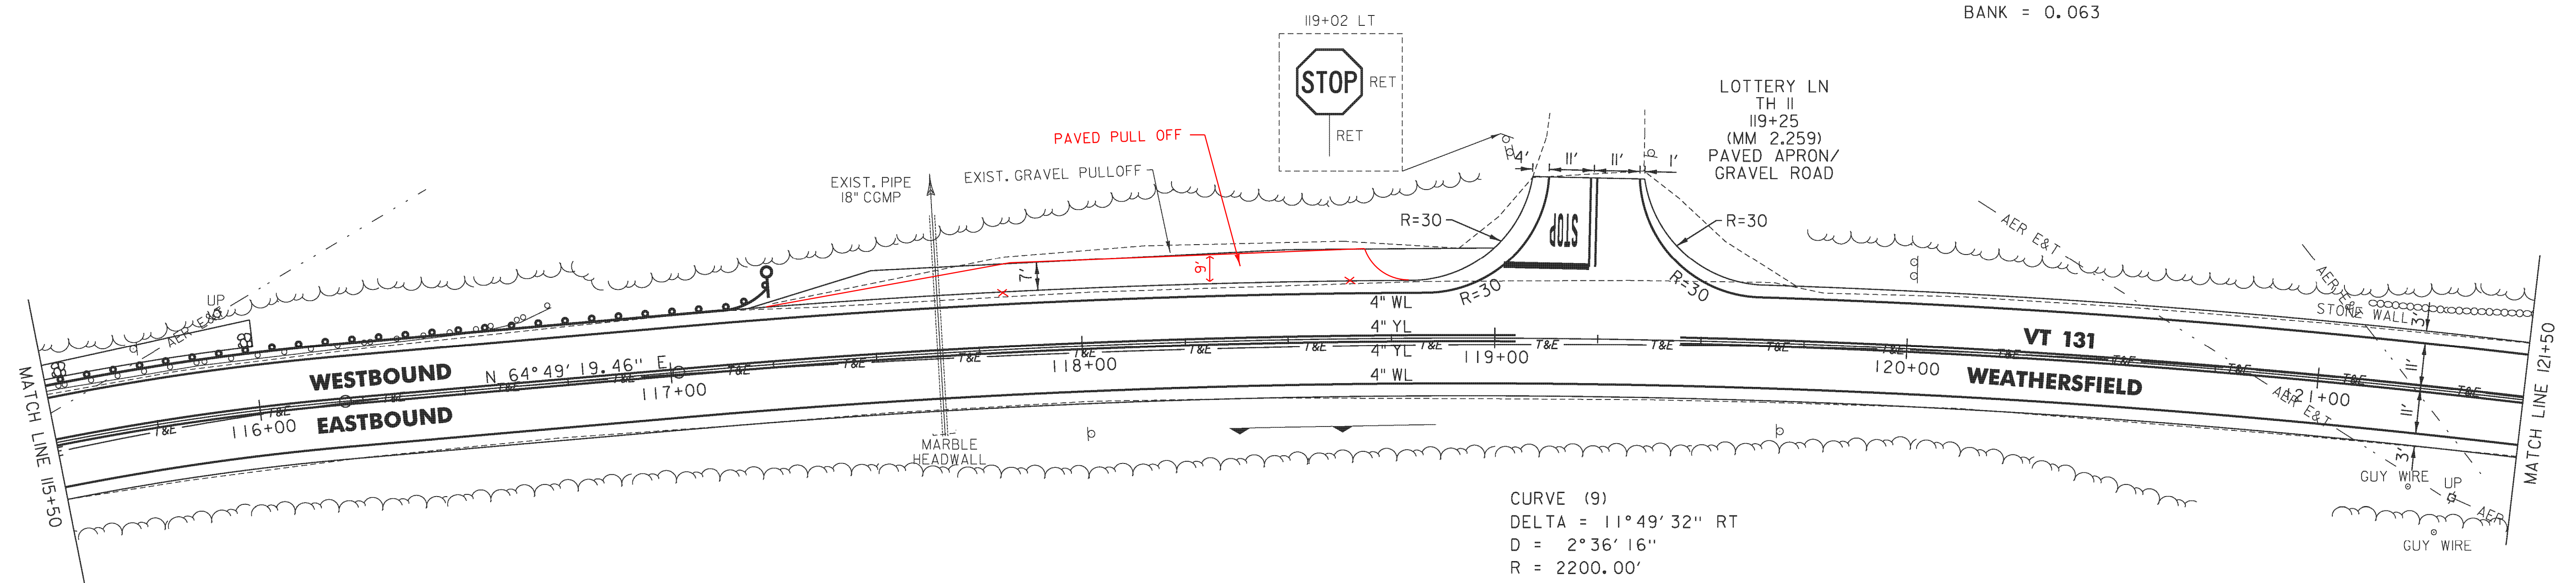

CURVE (9)  
 DELTA = 11°49'32" RT  
 D = 2°36'16"  
 R = 2200.00'  
 T = 227.84'  
 L = 454.06'  
 E = 11.77'  
 BANK = 0.027

LEGEND

- R = REMOVE EXISTING
- S = SALVAGE
- R&S = REMOVE AND SALVAGE
- N = NEW
- RET = RETAIN
- B-B = BACK TO BACK
- = EXISTING GUARDRAIL
- = PROPOSED GUARDRAIL
- YL = YELLOW LINE
- WL = WHITE LINE
- = DELINEATOR
- = UNDERDRAIN
- = BORING

ROADWAY LAYOUT SHEET 6

PROJECT NAME: WEATHERSFIELD	PLOT DATE: 3/7/2013
PROJECT NUMBER: STP 2913(1)	DRAWN BY: WWG
FILE NAME: 10c228.dgn	CHECKED BY: PTS
DESIGNED BY: NLL	SHEET 39 OF 234
IPARM FILE NAME: p10c228.39	

NOT TO SCALE