


TEMPORARY 4" YELLOW LINE, PAINT  
DURABLE 4" YELLOW LINE (OPTION BID ITEM)  
121+50 TO 133+50 SOLID LT & RT

STEEL BEAM GUARDRAIL, GALVANIZED  
W/8 FEET POSTS  
124+78 TO 125+65.5 LT

| REMOVAL AND DISPOSAL OF GUARDRAIL |    |          |    |
|-----------------------------------|----|----------|----|
| 124+78                            | TO | 125+65.5 | LT |
| 124+80                            | TO | 125+17.5 | RT |
| 126+83.5                          | TO | 127+21   | RT |
| 126+92.5                          | TO | 127+30   | LT |

RELOCATE MAILBOX, SINGLE SUPPORT  
129+10 RT

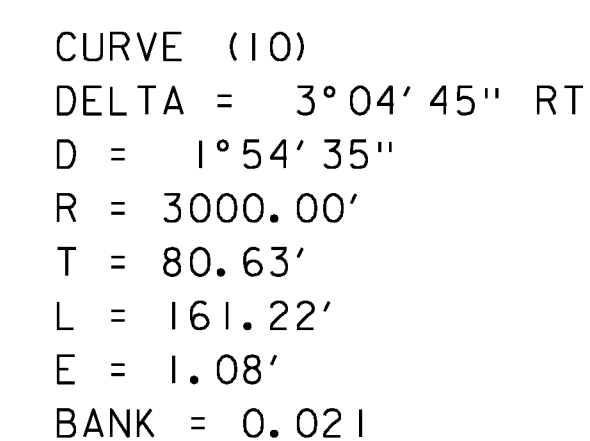

CURVE (11)  
DELTA = 15°05'47" LT  
D = 3°22'13"  
R = 1700.00'  
T = 225.26'  
L = 447.92'  
E = 14.86'  
BANK = 0.057

|                                                                                       |   |                    |
|---------------------------------------------------------------------------------------|---|--------------------|
| R                                                                                     | = | REMOVE EXISTING    |
| S                                                                                     | = | SALVAGE            |
| R&S                                                                                   | = | REMOVE AND SALVAGE |
| N                                                                                     | = | NEW                |
| RET                                                                                   | = | RETAIN             |
| B-B                                                                                   | = | BACK TO BACK       |
|  | = | EXISTING GUARDRAIL |
|  | = | PROPOSED GUARDRAIL |
| YL                                                                                    | = | YELLOW LINE        |
| WL                                                                                    | = | WHITE LINE         |
|  | = | DELINEATOR         |
|  | = | UNDERDRAIN         |
|  | = | BORING             |

|                 |               |
|-----------------|---------------|
| PROJECT NAME:   | WEATHERSFIELD |
| PROJECT NUMBER: | STP 2913(1)   |

FILE NAME: IOc228.dgn  
PROJECT LEADER: PTS  
DESIGNED BY: NLL  
IPARM FILE NAME: pIOc228\_40

PLOT DATE: 3/7/2013  
DRAWN BY: WWG  
CHECKED BY: PTS  
SHEET 40 OF 234

NOT TO SCALE