

TEMPORARY 4" WHITE LINE, PAINT
 DURABLE 4" WHITE LINE (OPTION BID ITEM)
 192+50 TO 198+90 SOLID LT
 192+50 TO 203+50 SOLID RT
 199+70 TO 203+50 SOLID LT

TEMPORARY 4" YELLOW LINE, PAINT
 DURABLE 4" YELLOW LINE (OPTION BID ITEM)
 192+50 TO 192+72 DASHED CL
 192+72 TO 198+80 DASHED LT, SOLID RT
 198+80 TO 199+10 SOLID LT & RT
 199+50 TO 203+50 SOLID LT & RT

STEEL BEAM GUARDRAIL, GALVANIZED
 198+80 TO 203+05 RT
 201+44 TO 202+20 LT
 202+82.5 TO 203+45 LT



STEEL BEAM GUARDRAIL, GALVANIZED
 W/8 FEET POSTS
 202+20 TO 202+82.5 LT

ANCHOR FOR STEEL BEAM RAIL
 198+80 RT
 201+44 LT
 203+05 RT
 203+45 LT

REMOVAL AND DISPOSAL OF GUARDRAIL
 198+80 TO 202+98 RT
 201+70 TO 203+44 LT

DELINEATOR WITH STEEL POST
 198+80 RT
 201+44 LT
 203+05 RT
 203+45 LT

RELOCATE MAILBOX, SINGLE SUPPORT
 194+60 LT
 198+29 RT
 198+30 RT

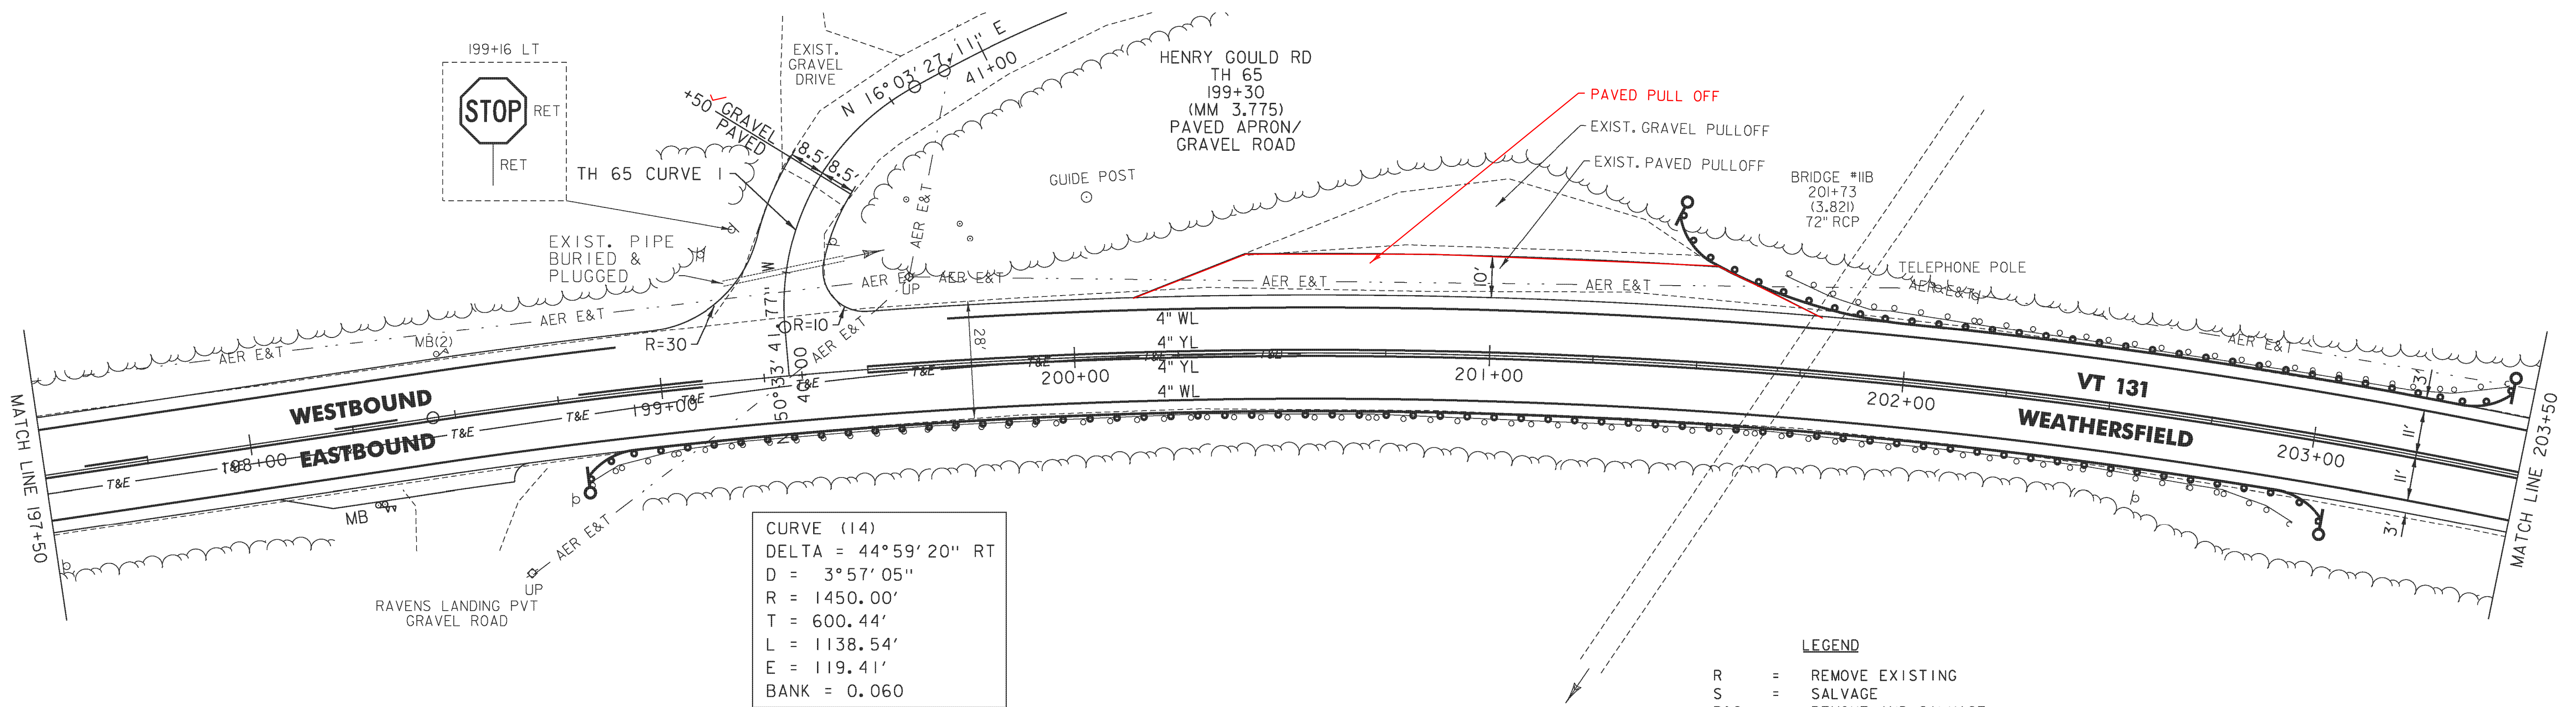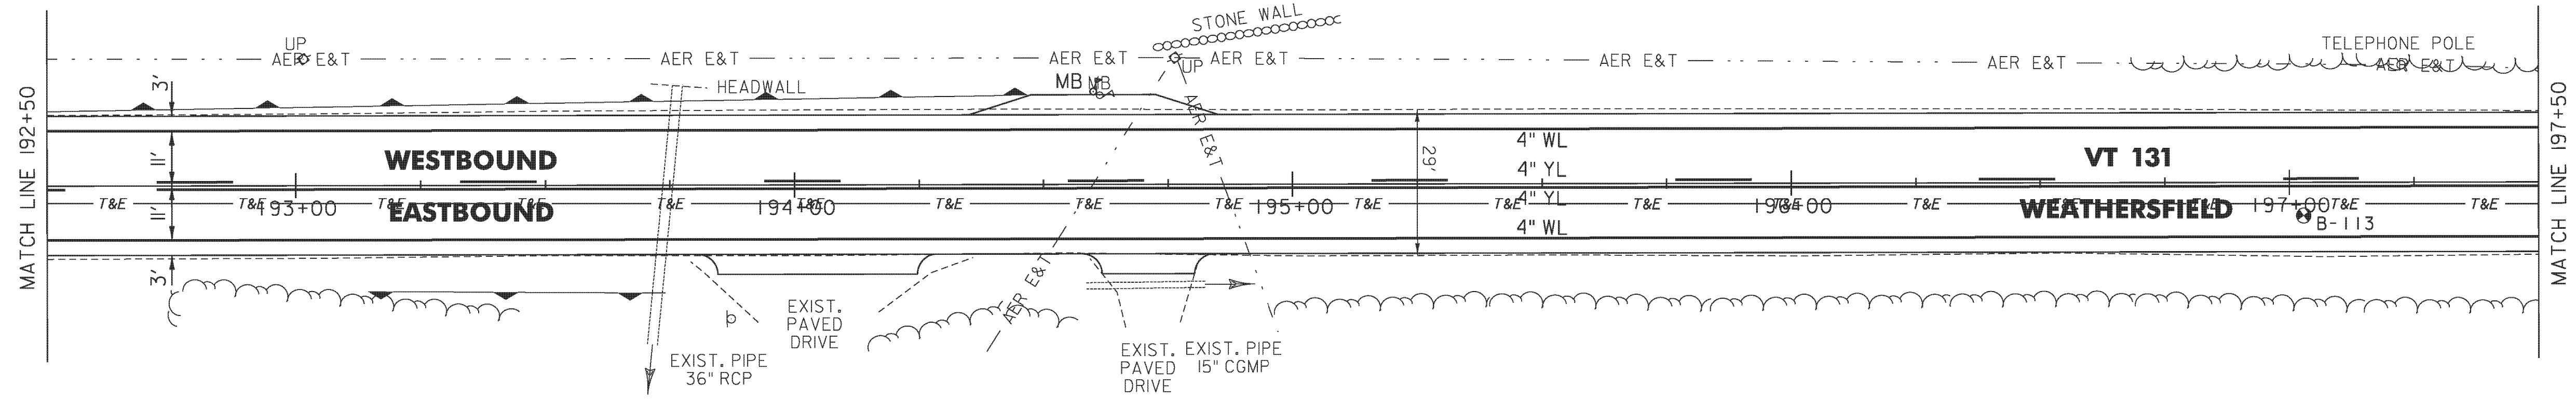

- LEGEND**
- R = REMOVE EXISTING
 - S = SALVAGE
 - R&S = REMOVE AND SALVAGE
 - N = NEW
 - RET = RETAIN
 - B-B = BACK TO BACK
 - = EXISTING GUARDRAIL
 - ⊞ = PROPOSED GUARDRAIL
 - YL = YELLOW LINE
 - WL = WHITE LINE
 - = DELINEATOR
 - ⋯ = UNDERDRAIN
 - ⊙ = BORING

ROADWAY LAYOUT SHEET 13

PROJECT NAME: WEATHERSFIELD
 PROJECT NUMBER: STP 2913(1)
 FILE NAME: I0c228.dgn
 PROJECT LEADER: PTS
 DESIGNED BY: NLL
 IPARM FILE NAME: pI0C228.46
 PLOT DATE: 3/7/2013
 DRAWN BY: WWG
 CHECKED BY: PTS
 SHEET 46 OF 234

NOT TO SCALE