

TEMPORARY 4" WHITE LINE, PAINT
 DURABLE 4" WHITE LINE (OPTION BID ITEM)
 203+50 TO 211+15 SOLID LT
 203+50 TO 215+50 SOLID RT
 211+15 TO 211+49 SOLID LT (TH 7)
 211+65 TO 211+89 SOLID LT (TH 7)
 211+89 TO 215+50 SOLID LT

TEMPORARY 4" YELLOW LINE, PAINT
 DURABLE 4" YELLOW LINE (OPTION BID ITEM)
 203+50 TO 211+32 SOLID LT & RT
 211+52 TO 211+57 DOUBLE SOLID LT (TH 7)
 211+72 TO 215+50 SOLID LT & RT

TEMPORARY 24" STOP BAR, PAINT
 DURABLE 24" STOP BAR (OPTION BID ITEM)
 211+33 TO 211+51 LT (TH 7)

TEMPORARY LETTER OR SYMBOL, PAINT
 DURABLE LETTER OR SYMBOL (OPTION BID ITEM)
 211+44 LT - "STOP" (TH 7)

6 INCH UNDERDRAIN PIPE
 203+50 TO 206+00 RT

STEEL BEAM GUARDRAIL, GALVANIZED
 211+88 TO 215+50 LT
 212+25 TO 213+00 RT
 214+87.5 TO 215+50 RT



STEEL BEAM GUARDRAIL, GALVANIZED
 W/8 FEET POSTS
 213+00 TO 214+87.5 RT

ANCHOR FOR STEEL BEAM RAIL
 211+88 LT
 212+25 RT

REMOVAL AND DISPOSAL OF GUARDRAIL
 211+88 TO 215+50 LT
 212+25 TO 215+50 RT

DELINEATOR WITH STEEL POST
 211+88 LT
 212+25 RT

RELOCATE MAILBOX, SINGLE SUPPORT
 206+60 LT
 207+89 LT

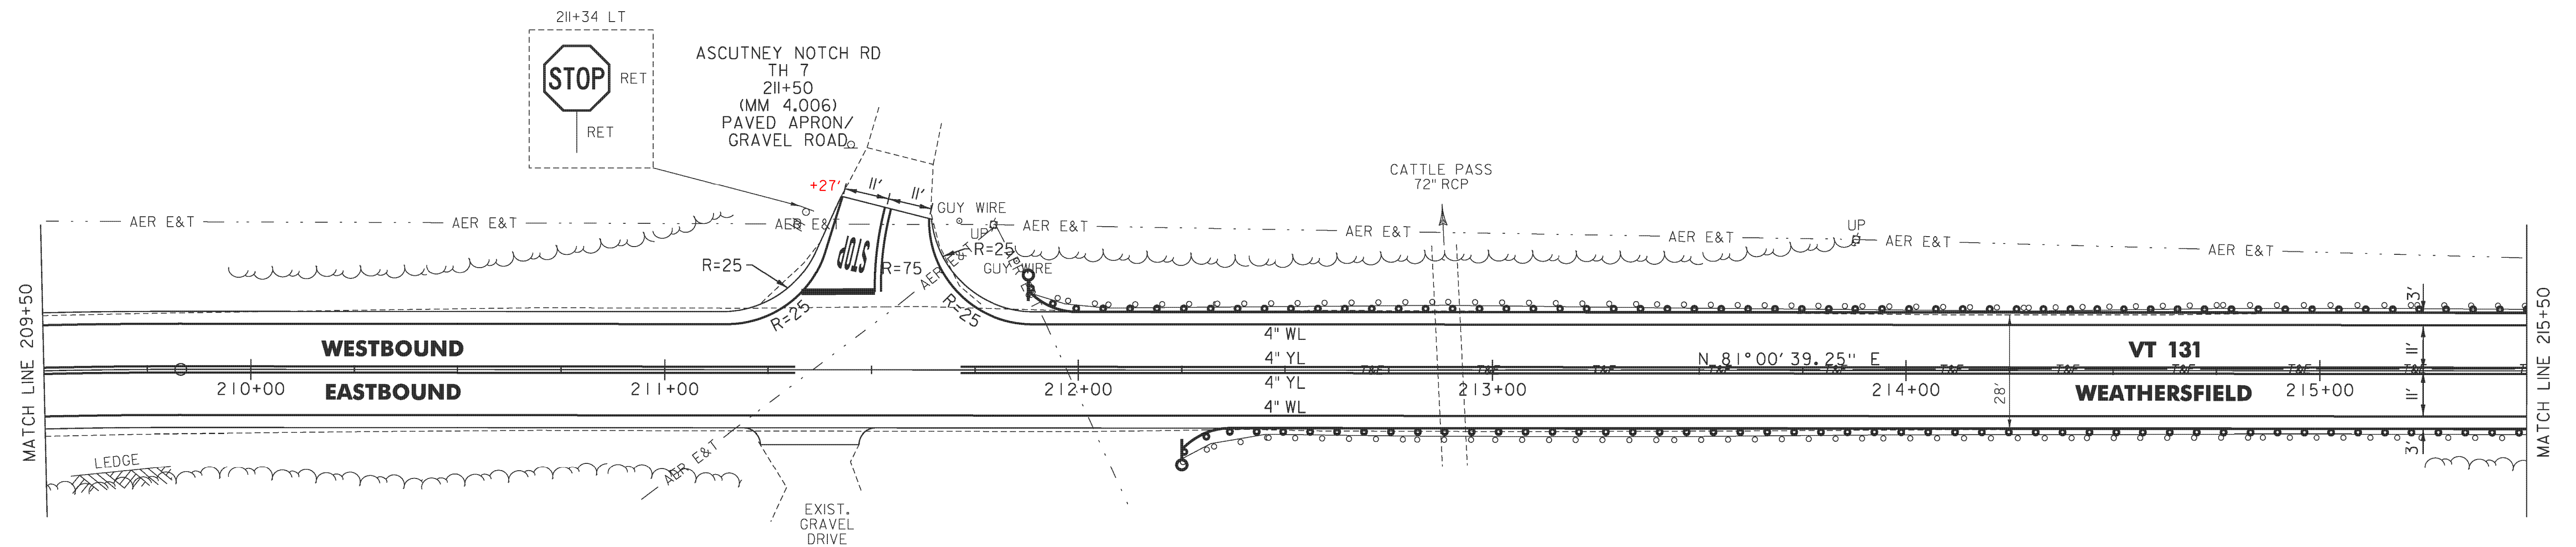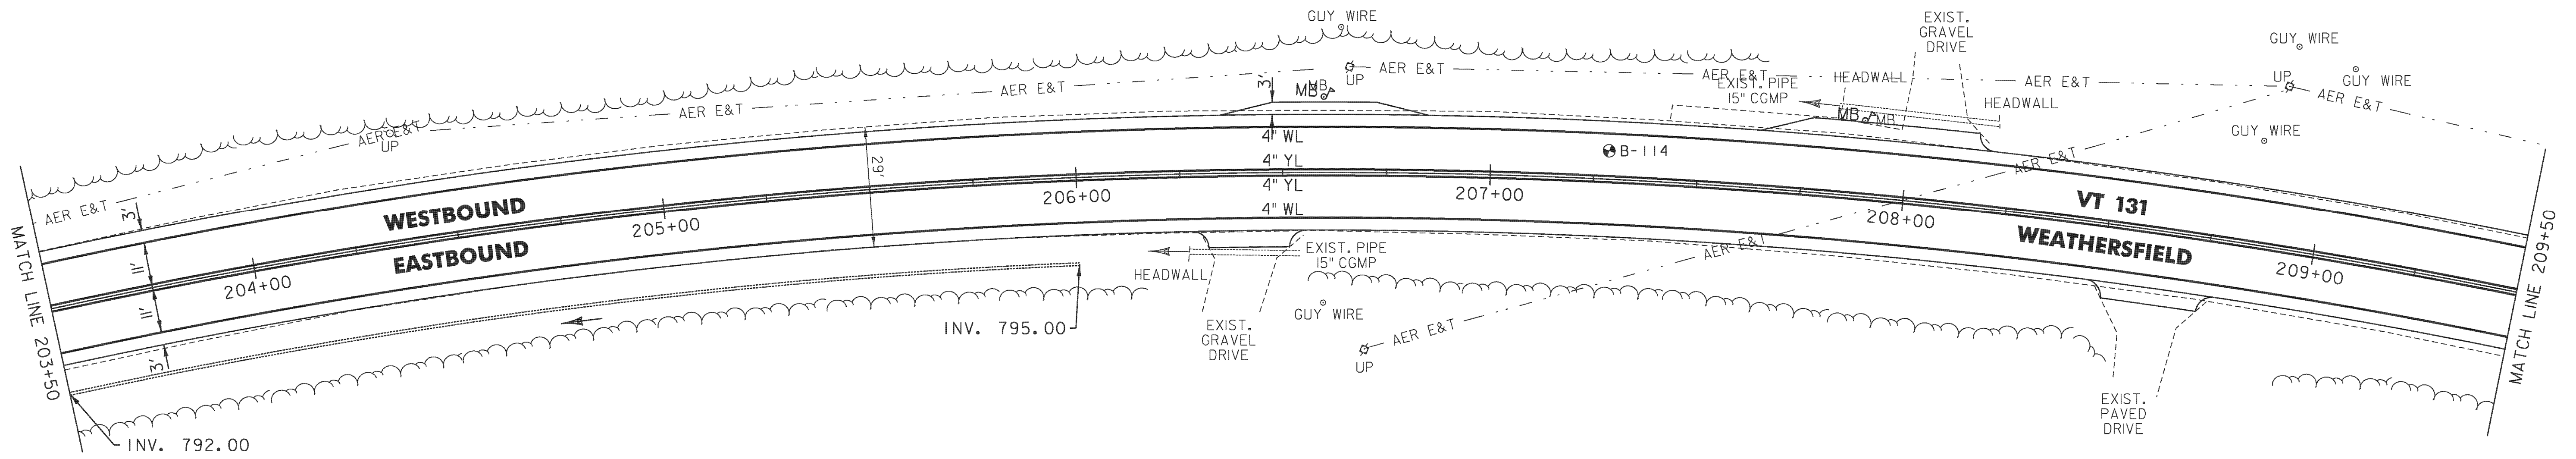

LEGEND

- R = REMOVE EXISTING
- S = SALVAGE
- R&S = REMOVE AND SALVAGE
- N = NEW
- RET = RETAIN
- B-B = BACK TO BACK
- = EXISTING GUARDRAIL
- ⊕ = PROPOSED GUARDRAIL
- YL = YELLOW LINE
- WL = WHITE LINE
- = DELINEATOR
- ⋯ = UNDERDRAIN
- ⊙ = BORING

ROADWAY LAYOUT SHEET 14

PROJECT NAME: WEATHERSFIELD	FILE NAME: I0c228.dgn	PLOT DATE: 3/7/2013
PROJECT NUMBER: STP 2913(1)	PROJECT LEADER: PTS	DRAWN BY: WWG
	DESIGNED BY: NLL	CHECKED BY: PTS
	IPARM FILE NAME: pI0C228.47	SHEET 47 OF 234

NOT TO SCALE