

TEMPORARY 4" WHITE LINE, PAINT  
 DURABLE 4" WHITE LINE (OPTION BID ITEM)  
 298+50 TO 310+50 SOLID LT  
 298+50 TO 301+24 SOLID RT  
 302+04 TO 308+57 SOLID RT  
 309+19 TO 310+50 SOLID RT

TEMPORARY 4" YELLOW LINE, PAINT  
 DURABLE 4" YELLOW LINE (OPTION BID ITEM)  
 298+50 TO 301+44 SOLID LT & RT  
 301+84 TO 308+61 SOLID LT & RT  
 309+01 TO 310+50 SOLID LT & RT

6 INCH UNDERDRAIN PIPE  
 302+50 TO 306+00 LT

STONE FILL, TYPE I  
 GEOTEXTILE UNDER STONE FILL  
 298+75 TO 299+50 LT

STEEL BEAM GUARDRAIL, GALVANIZED  
 306+53 TO 310+50 LT


STEEL BEAM GUARDRAIL, GALVANIZED  
 W/8 FEET POSTS  
 306+20 TO 308+57.5 RT

ANCHOR FOR STEEL BEAM RAIL  
 306+20 RT  
 306+53 LT  
 308+57.5 RT

REMOVAL AND DISPOSAL OF GUARDRAIL  
 306+19 TO 308+57 RT  
 306+53 TO 310+50 LT

DELINEATOR WITH STEEL POST  
 306+20 RT  
 306+53 LT  
 308+57.5 RT

CURVE (24)  
 DELTA = 17°52'02" LT  
 D = 3°34'52"  
 R = 1600.00'  
 T = 251.51'  
 L = 498.94'  
 E = 19.65'  
 BANK = 0.059

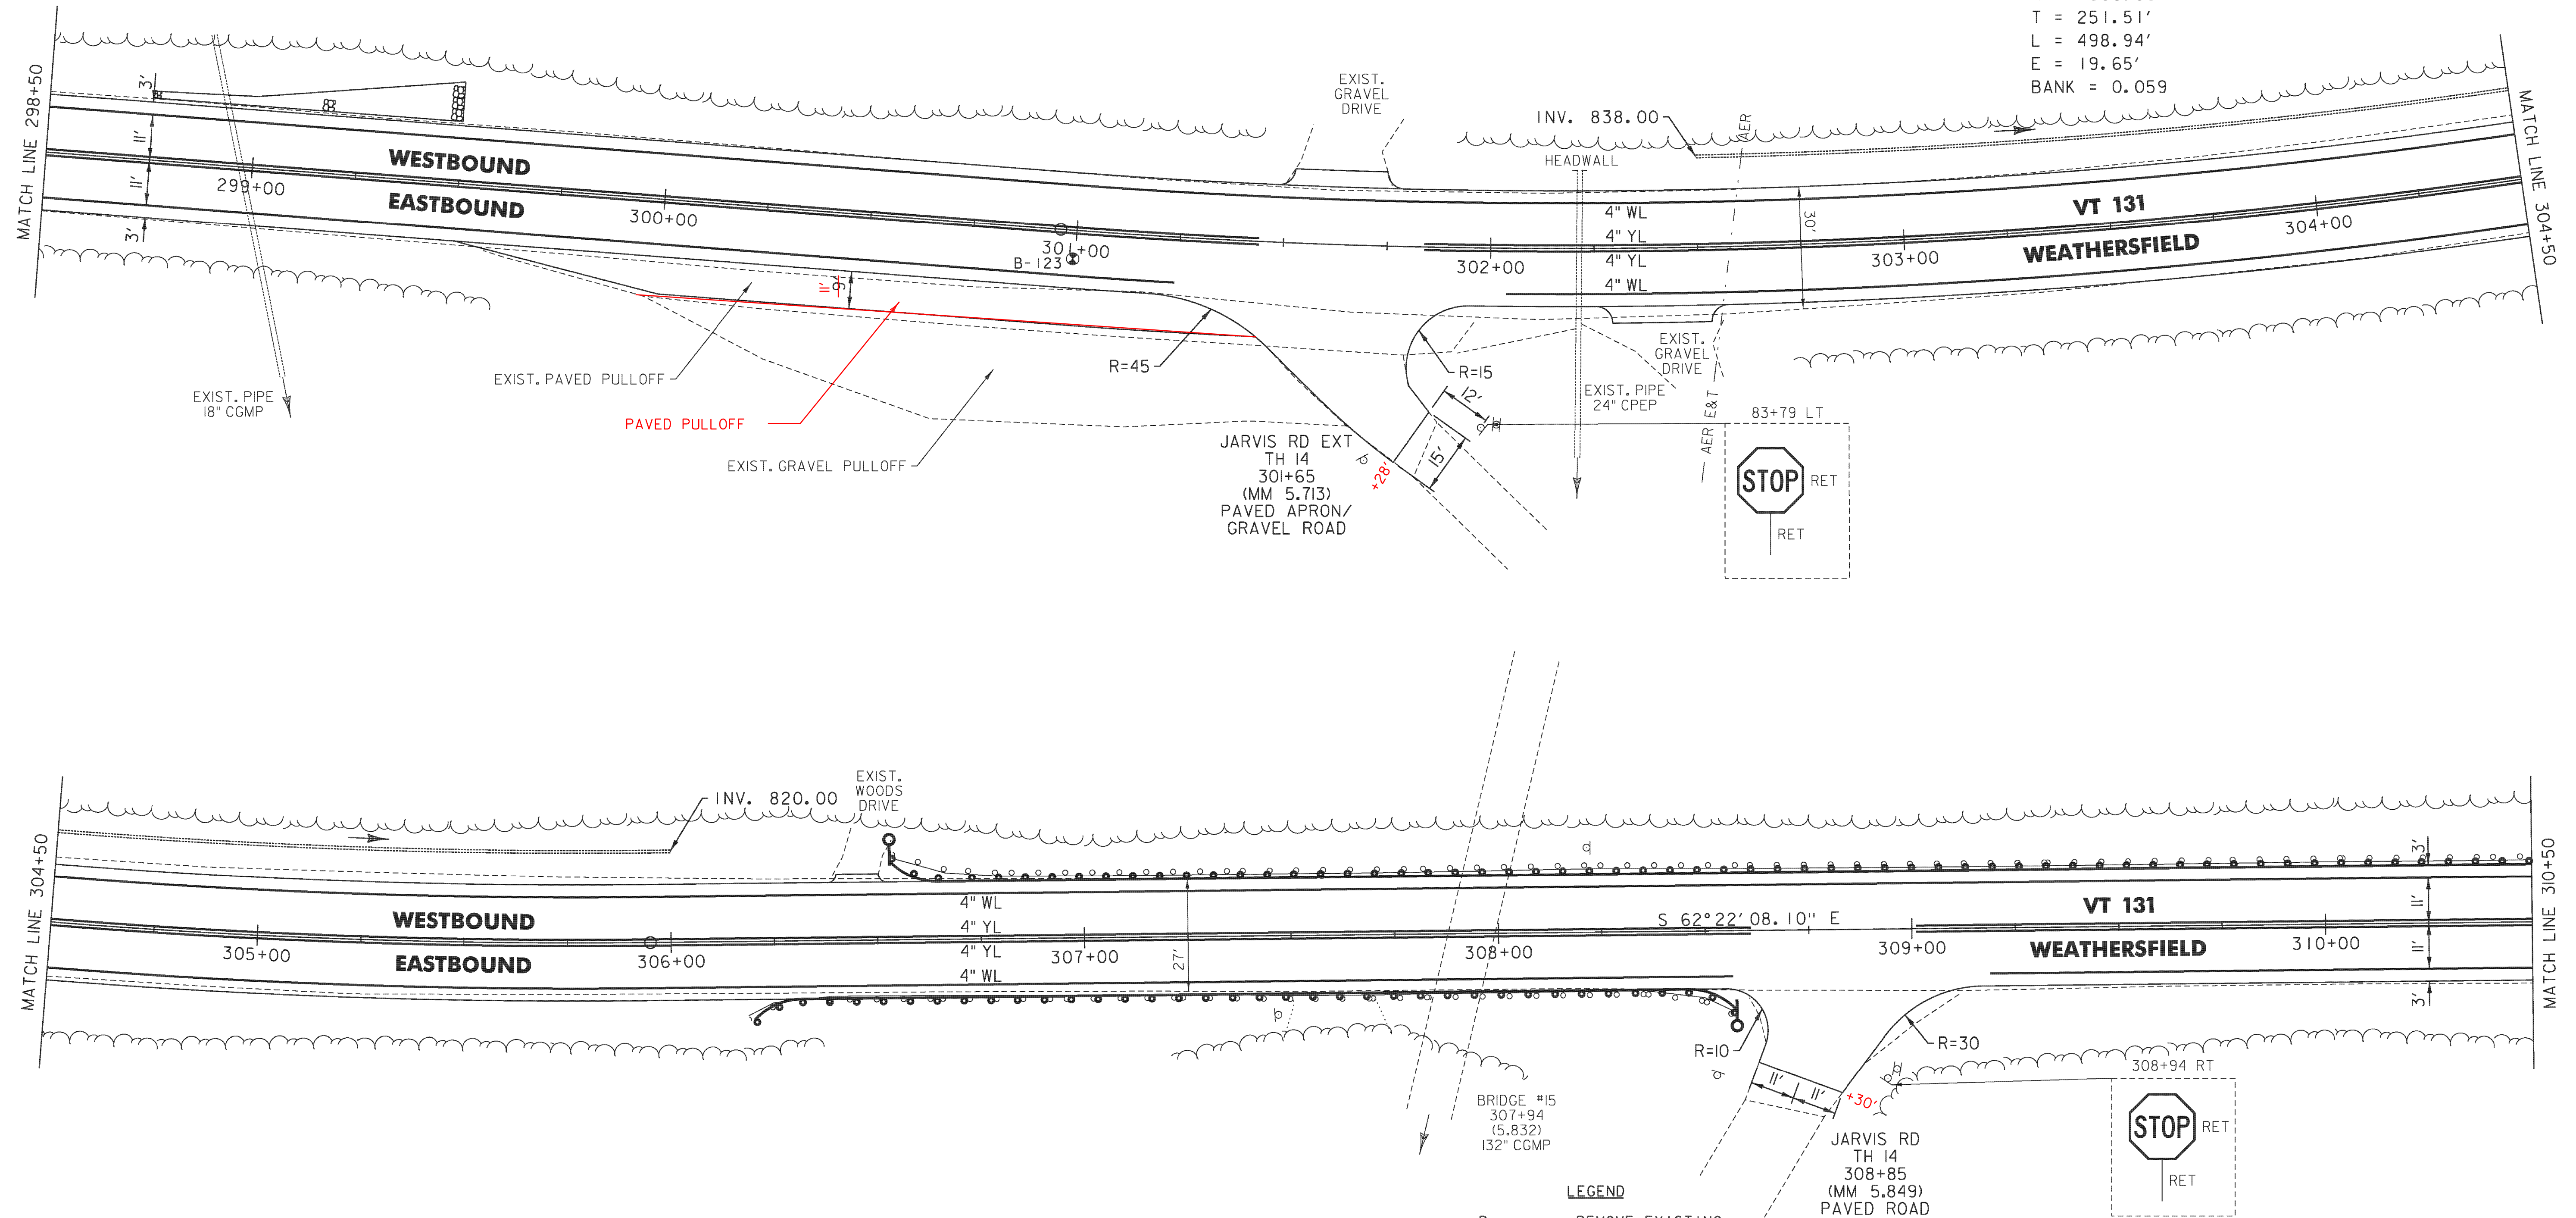

LEGEND

- R = REMOVE EXISTING
- S = SALVAGE
- R&S = REMOVE AND SALVAGE
- N = NEW
- RET = RETAIN
- B-B = BACK TO BACK
- ⊕ = EXISTING GUARDRAIL
- ⊕ = PROPOSED GUARDRAIL
- YL = YELLOW LINE
- WL = WHITE LINE
- = DELINEATOR
- ⋯ = UNDERDRAIN
- ⊙ = BORING

NOT TO SCALE

ROADWAY LAYOUT SHEET 22

PROJECT NAME: WEATHERSFIELD

PROJECT NUMBER: STP 2913(I)

FILE NAME: I0c228.dgn

PROJECT LEADER: PTS

DESIGNED BY: NLL

IPARM FILE NAME: pI0C228.55

PLOT DATE: 3/7/2013

DRAWN BY: WWG

CHECKED BY: PTS

SHEET 55 OF 234