

TEMPORARY 4" WHITE LINE, PAINT
 DURABLE 4" WHITE LINE (OPTION BID ITEM)

310+50 TO 314+30 SOLID LT
 310+50 TO 321+50 SOLID RT
 314+30 TO 314+61 SOLID LT & RT (TH 28)
 314+84 TO 315+16 SOLID LT (TH 28)
 315+16 TO 321+50 SOLID LT

TEMPORARY 4" YELLOW LINE, PAINT
 DURABLE 4" YELLOW LINE (OPTION BID ITEM)

310+50 TO 314+55 SOLID LT & RT
 314+73 TO 314+75 DOUBLE SOLID LT (TH 28)
 314+95 TO 321+50 SOLID LT & RT

TEMPORARY 24" STOP BAR, PAINT
 DURABLE 24" STOP BAR (OPTION BID ITEM)

314+53 TO 314+74 LT (TH 28)

TEMPORARY LETTER OR SYMBOL, PAINT
 DURABLE LETTER OR SYMBOL (OPTION BID ITEM)
 314+66 LT - "STOP" (TH 28)

STEEL BEAM GUARDRAIL, GALVANIZED
 310+50 TO 314+59 LT




REMOVAL AND DISPOSAL OF GUARDRAIL

310+50 TO 314+18 LT
 314+55 TO 314+59 LT (TH 28)

RELOCATE MAILBOX, SINGLE SUPPORT

312+00 LT
 315+22 RT
 320+04 RT

CURVE (25)
 DELTA = 18°47'19" LT
 D = 4°05'33"
 R = 1400.00'
 T = 231.63'
 L = 459.09'
 E = 19.03'
 BANK = 0.064

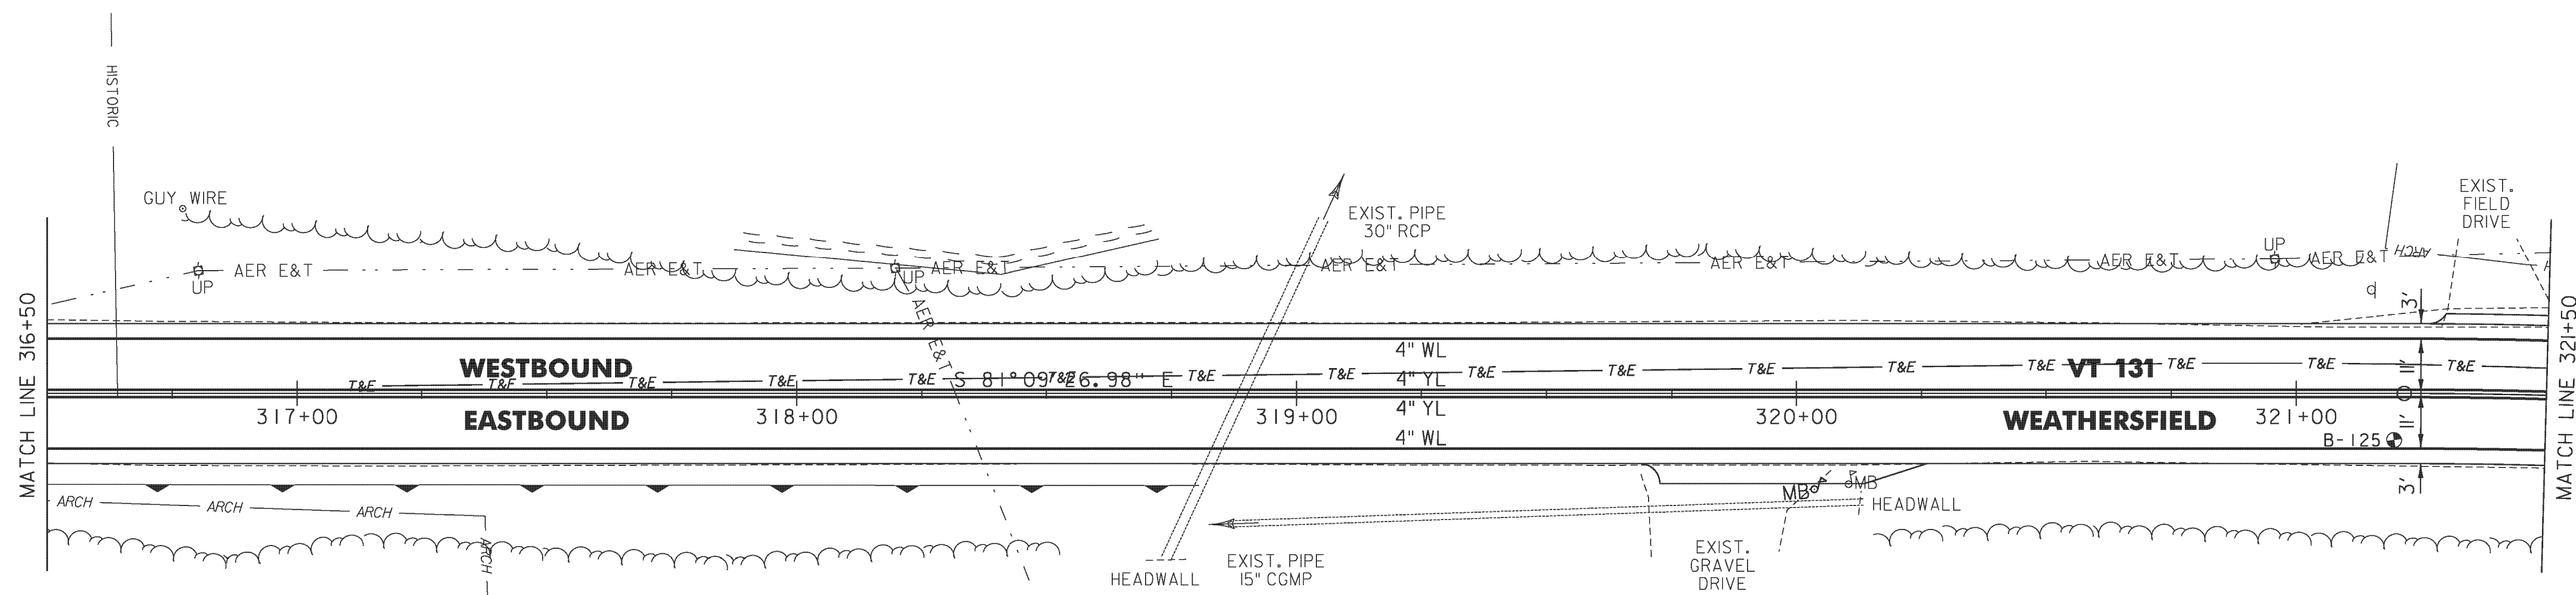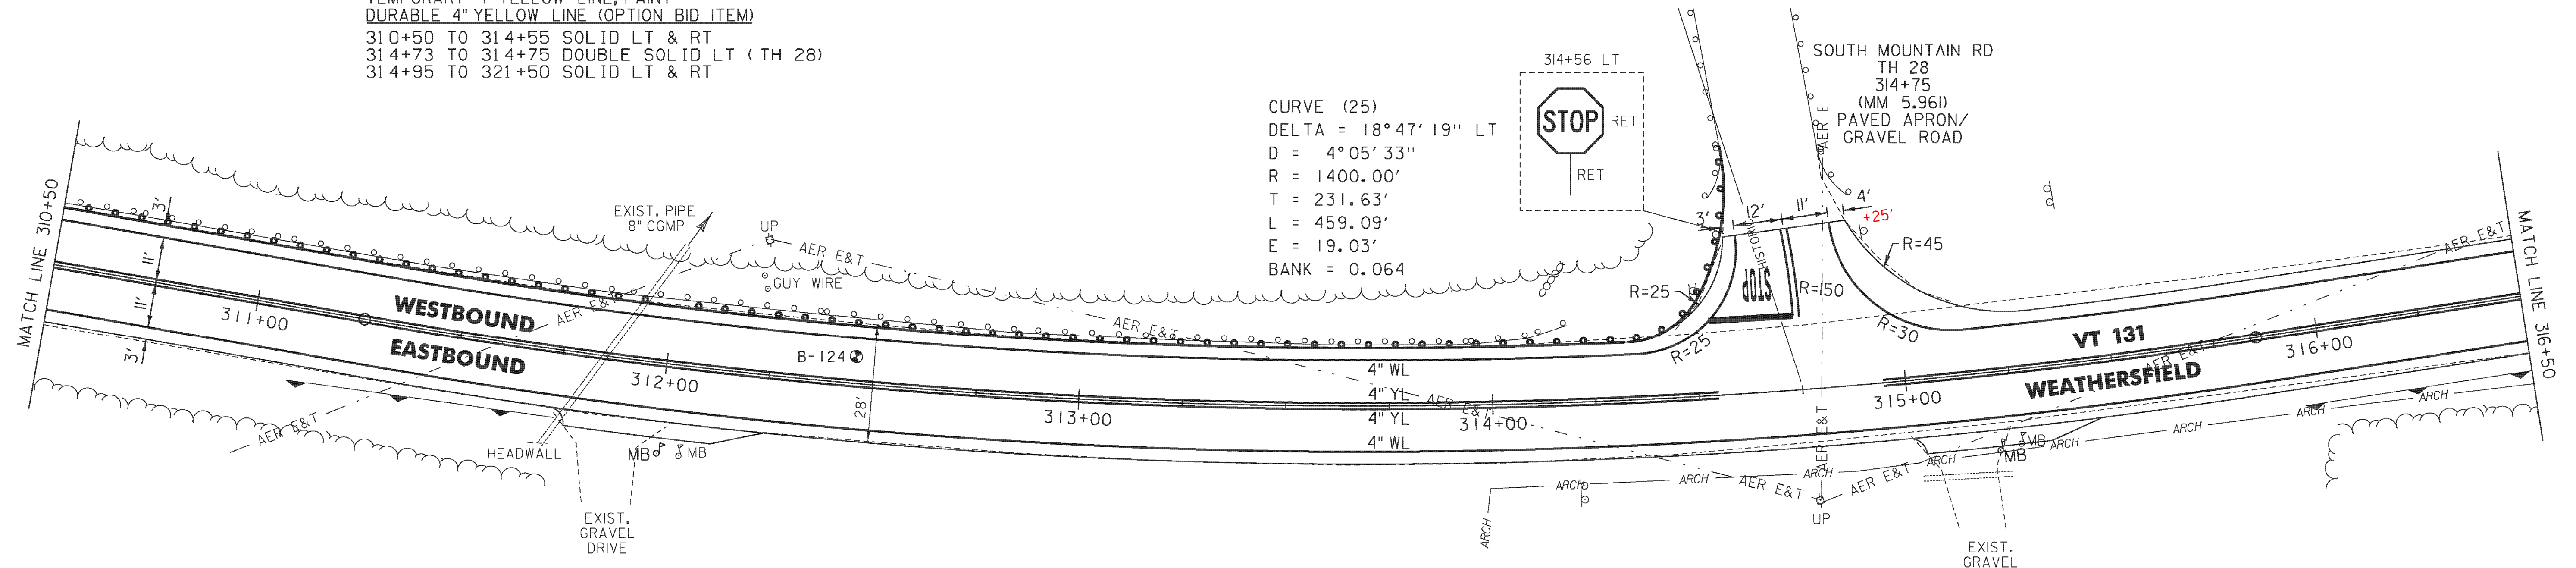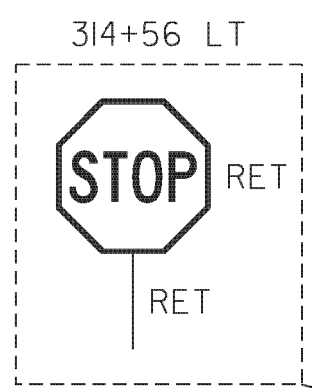

LEGEND

- R = REMOVE EXISTING
- S = SALVAGE
- R&S = REMOVE AND SALVAGE
- N = NEW
- RET = RETAIN
- B-B = BACK TO BACK
- = EXISTING GUARDRAIL
- = PROPOSED GUARDRAIL
- YL = YELLOW LINE
- WL = WHITE LINE
- = DELINEATOR
- ⋯⋯⋯ = UNDERDRAIN
- ⊙ = BORING

ROADWAY LAYOUT SHEET 23

PROJECT NAME: WEATHERSFIELD

PROJECT NUMBER: STP 2913(1)

FILE NAME: I0c228.dgn

PROJECT LEADER: PTS

DESIGNED BY: NLL

IPARM FILE NAME: pI0c228.56

PLOT DATE: 3/7/2013

DRAWN BY: WWG

CHECKED BY: PTS

SHEET 56 OF 234

NOT TO SCALE