

TEMPORARY 4" WHITE LINE, PAINT
 DURABLE 4" WHITE LINE (OPTION BID ITEM)
 343+50 TO 343+78 SOLID LT
 343+50 TO 355+50 SOLID RT
 343+78 TO 344+11 SOLID LT (TH 37)
 344+13 TO 344+18 SOLID LT (TH 37)
 344+18 TO 355+50 SOLID LT


TEMPORARY 4" YELLOW LINE, PAINT
 DURABLE 4" YELLOW LINE (OPTION BID ITEM)
 343+50 TO 343+80 SOLID LT & RT
 343+99 TO 344+17 DOUBLE SOLID LT (TH 37)
 344+20 TO 355+50 SOLID LT & RT

TEMPORARY 24" STOP BAR, PAINT
 DURABLE 24" STOP BAR (OPTION BID ITEM)
 343+88 TO 343+99 LT (TH 37)


TEMPORARY LETTER OR SYMBOL, PAINT
 DURABLE LETTER OR SYMBOL (OPTION BID ITEM)
 344+00 LT - "STOP" (TH 37)

REMOVAL OF EXISTING FENCE
 354+44 TO 355+50 RT

RELOCATE MAILBOX, SINGLE SUPPORT
 353+68 LT

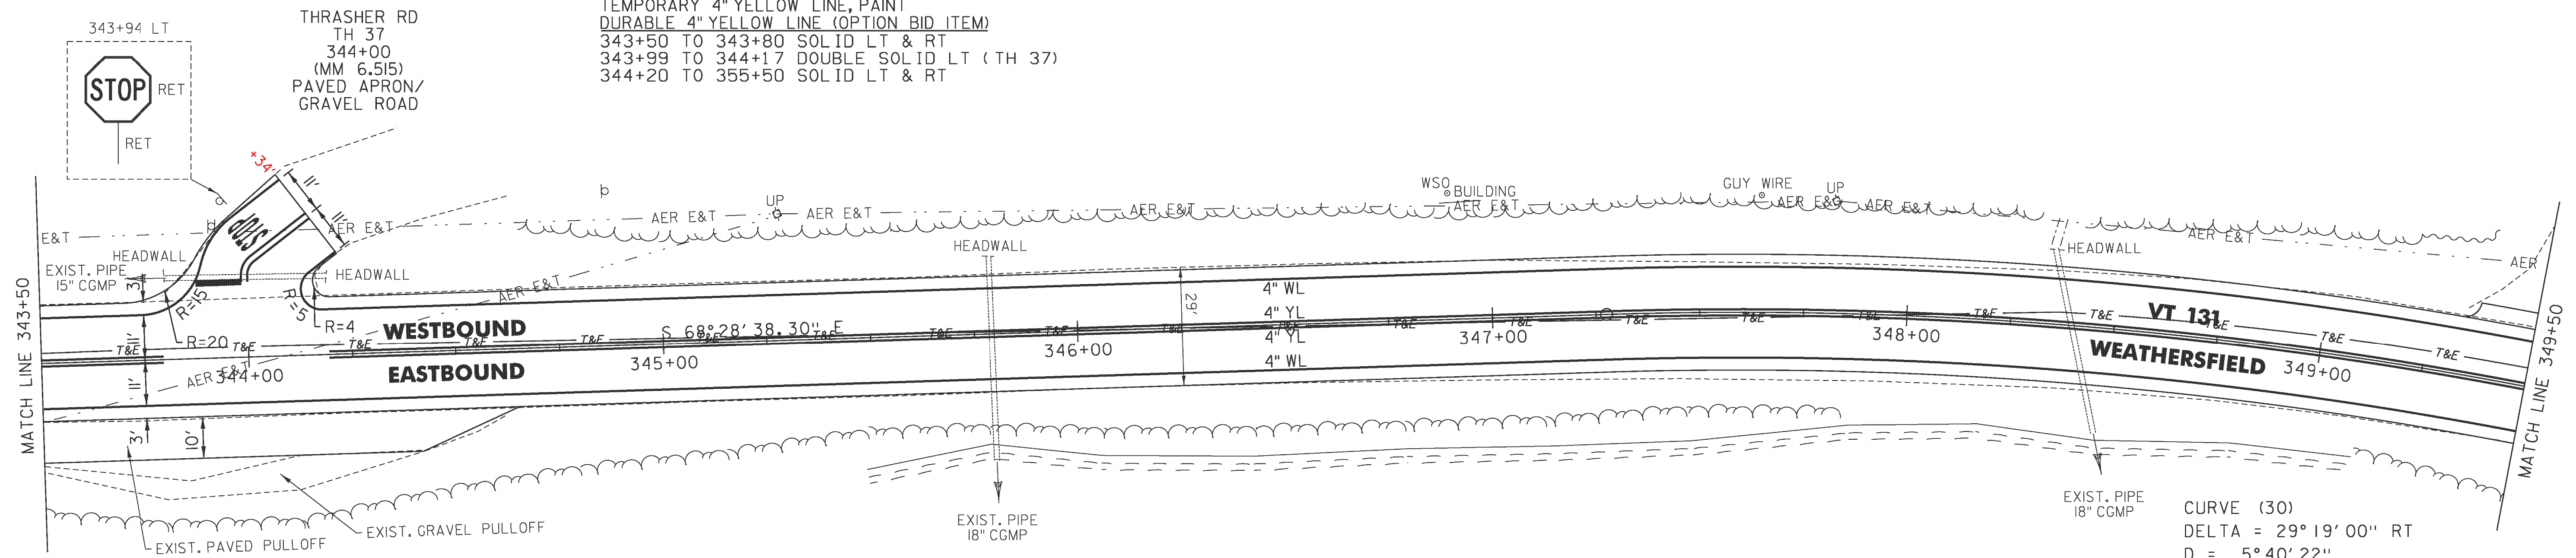

CURVE (30)
 DELTA = 29° 19' 00" RT
 D = 5° 40' 22"
 R = 1010.00'
 T = 264.18'
 L = 516.79'
 E = 33.98'
 BANK = 0.075

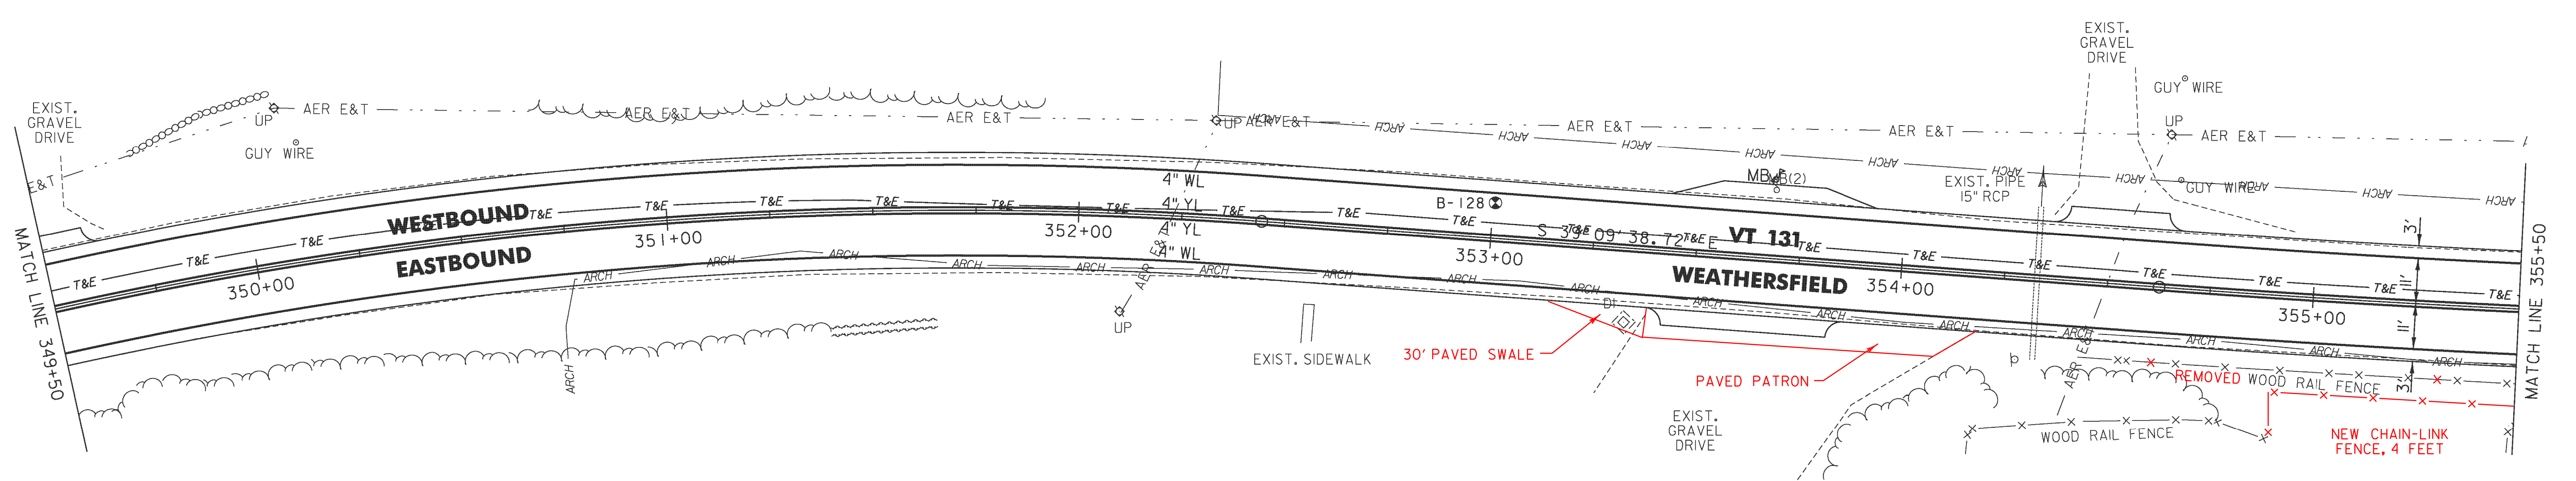

LEGEND

- R = REMOVE EXISTING
- S = SALVAGE
- R&S = REMOVE AND SALVAGE
- N = NEW
- RET = RETAIN
- B-B = BACK TO BACK
- = EXISTING GUARDRAIL
- = PROPOSED GUARDRAIL
- YL = YELLOW LINE
- WL = WHITE LINE
- = DELINEATOR
- ⋯ = UNDERDRAIN
- = BORING

ROADWAY LAYOUT SHEET 26

PROJECT NAME: WEATHERSFIELD
 PROJECT NUMBER: STP 2913(1)
 FILE NAME: I0c228.dgn
 PROJECT LEADER: PTS
 DESIGNED BY: NLL
 IPARM FILE NAME: pI0c228.59
 PLOT DATE: 3/7/2013
 DRAWN BY: WWG
 CHECKED BY: PTS
 SHEET 59 OF 234

NOT TO SCALE