

TEMPORARY 4" WHITE LINE, PAINT
 DURABLE 4" WHITE LINE (OPTION BID ITEM)
 355+50 TO 367+50 SOLID LT
 355+50 TO 367+50 SOLID RT

STONE FILL, TYPE I
 GEOTEXTILE UNDER STONE FILL
 358+75 TO 360+00 RT
 362+00 TO 366+00 RT

REMOVAL OF EXISTING FENCE
 355+50 TO 355+97 RT
 356+18 TO 358+33 RT
 STEEL BEAM GUARDRAIL, GALVANIZED
 W/8 FEET POSTS
 357+93 TO 367+50 RT

ANCHOR FOR STEEL BEAM RAIL
 357+93 RT
 REMOVAL AND DISPOSAL OF GUARDRAIL
 358+43 TO 367+50 RT



DELINEATOR WITH STEEL POST
 357+93 RT

TEMPORARY 4" YELLOW LINE, PAINT
 DURABLE 4" YELLOW LINE (OPTION BID ITEM)
 355+50 TO 367+50 SOLID LT & RT

6 INCH UNDERDRAIN PIPE
 364+25 TO 367+50 LT

CURVE (31)
 DELTA = 5°58'24" LT
 D = 1°41'07"
 R = 3400.00'
 T = 177.39'
 L = 354.46'
 E = 4.62'
 BANK = 0.023

CURVE (32)
 DELTA = 7°41'11" LT
 D = 5°12'31"
 R = 1100.00'
 T = 73.90'
 L = 147.57'
 E = 2.48'
 BANK = 0.056

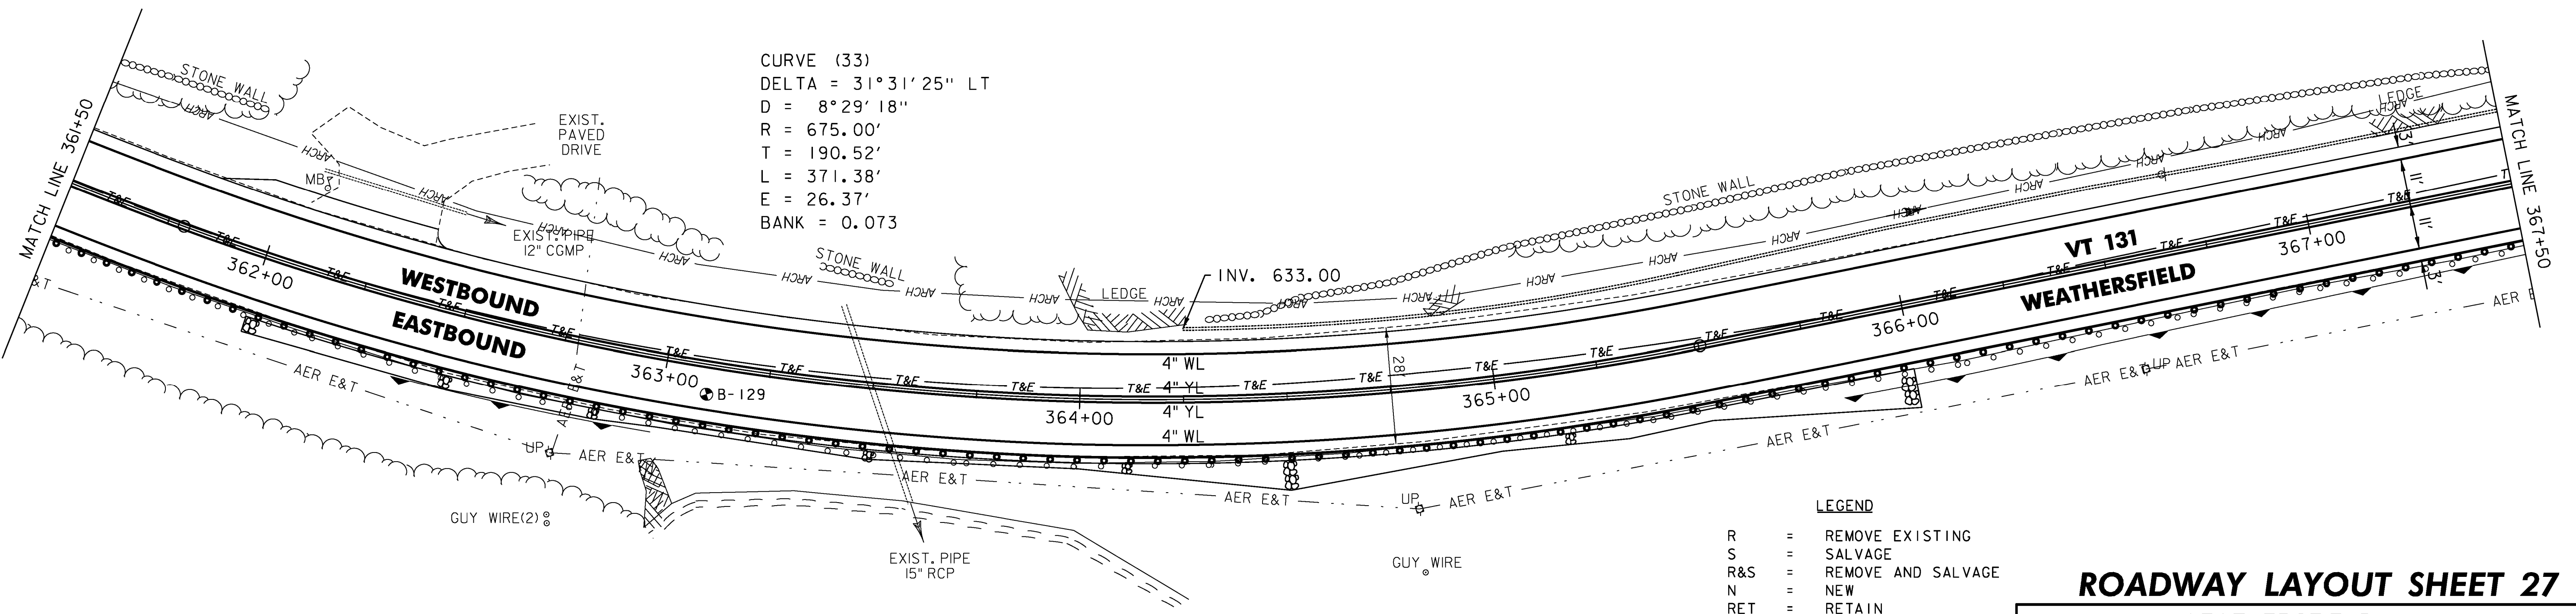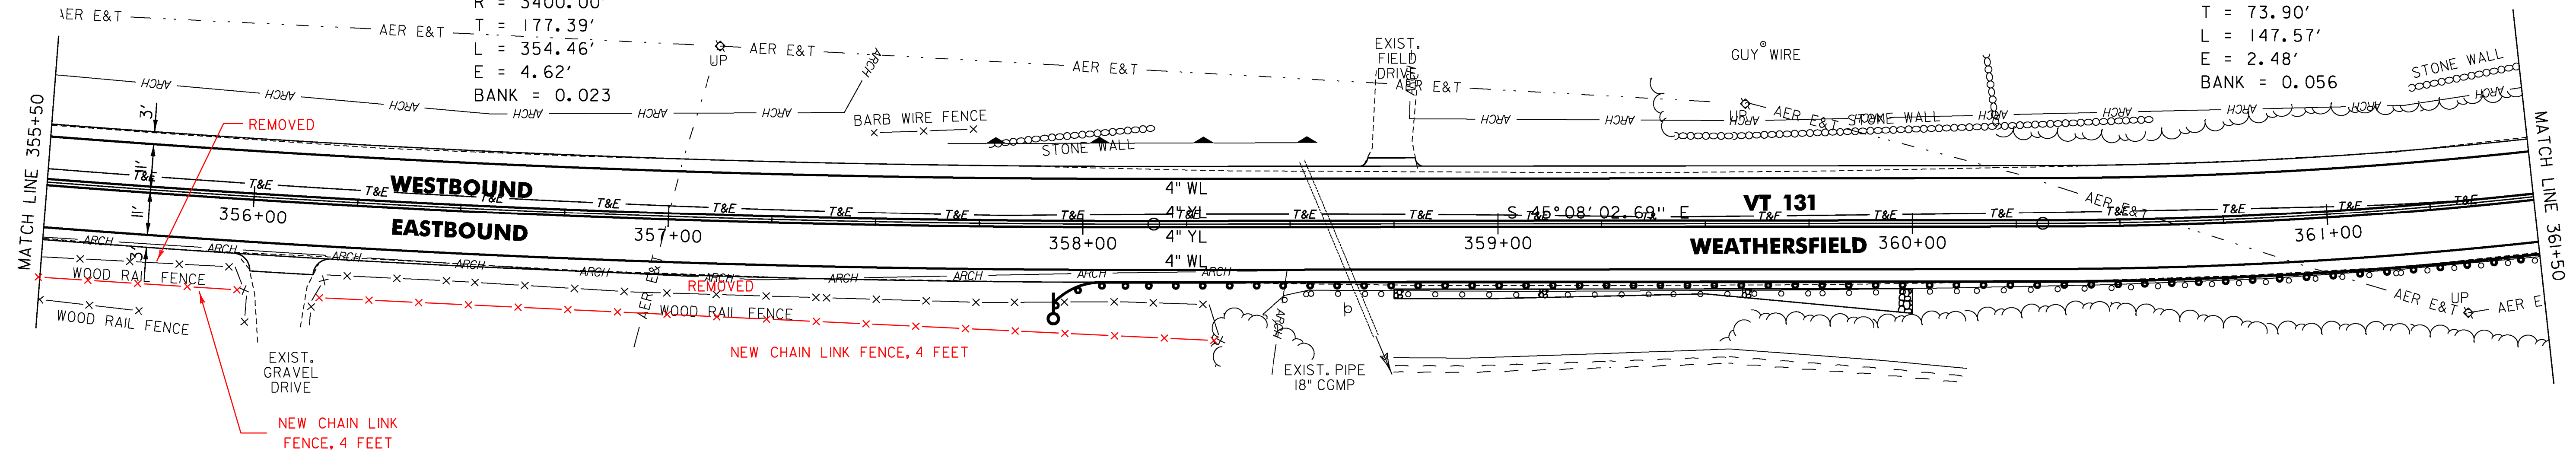

CURVE (33)
 DELTA = 31°31'25" LT
 D = 8°29'18"
 R = 675.00'
 T = 190.52'
 L = 371.38'
 E = 26.37'
 BANK = 0.073

LEGEND

- R = REMOVE EXISTING
- S = SALVAGE
- R&S = REMOVE AND SALVAGE
- N = NEW
- RET = RETAIN
- B-B = BACK TO BACK
- = EXISTING GUARDRAIL
- ⊕ = PROPOSED GUARDRAIL
- YL = YELLOW LINE
- WL = WHITE LINE
- = DELINEATOR
- ⋯ = UNDERDRAIN
- ⊙ = BORING

ROADWAY LAYOUT SHEET 27

PROJECT NAME: WEATHERSFIELD
 PROJECT NUMBER: STP 2913(1)

FILE NAME: I0c228.dgn
 PROJECT LEADER: PTS
 DESIGNED BY: NLL
 IPARM FILE NAME: pI0c228_60

PLOT DATE: 3/7/2013
 DRAWN BY: WWG
 CHECKED BY: PTS
 SHEET 60 OF 234

NOT TO SCALE