


TEMPORARY 4" WHITE LINE, PAINT  
 DURABLE 4" WHITE LINE (OPTION BID ITEM)  
 427+50 TO 428+75 SOLID LT  
 427+50 TO 428+75 SOLID RT

TEMPORARY 4" YELLOW LINE, PAINT  
 DURABLE 4" YELLOW LINE (OPTION BID ITEM)  
 427+50 TO 428+75 SOLID LT & RT

**428+75.00 (MM 8.120) VT ROUTE 131**  
**VT ROUTE 131 END PROJECT NH 2948(1) BEGIN PROJECT**  
**STP 2913(1)**

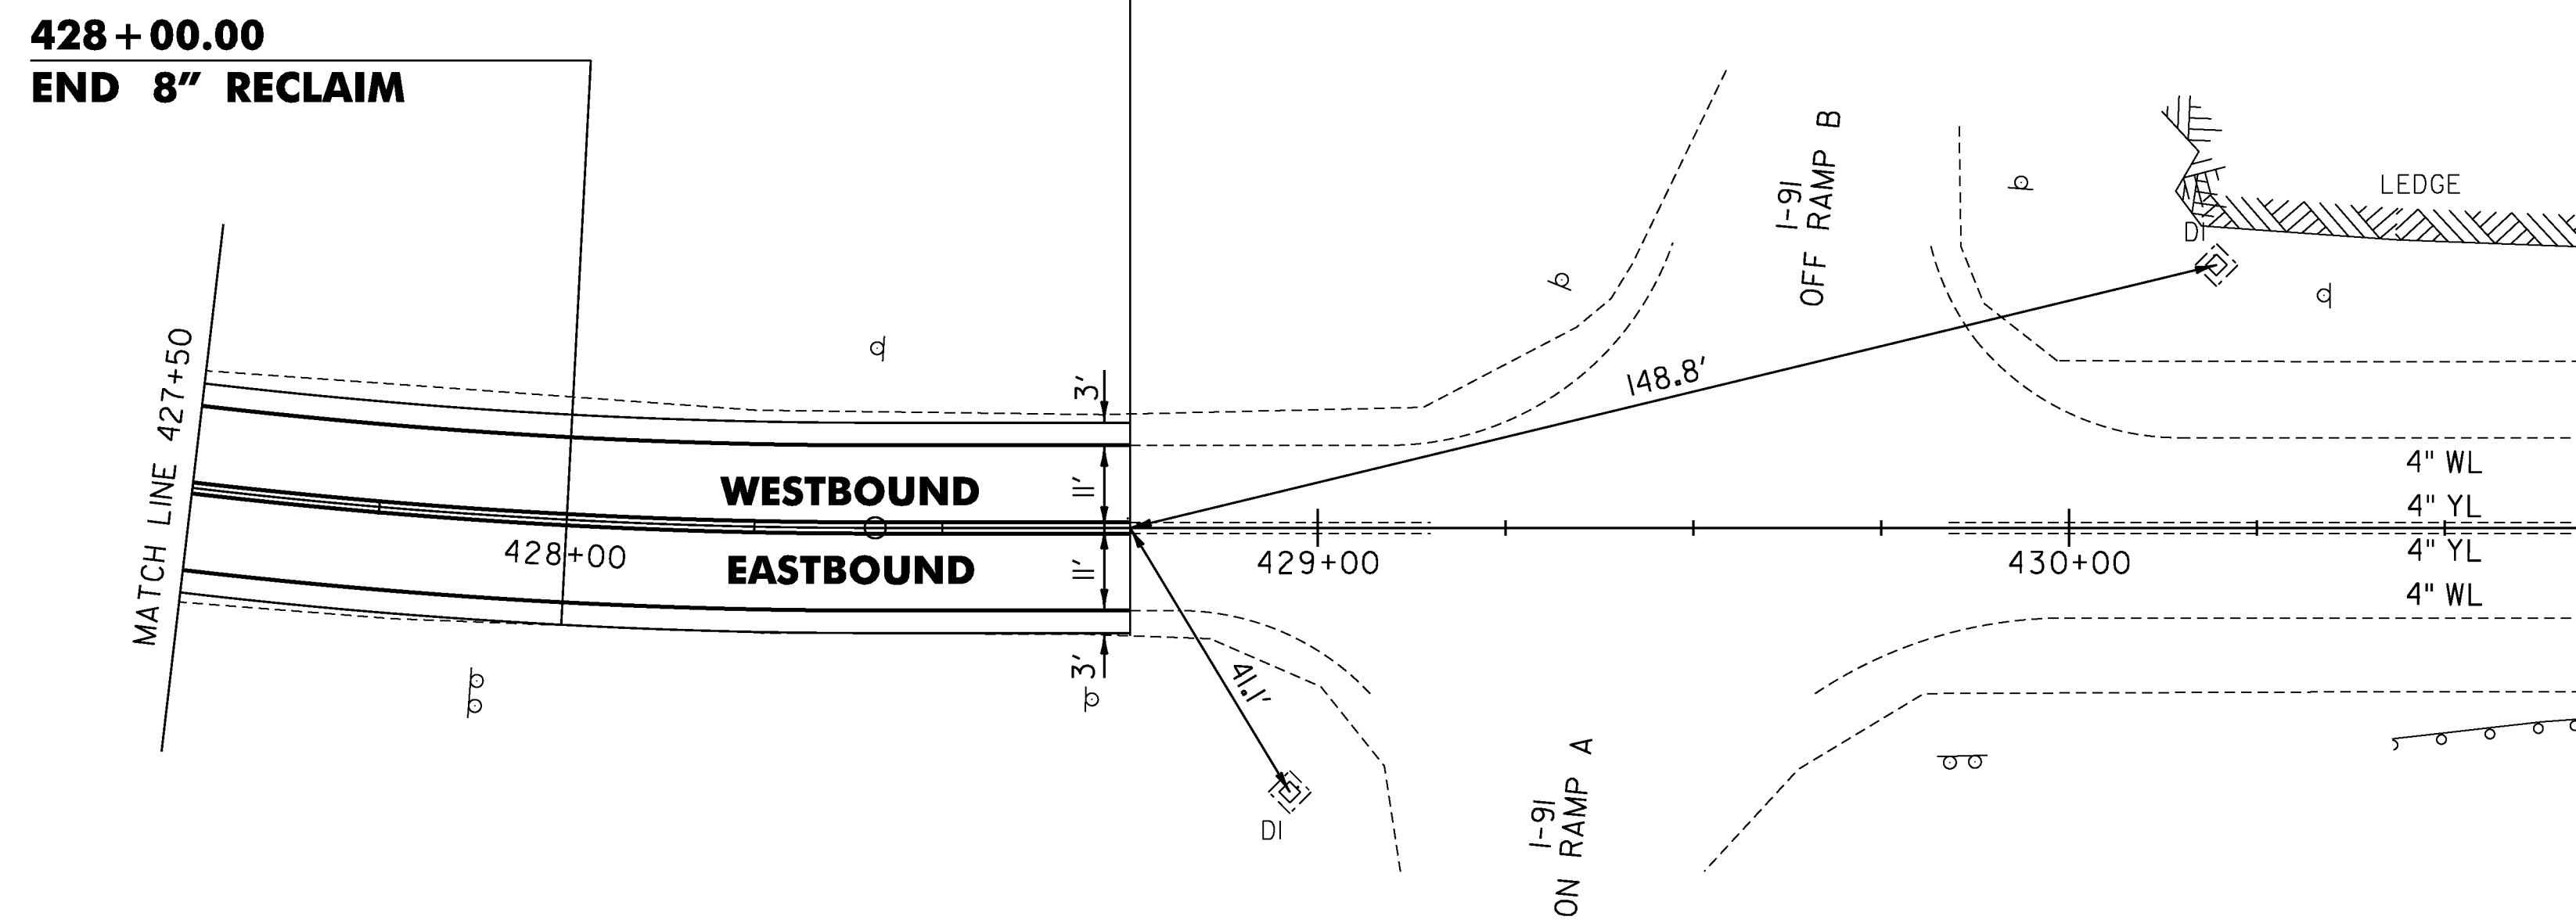

**LEGEND**

- R = REMOVE EXISTING
- S = SALVAGE
- R&S = REMOVE AND SALVAGE
- N = NEW
- RET = RETAIN
- B-B = BACK TO BACK
- = EXISTING GUARDRAIL
- = PROPOSED GUARDRAIL
- YL = YELLOW LINE
- WL = WHITE LINE
- = DELINEATOR
- = UNDERDRAIN
- ⊙ = BORING

**ROADWAY LAYOUT SHEET 33**

PROJECT NAME: WEATHERSFIELD

PROJECT NUMBER: STP 2913(1)

FILE NAME: I0c228.dgn

PROJECT LEADER: PTS

DESIGNED BY: NULL

IPARM FILE NAME: pI0C228\_66

PLOT DATE: 3/7/2013

DRAWN BY: WWG

CHECKED BY: PTS

SHEET 66 OF 234

NOT TO SCALE