


CURVE 21 - WEATHERSFIELD

CURVE 22 - WEATHERSFIELD

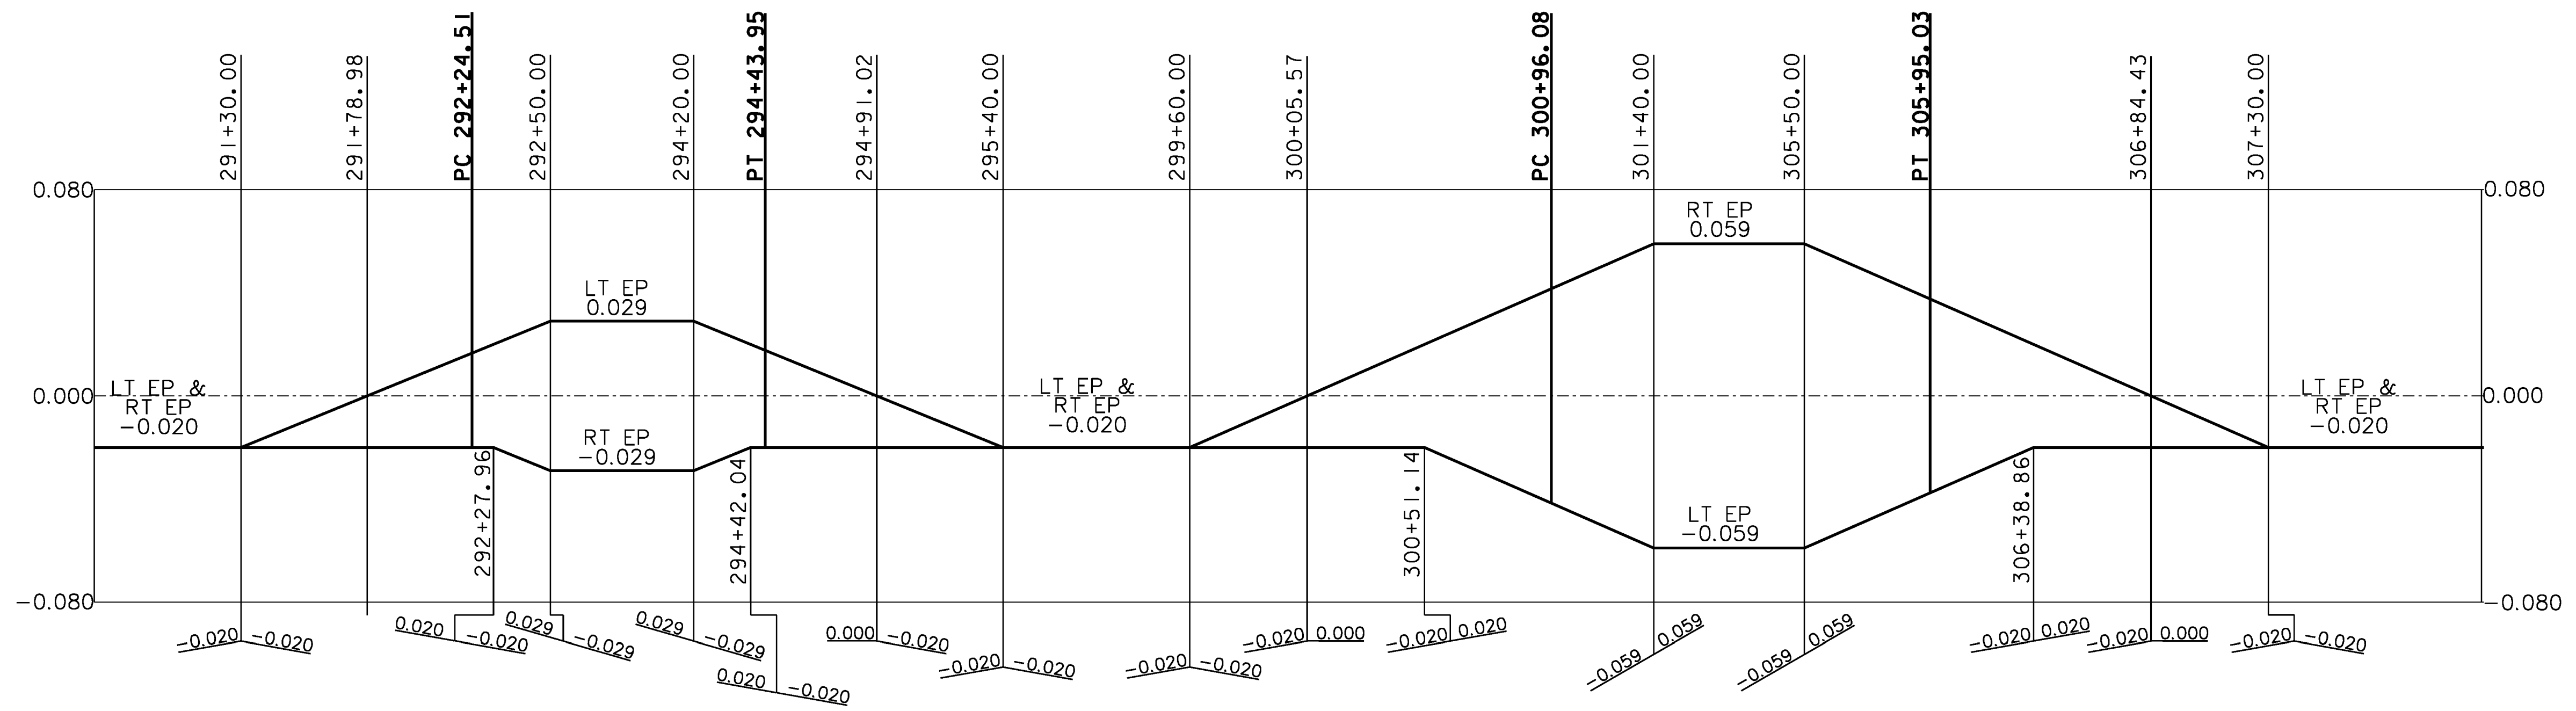

CURVE 23 - WEATHERSFIELD

CURVE 24 - WEATHERSFIELD

BANKING DIAGRAM 5

PROJECT NAME: WEATHERSFIELD	PLOT DATE: 2/7/2013
PROJECT NUMBER: STP 2913(I)	DRAWN BY: JLS
FILE NAME: I0c228.dgn	CHECKED BY: PTS
PROJECT LEADER: PTS	SHEET 73 OF 234
DESIGNED BY: NULL	
IPARM FILE NAME: p10c228_73	