


CURVE 36 - WEATHERSFIELD CURVE 37 - WEATHERSFIELD CURVE 38 - WEATHERSFIELD

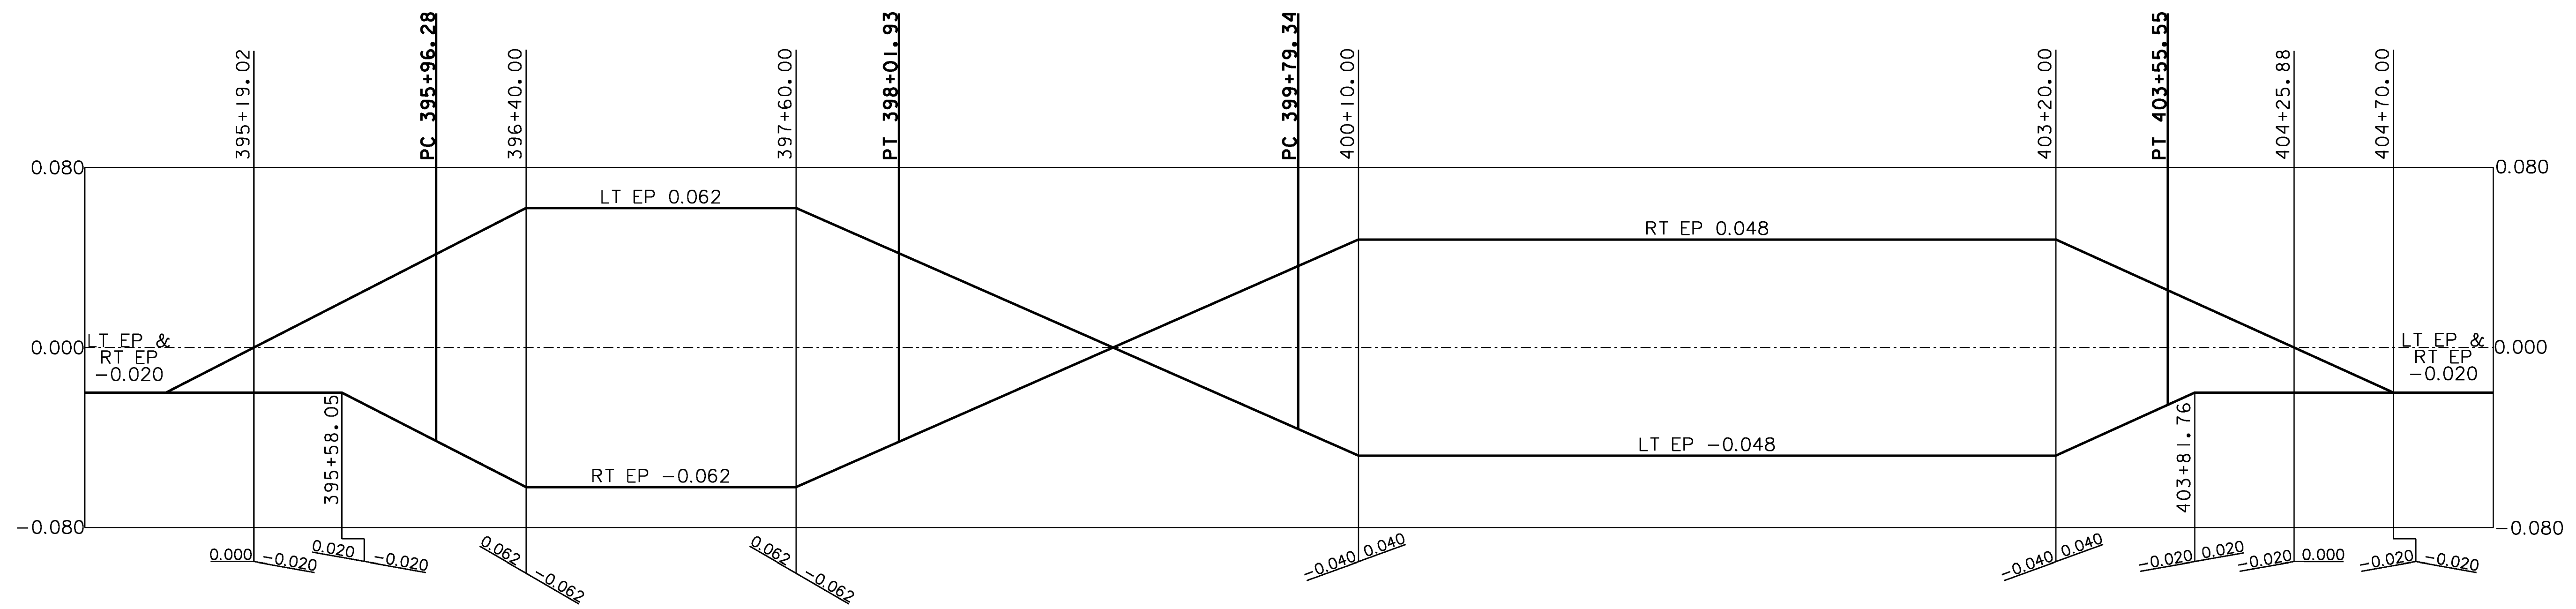

CURVE 39 - WEATHERSFIELD

CURVE 40 - WEATHERSFIELD

BANKING DIAGRAM 8

PROJECT NAME: WEATHERSFIELD	PLOT DATE: 2/7/2013
PROJECT NUMBER: STP 2913(1)	DRAWN BY: JLS
FILE NAME: I0c228.dgn	CHECKED BY: PTS
PROJECT LEADER: PTS	SHEET 76 OF 234
DESIGNED BY: NULL	
IPARM FILE NAME: pi0c228_76	