




71+00

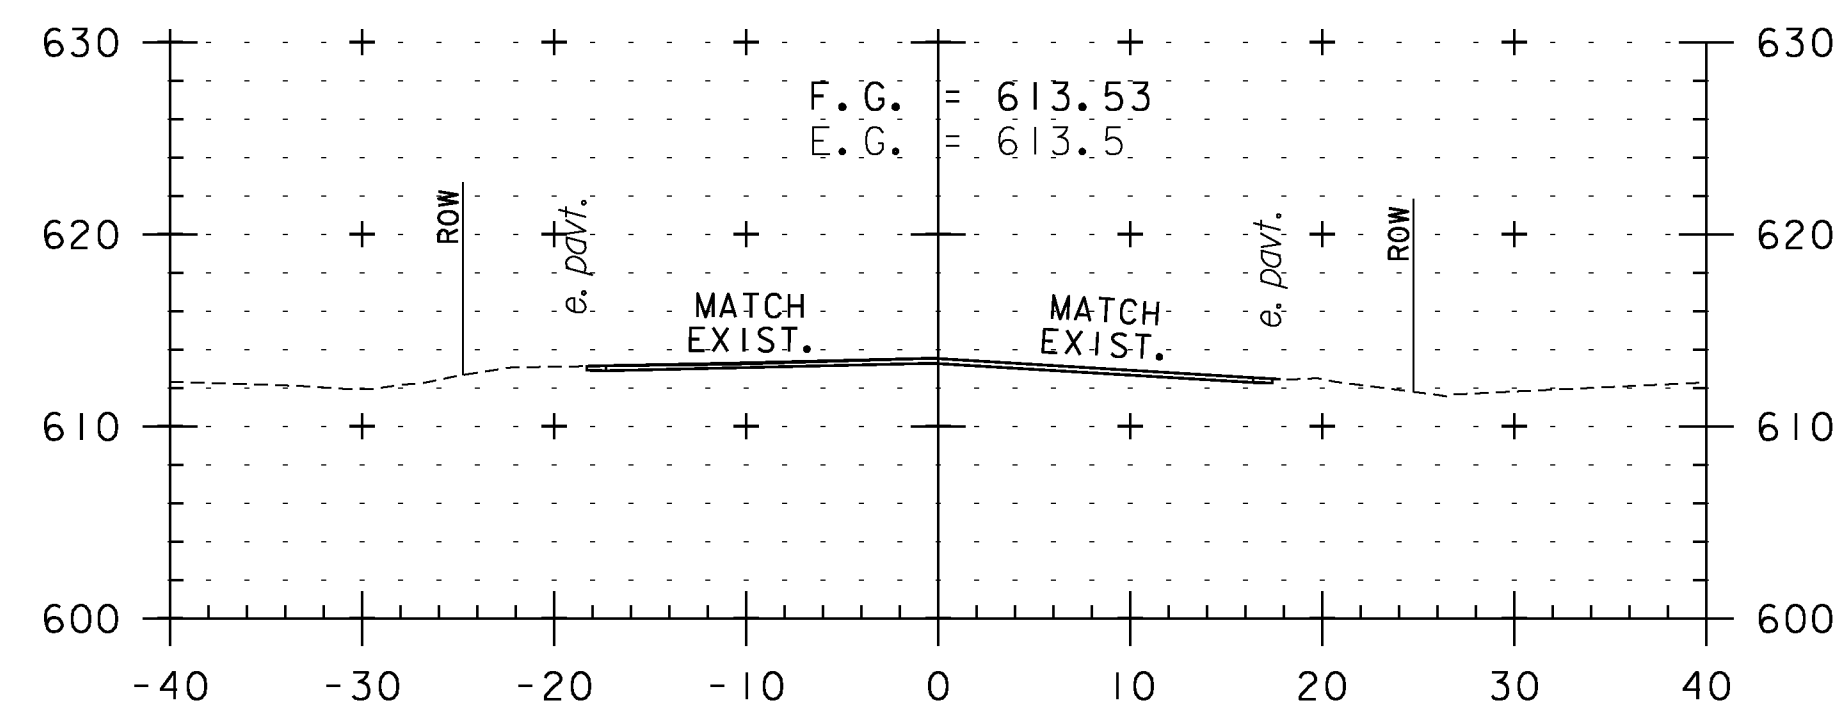


70+50

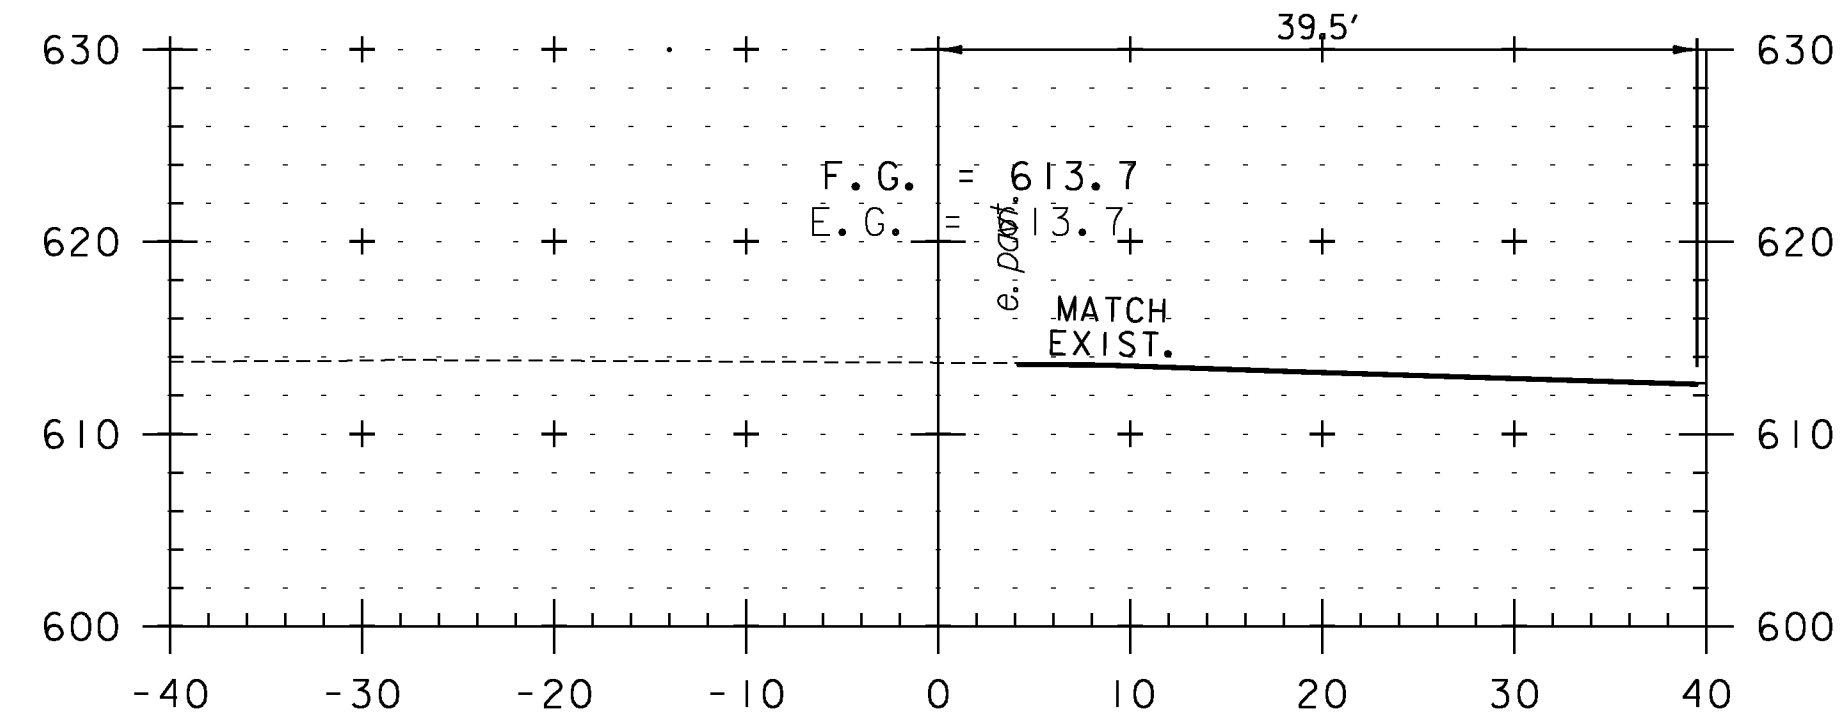


70+00  
BEGIN PROJECT

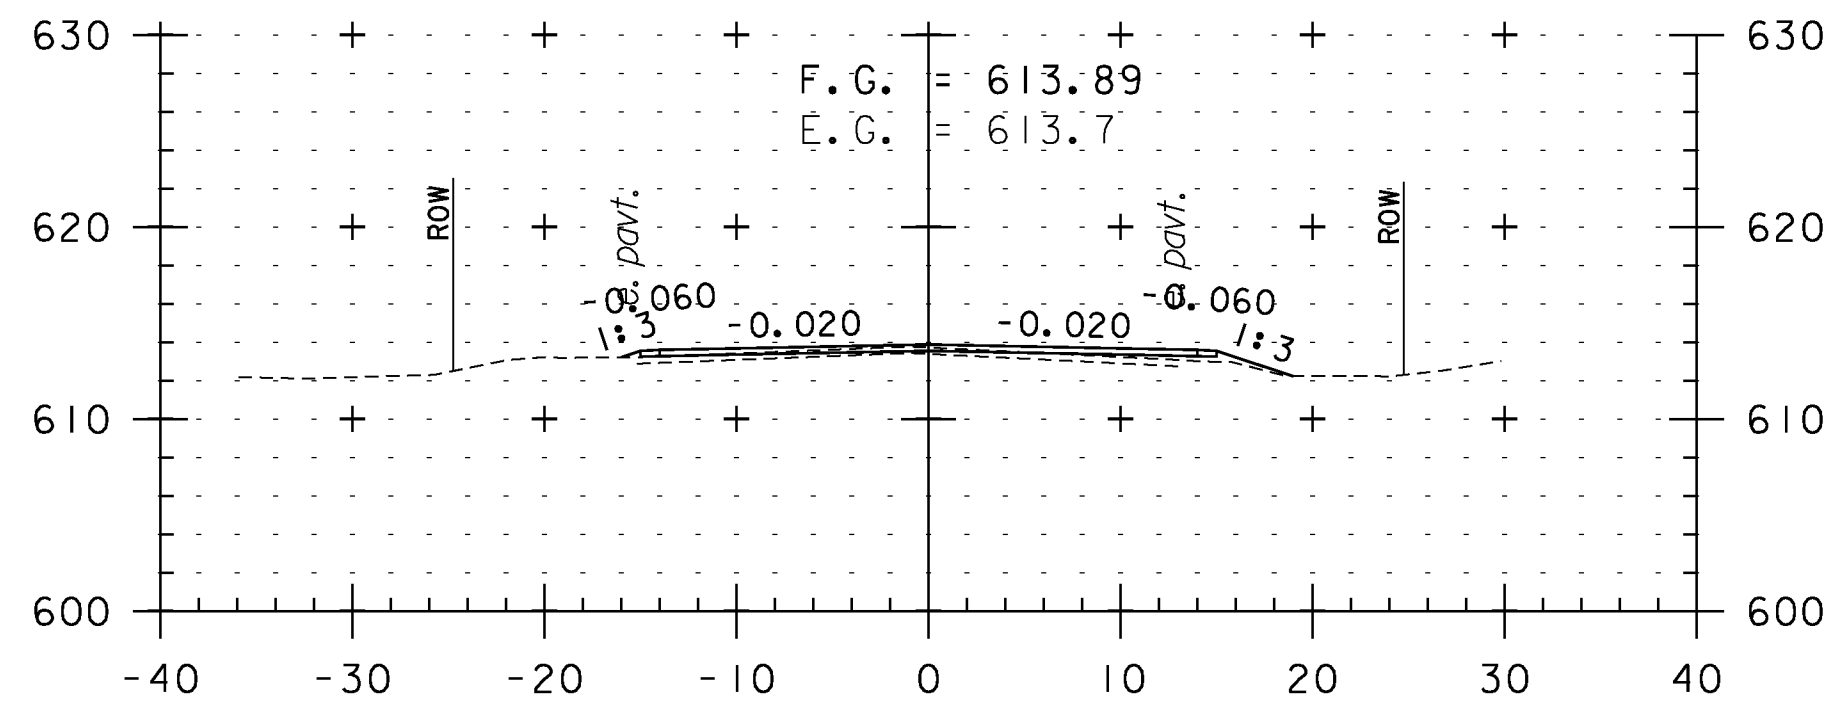


72+50

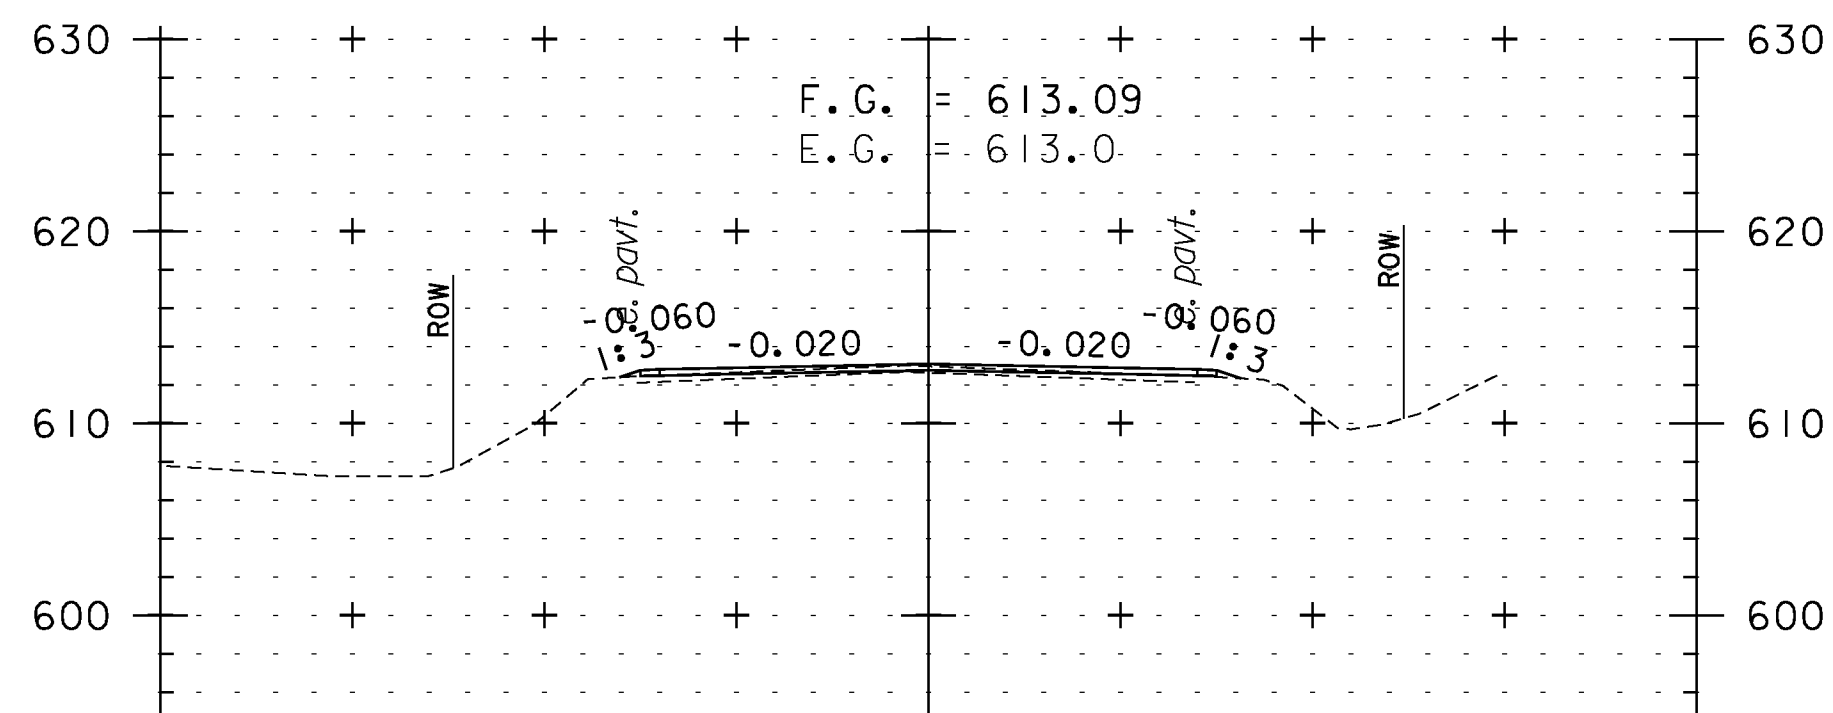


72+00

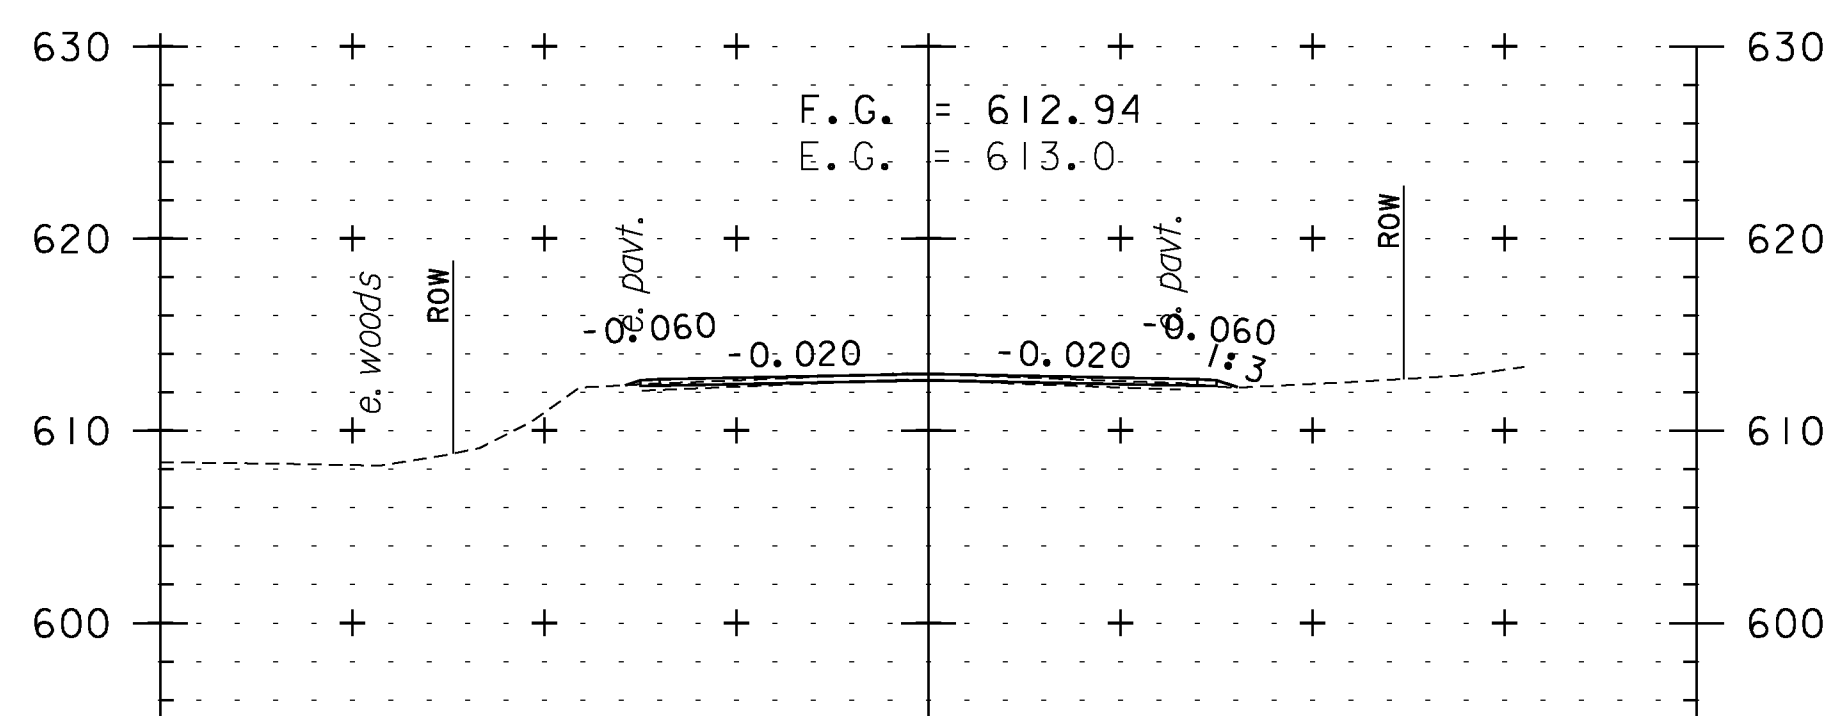


71+50

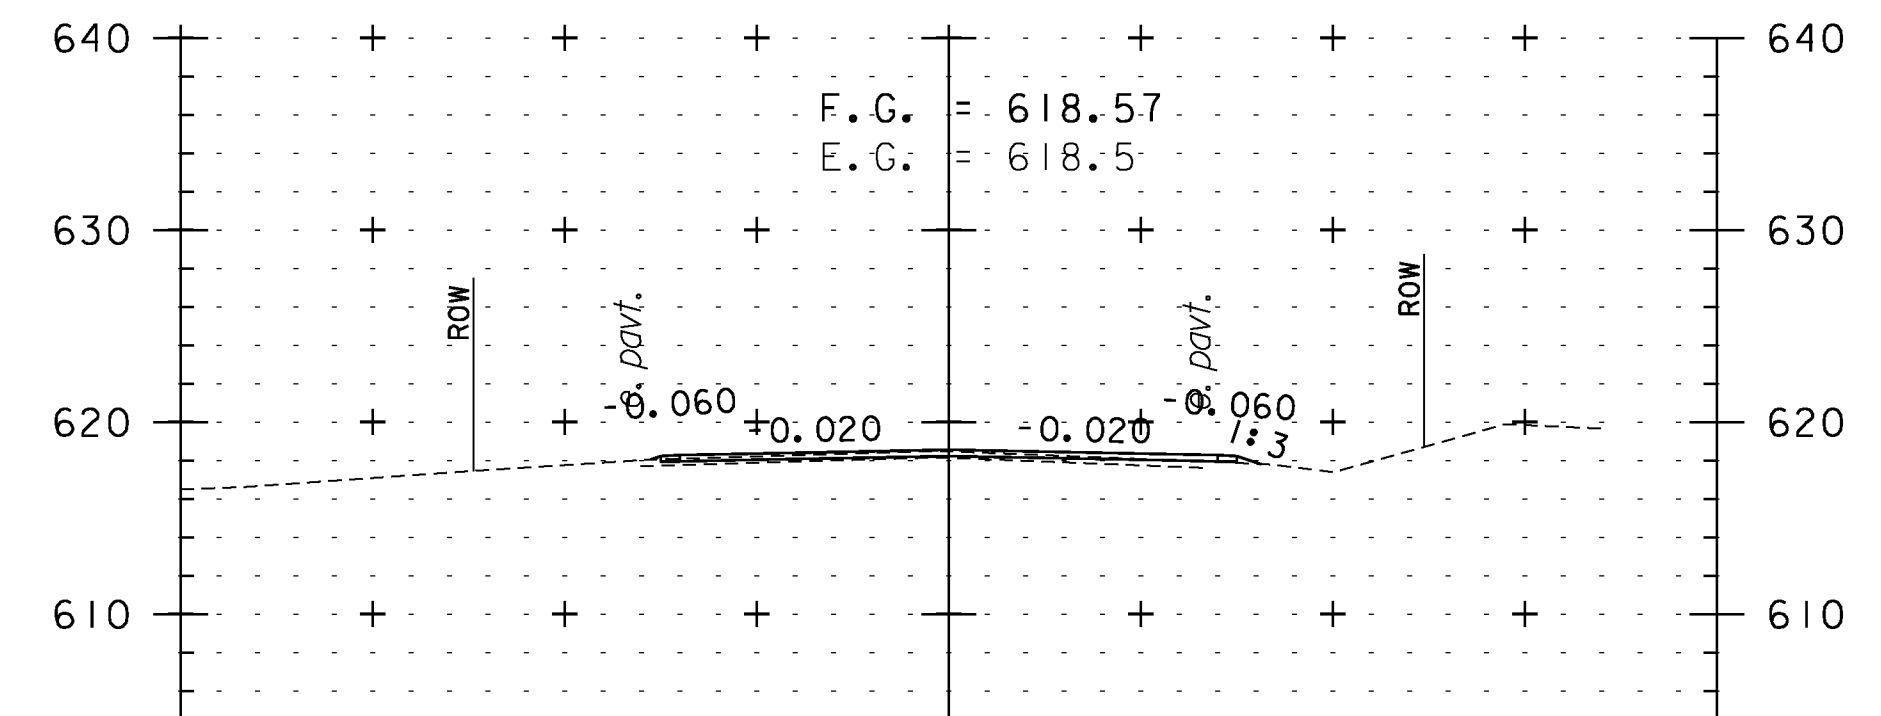

74+00

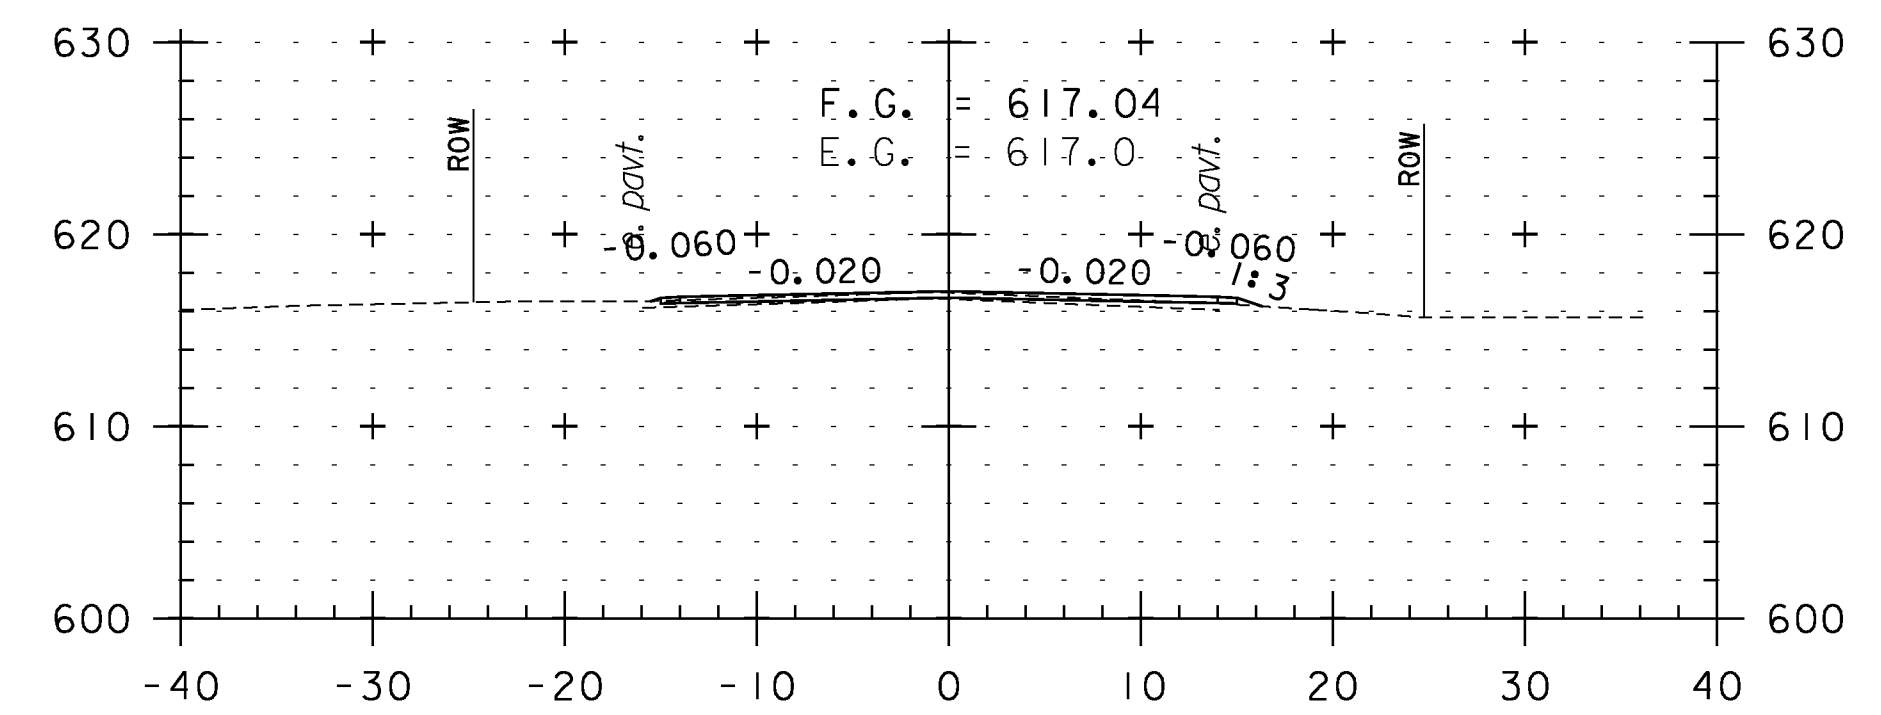

73+50

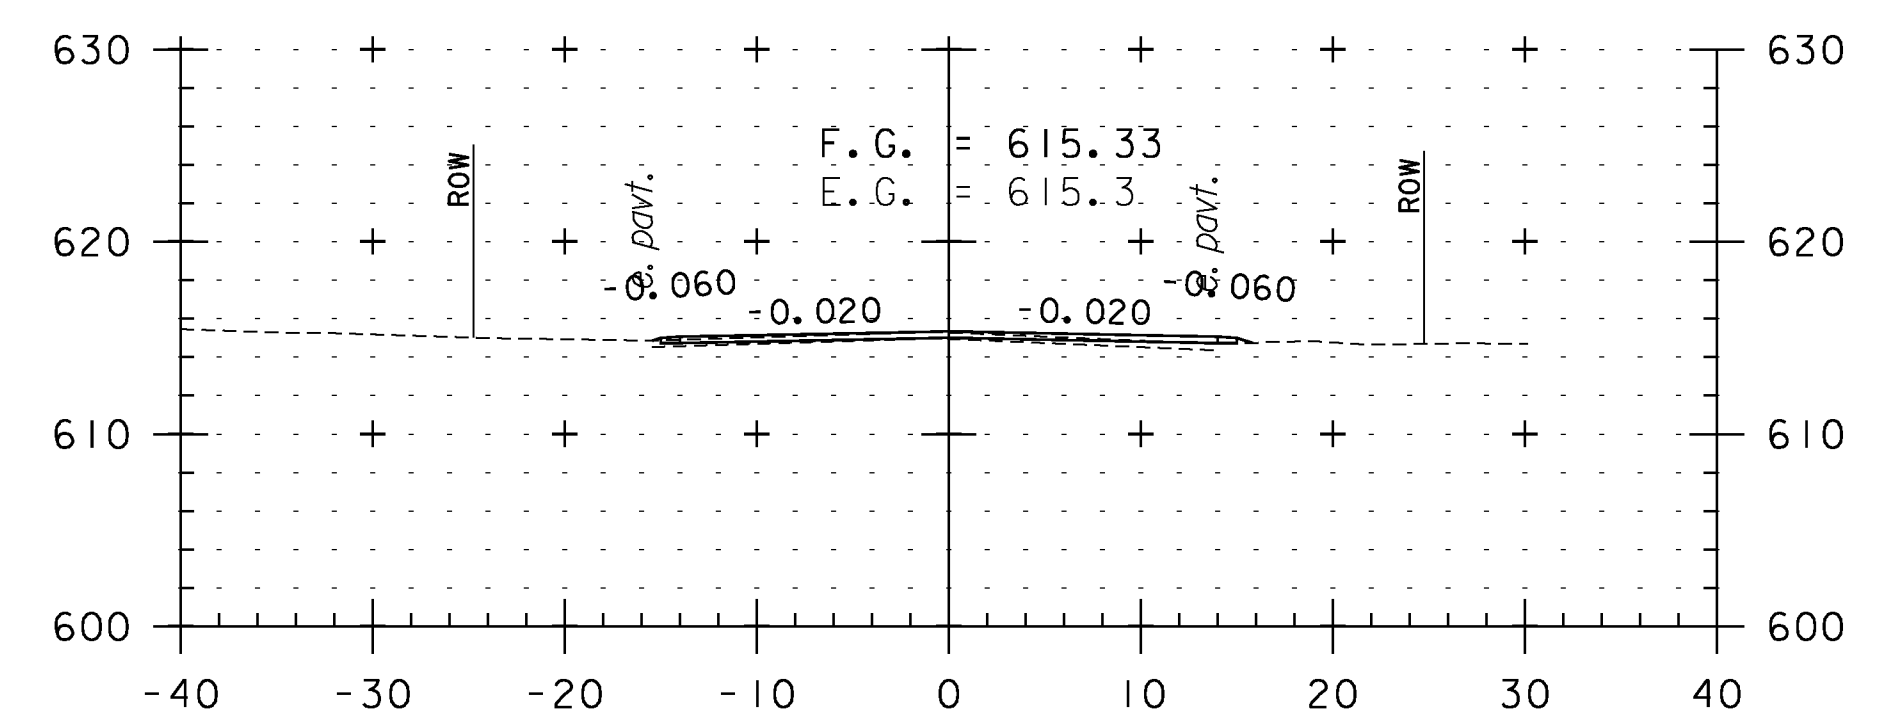

73+00

**CROSS SECTION SHEET 1**

PROJECT NAME: WEATHERSFIELD

PROJECT NUMBER: STP 2913(I)

FILE NAME: I0c228

PROJECT LEADER: PTS

DESIGNED BY: NLL

IPARM FILE NAME: pI0c228\_9I

PLOT DATE: 2/7/2013

DRAWN BY: WWG

CHECKED BY: PTS

SHEET 91 OF 234



STA. 70+00 TO STA. 74+00