




84+00

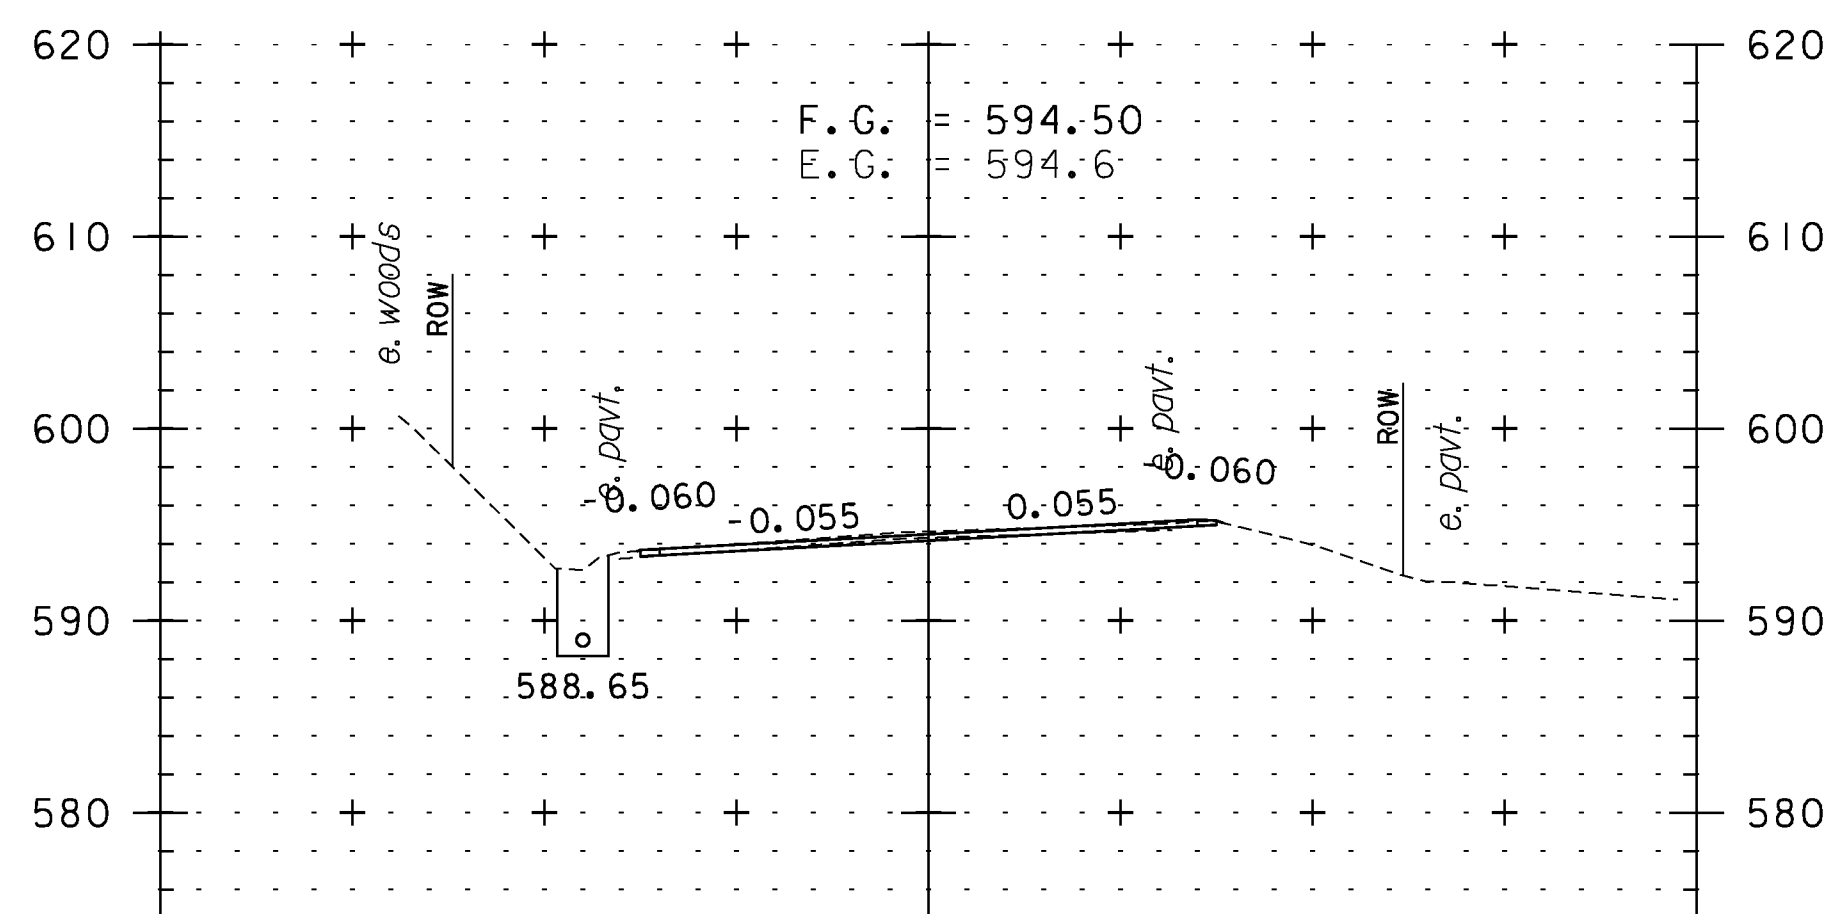


85+50

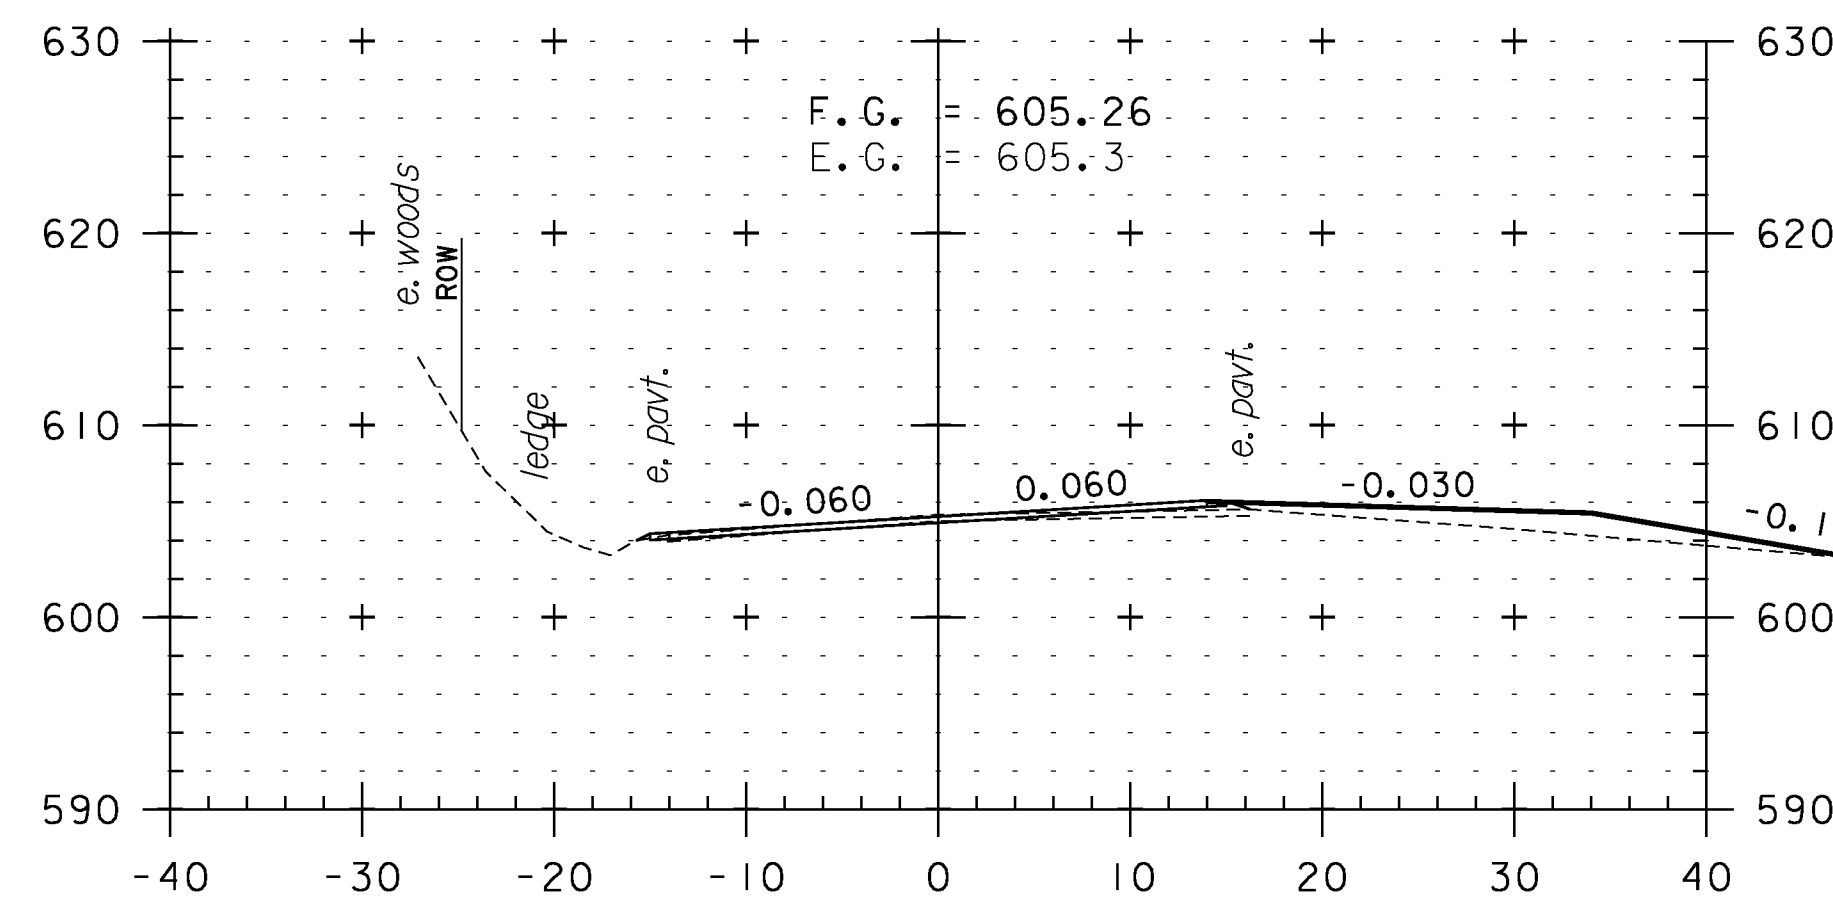


83+50  
TH 82

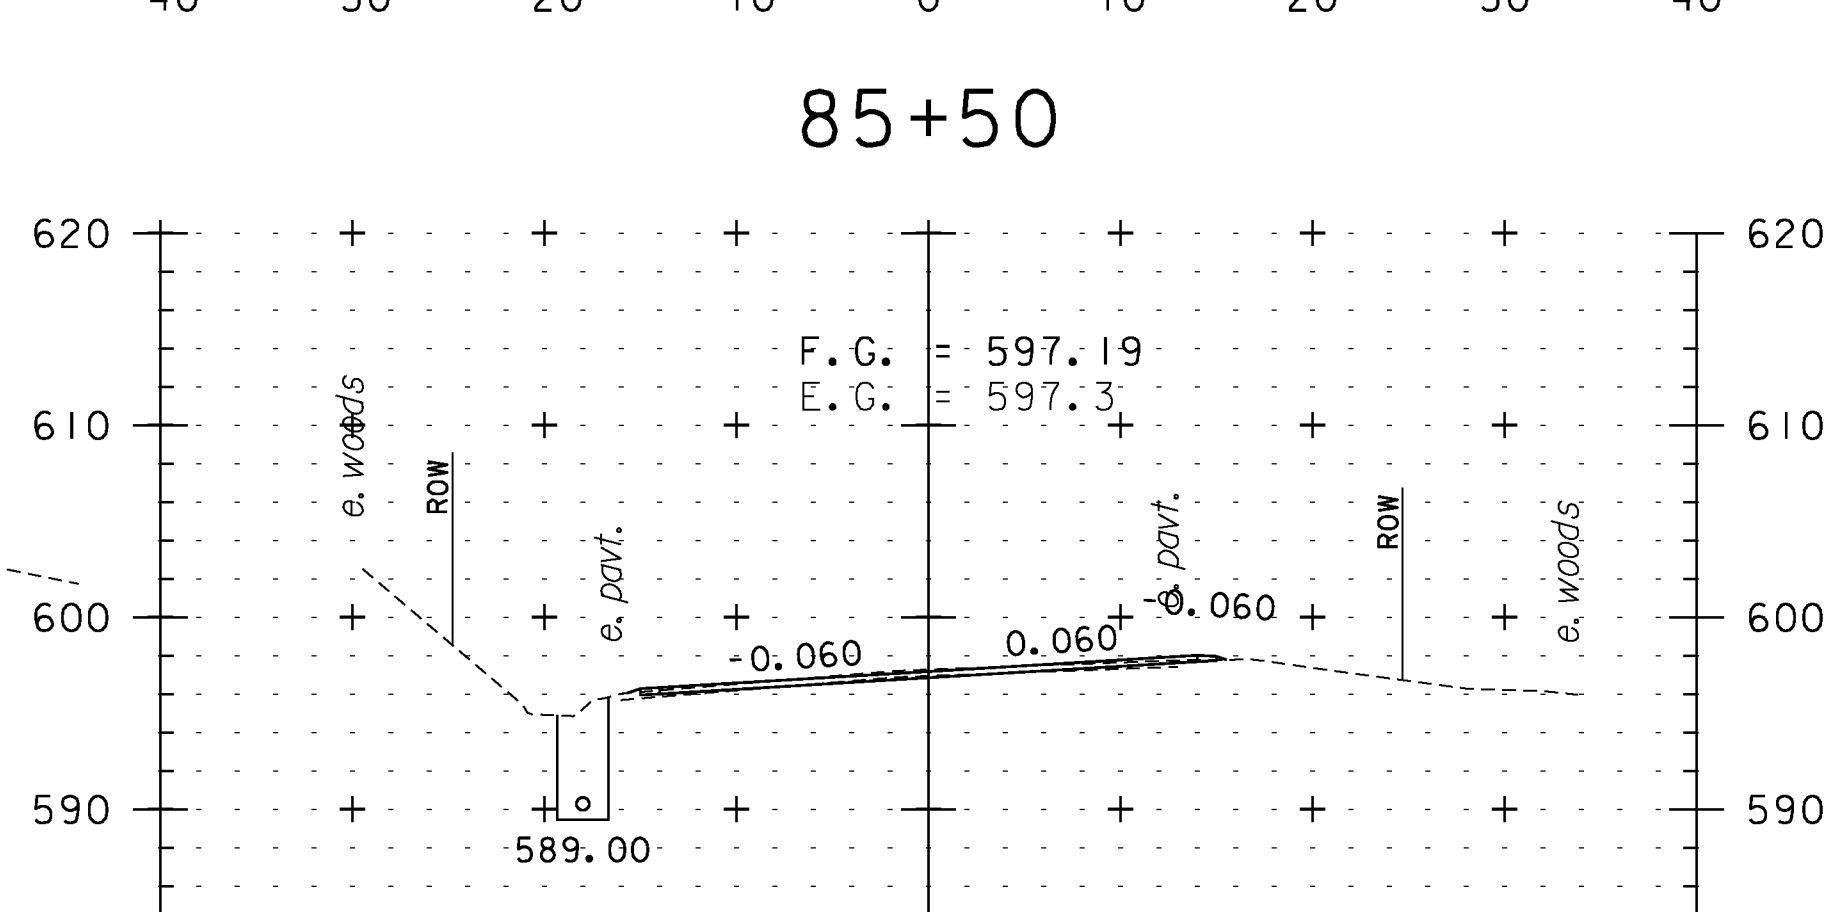


85+00

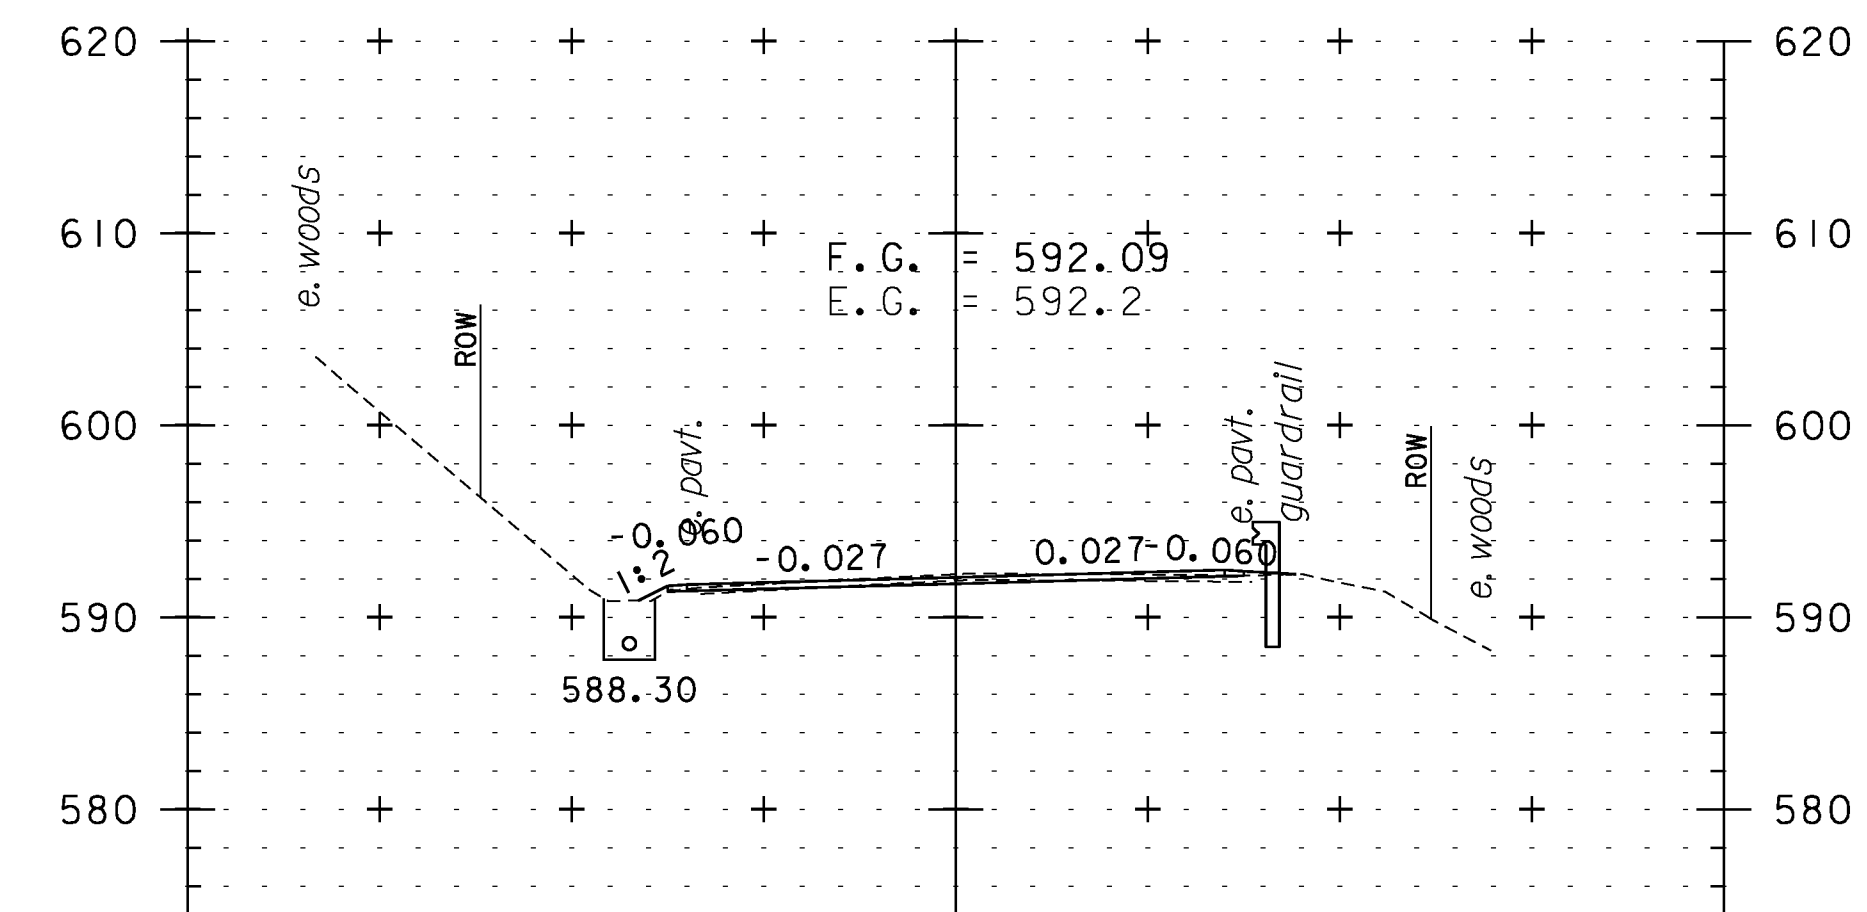


86+00

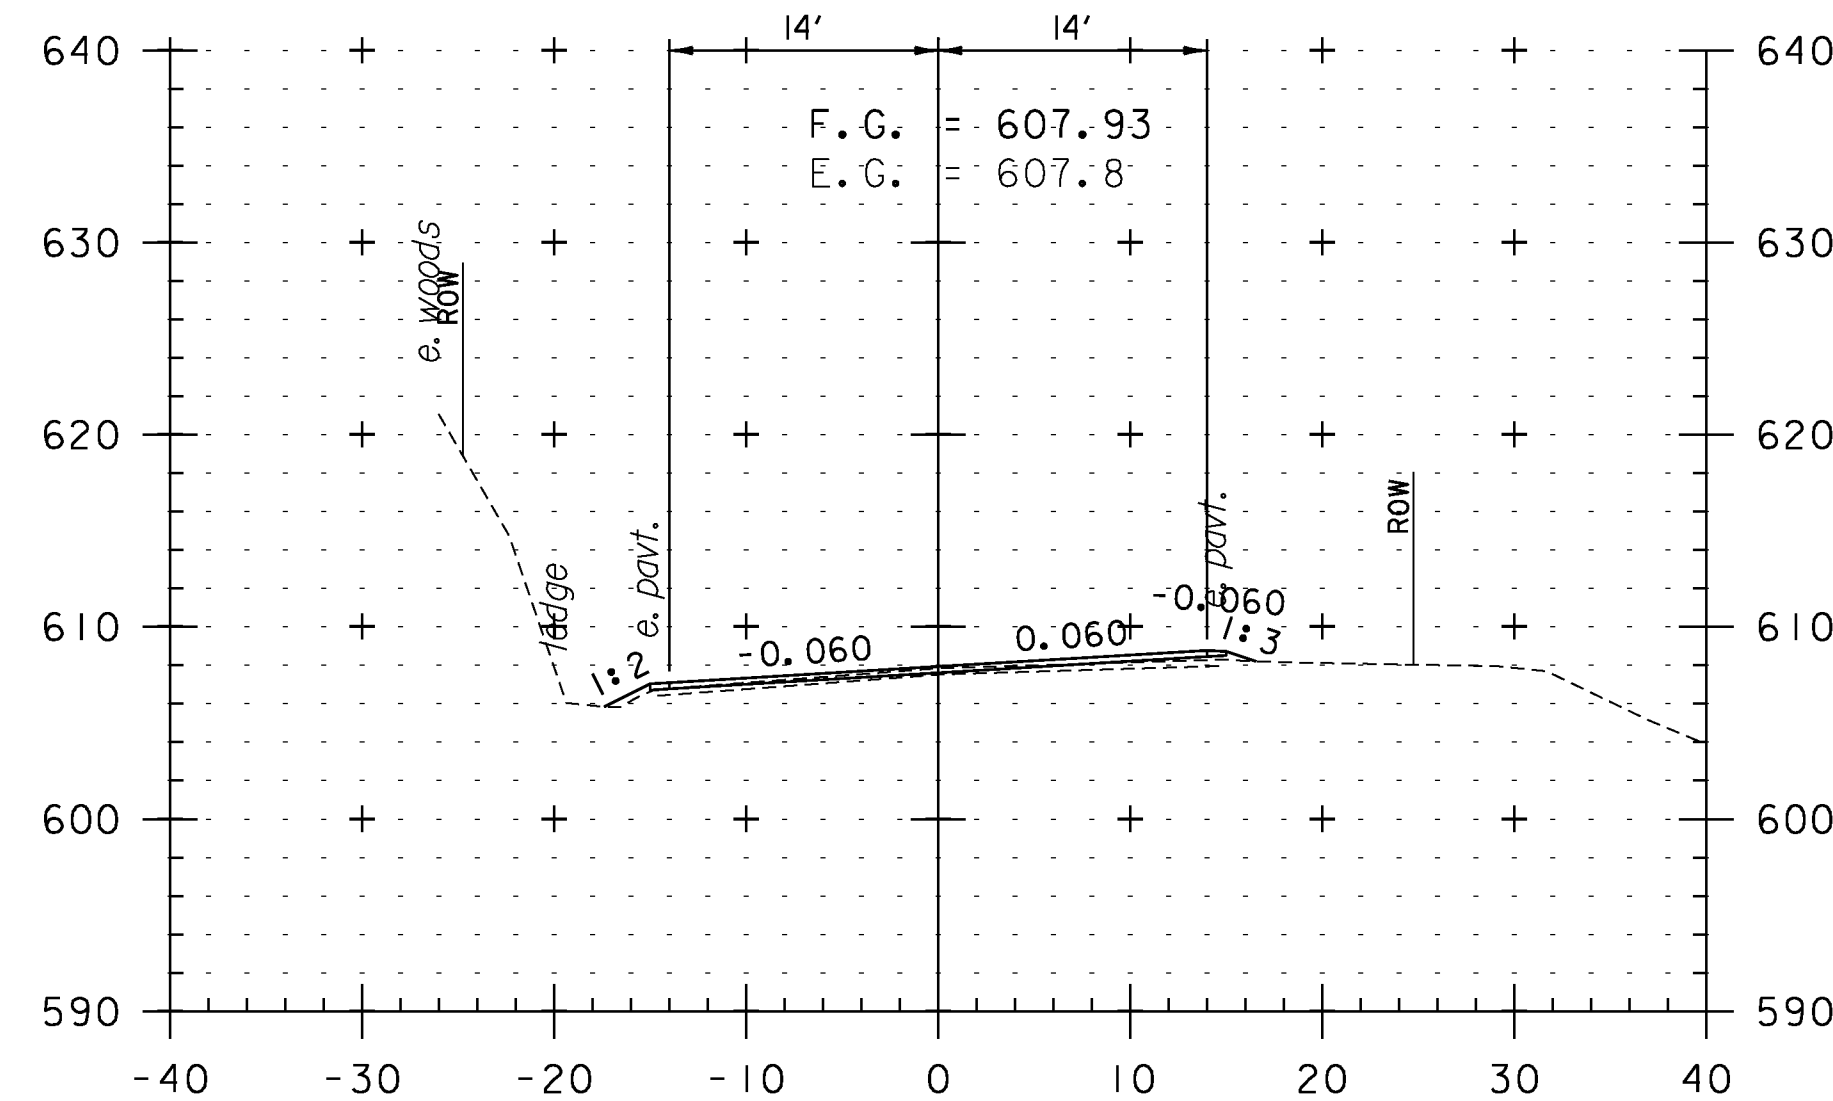

83+00

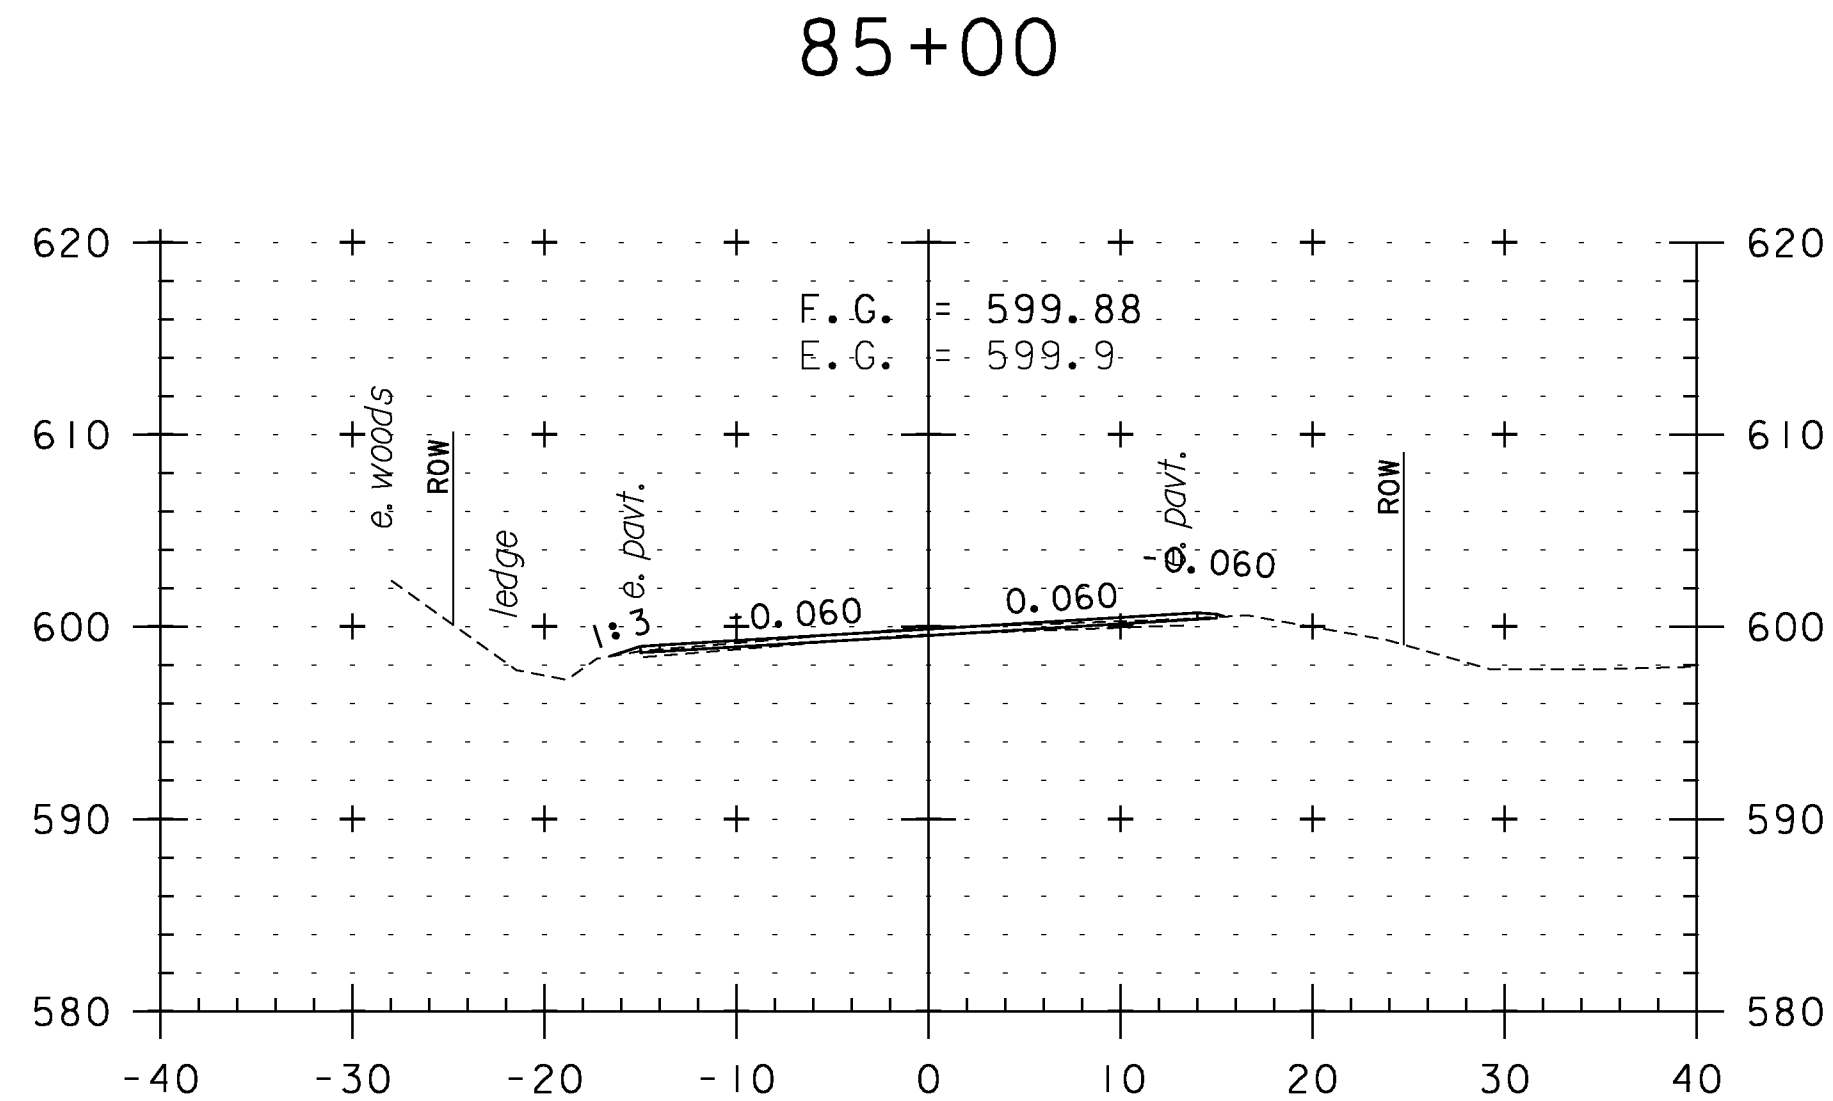

84+50

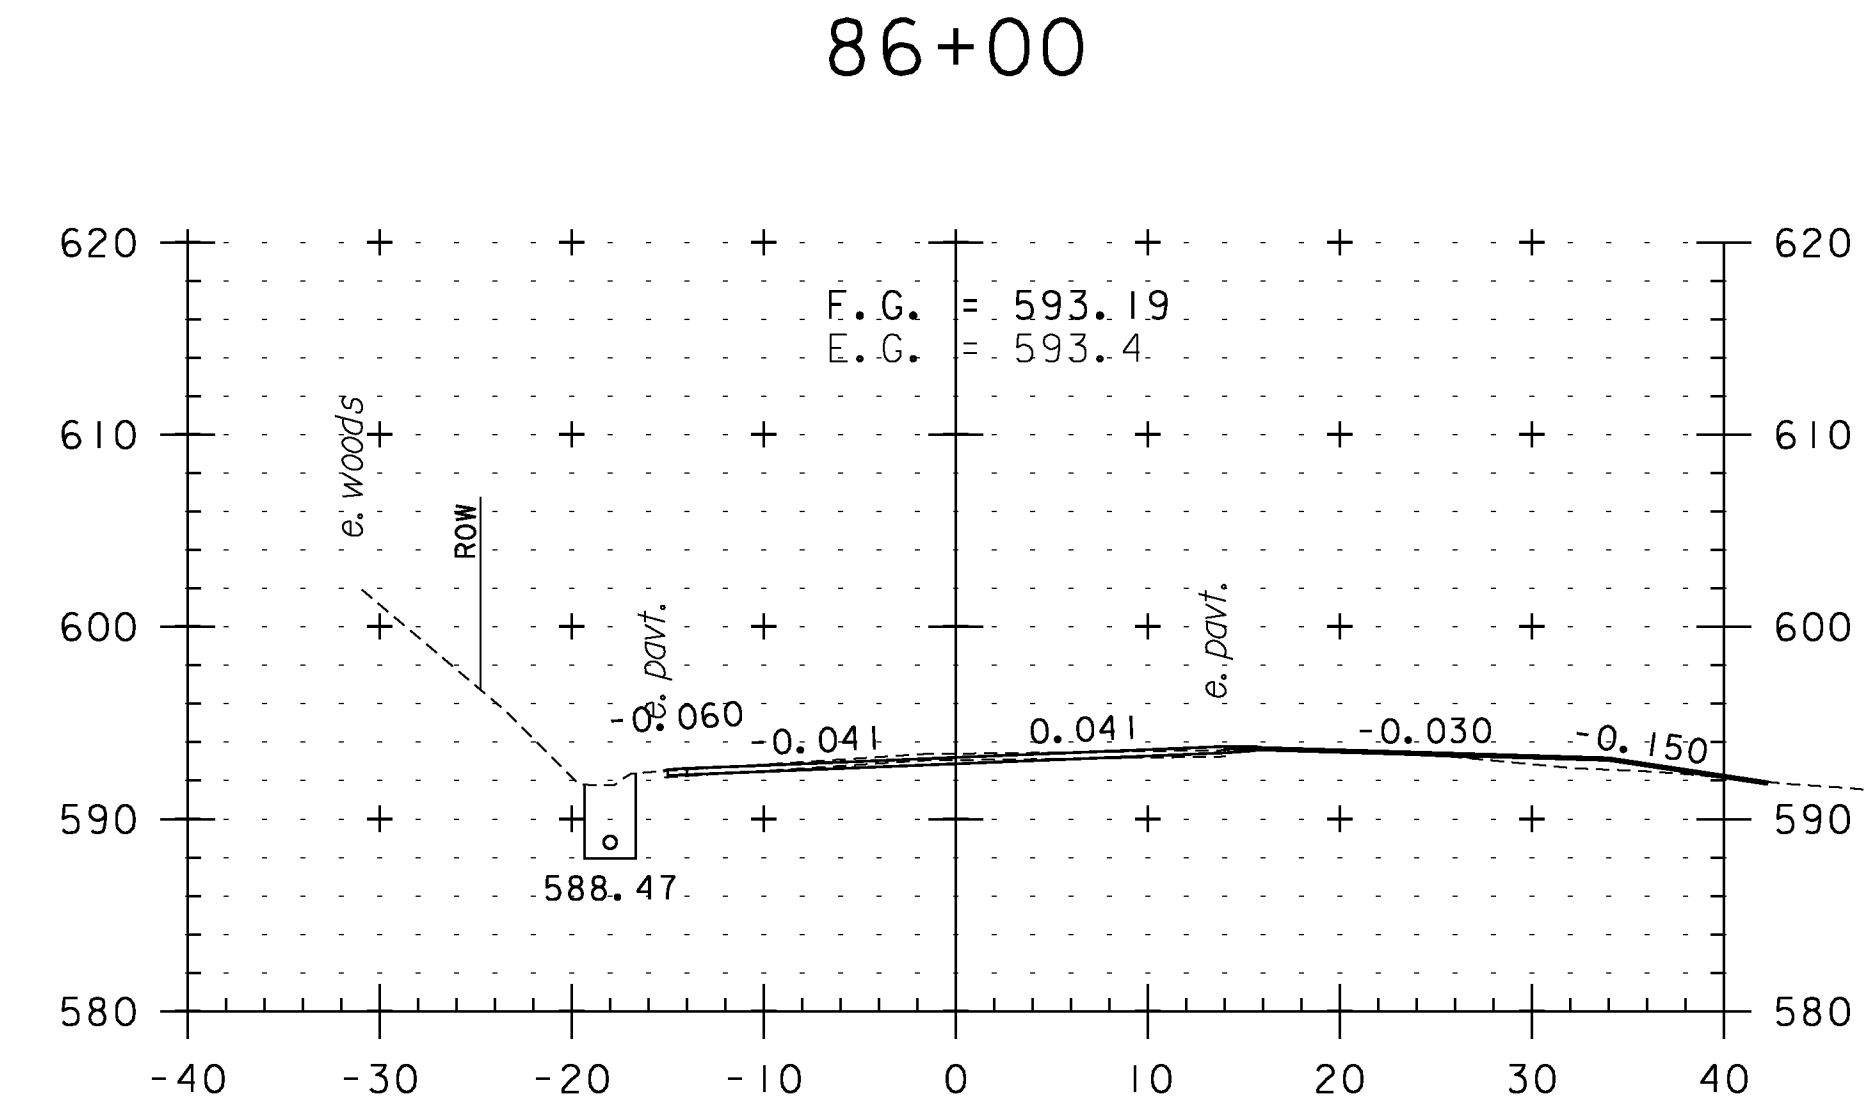

85+75  
TH 82

**CROSS SECTION SHEET 4**

PROJECT NAME: WEATHERSFIELD

PROJECT NUMBER: STP 2913(I)

FILE NAME: I0c228

PROJECT LEADER: PTS

DESIGNED BY: NLL


IPARM FILE NAME: pI0c228\_94

PLOT DATE: 2/7/2013

DRAWN BY: WWG

CHECKED BY: PTS

SHEET 94 OF 234

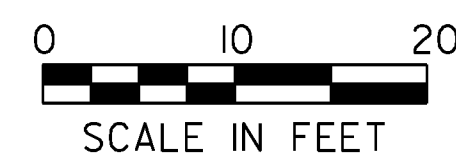

STA. 83+00 TO STA. 86+00