




99+50

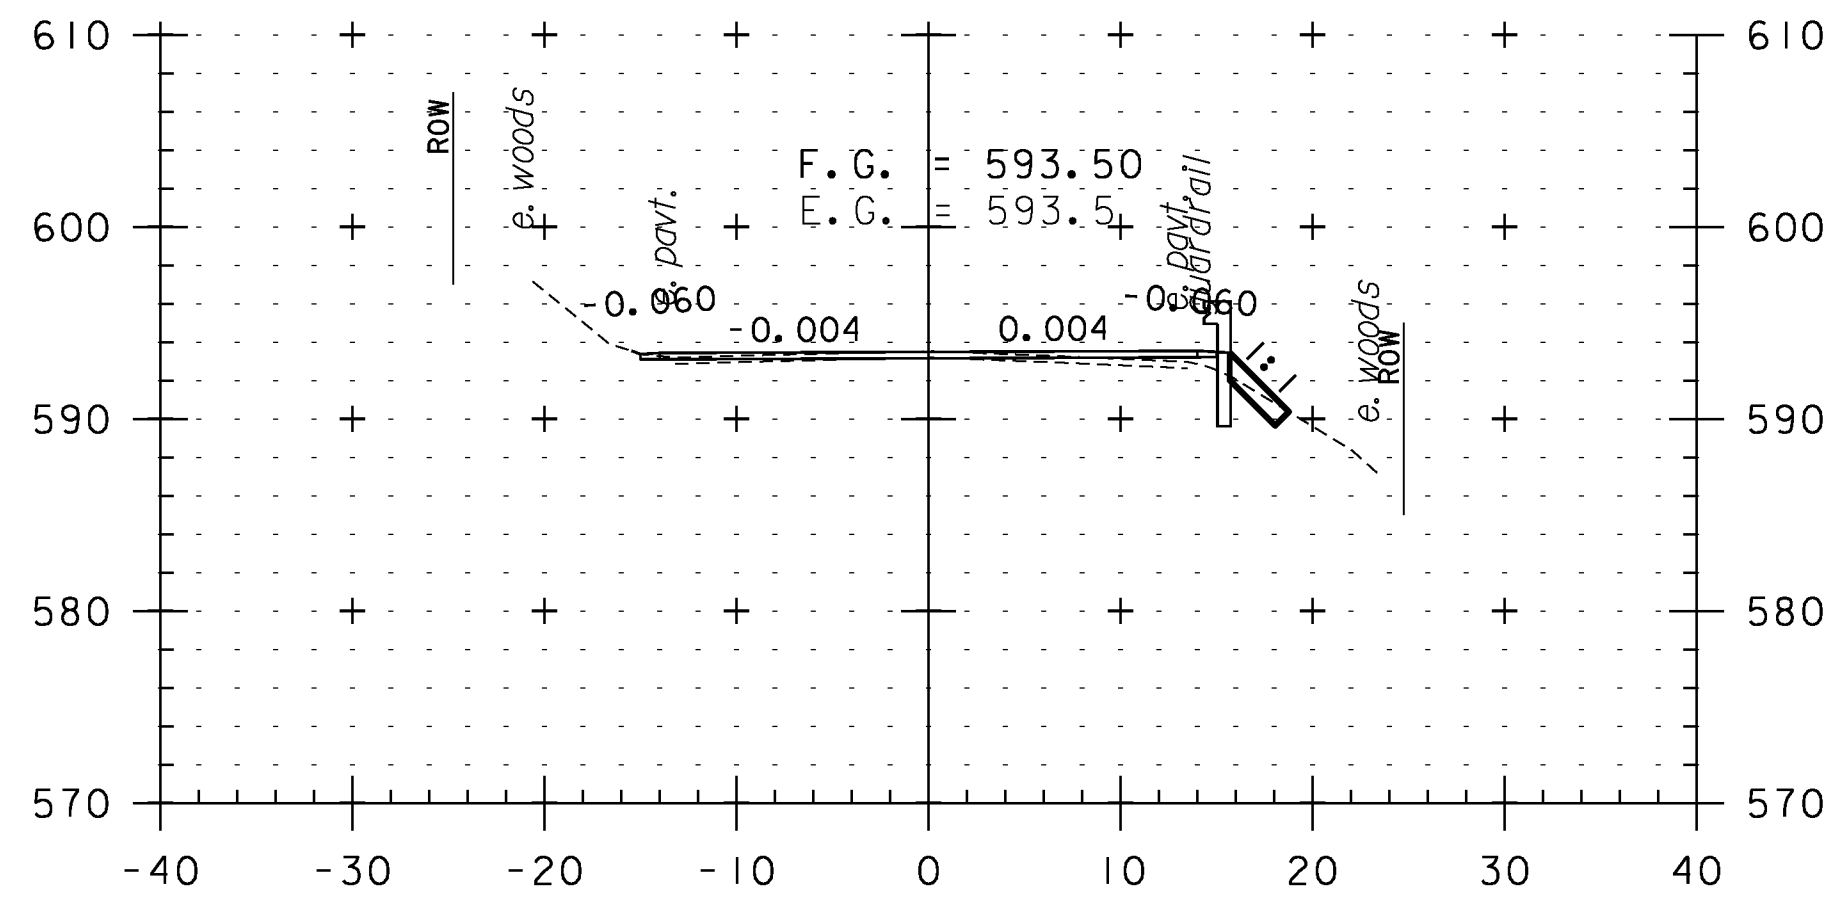


101+00

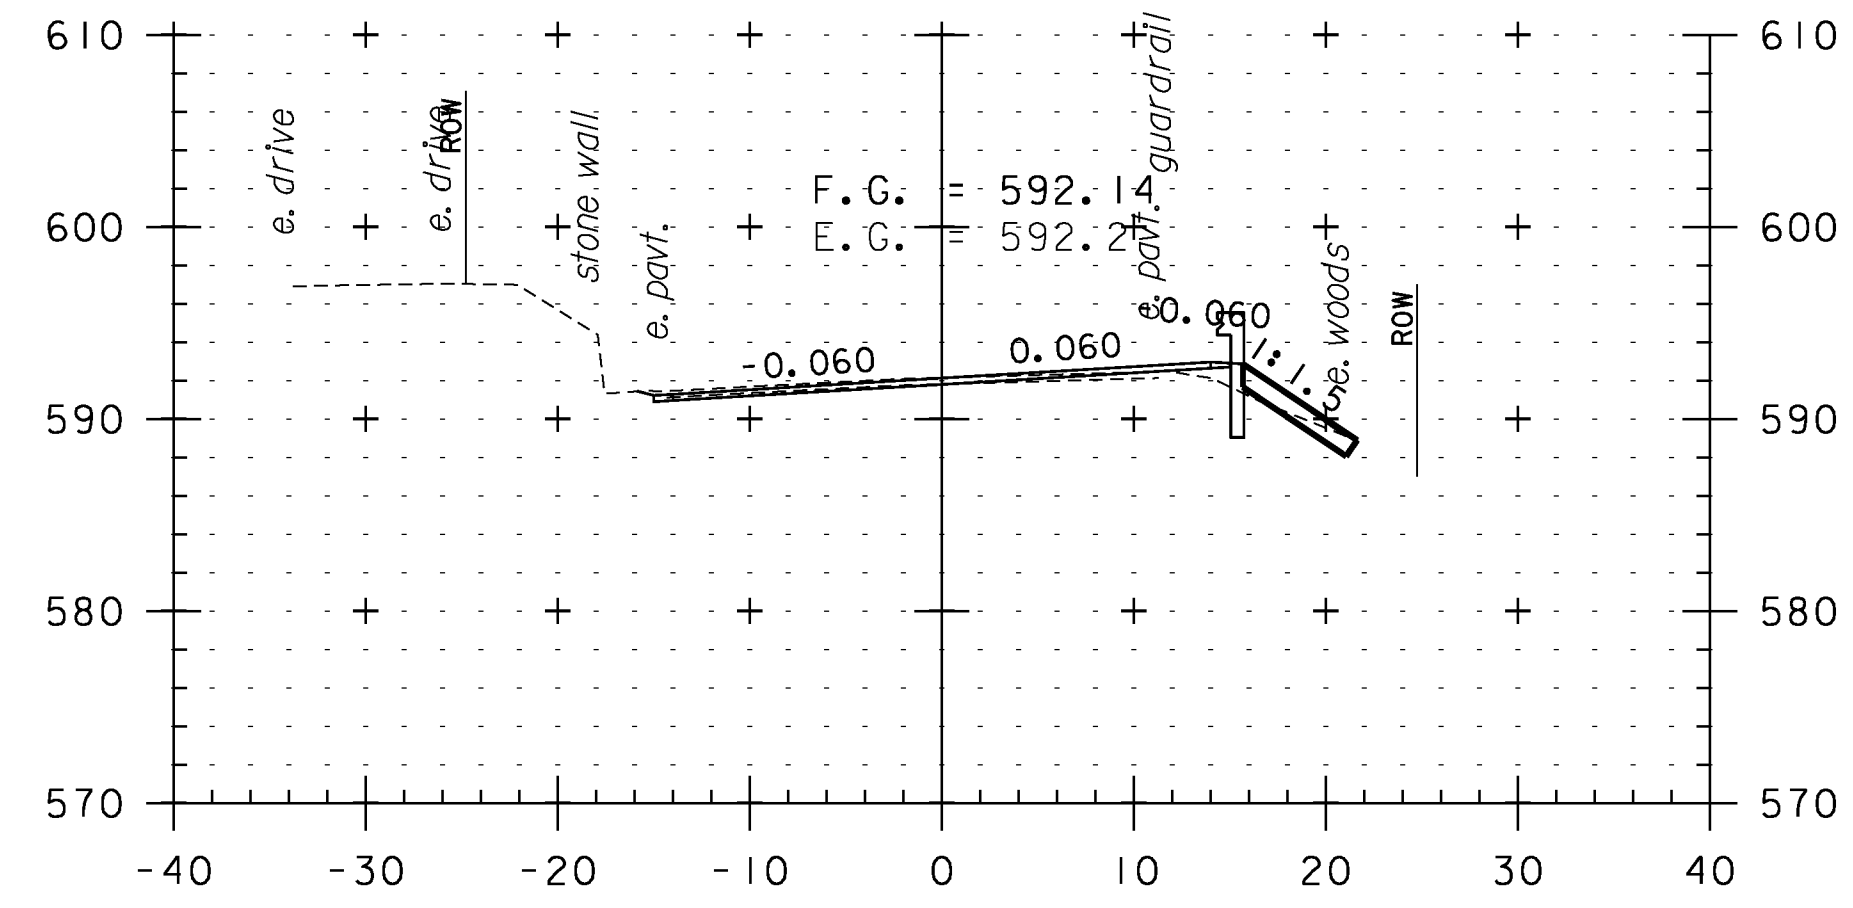


102+50

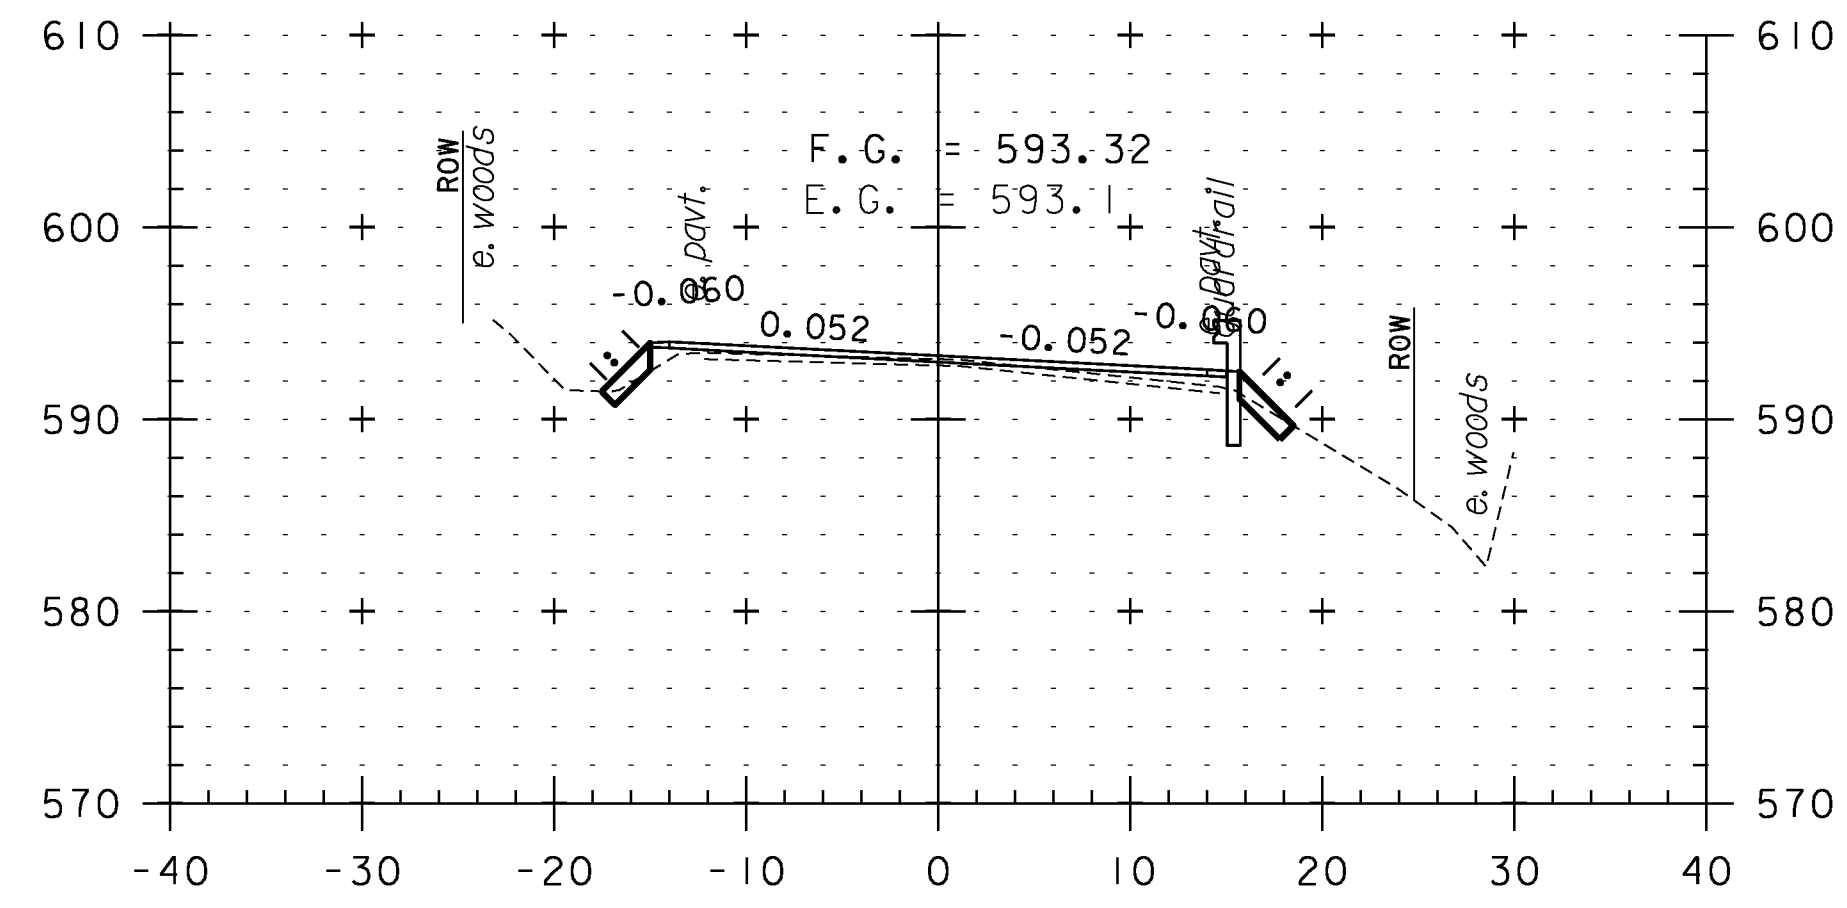


99+00

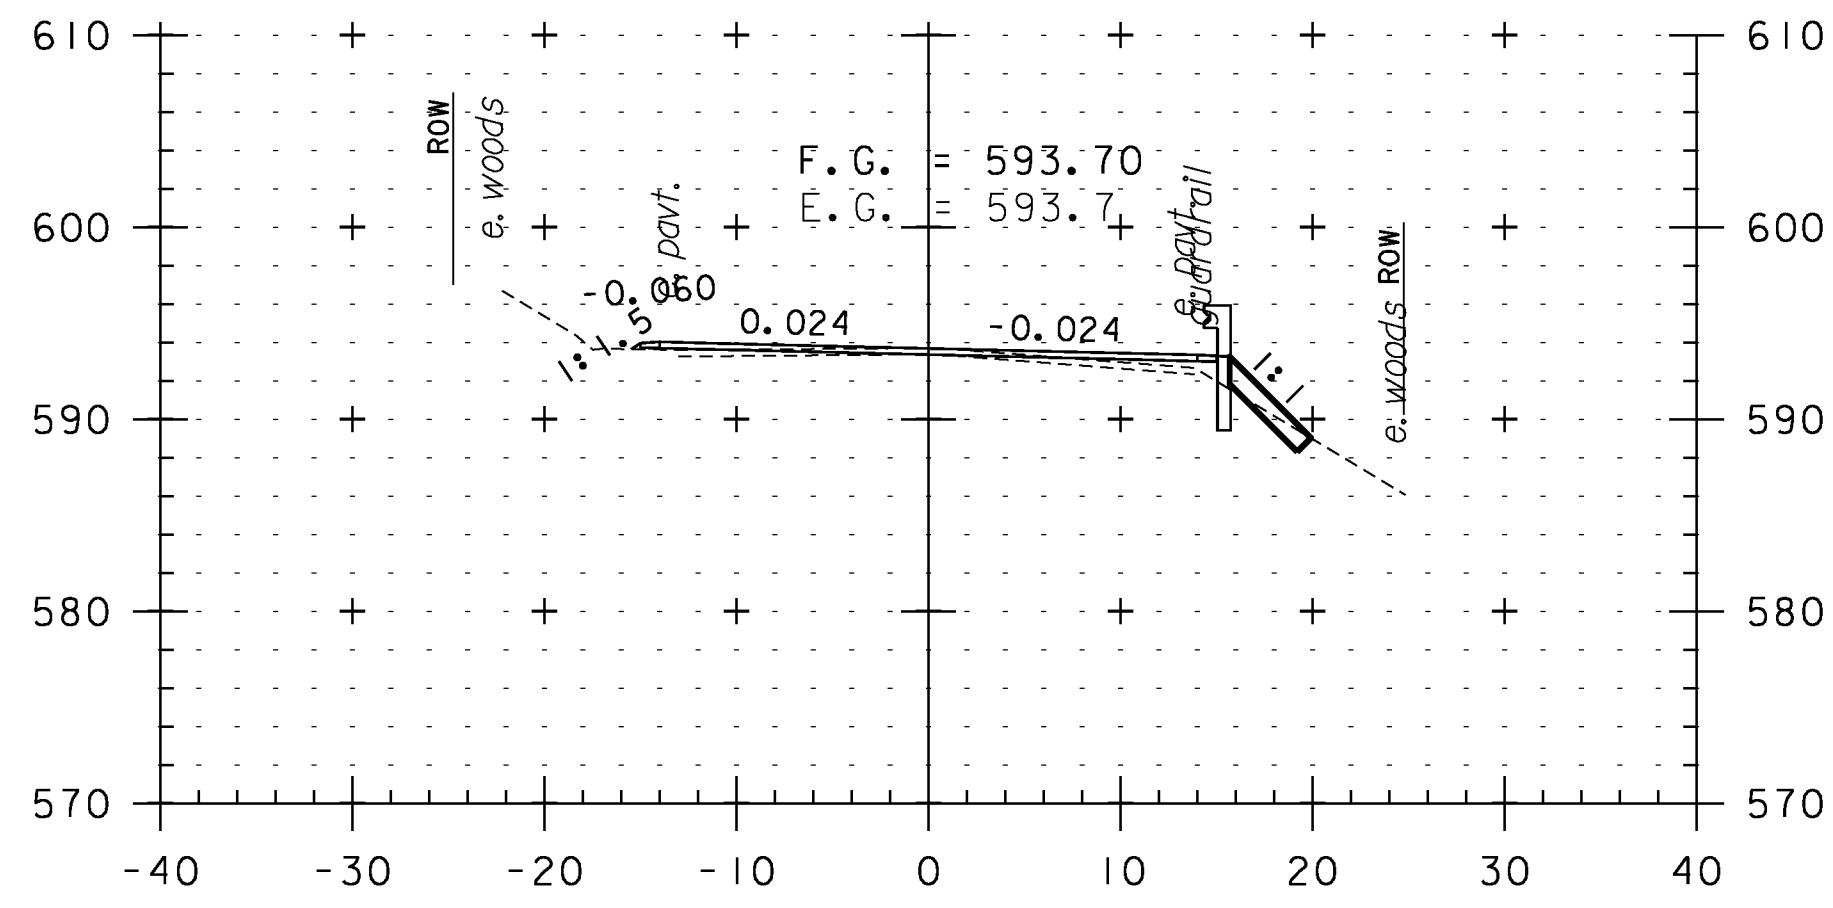


100+50

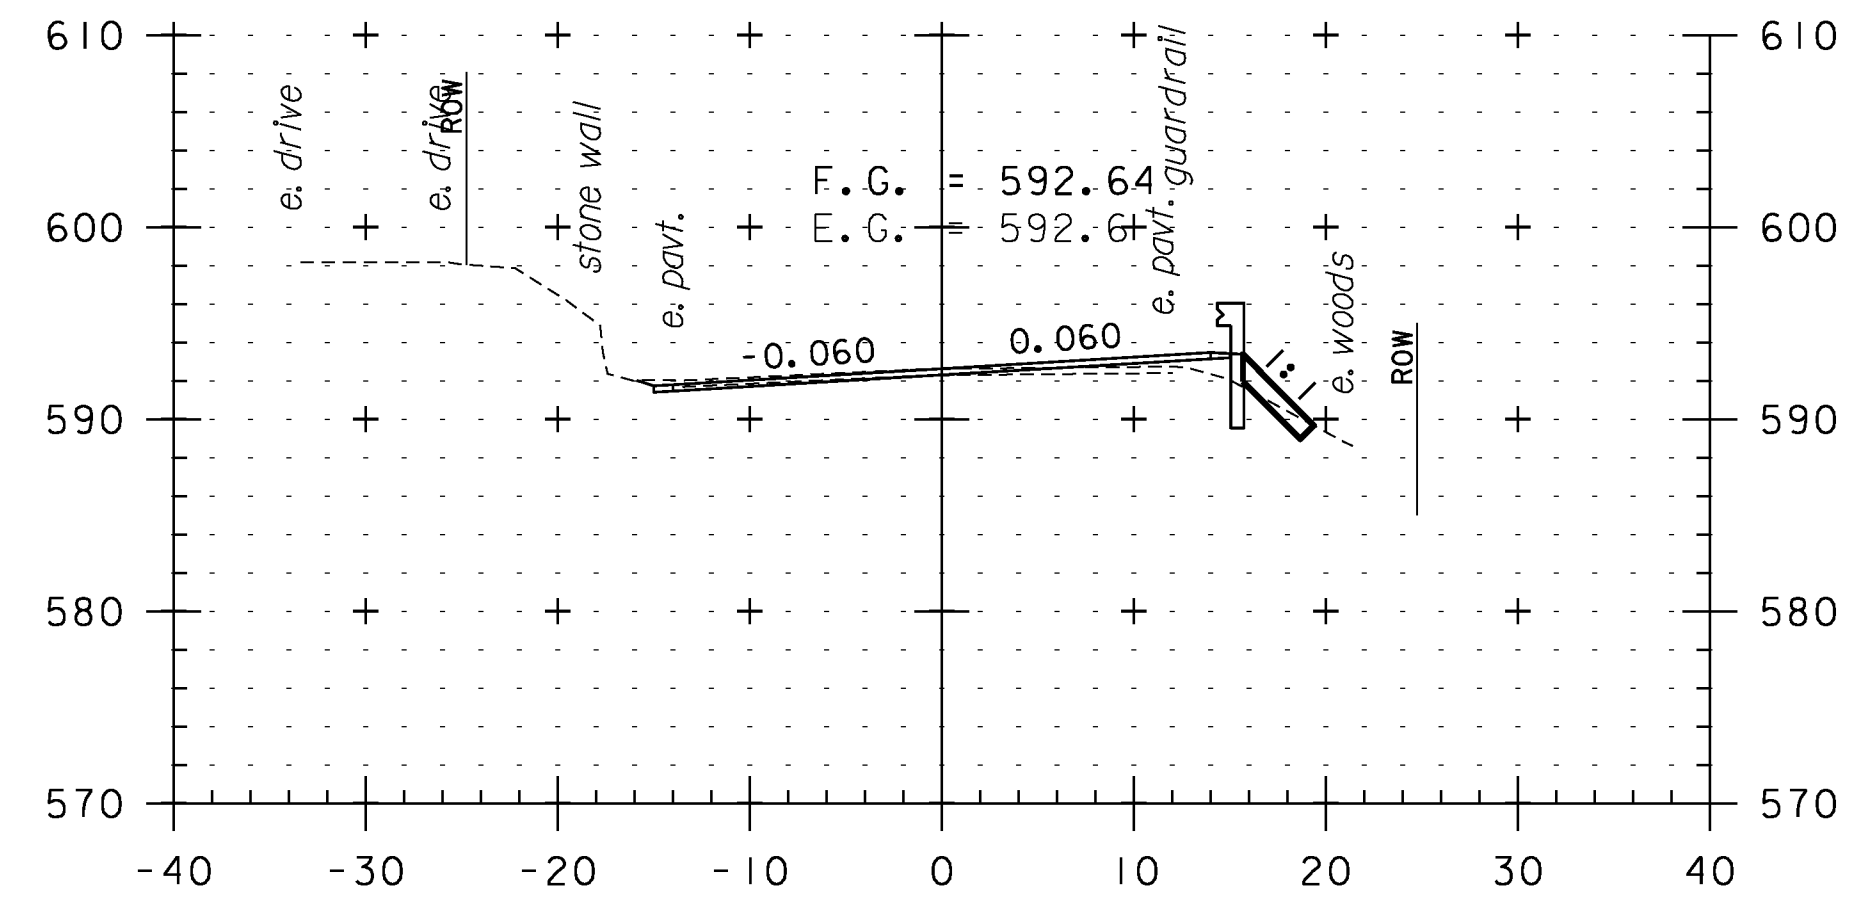


102+00

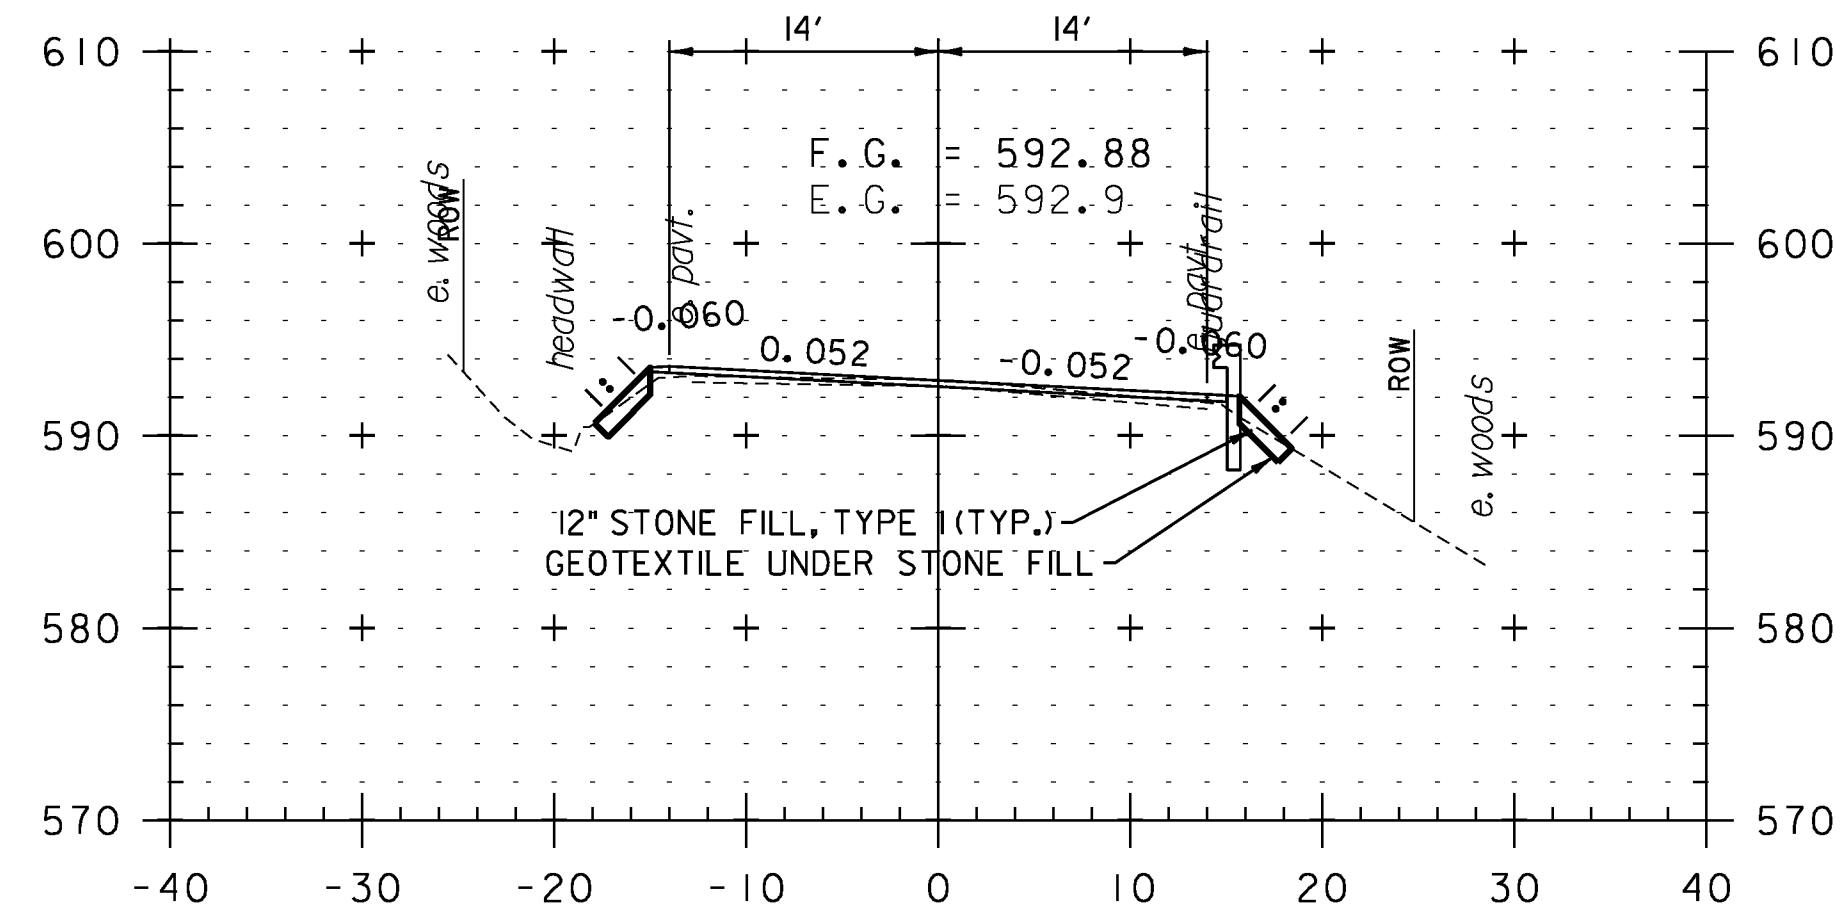

98+50

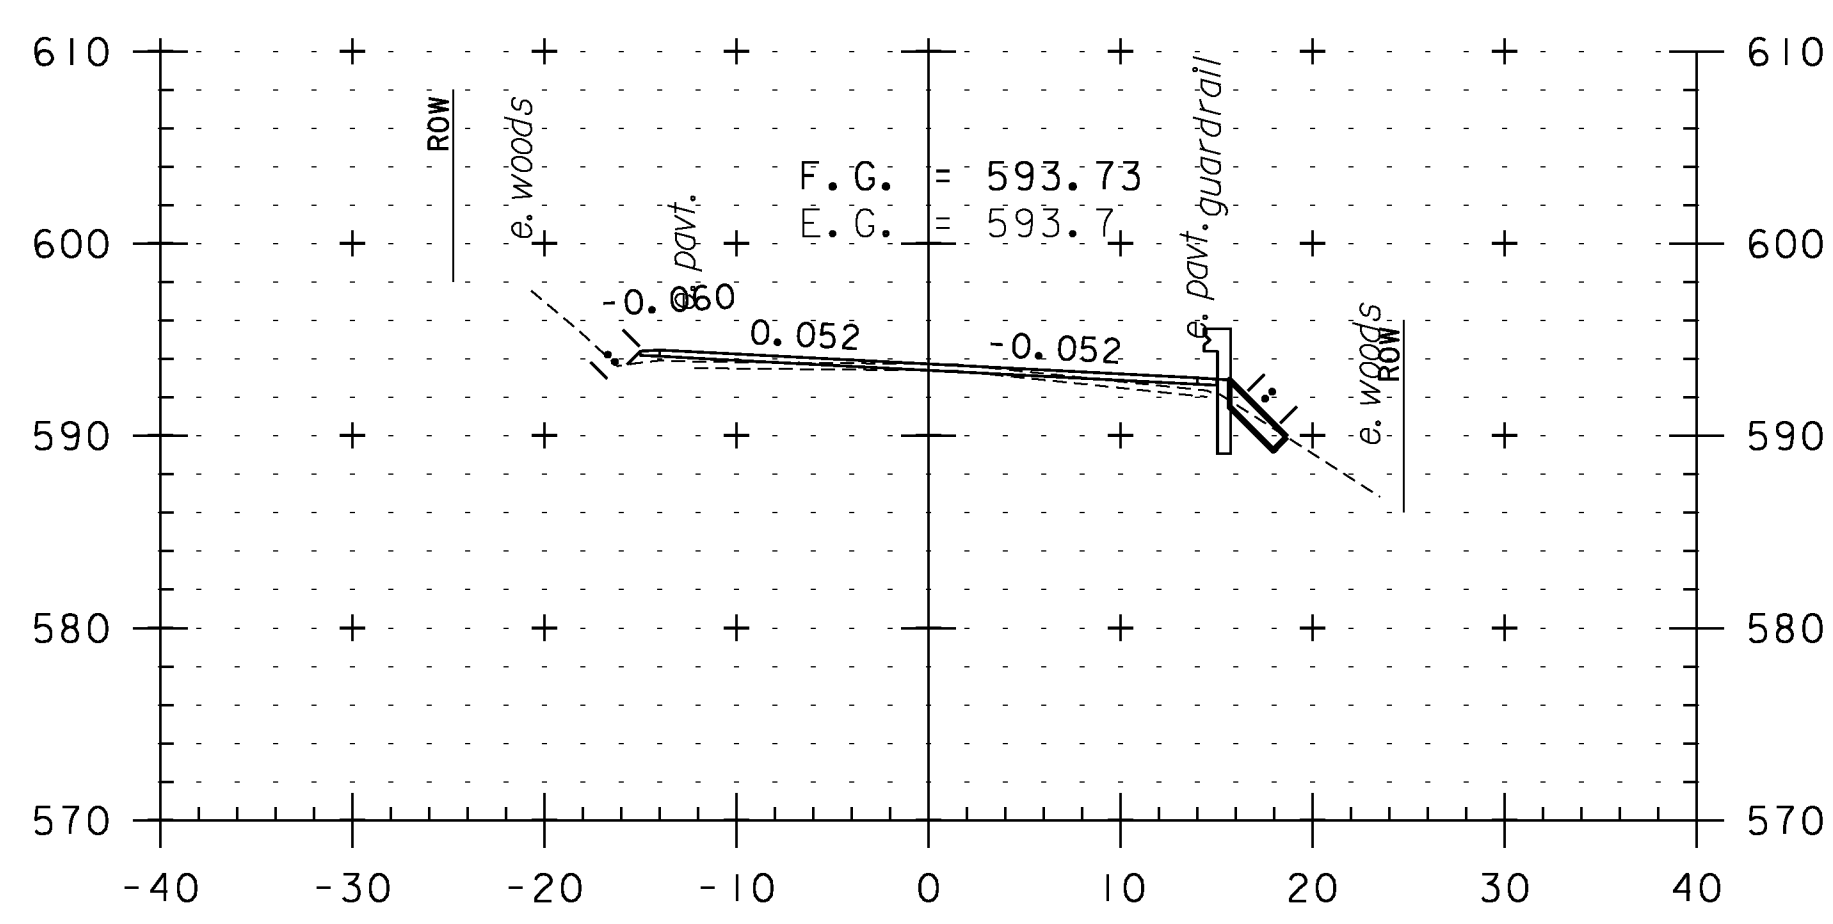

100+00

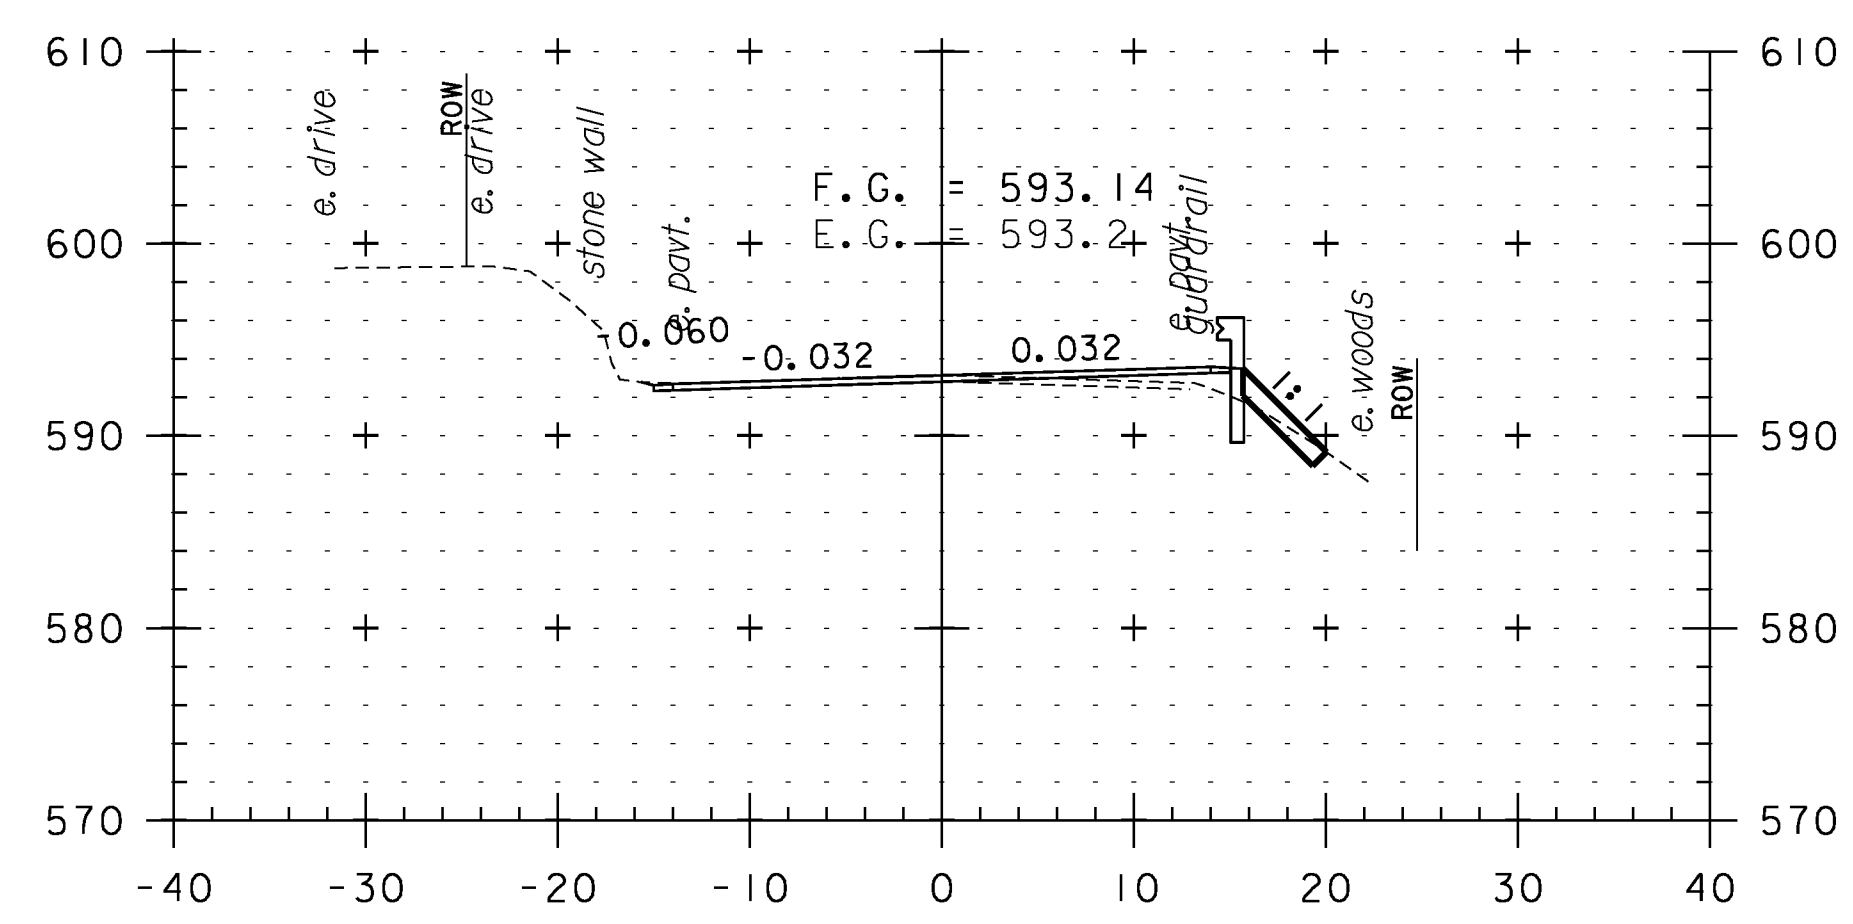

101+50

CROSS SECTION SHEET 8

PROJECT NAME: WEATHERSFIELD	
PROJECT NUMBER: STP 2913(I)	
FILE NAME: I0c228	PLOT DATE: 2/7/2013
PROJECT LEADER: PTS	DRAWN BY: WWG
DESIGNED BY: NLL	CHECKED BY: PTS
IPARM FILE NAME: pI0c228_98	SHEET 98 OF 234



STA. 98+50 TO STA. 102+50