




111+00

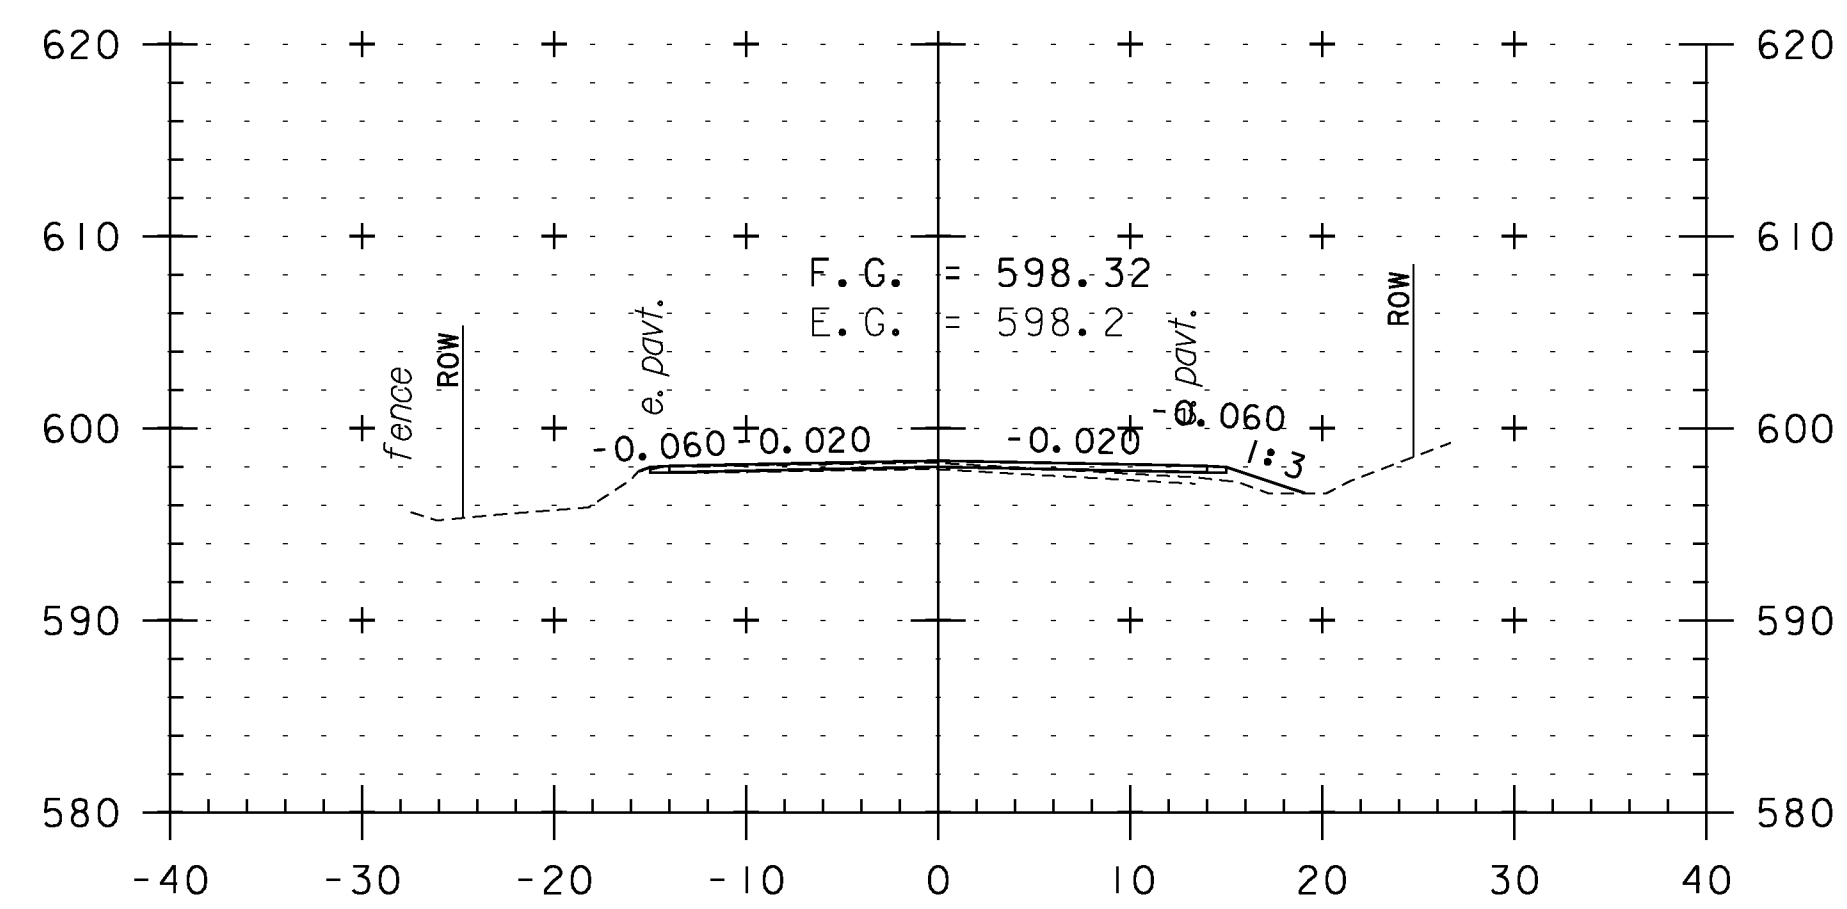


110+50

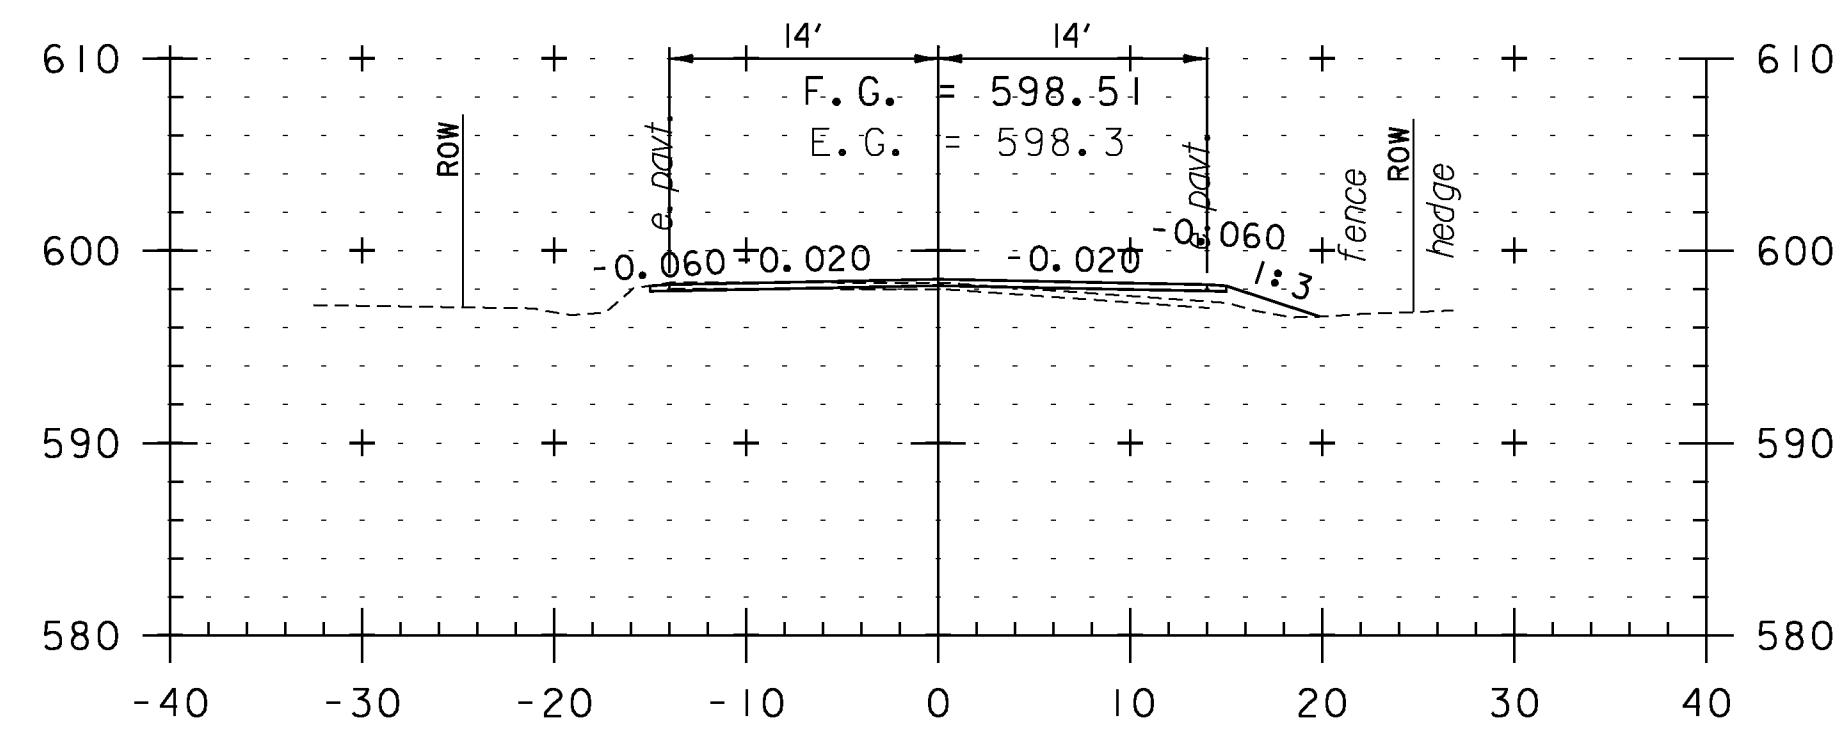


110+00

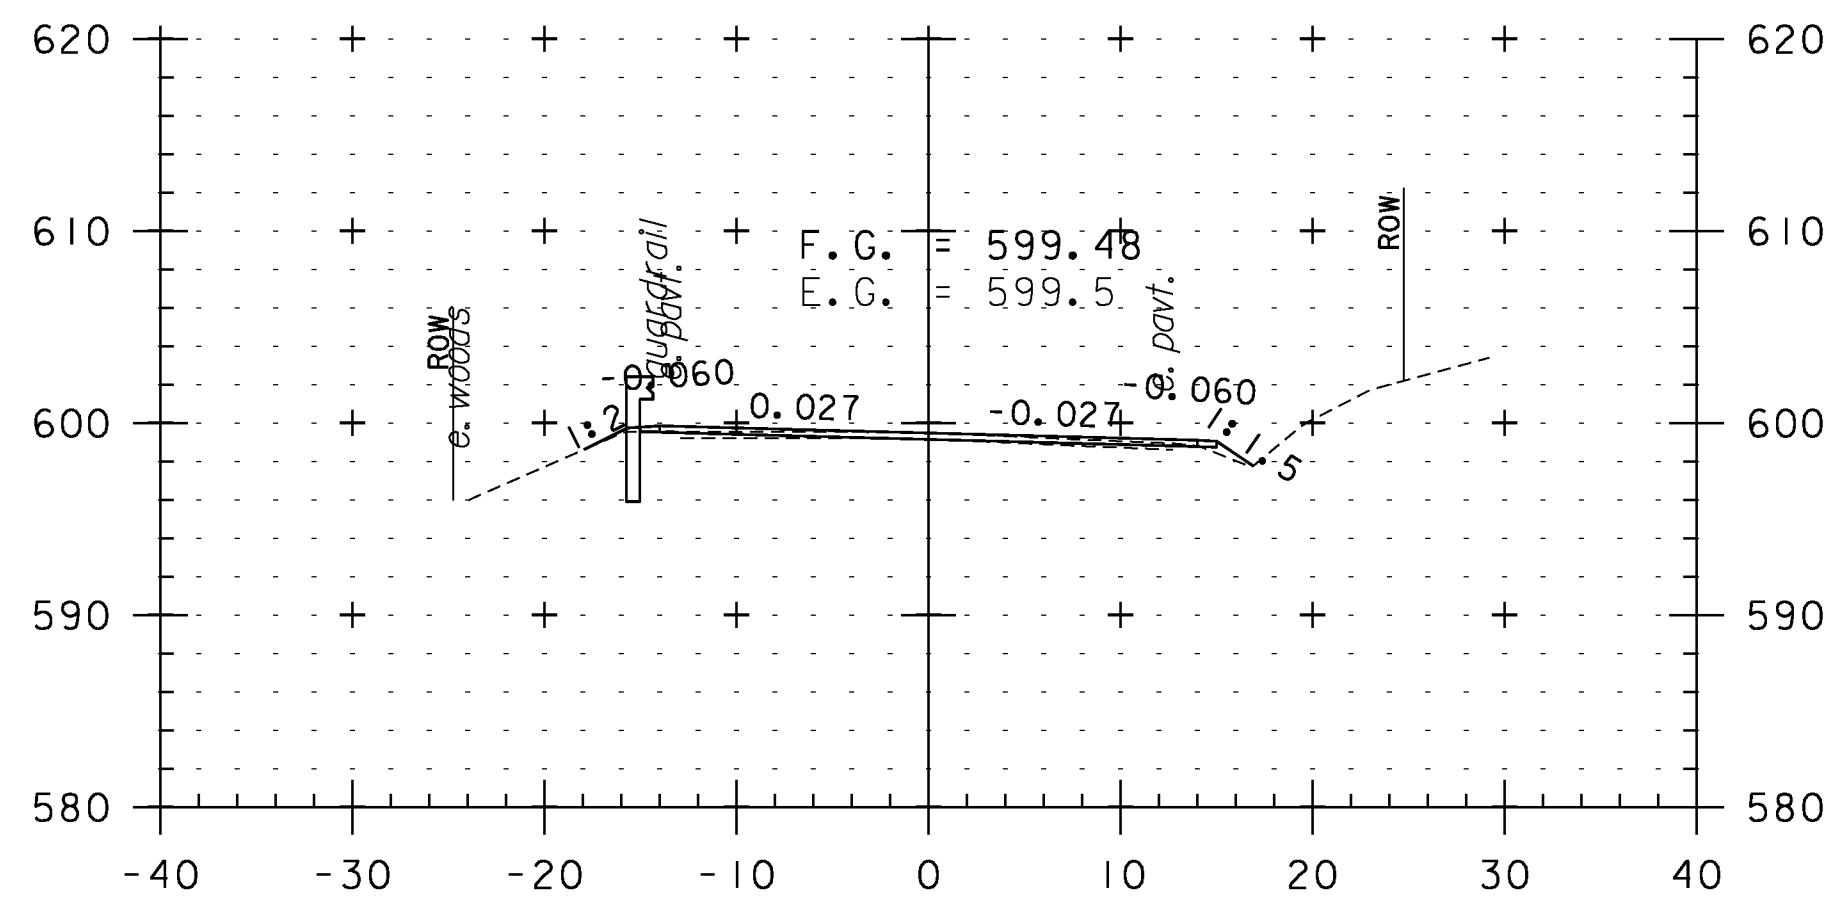


112+50

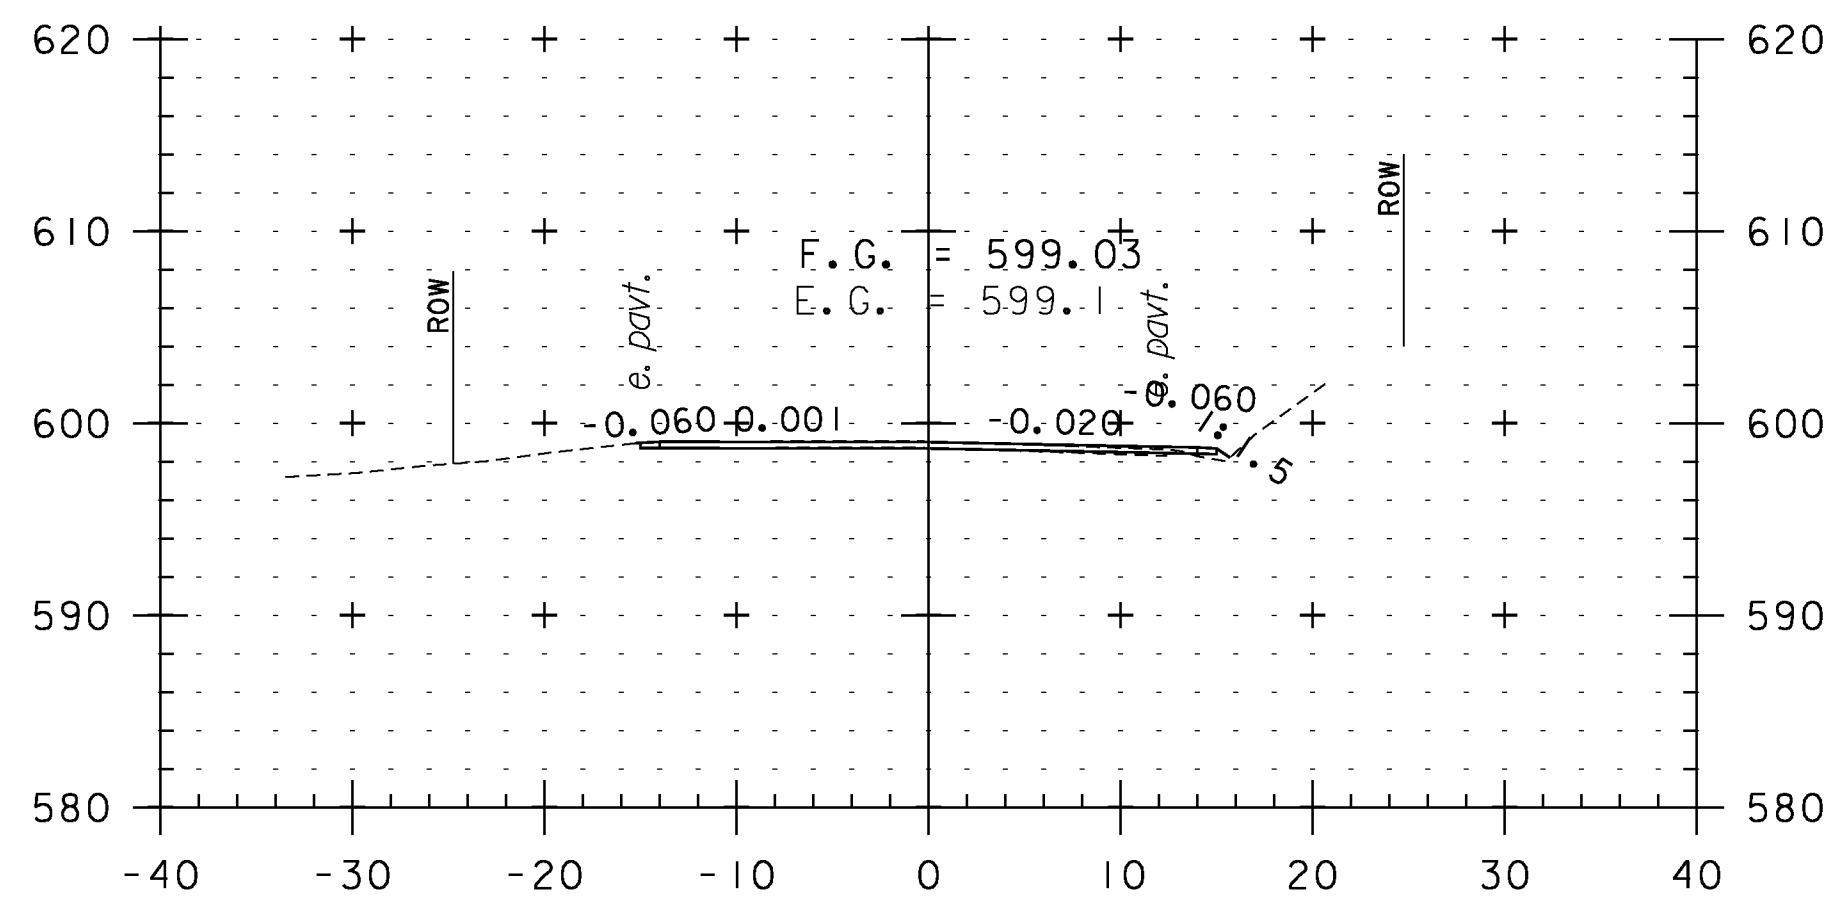


112+00

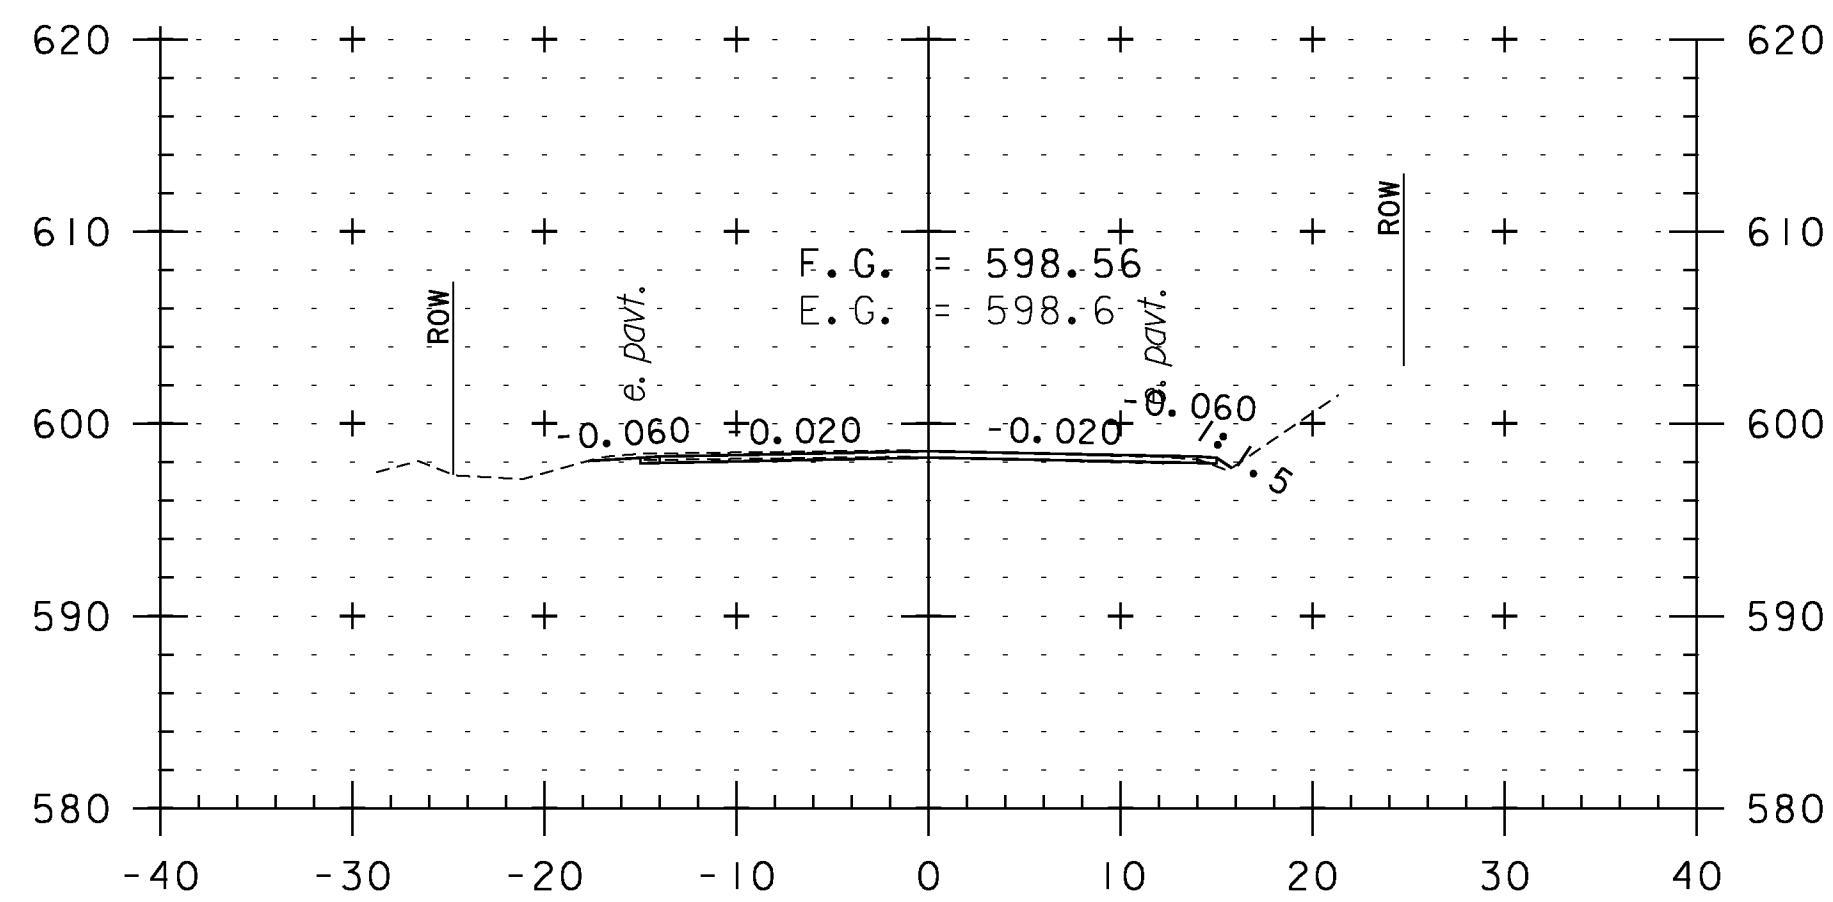


111+50

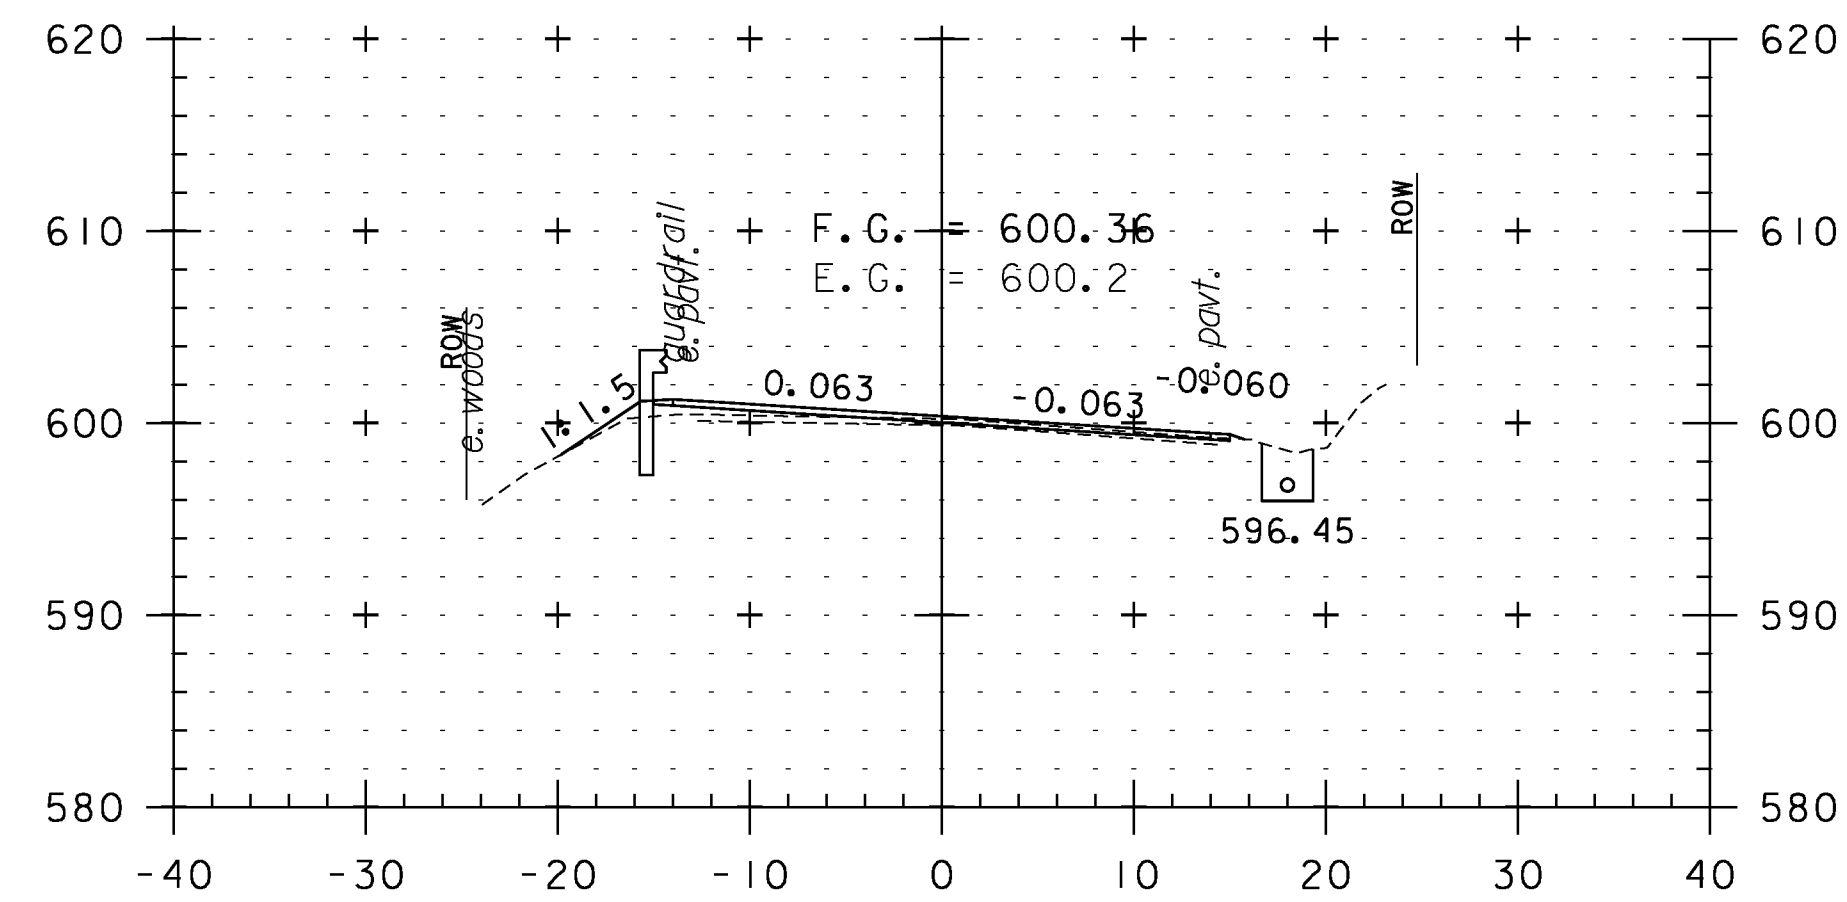

114+00

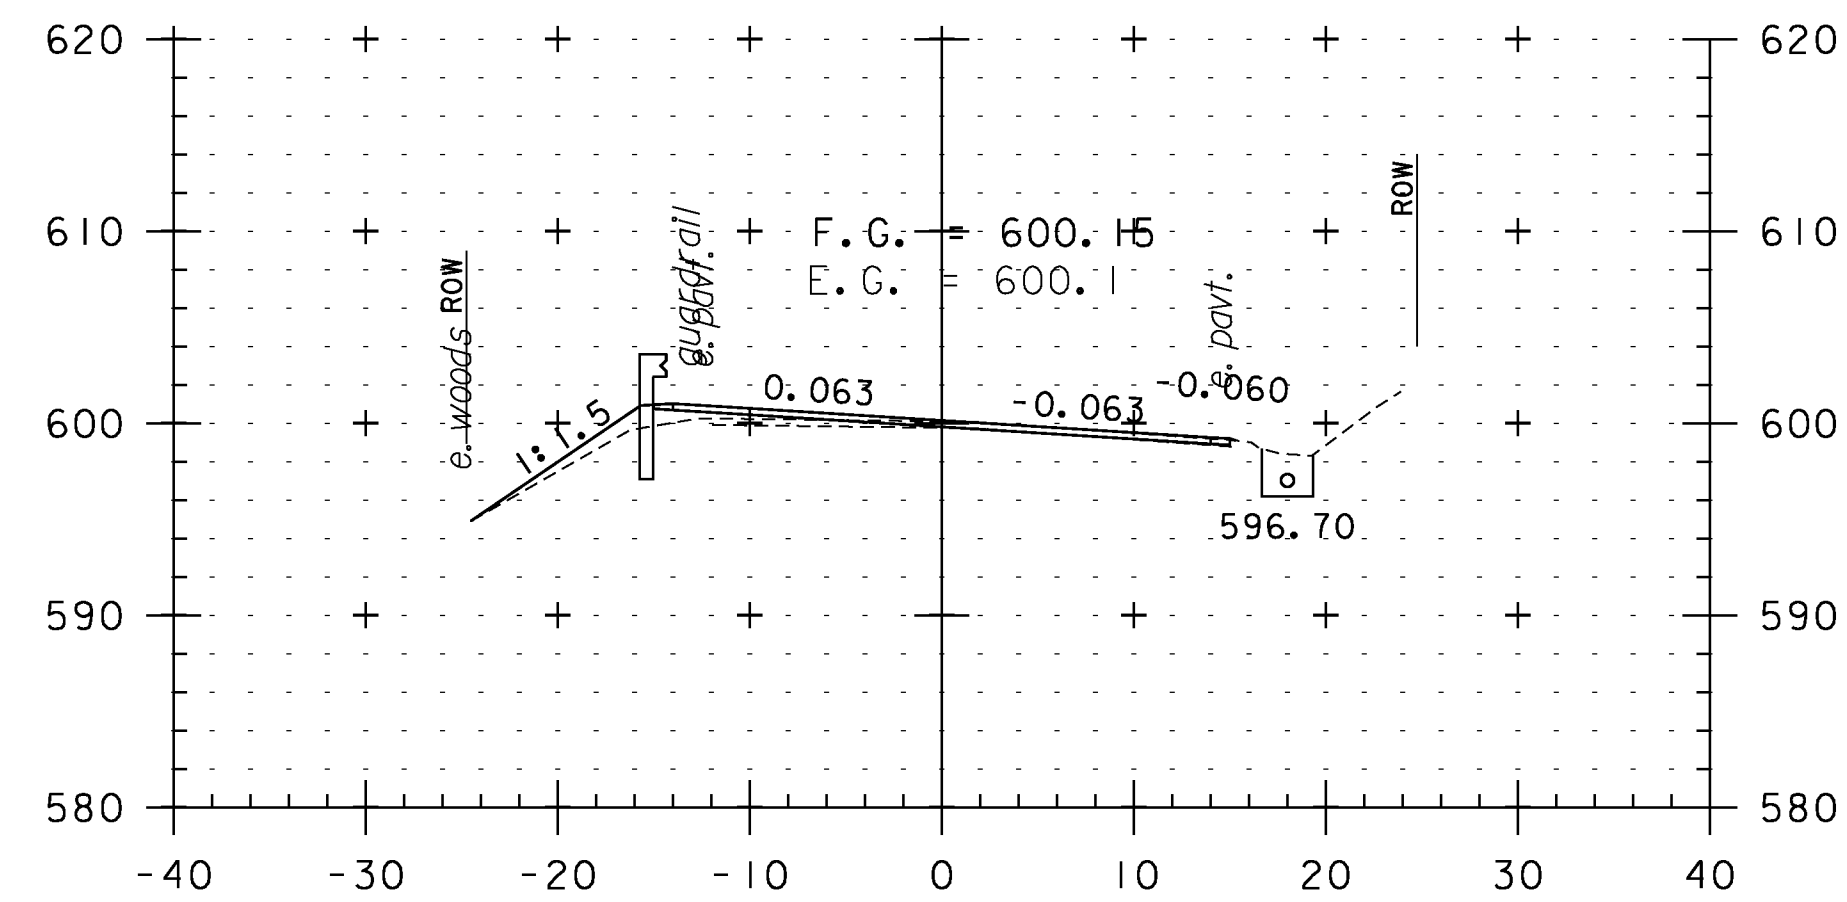

113+50

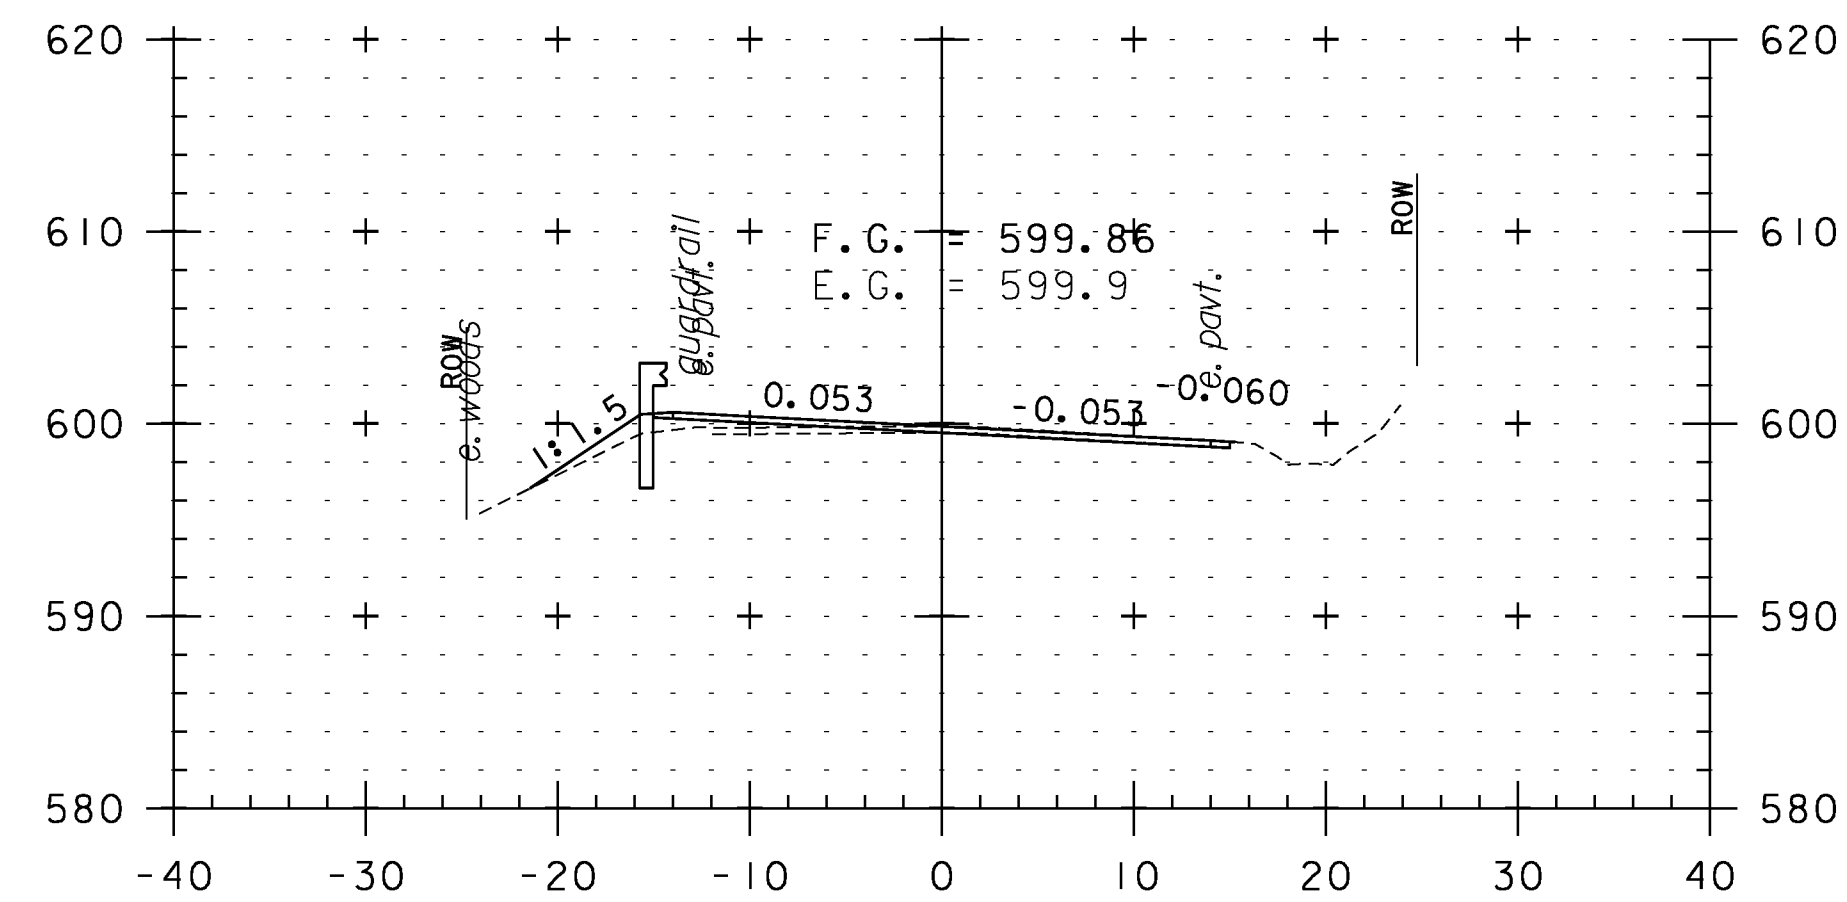

113+00

**CROSS SECTION SHEET 11**

PROJECT NAME:	WEATHERSFIELD	PLOT DATE:	2/7/2013
PROJECT NUMBER:	STP 2913(I)	DRAWN BY:	WWG
FILE NAME:	I0c228	DESIGNED BY:	NLL
PROJECT LEADER:	PTS	IPARM FILE NAME:	pI0C228_I01
CHECKED BY:	PTS	SHEET	101 OF 234



STA. 110+00 TO STA. 114+00