




115+50

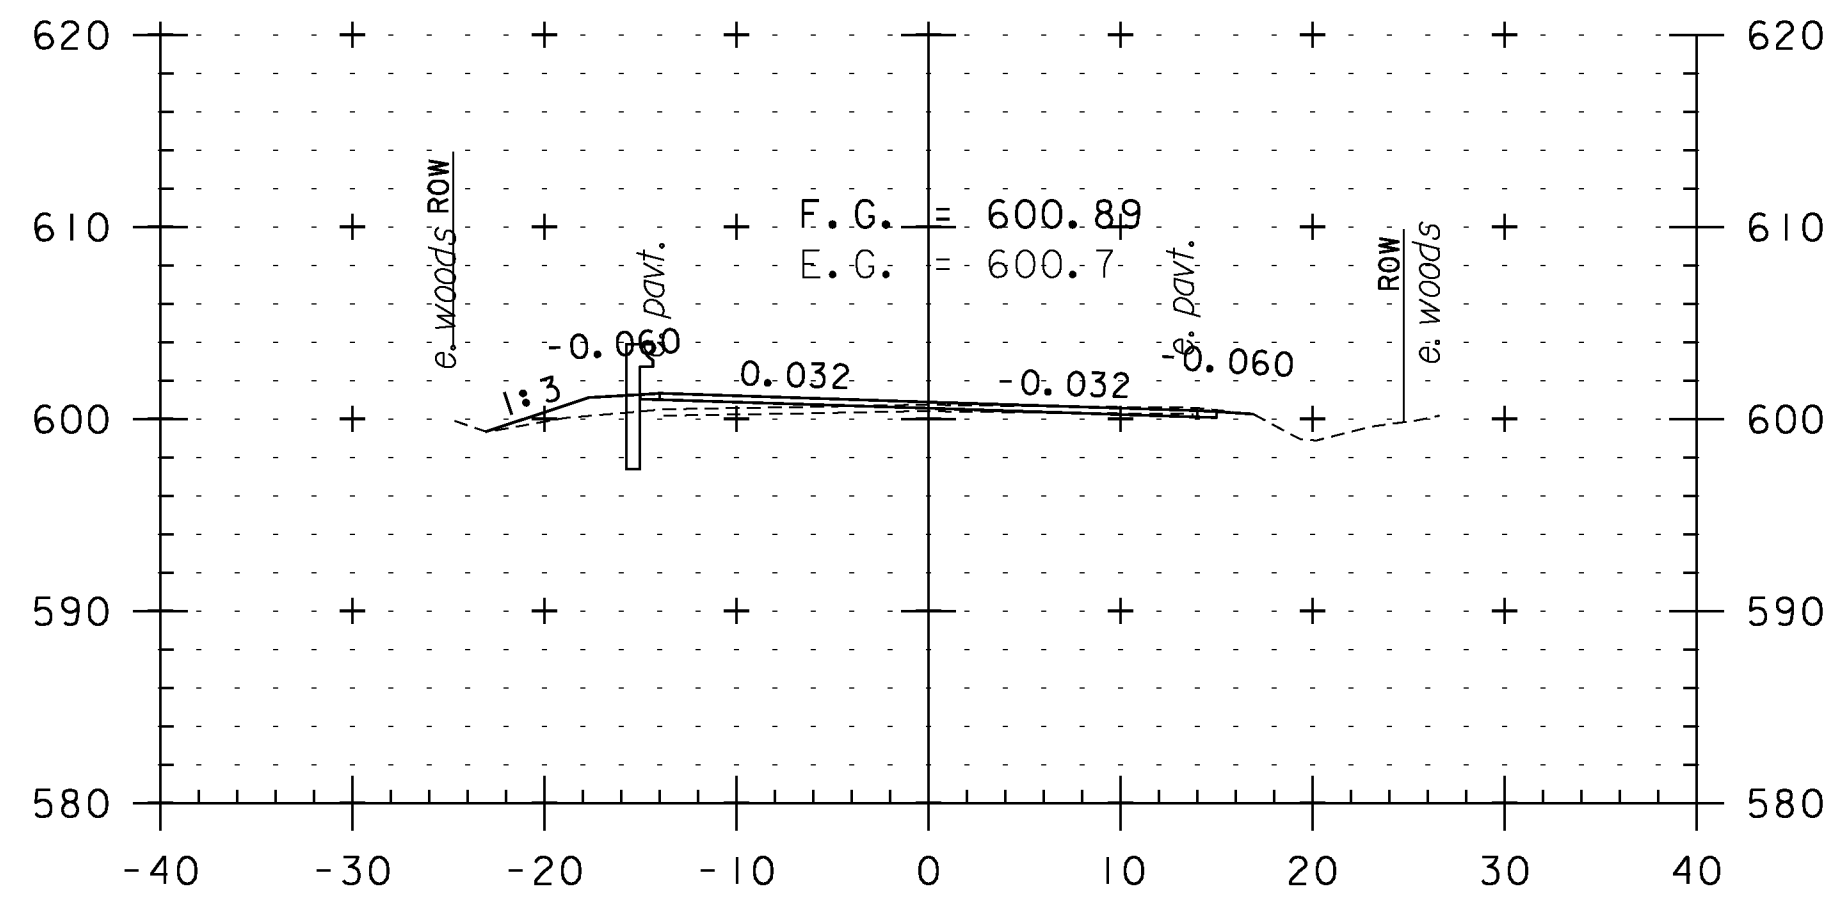


117+00

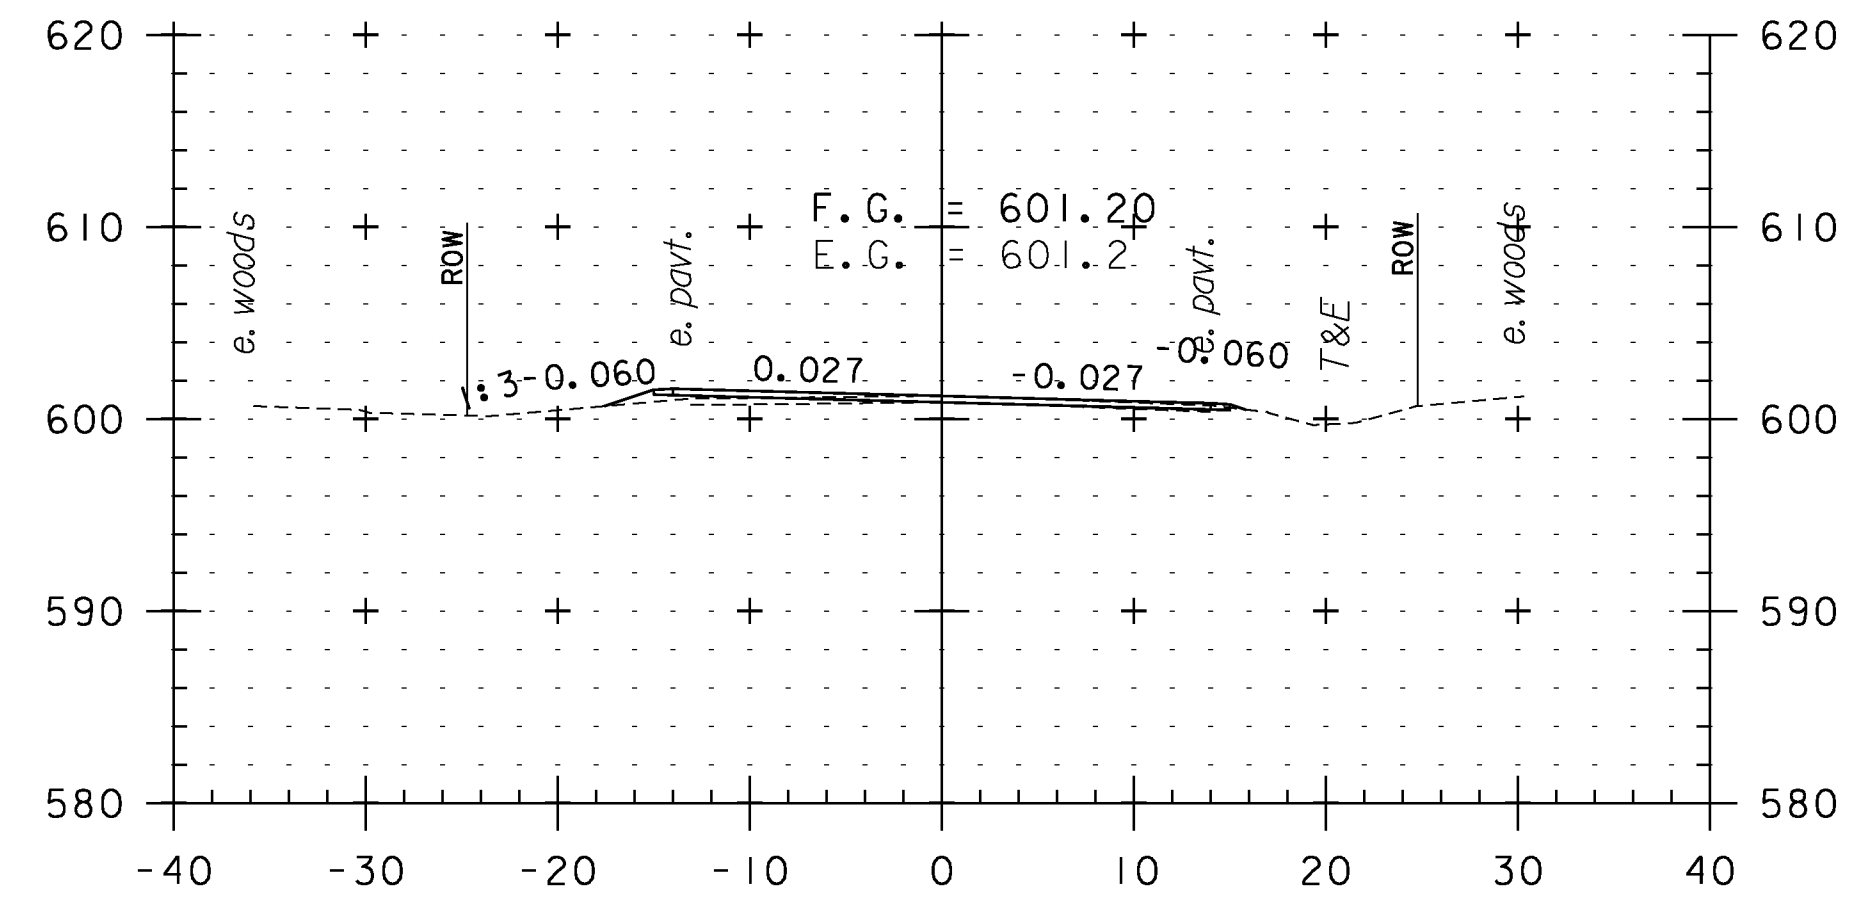


118+50

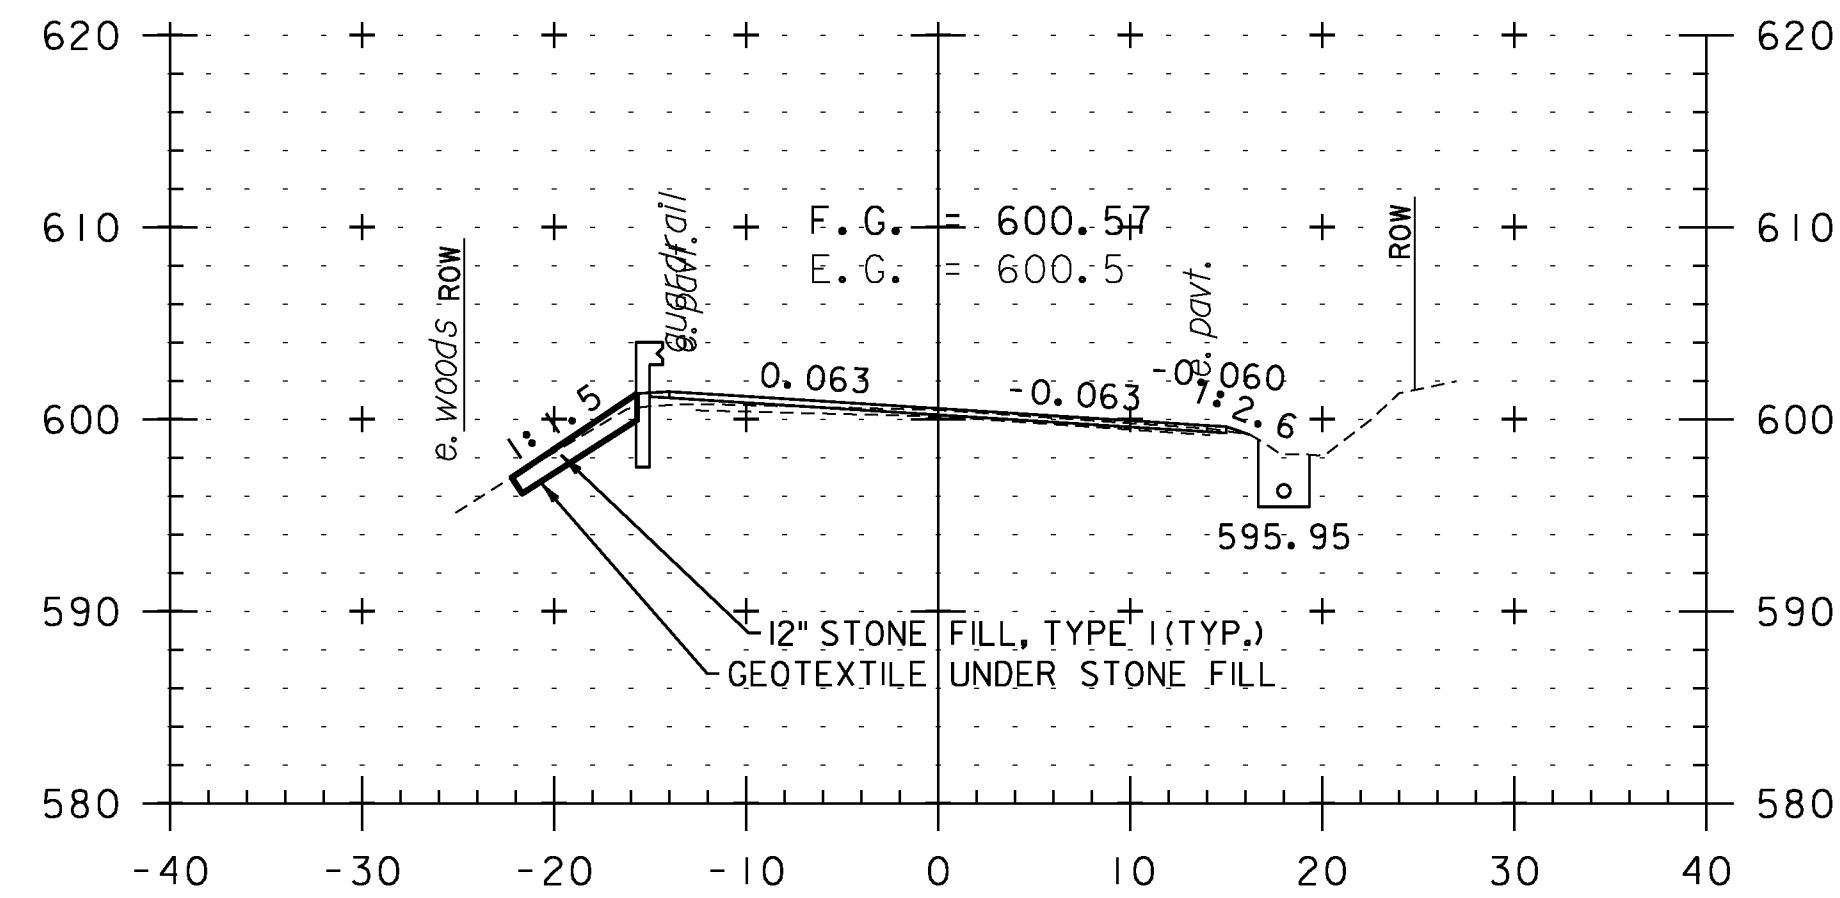


115+00

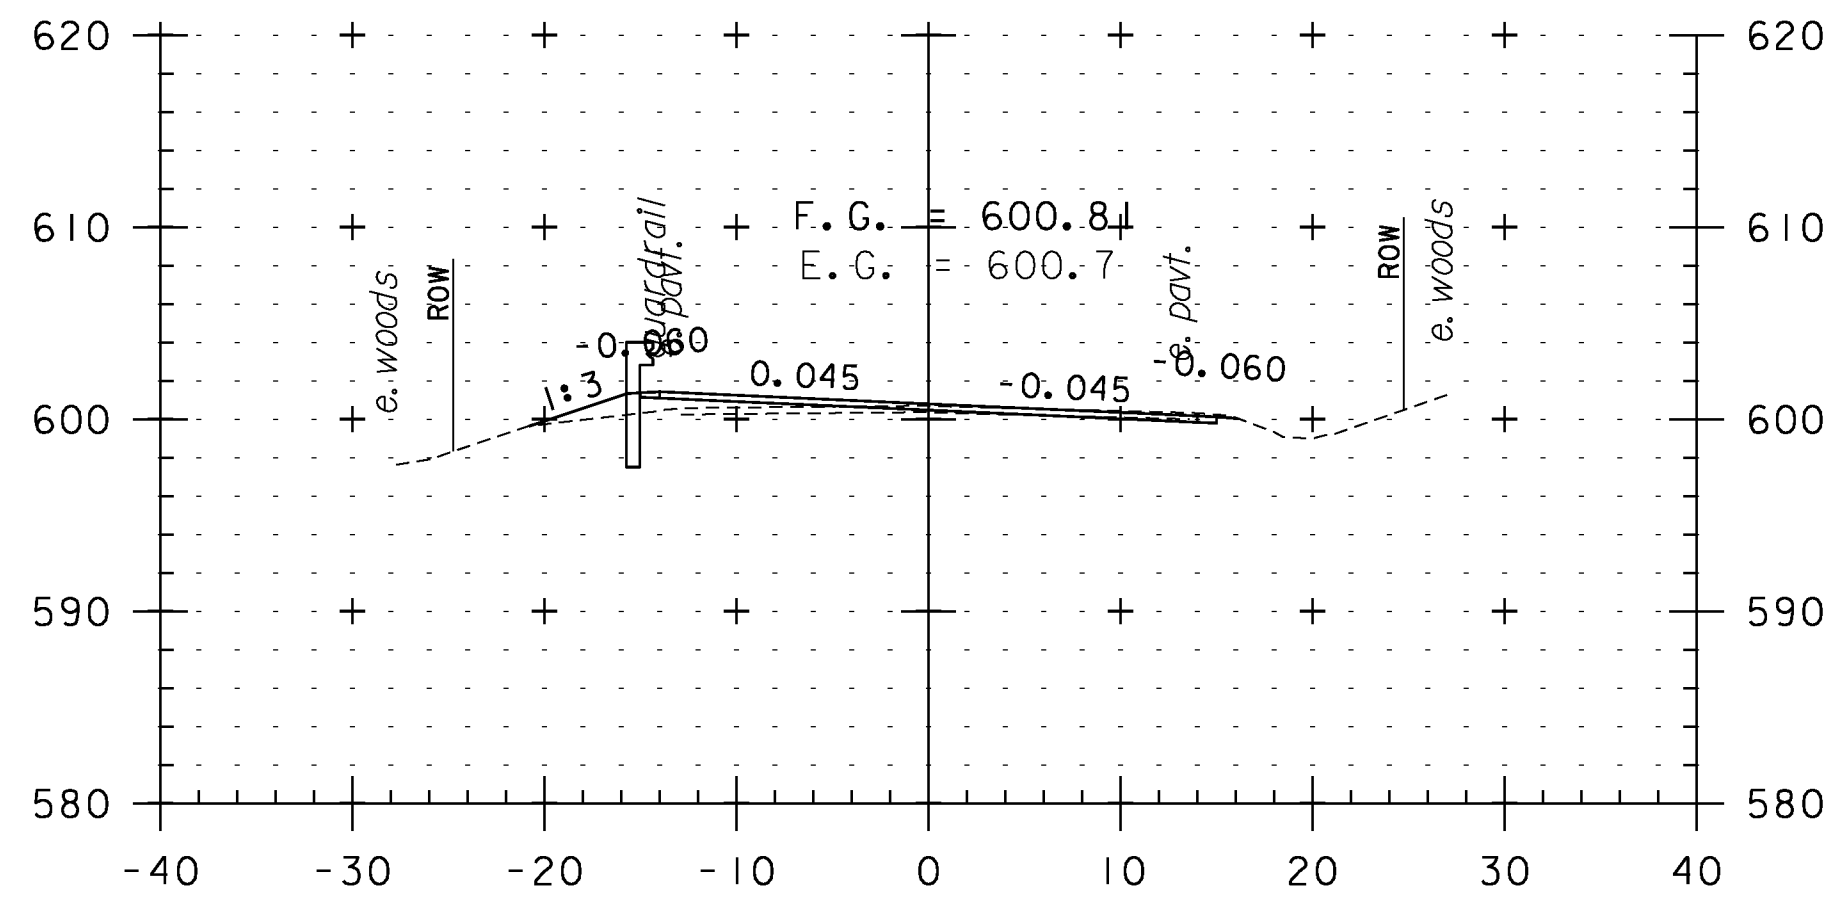


116+50

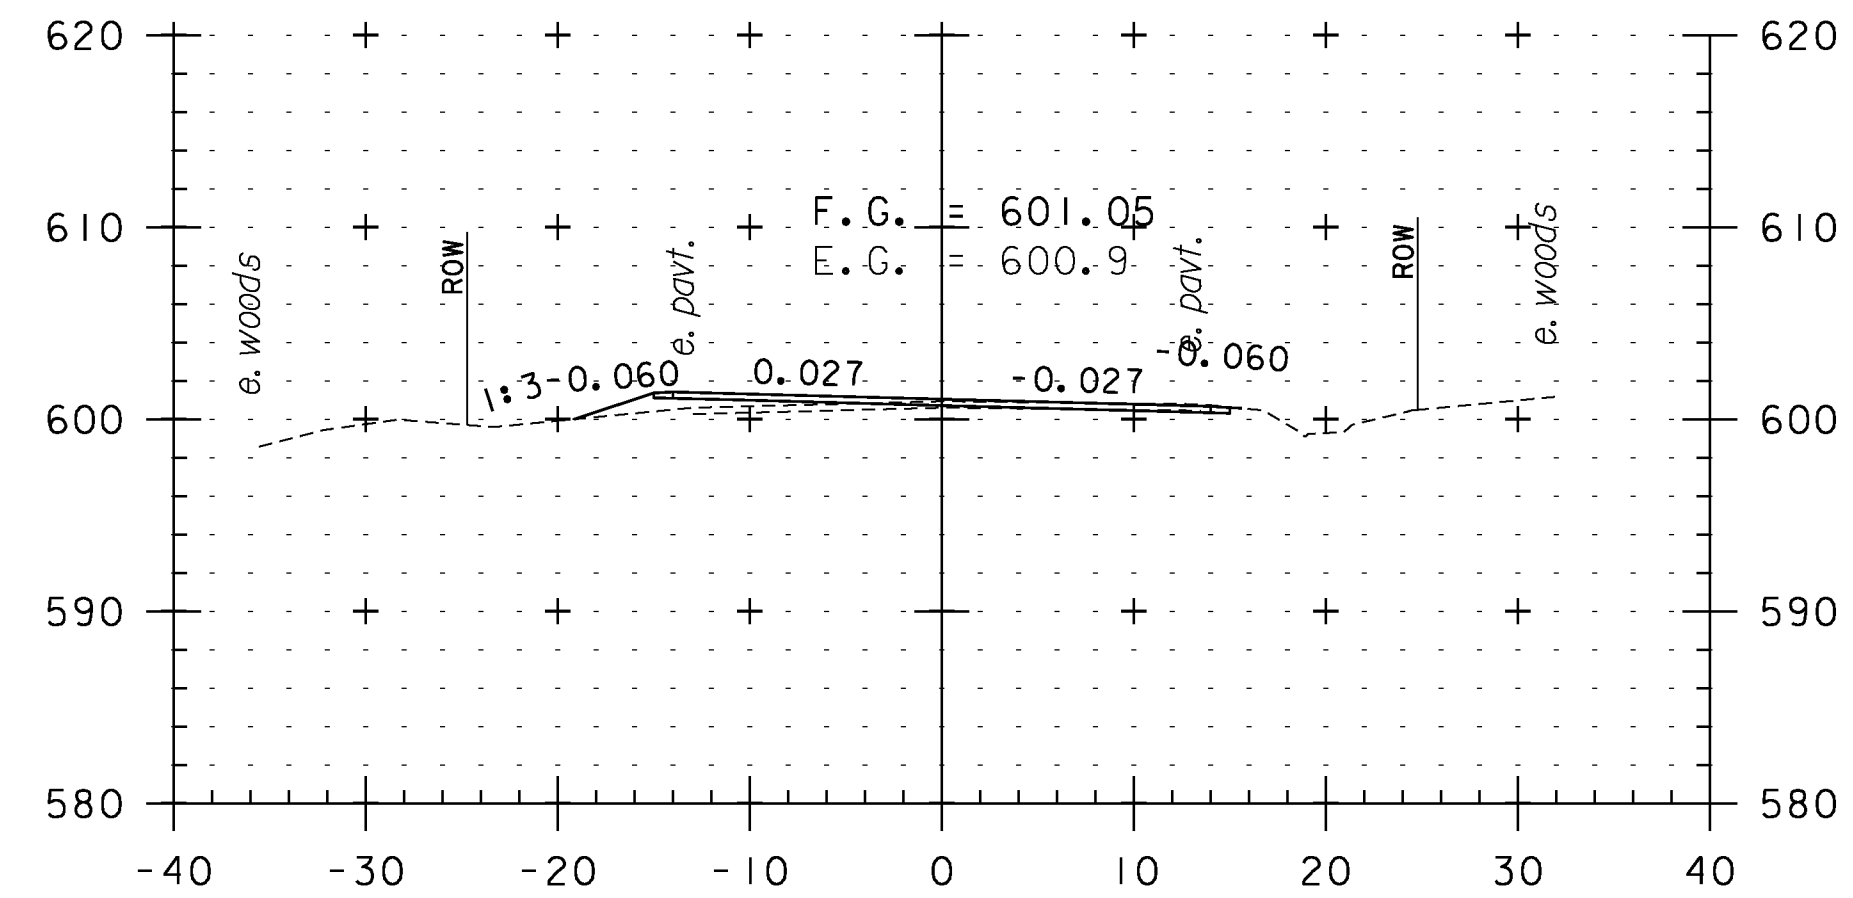


118+00

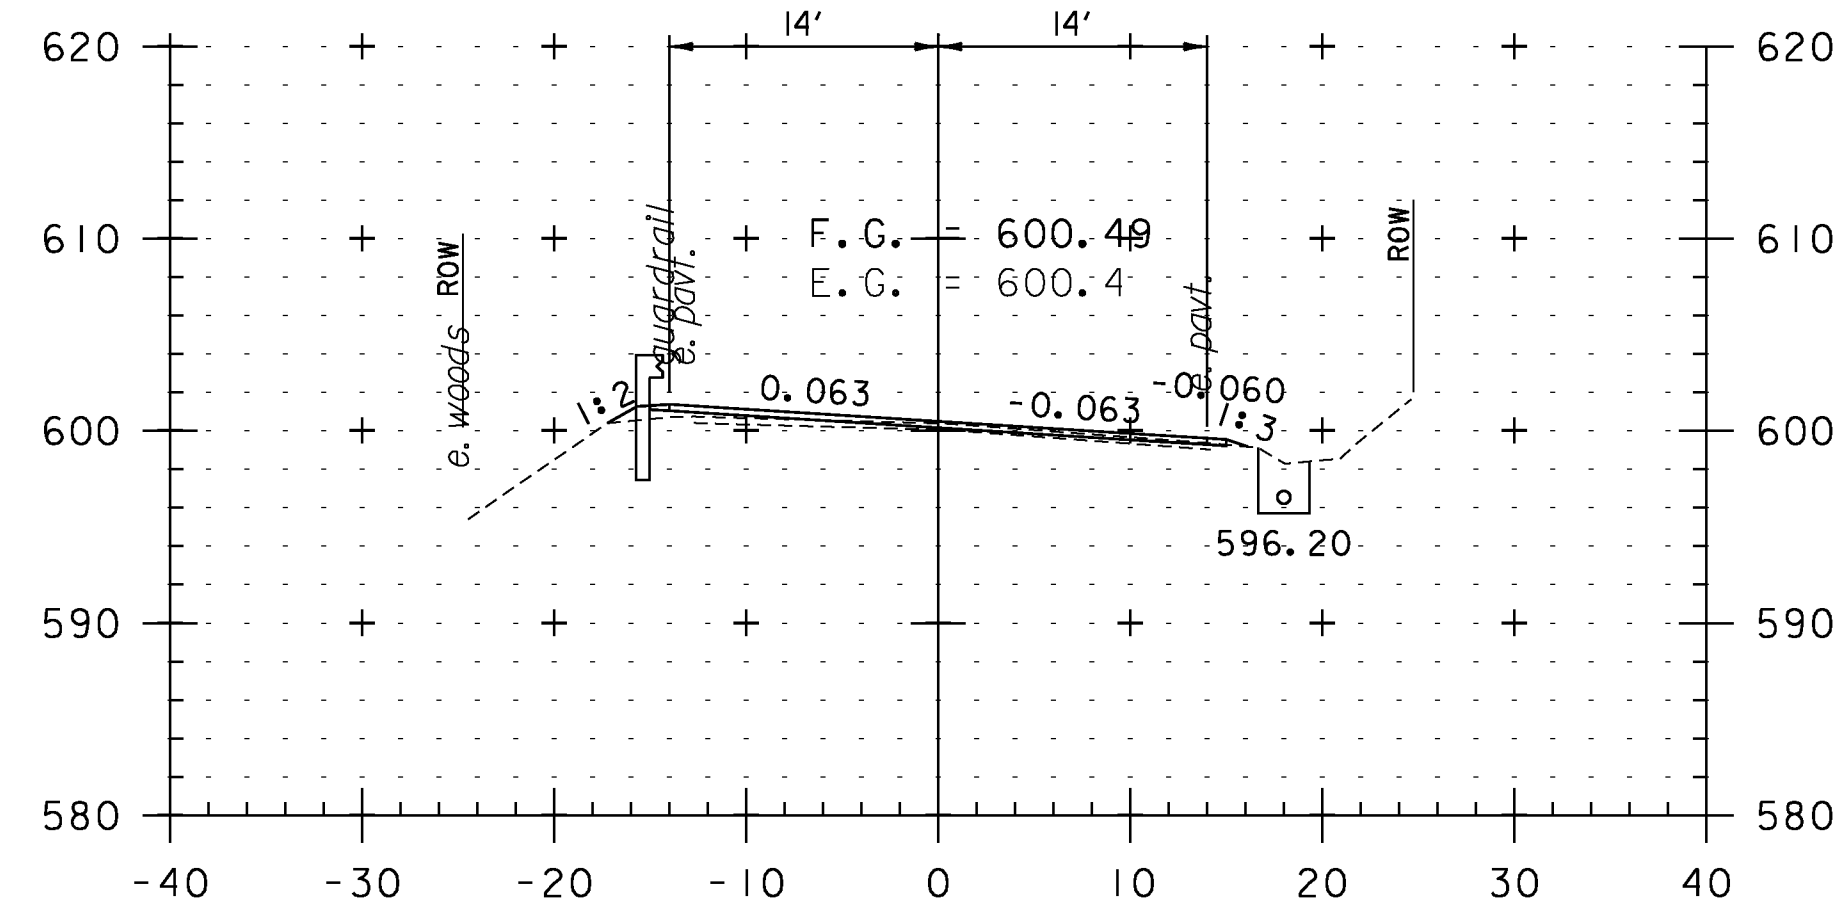

114+50

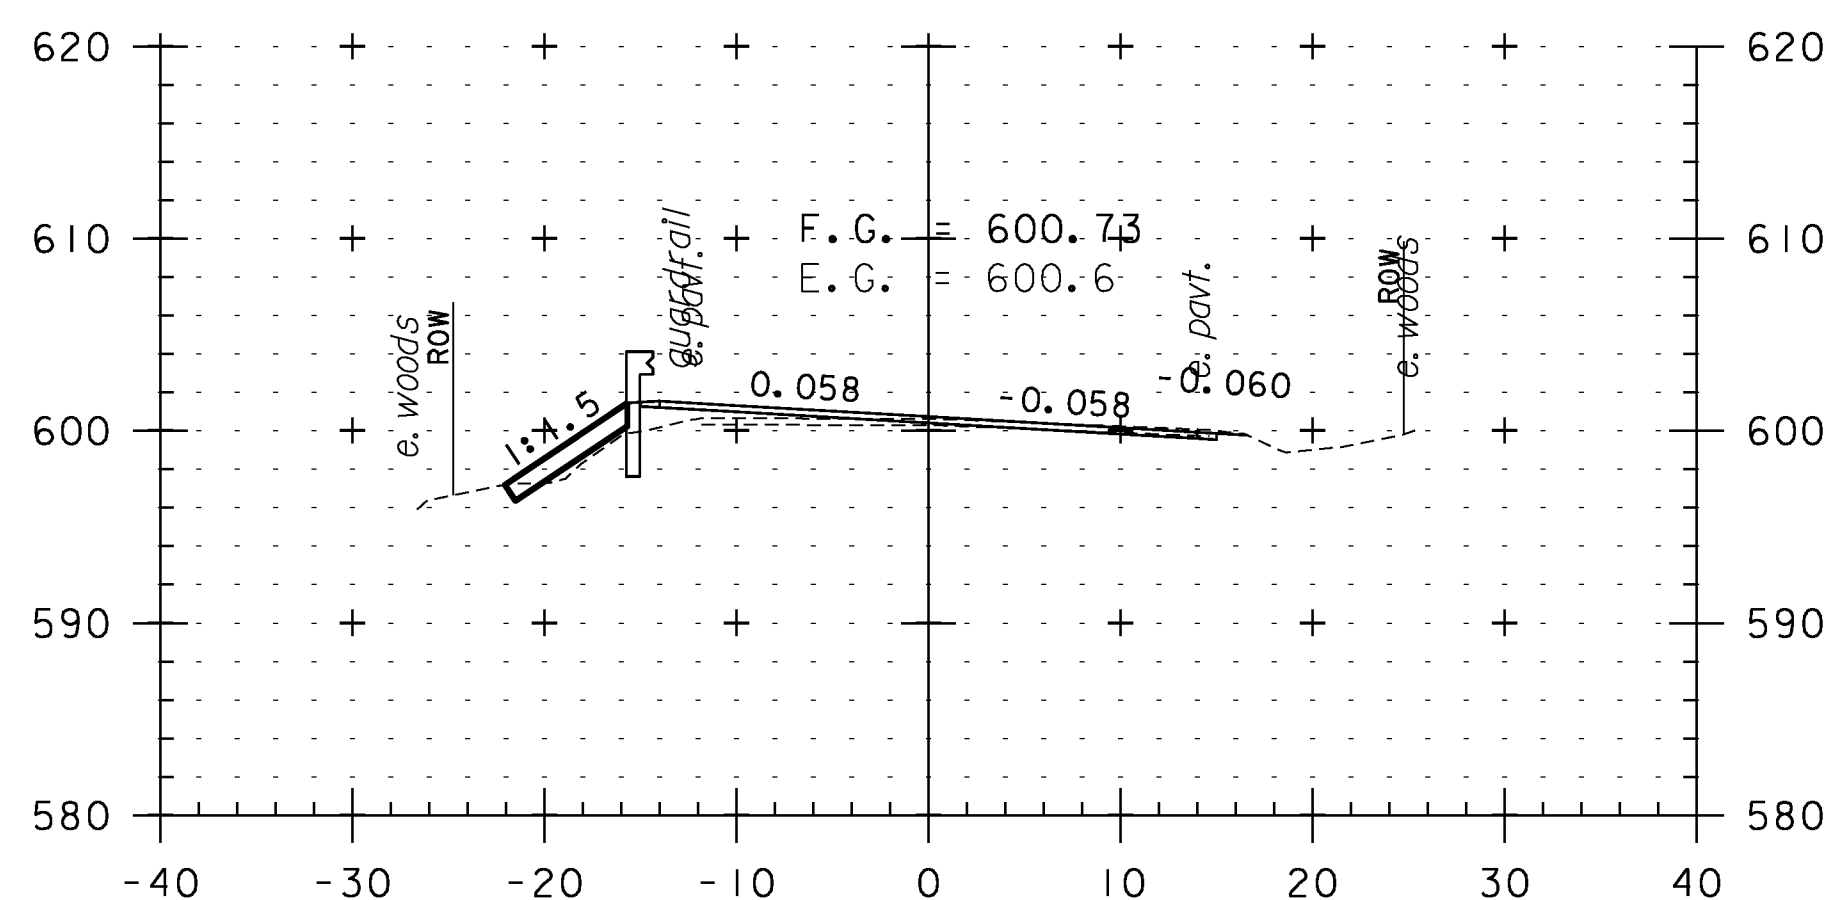

116+00

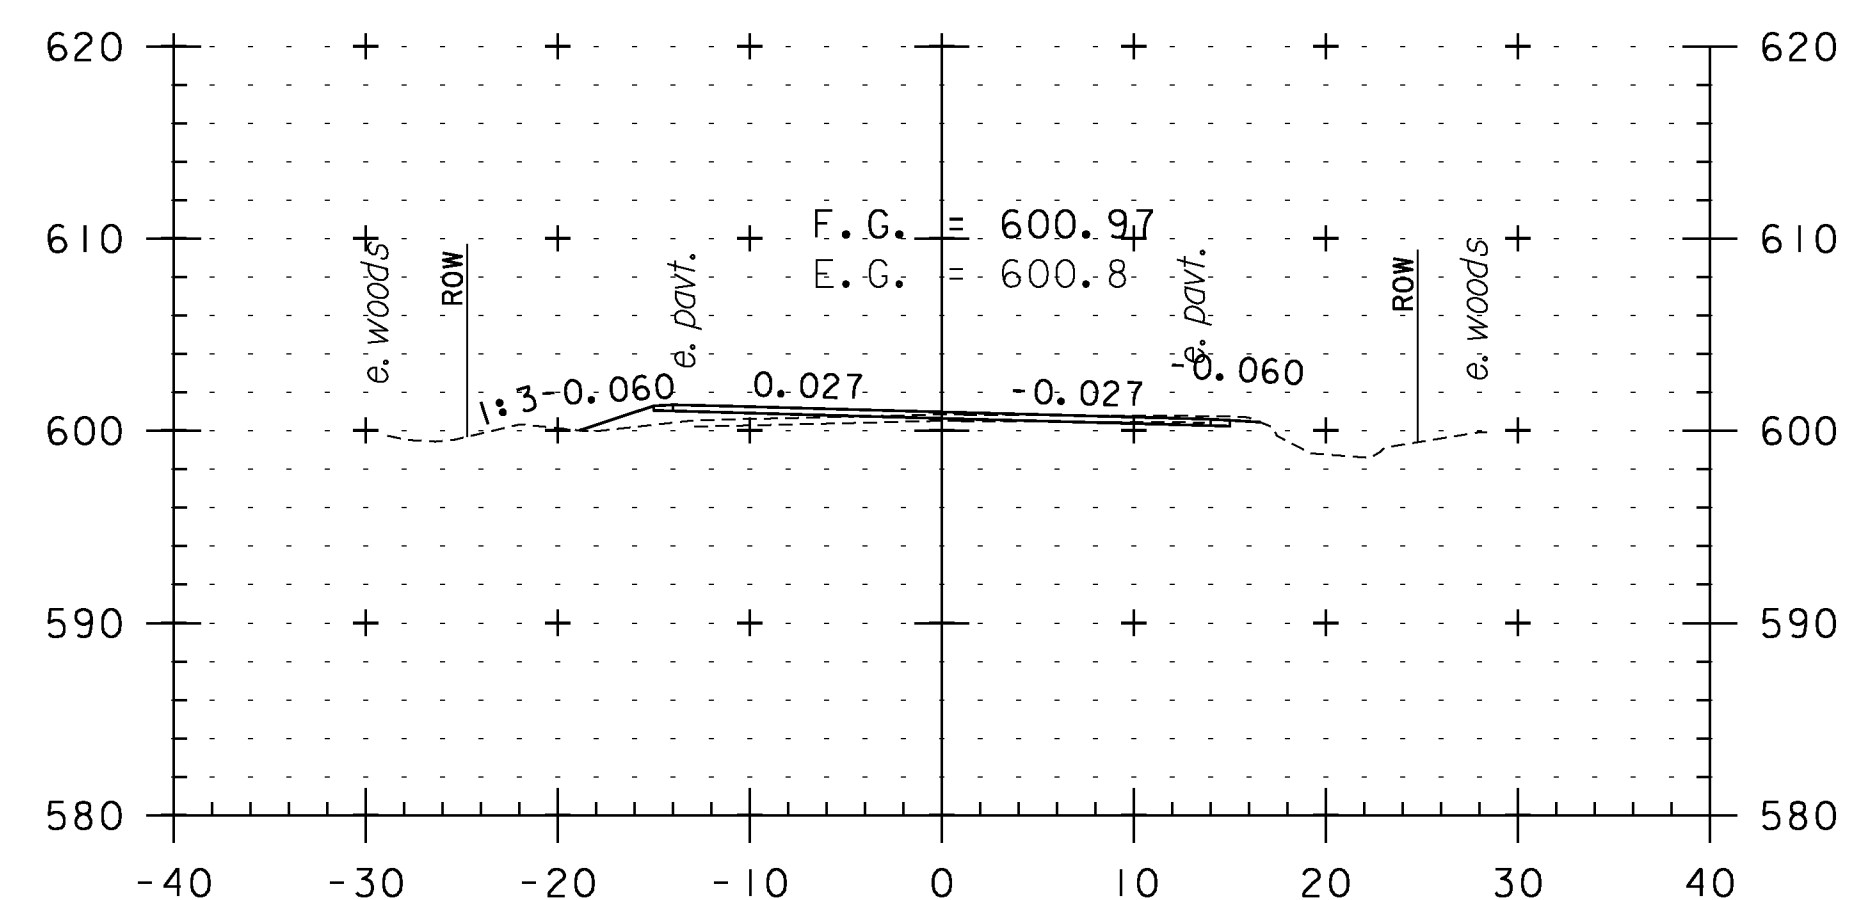

117+50

**CROSS SECTION SHEET 12**

|                              |                     |
|------------------------------|---------------------|
| PROJECT NAME: WEATHERSFIELD  | PLOT DATE: 2/7/2013 |
| PROJECT NUMBER: STP 2913(I)  | DRAWN BY: WWG       |
| FILE NAME: I0c228            | DESIGNED BY: NLL    |
| PROJECT LEADER: PTS          | CHECKED BY: PTS     |
| IPARM FILE NAME: pI0c228_I02 | SHEET 102 OF 234    |



STA. 114+50 TO STA. 118+50