




119+50

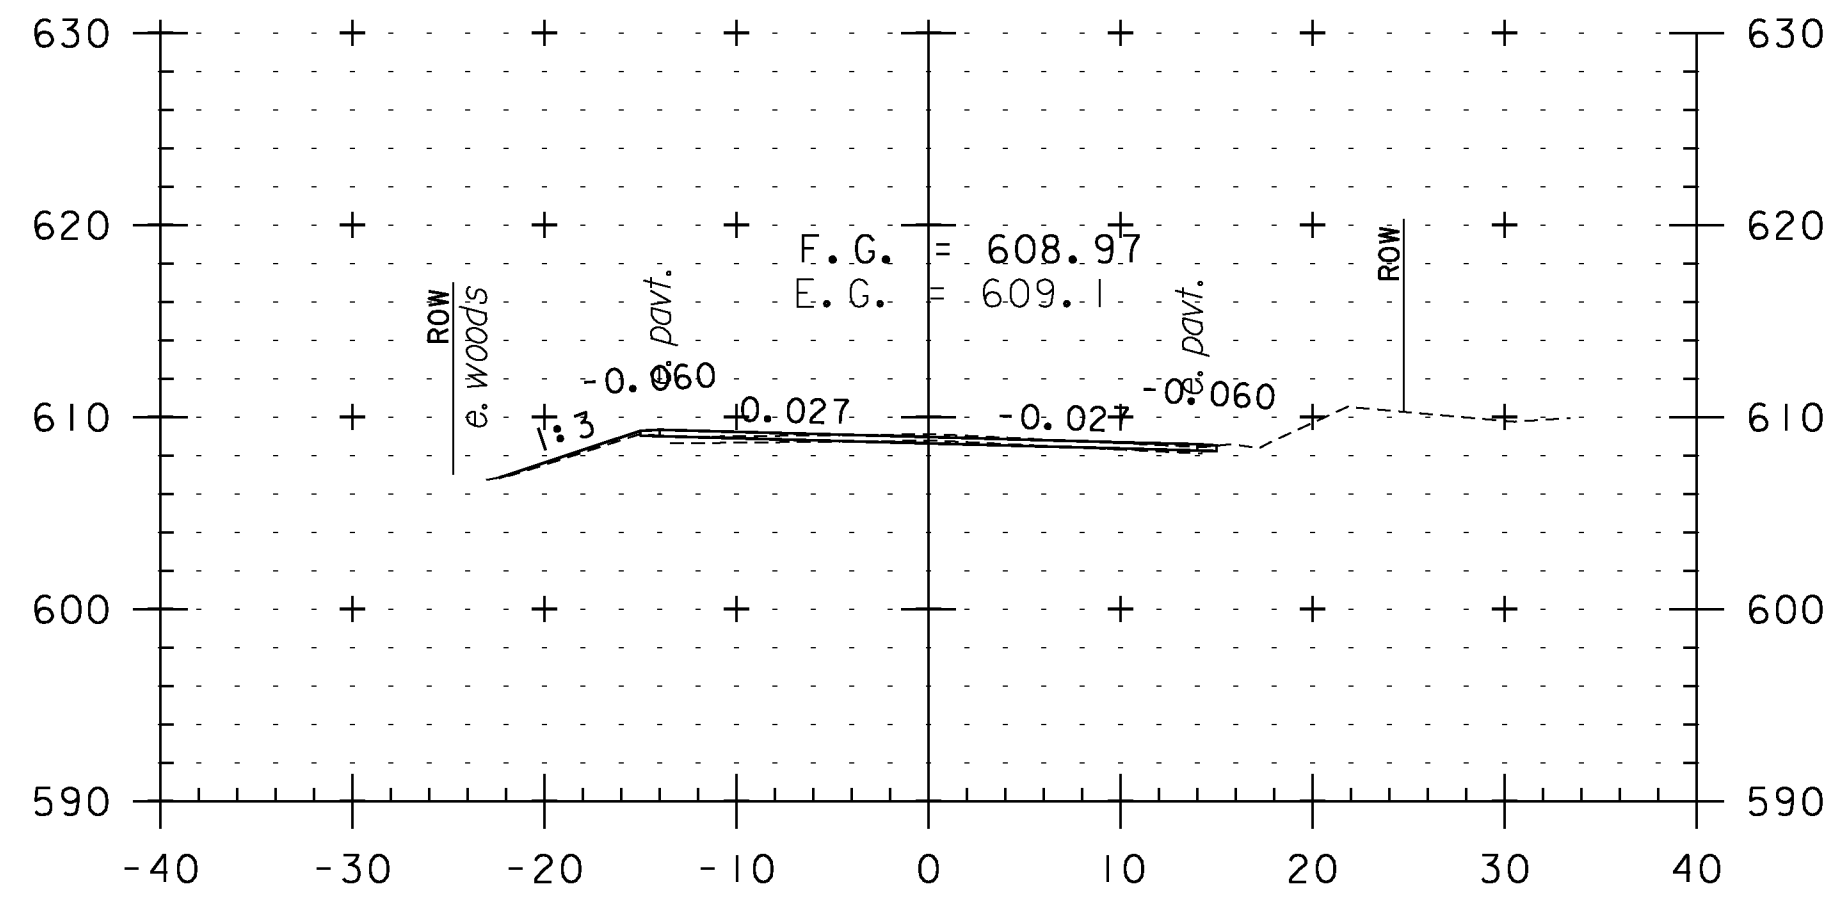


121+00

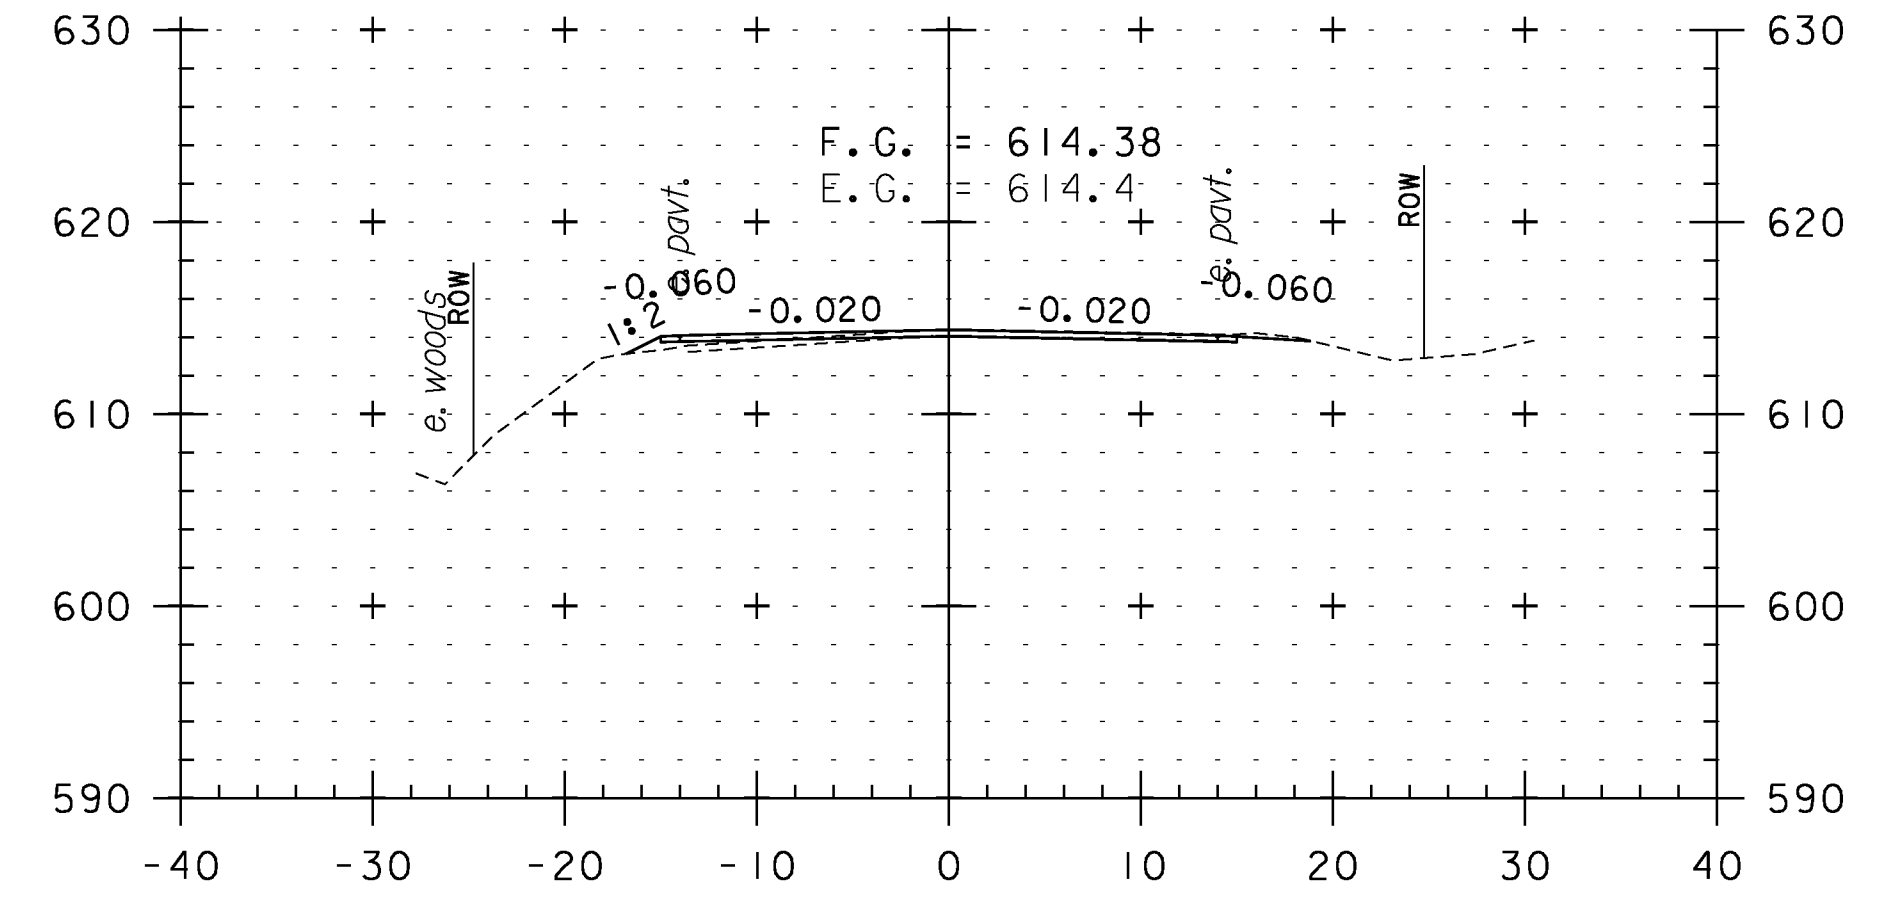


122+50

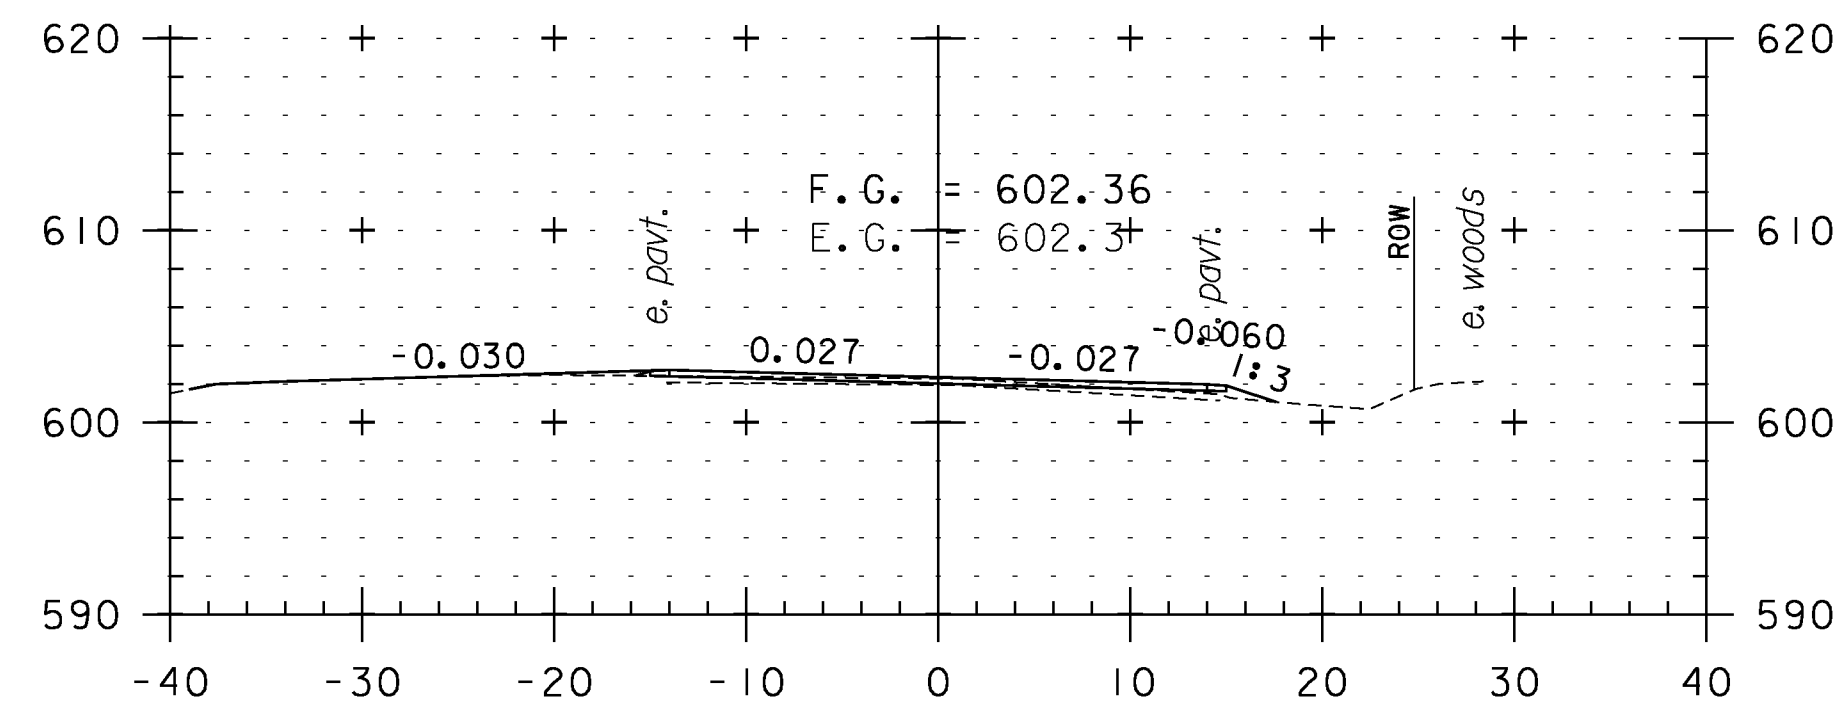


119+25
TH II

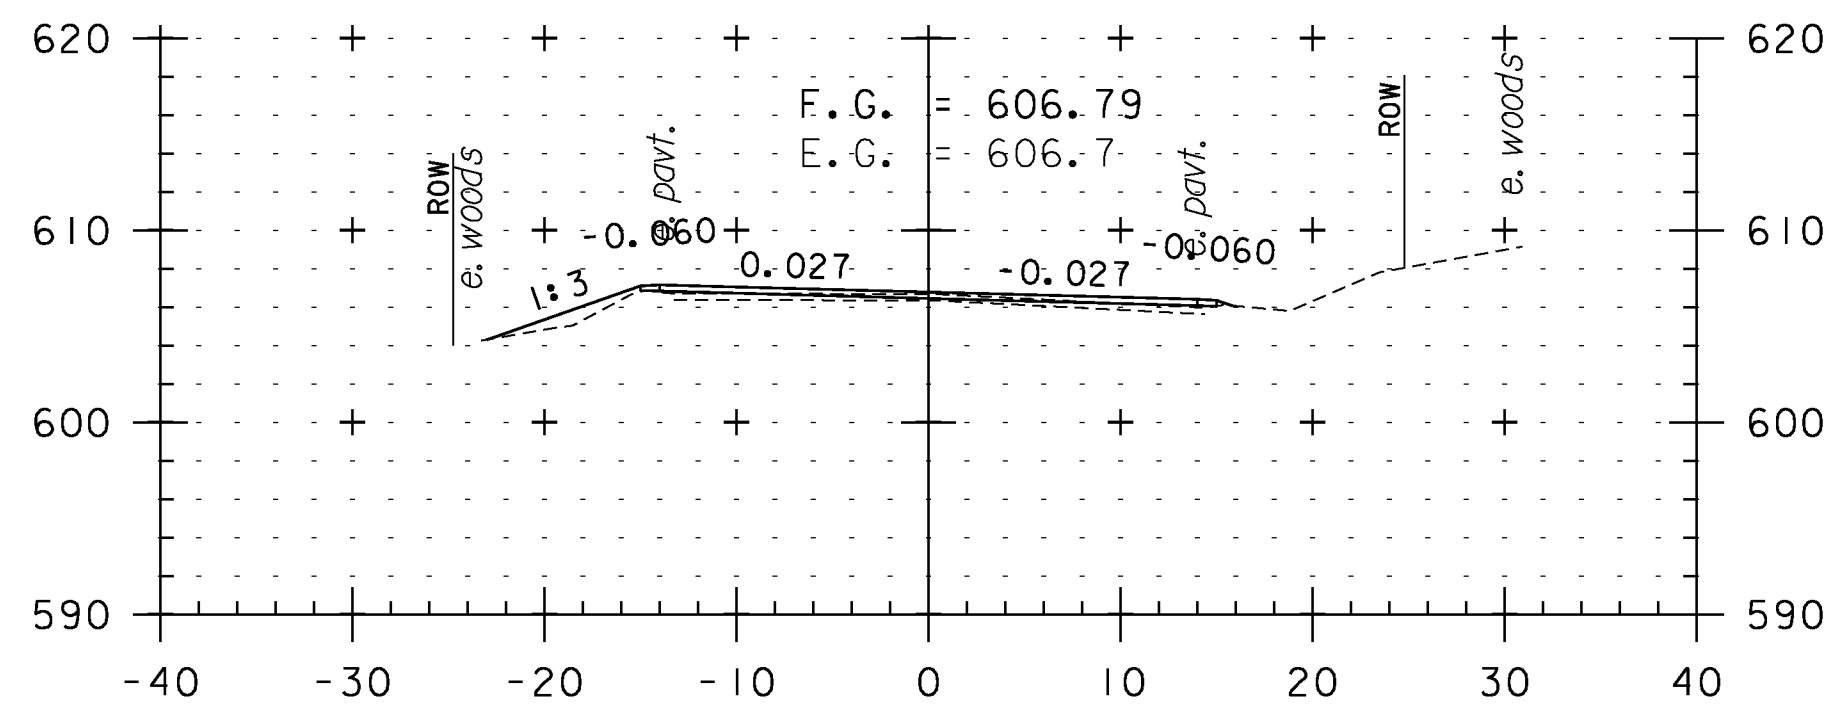


120+50

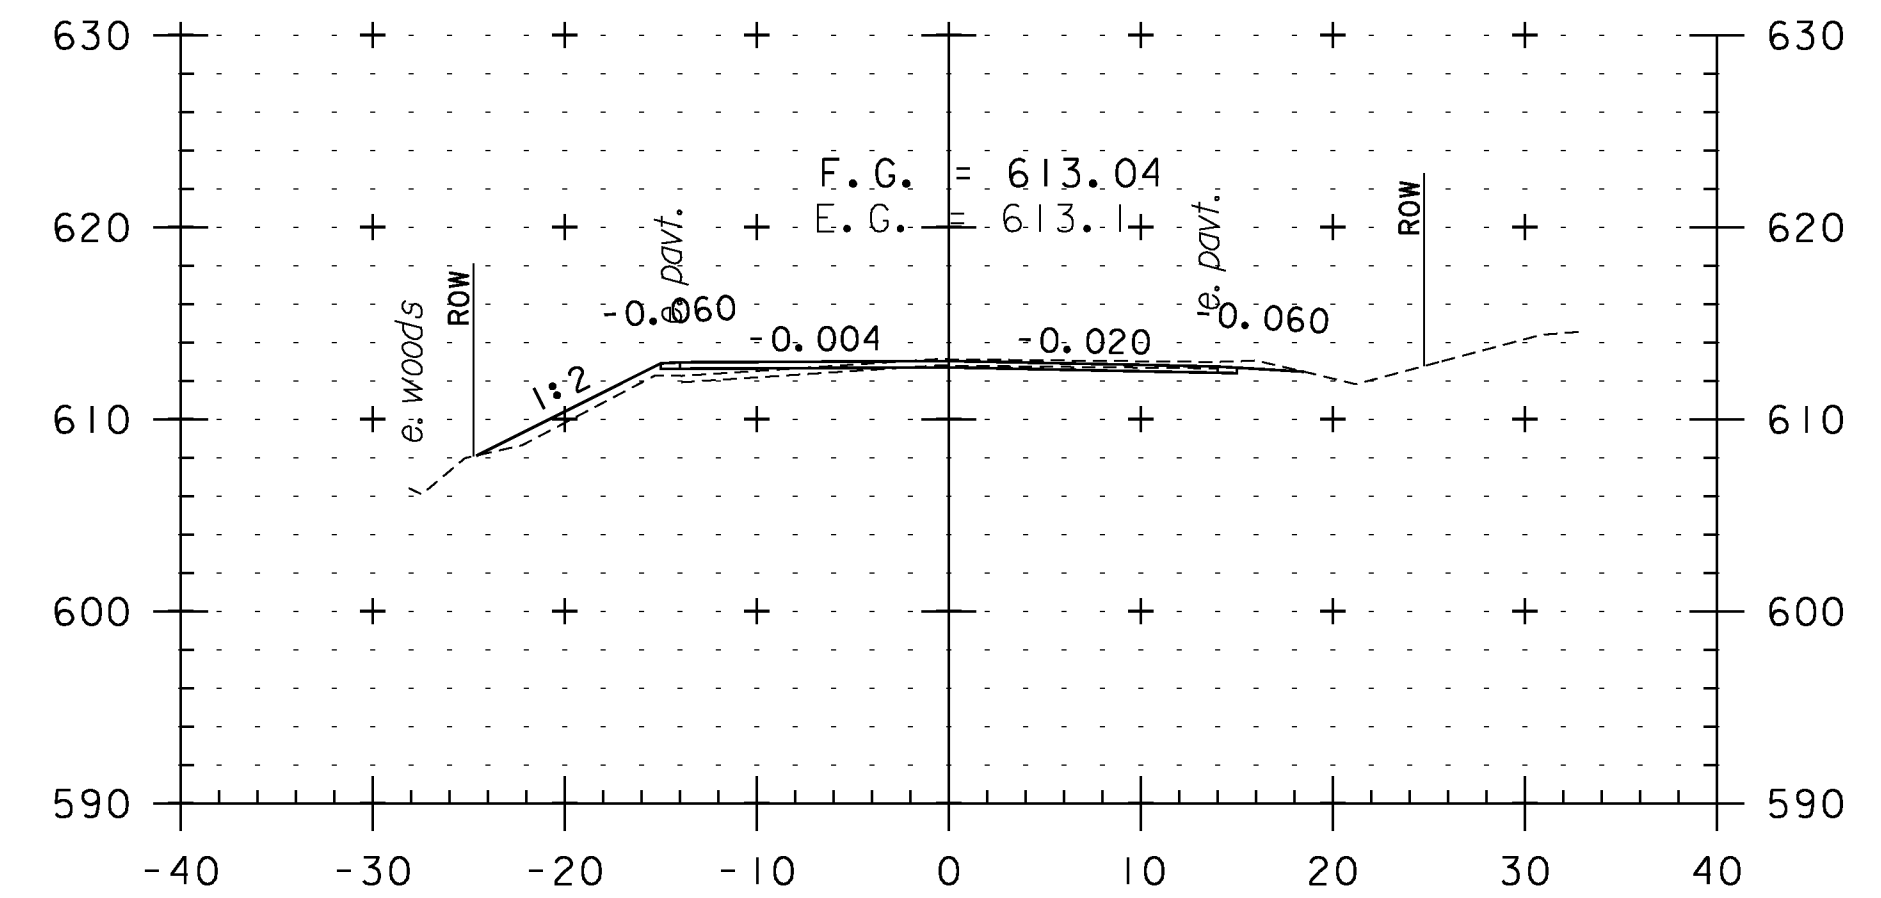


122+00

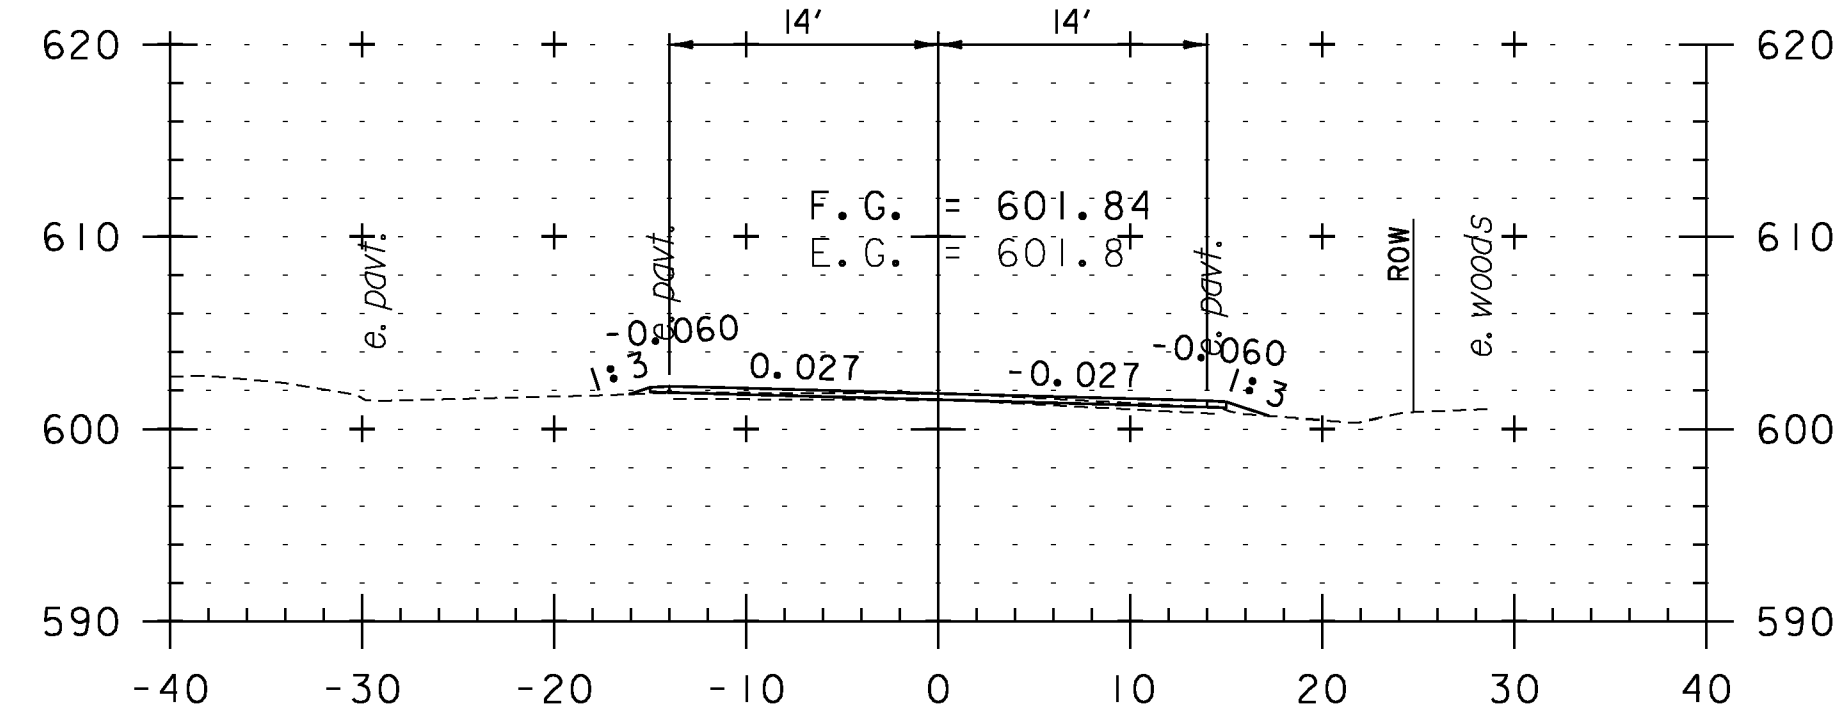

119+00

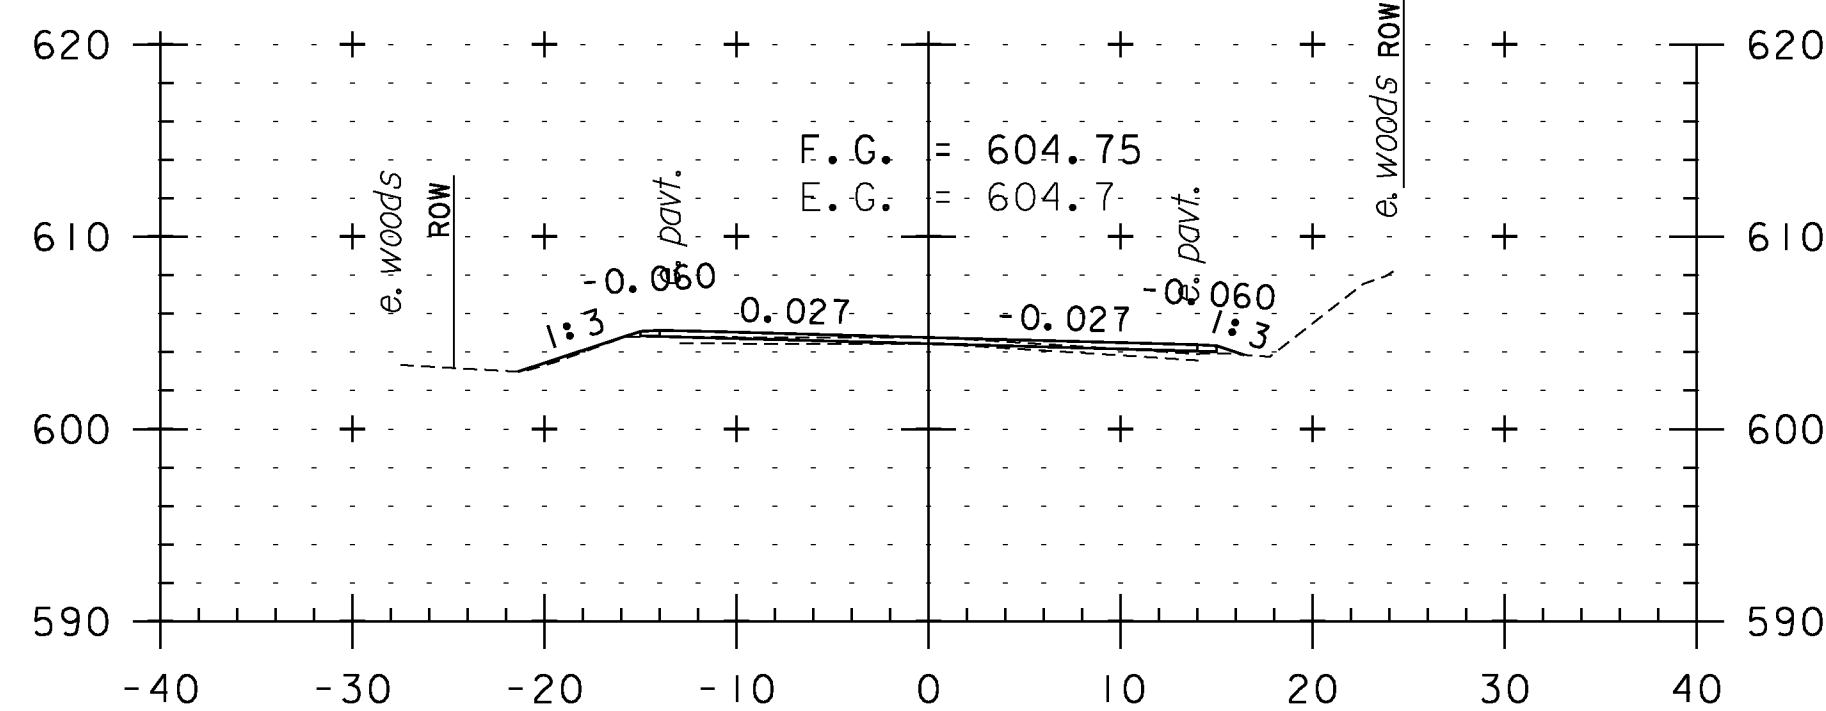

120+00

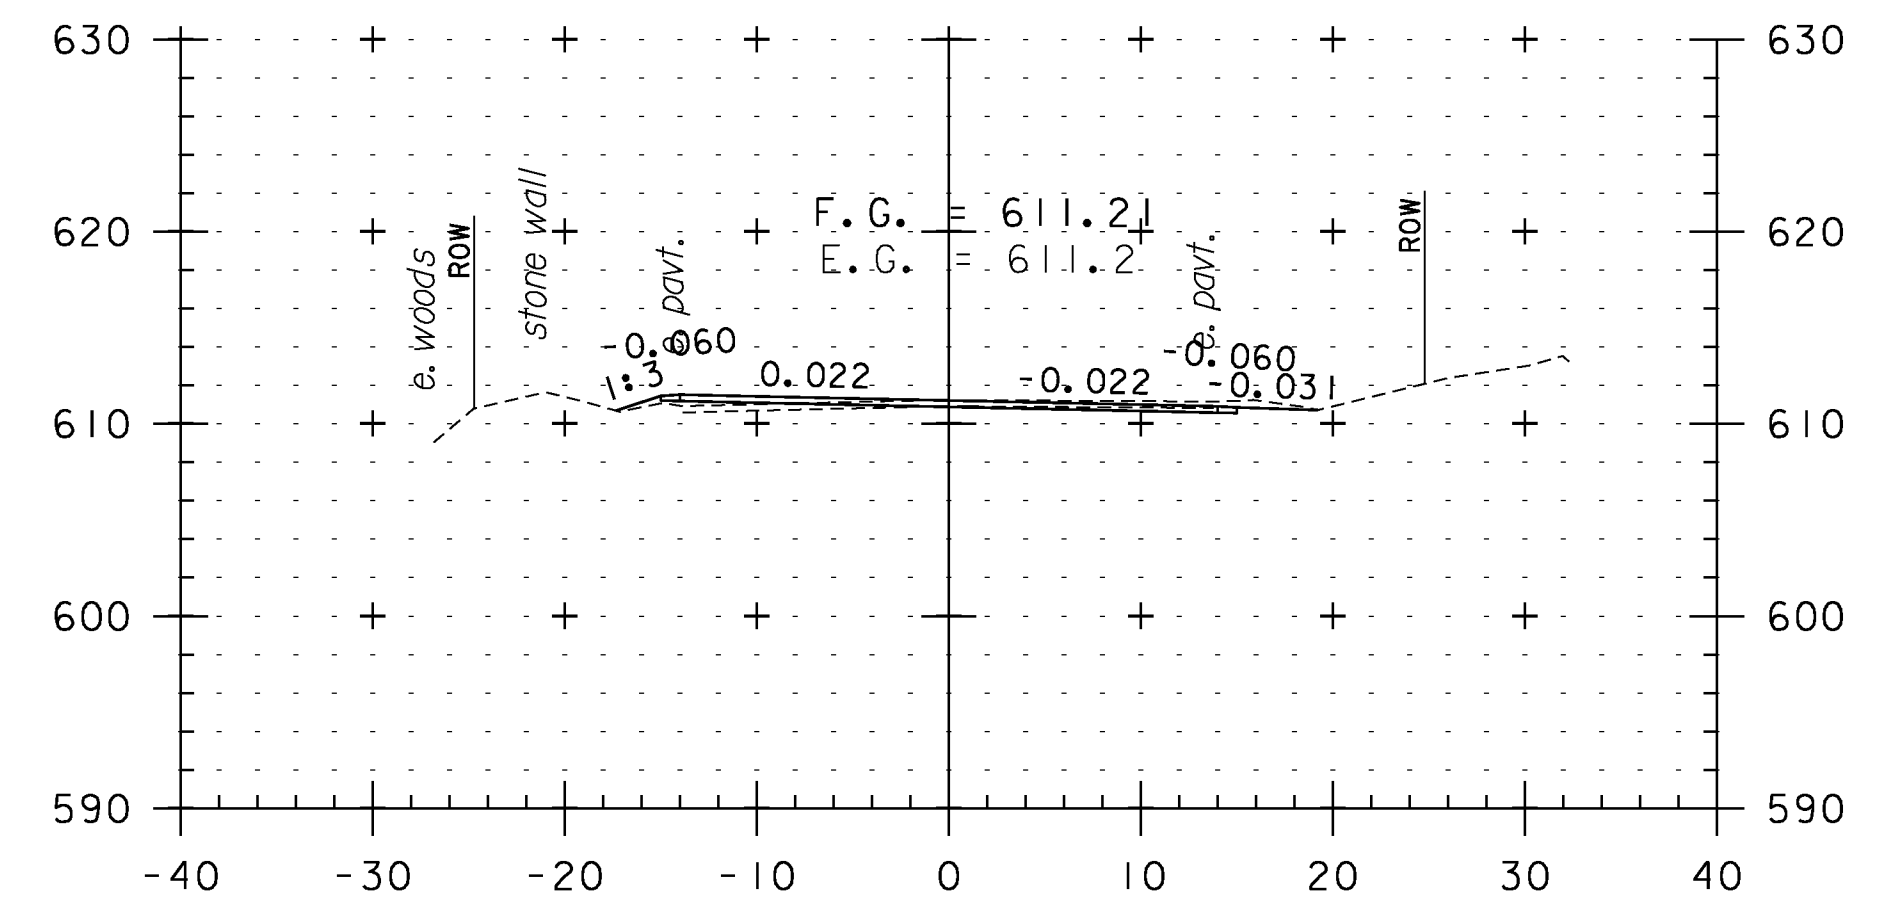

121+50

CROSS SECTION SHEET 13

PROJECT NAME: WEATHERSFIELD

PROJECT NUMBER: STP 2913(I)

FILE NAME: I0c228

PROJECT LEADER: PTS

DESIGNED BY: NLL

IPARM FILE NAME: pI0c228_I03

PLOT DATE: 2/7/2013

DRAWN BY: WWG

CHECKED BY: PTS

SHEET 103 OF 234



STA. 119+00 TO STA. 122+50