




124+00

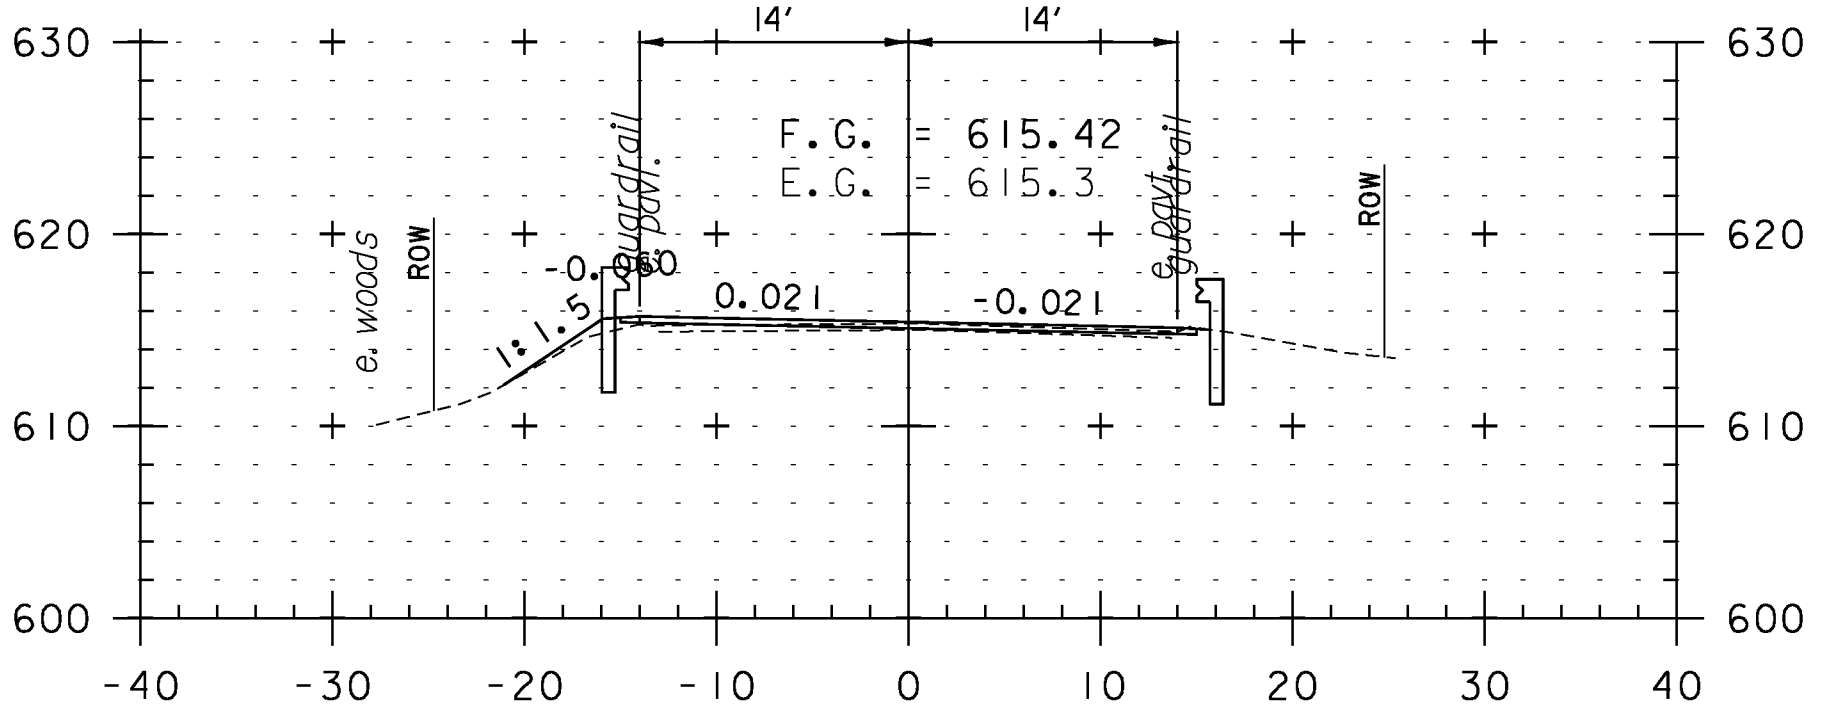


125+50

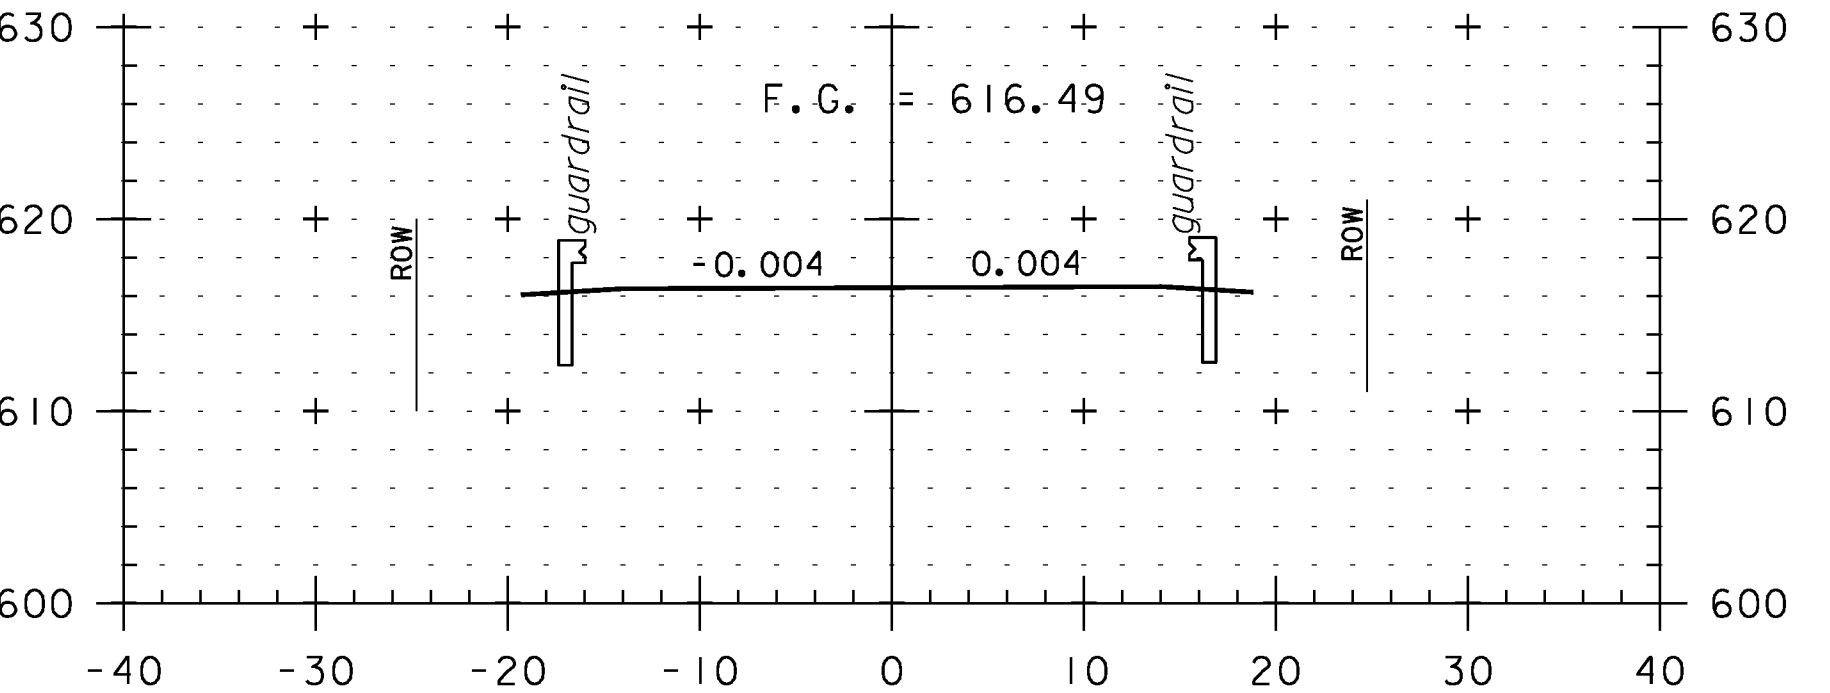


126+50  
BRIDGE II

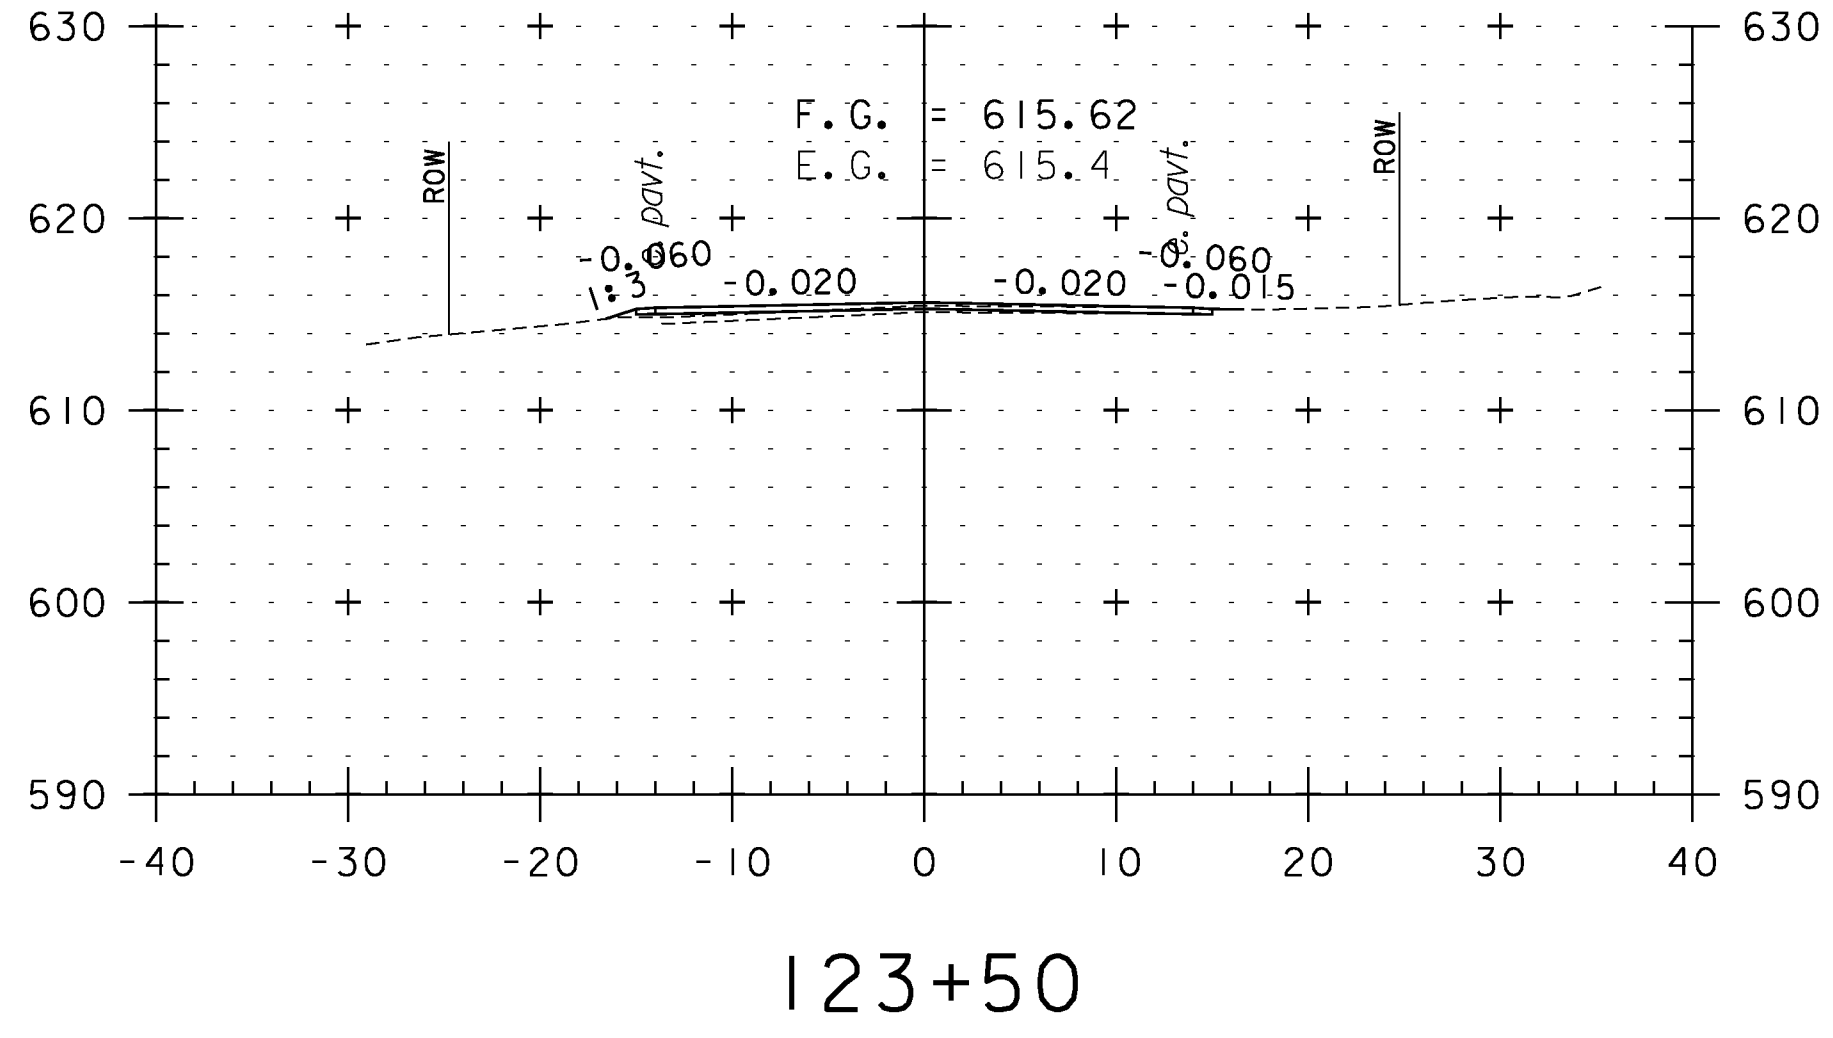


123+50

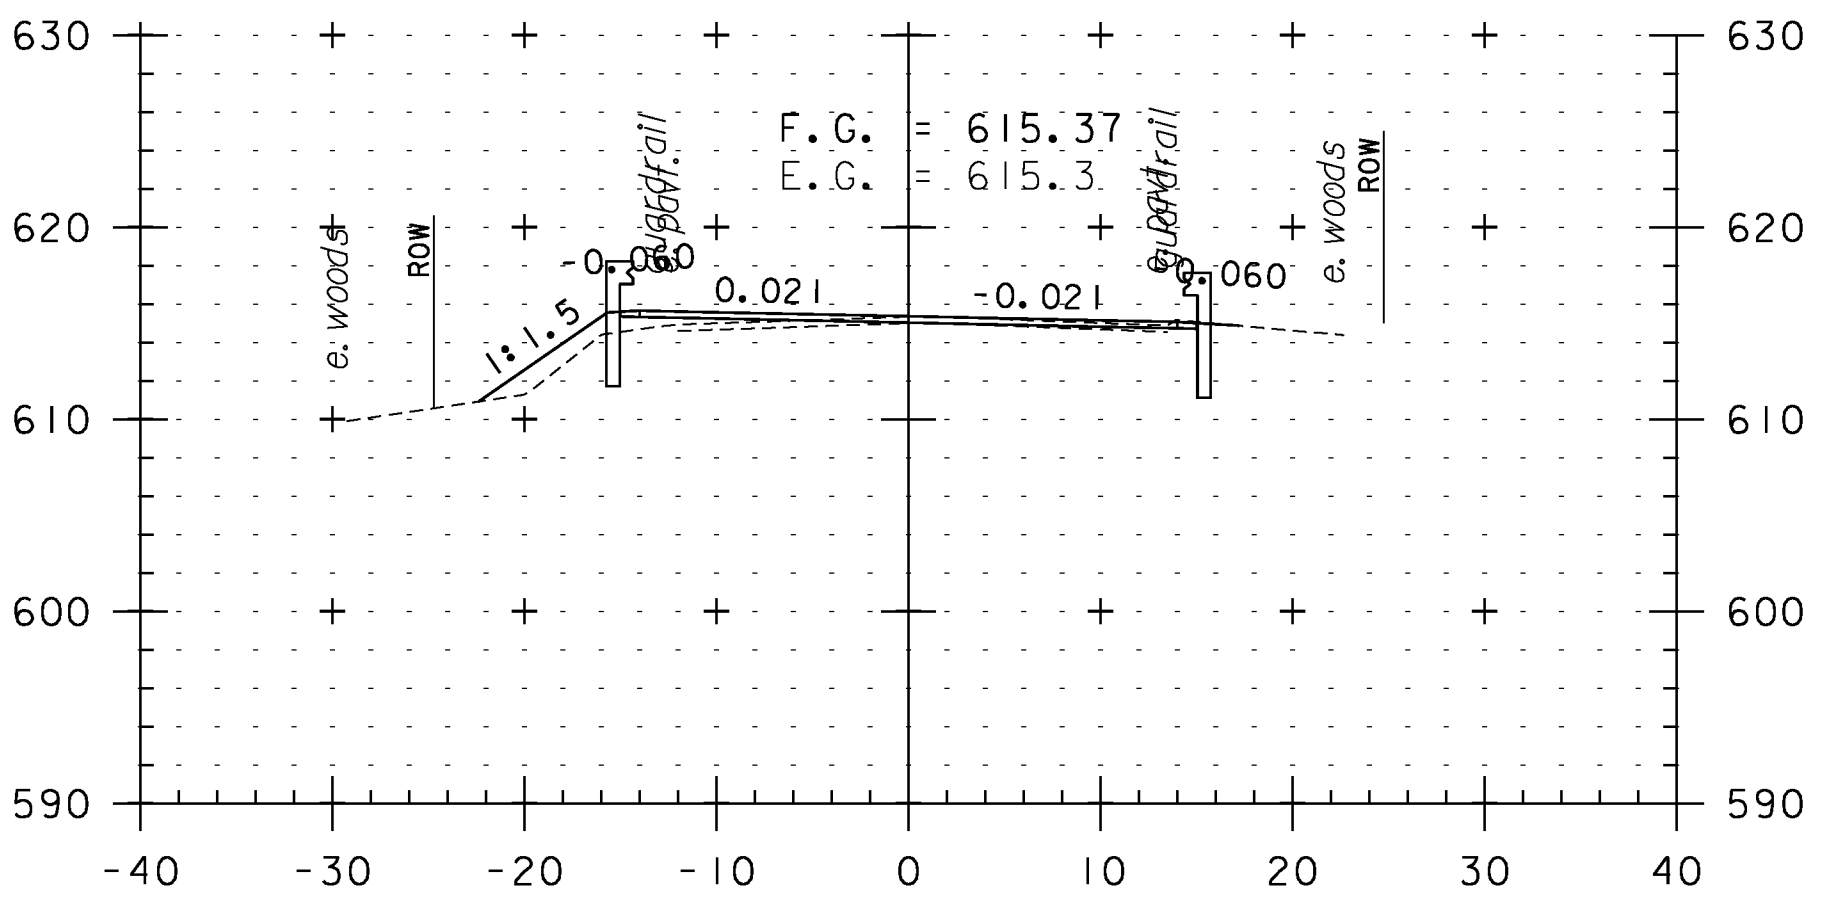


125+00

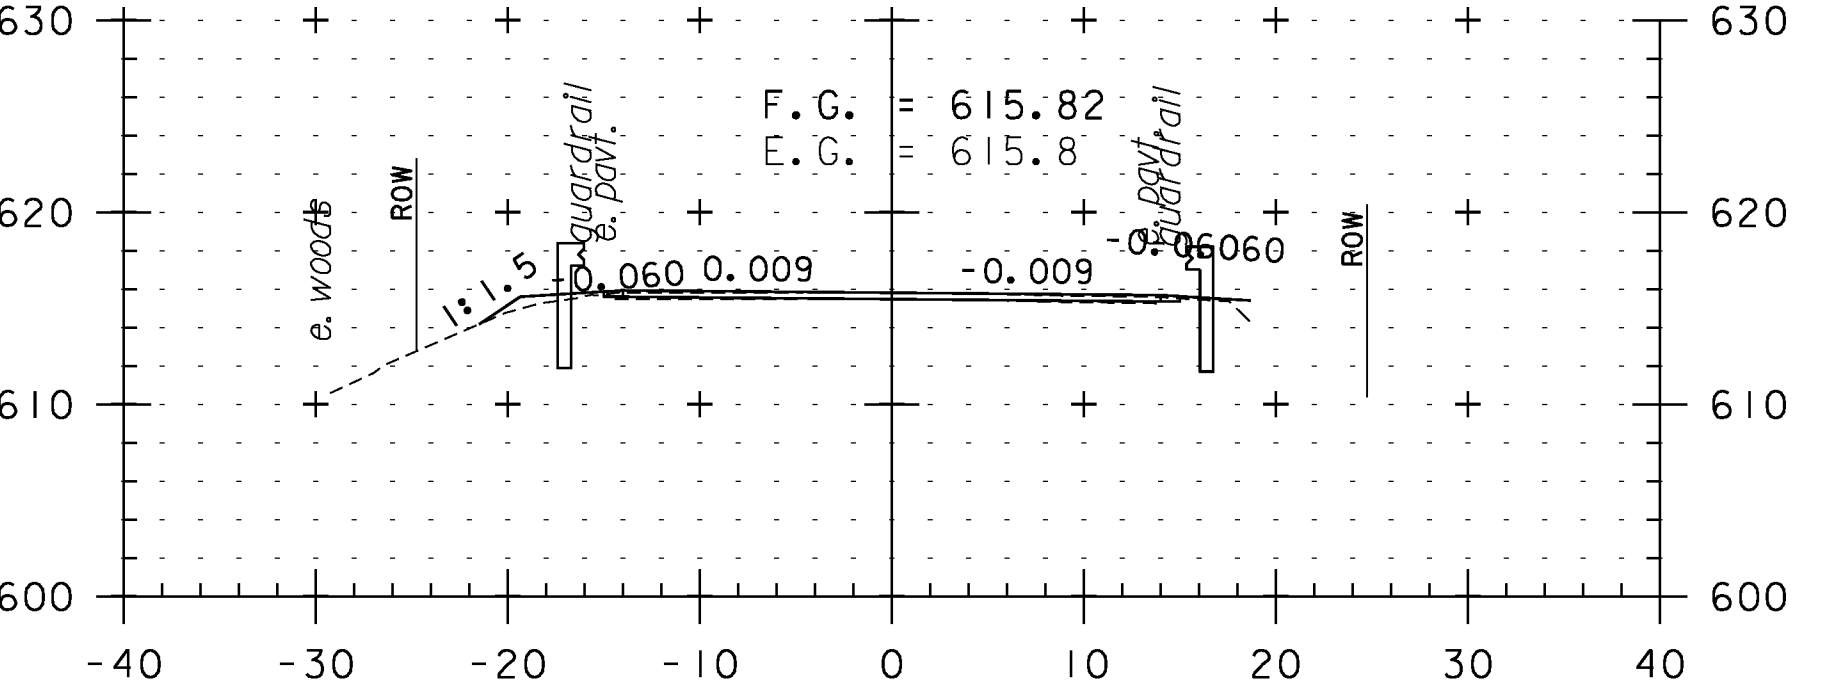


126+10  
BRIDGE II APPROACH

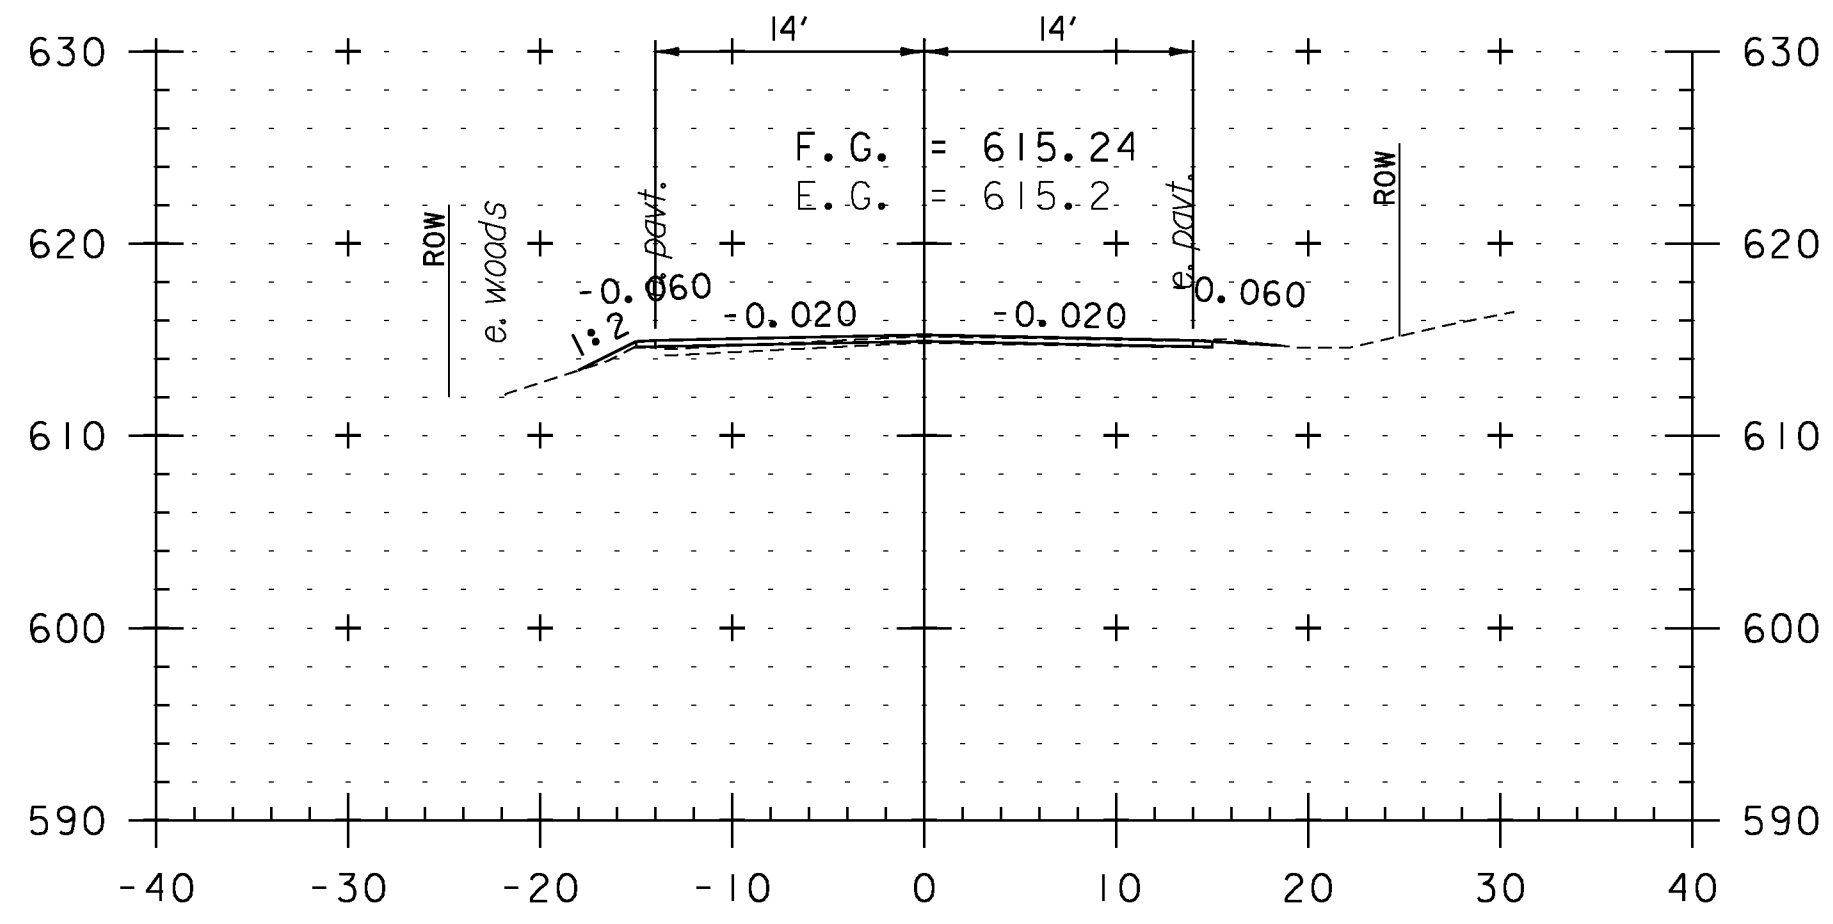

123+00

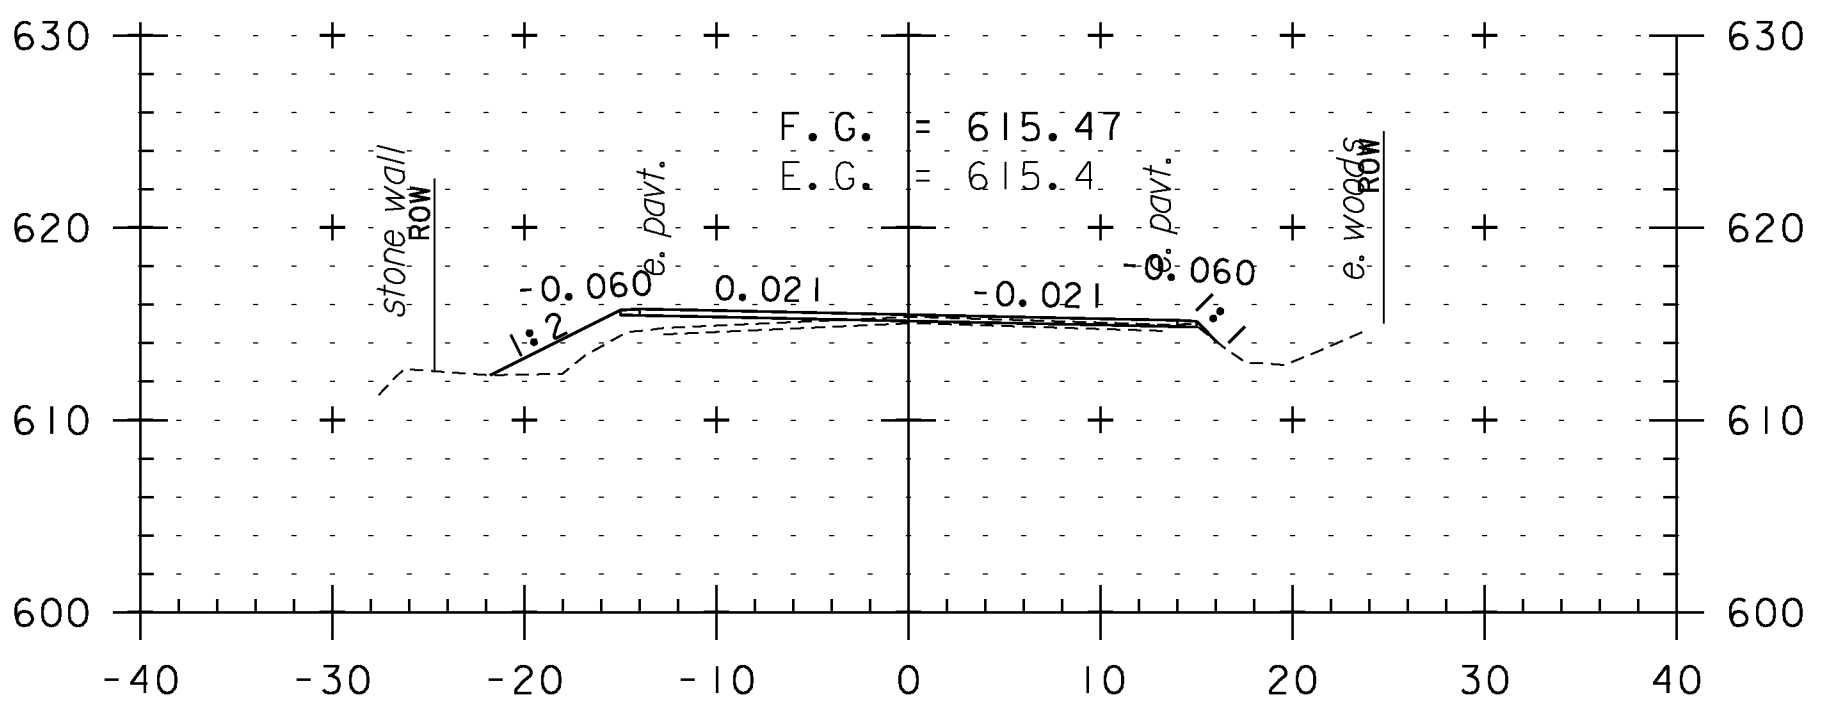

124+50

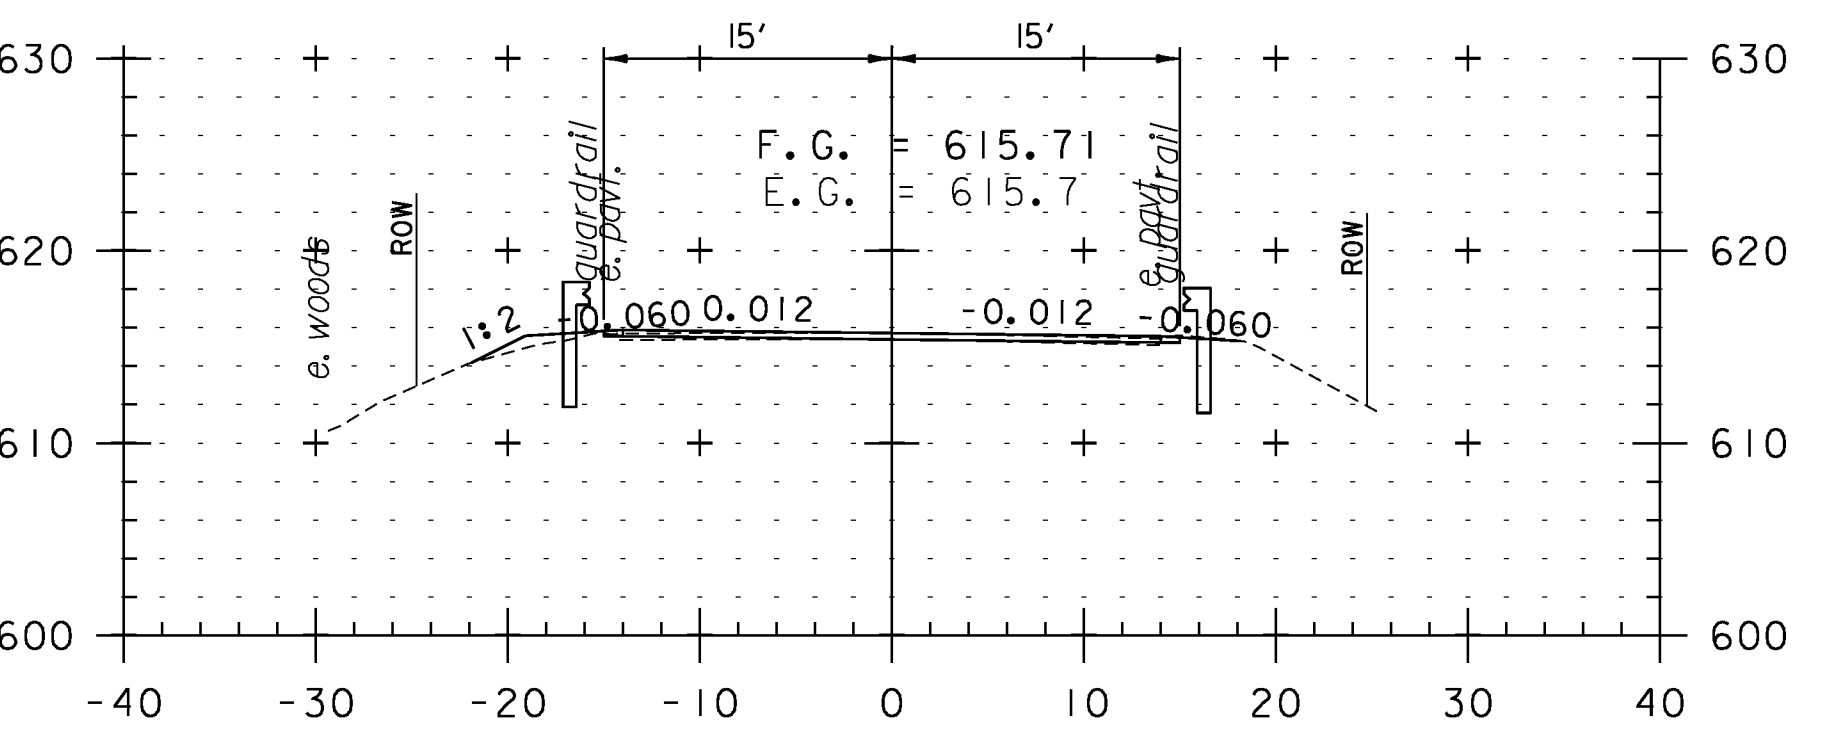

126+00

**CROSS SECTION SHEET 14**

PROJECT NAME: WEATHERSFIELD	PLOT DATE: 2/7/2013
PROJECT NUMBER: STP 2913(I)	DRAWN BY: WWG
FILE NAME: I0c228	CHECKED BY: PTS
PROJECT LEADER: PTS	SHEET 104 OF 234
DESIGNED BY: NLL	
IPARM FILE NAME: pI0c228_I04	



STA. 123+00 TO STA. 126+50