




132+00

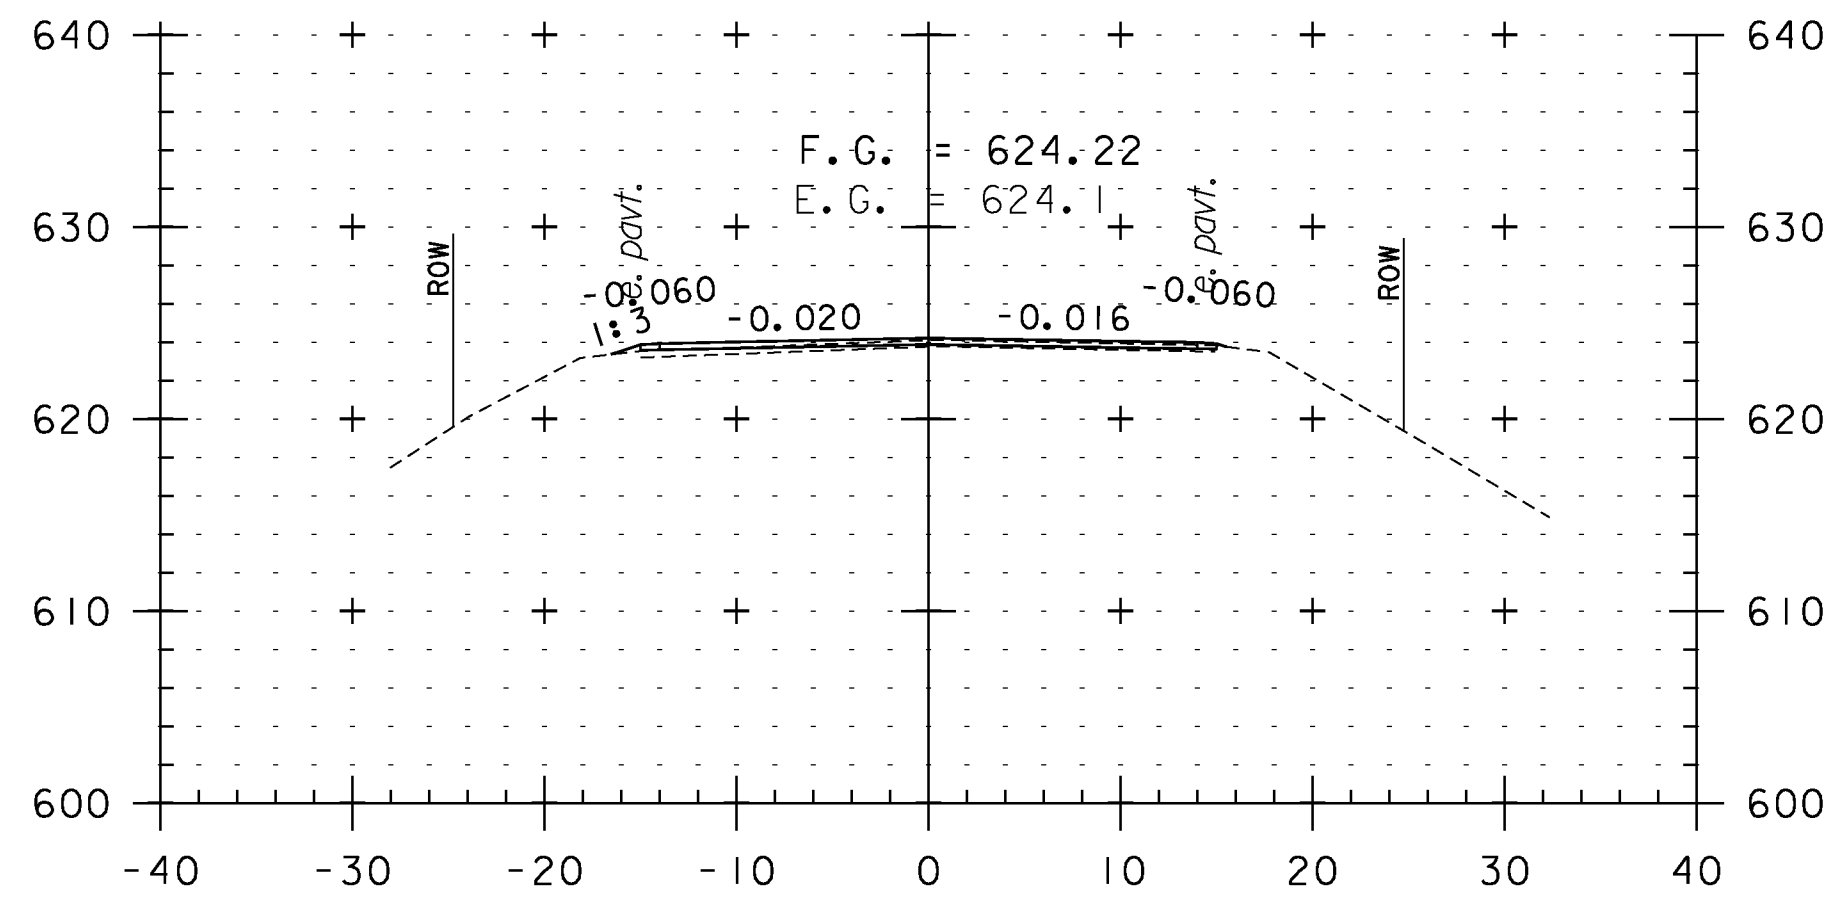


133+50

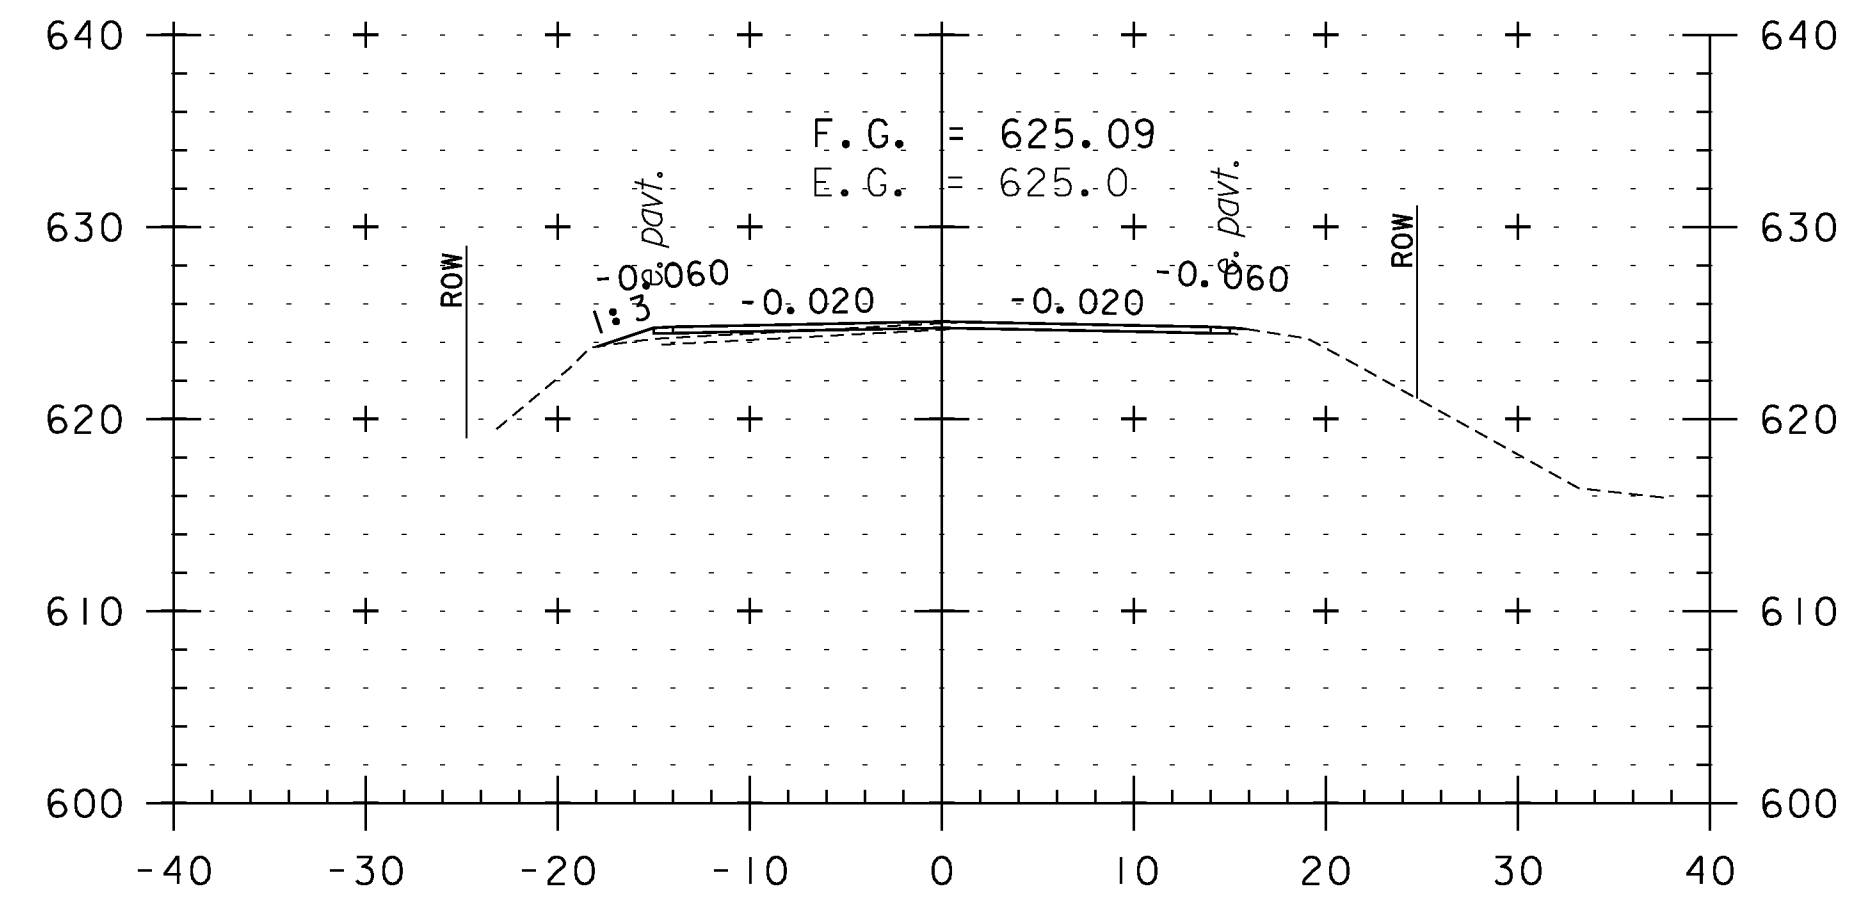


135+00

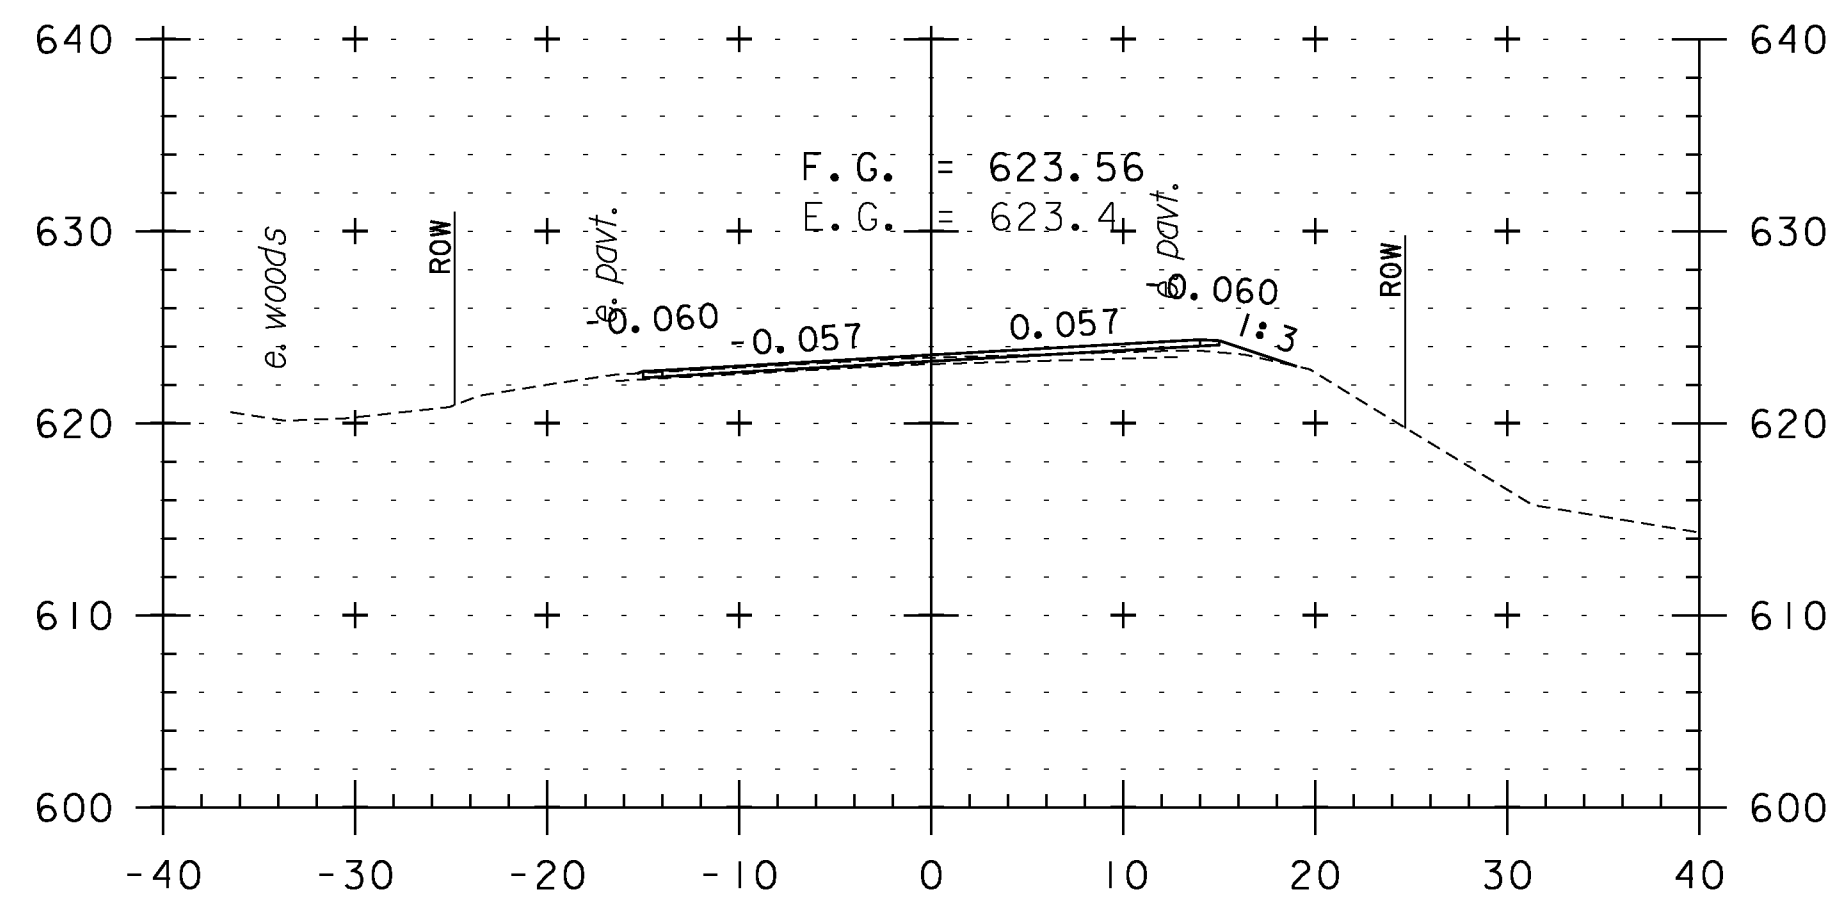


131+50

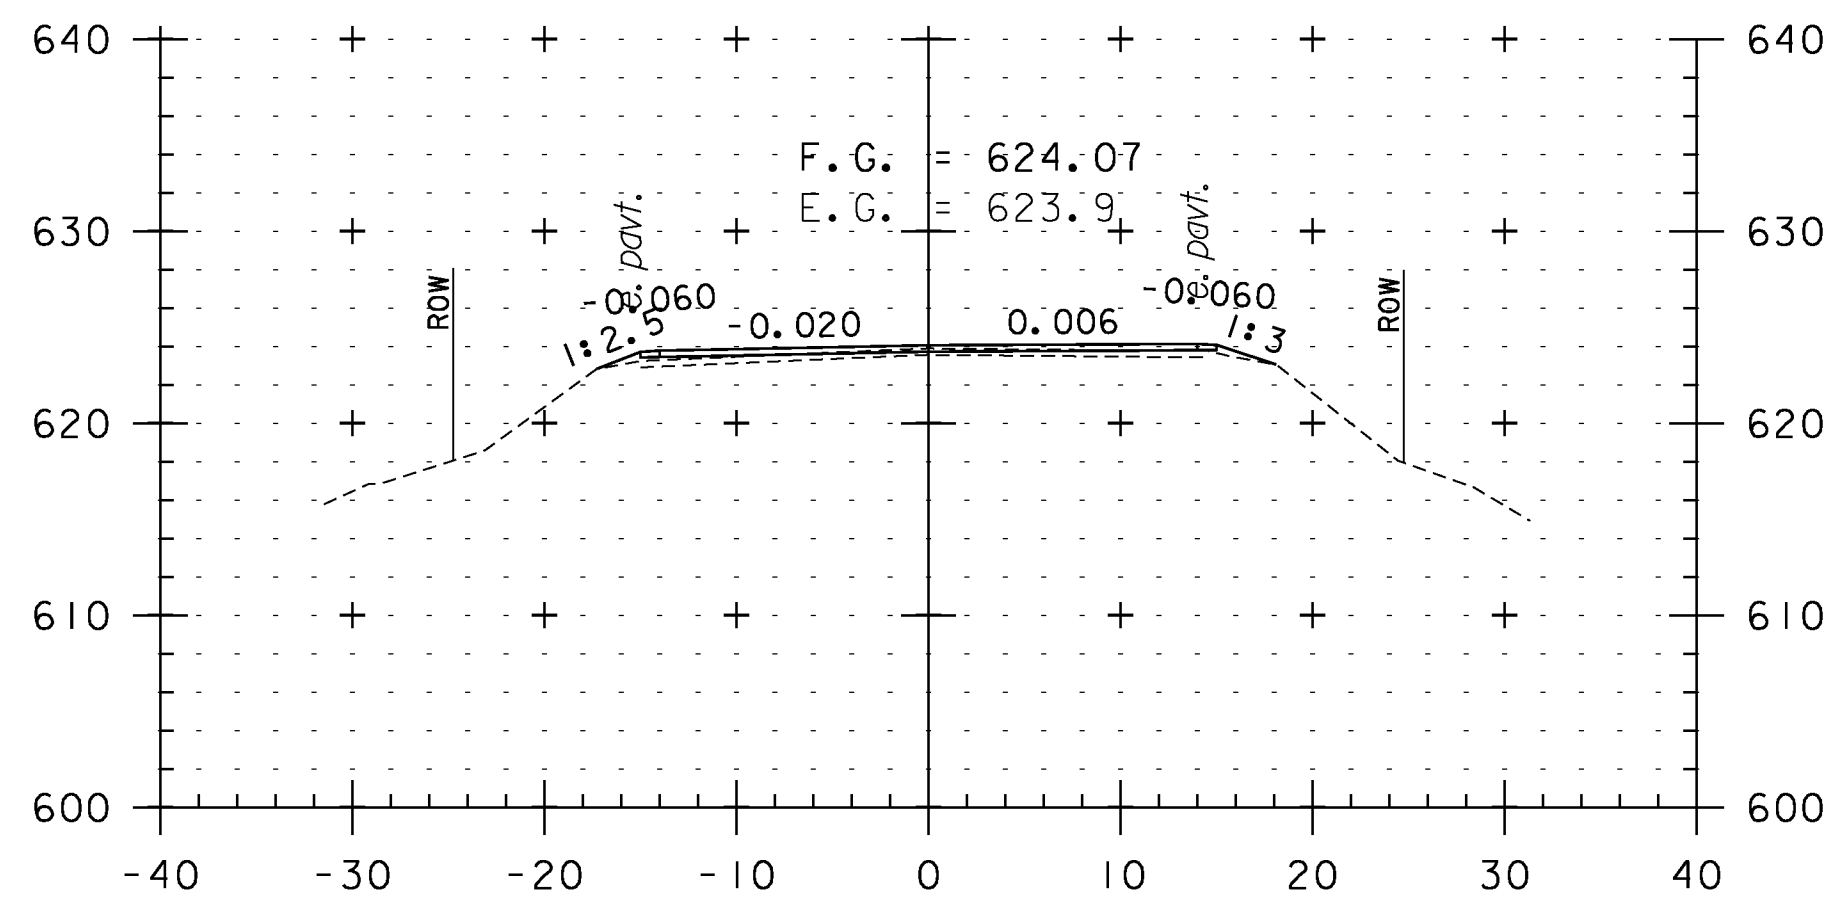


133+00

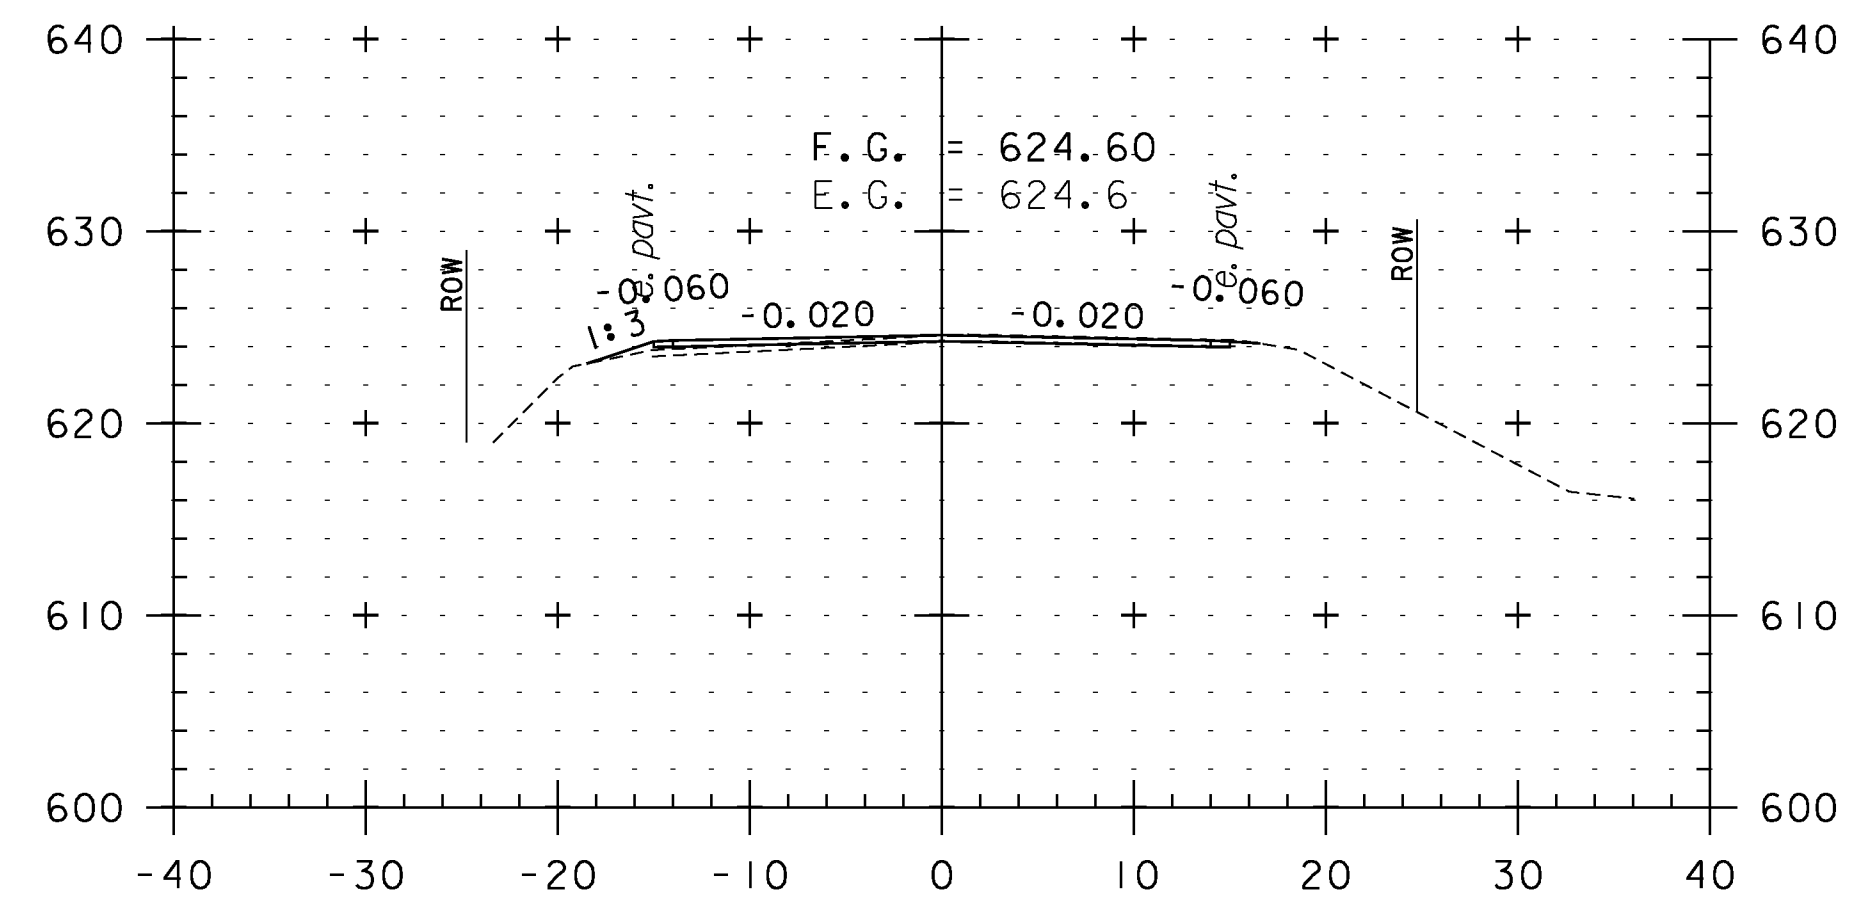


134+50

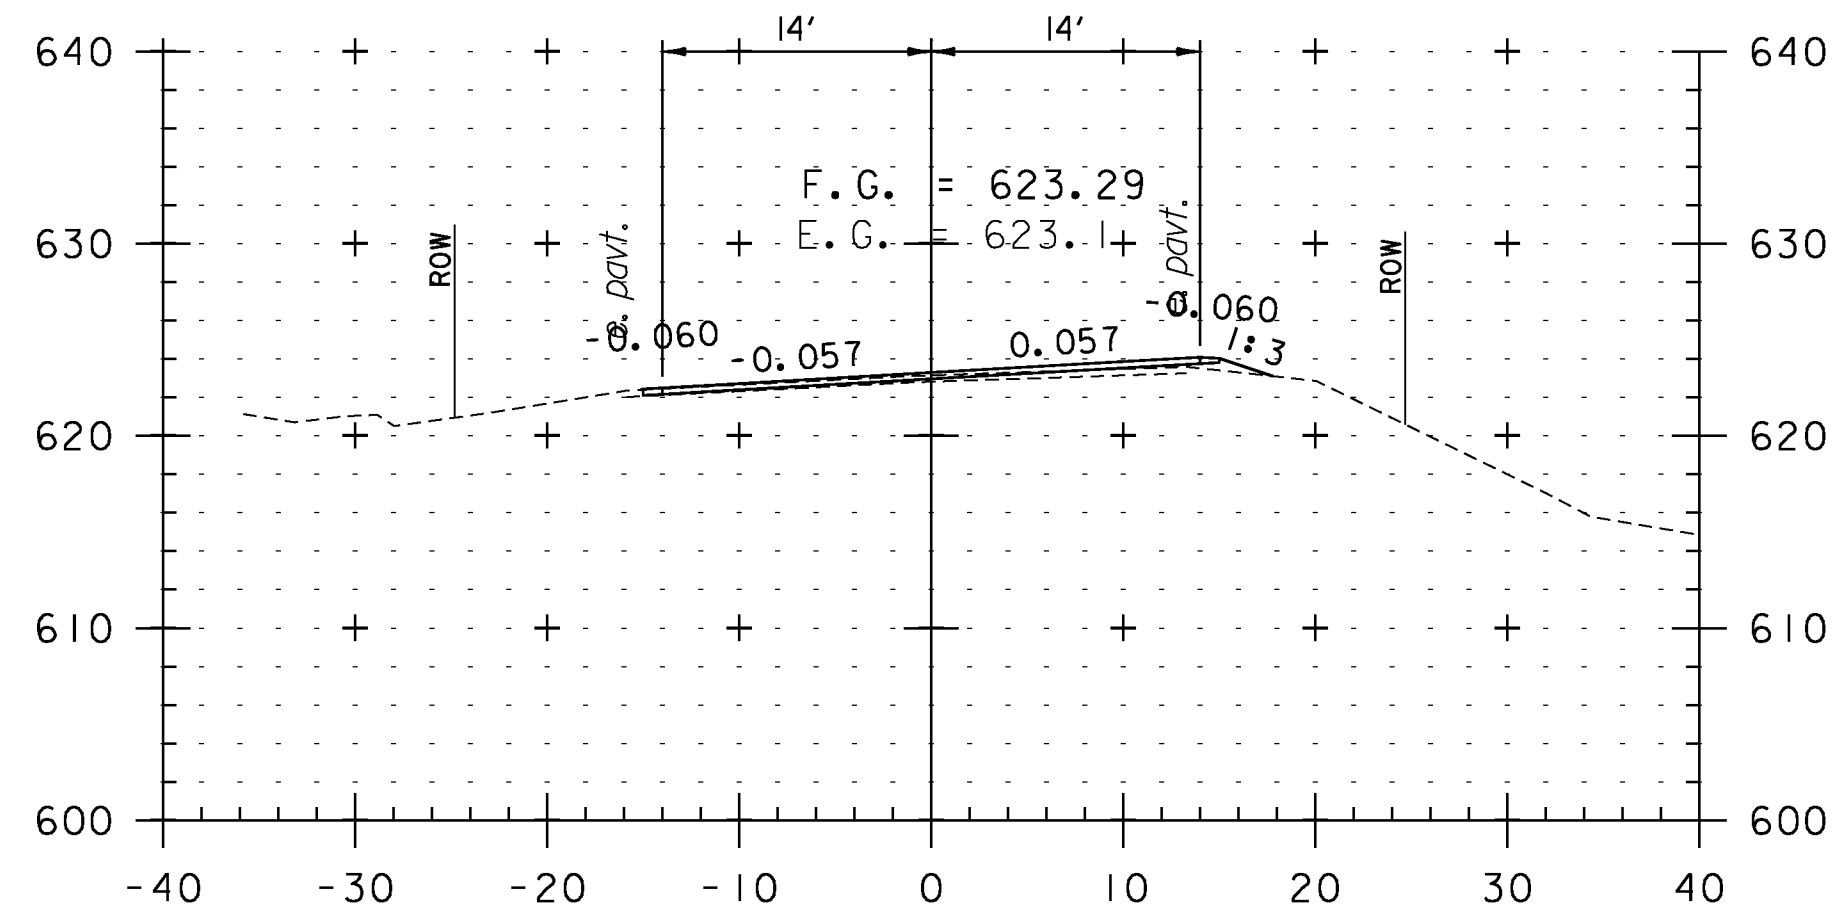

131+00

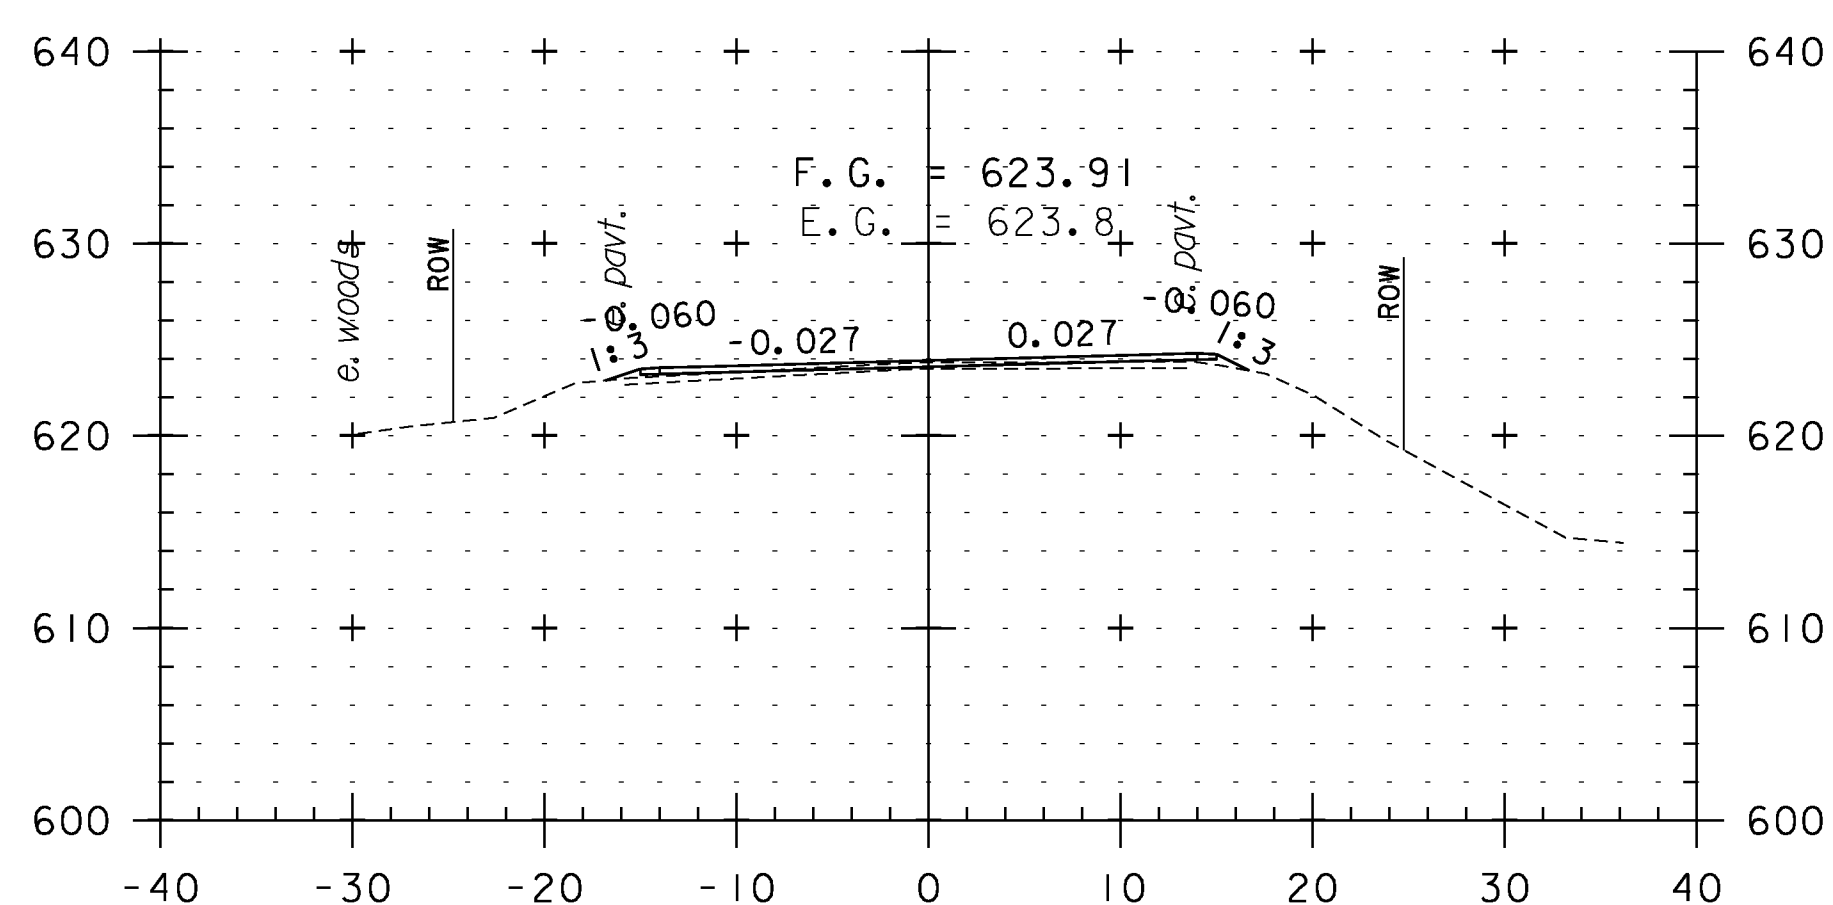

132+50

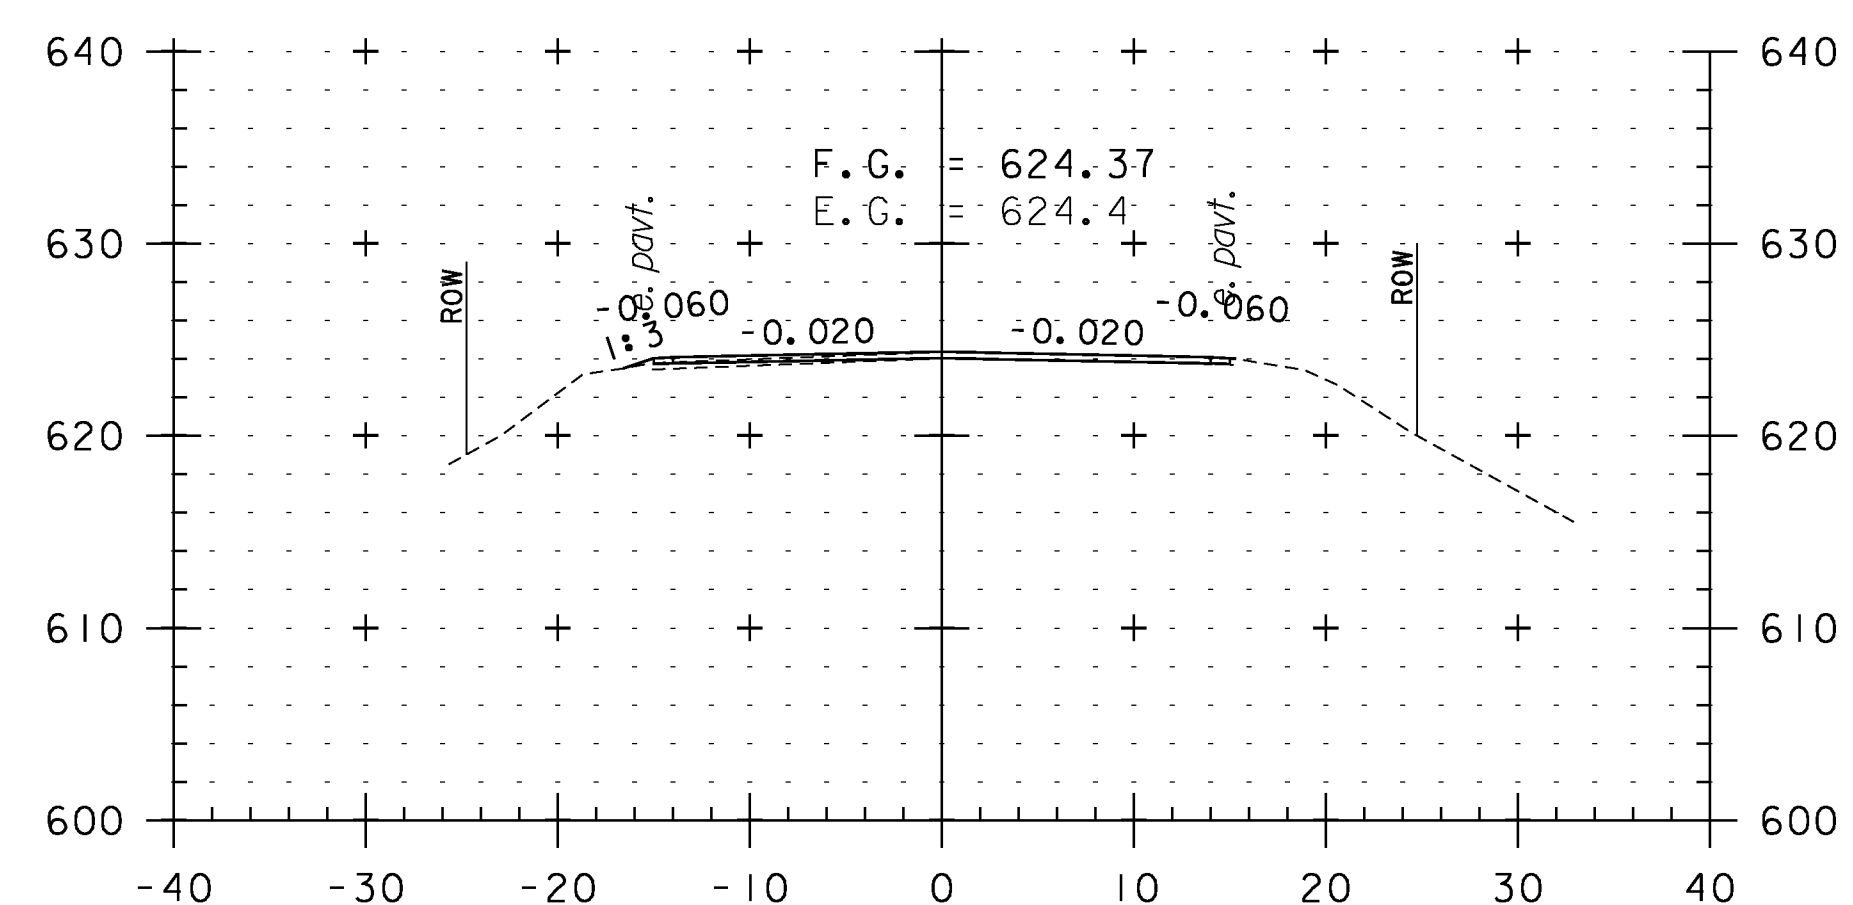

134+00

CROSS SECTION SHEET 16

PROJECT NAME: WEATHERSFIELD

PROJECT NUMBER: STP 2913(I)

FILE NAME: I0c228

PROJECT LEADER: PTS

DESIGNED BY: NLL


IPARM FILE NAME: pI0c228_I06

PLOT DATE: 2/7/2013

DRAWN BY: WWG

CHECKED BY: PTS

SHEET 106 OF 234

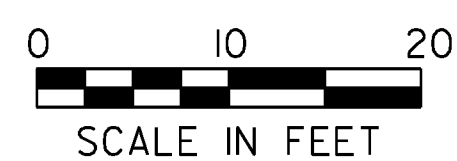

STA. 131+00 TO STA. 135+00