




149+00

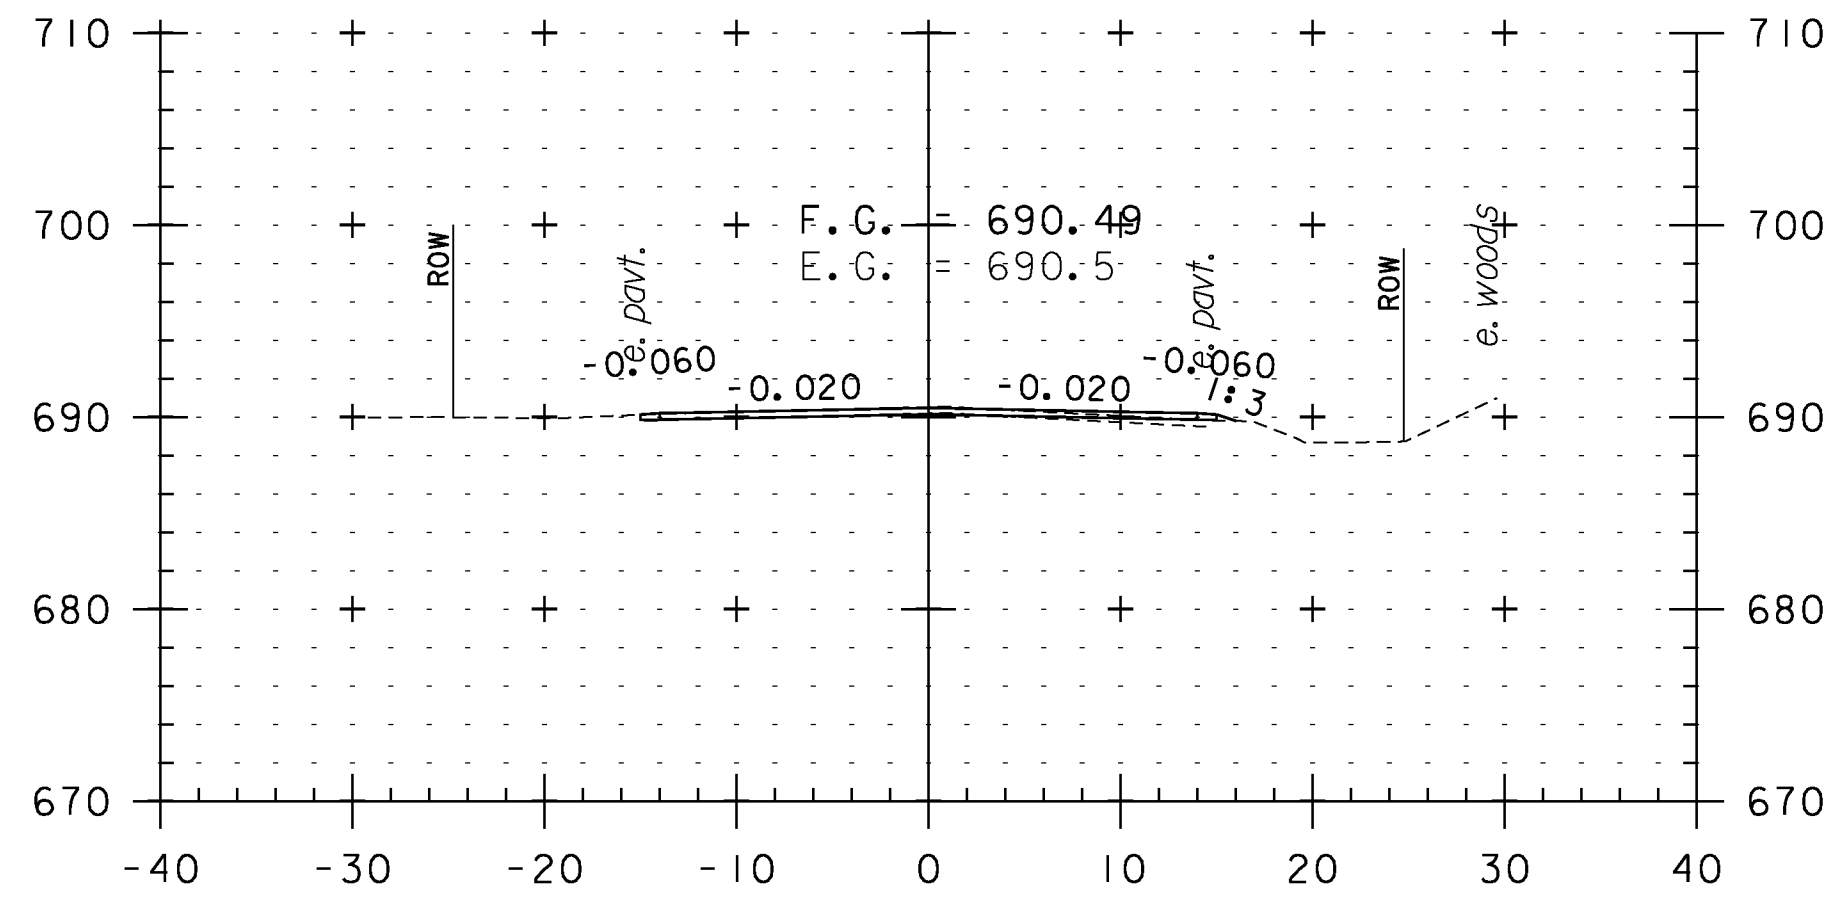


150+50

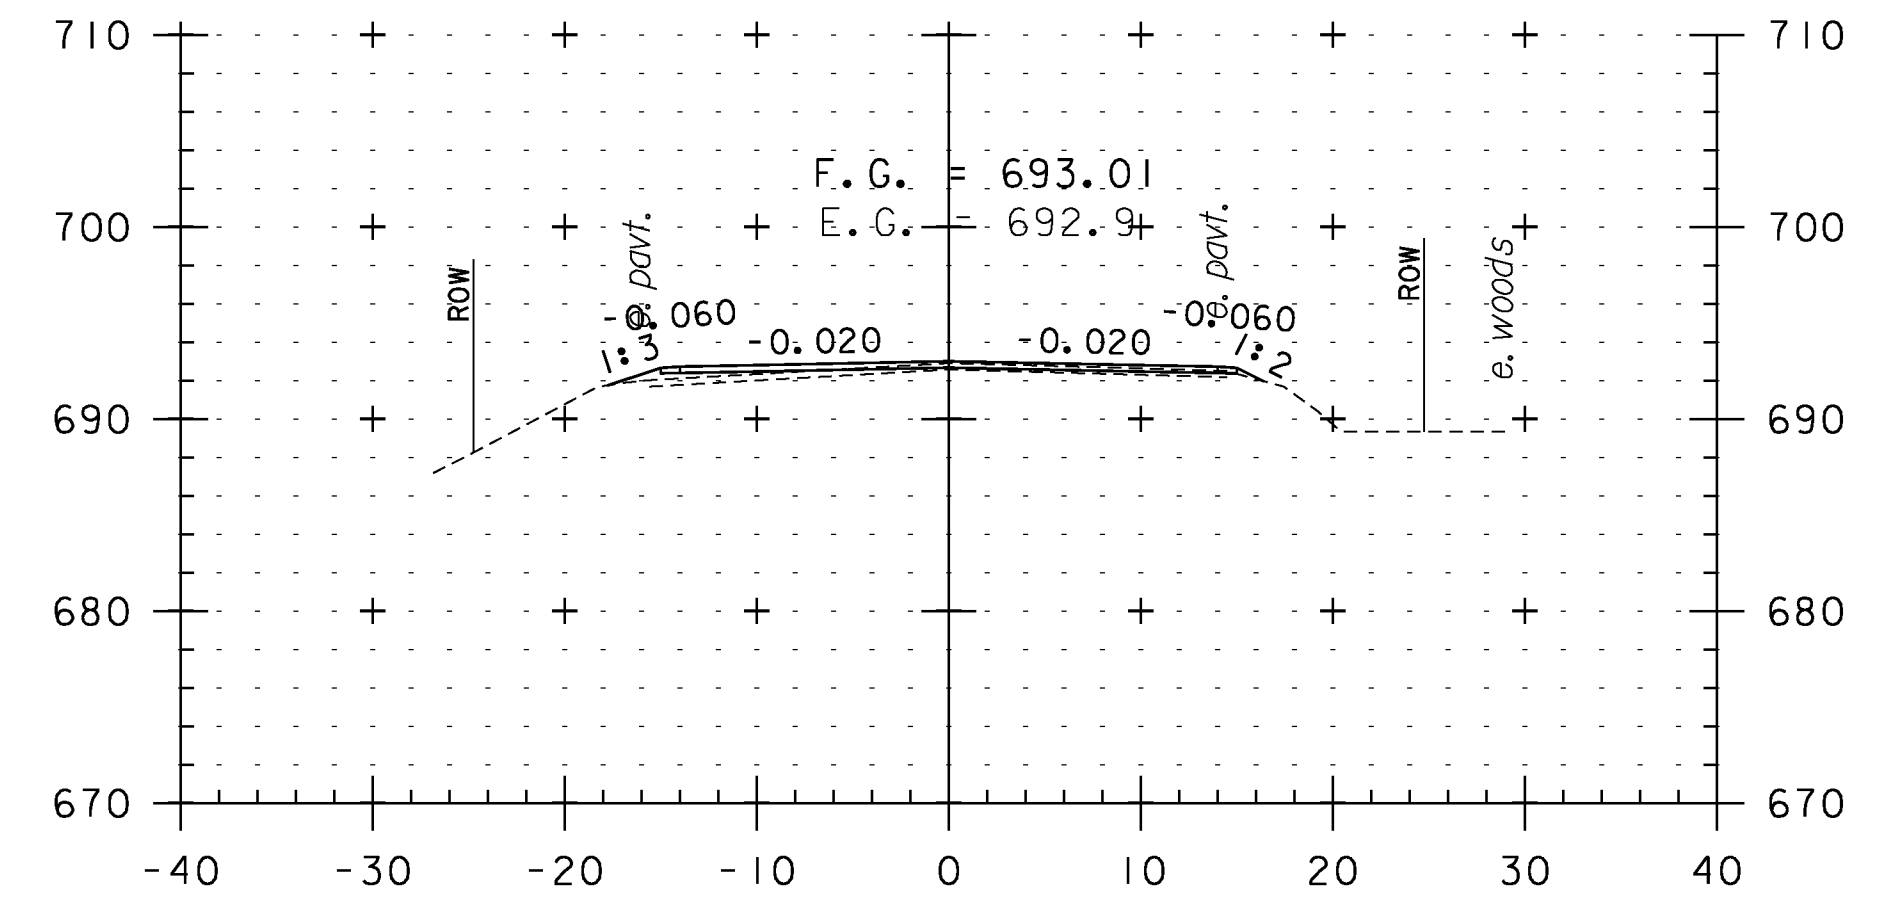


152+00

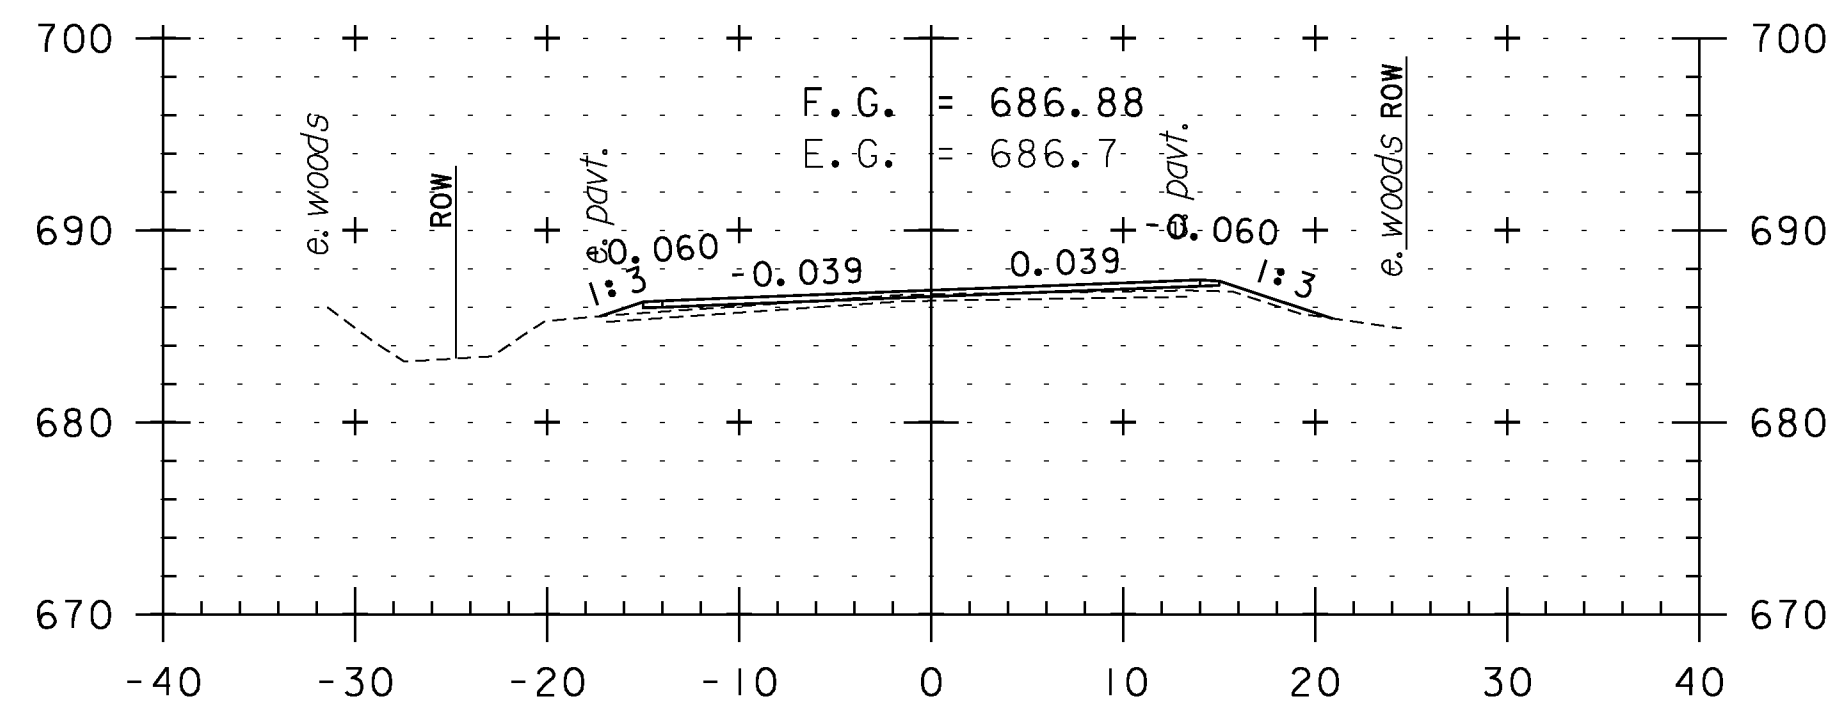


148+50

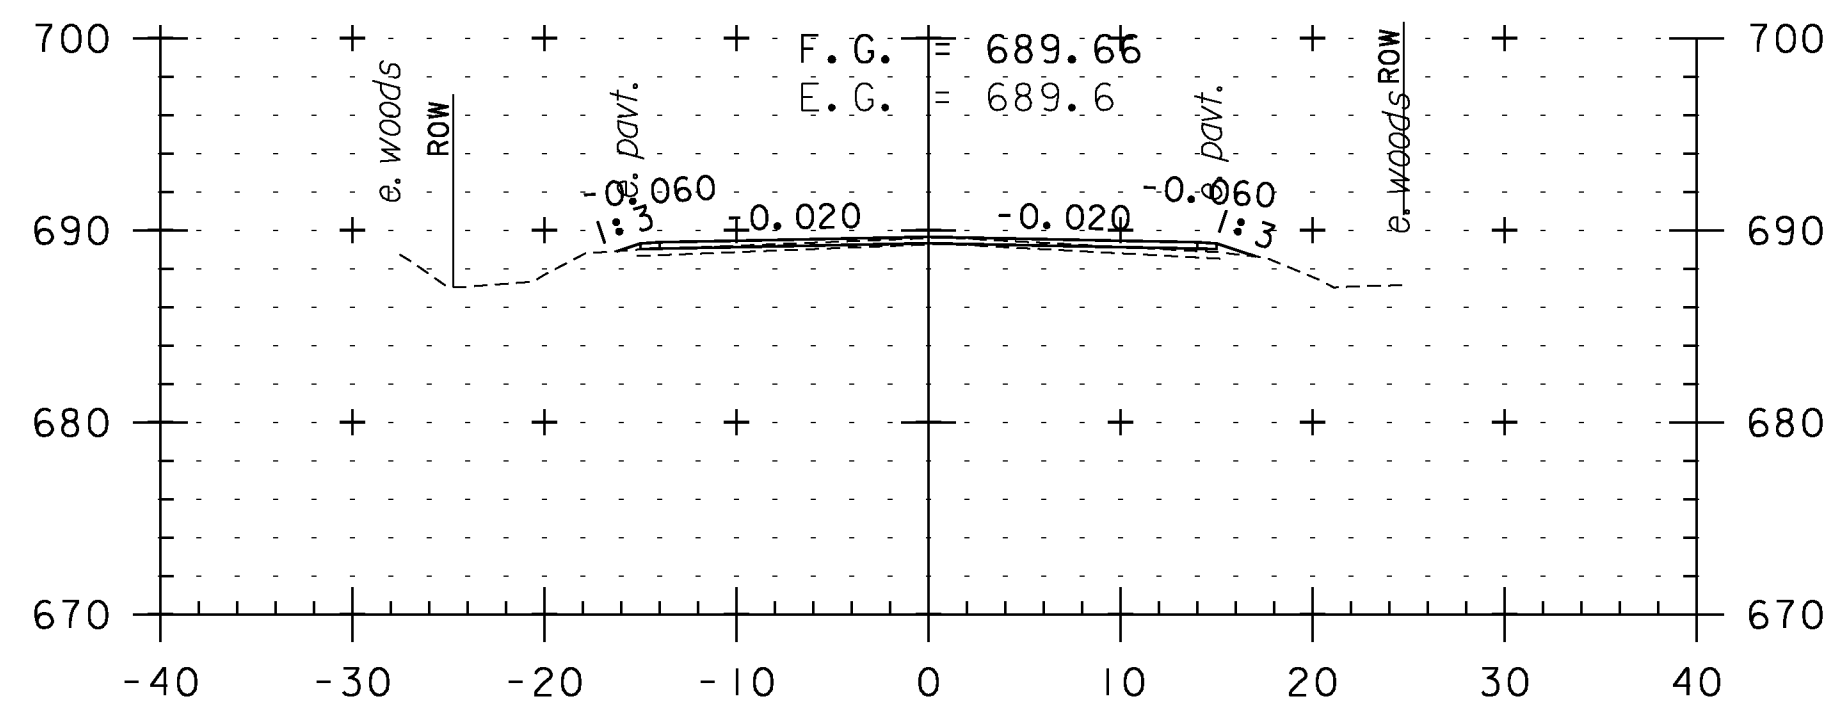


150+00

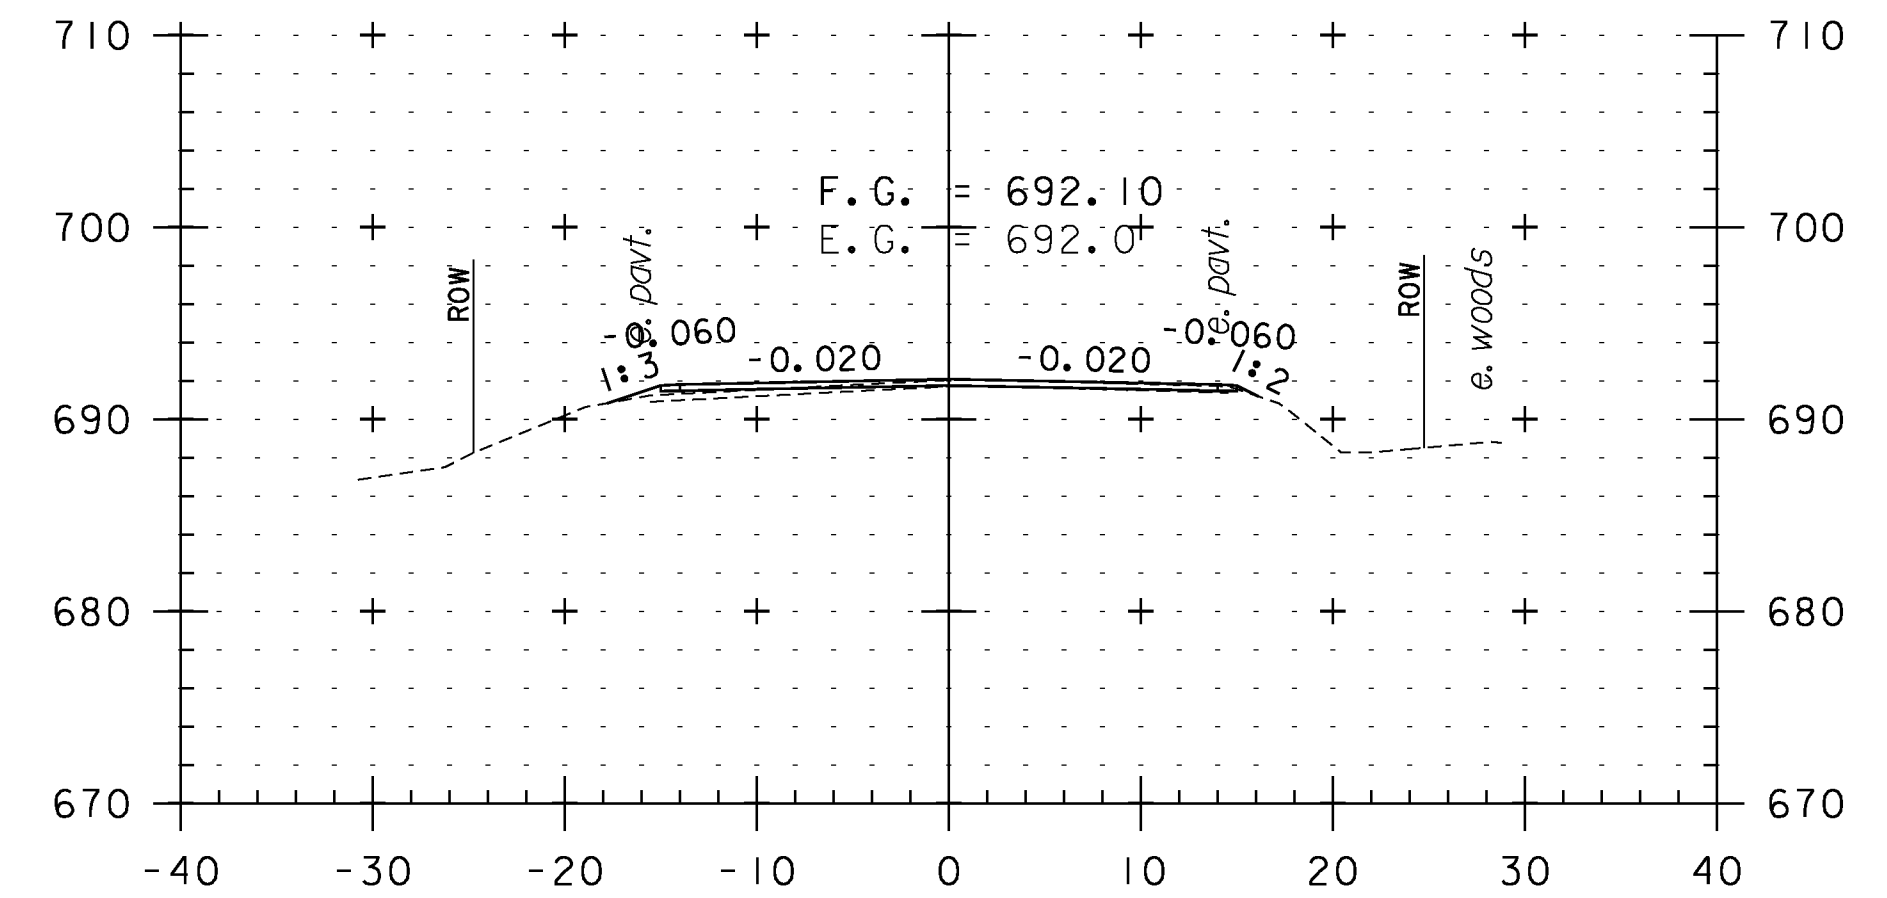


151+50

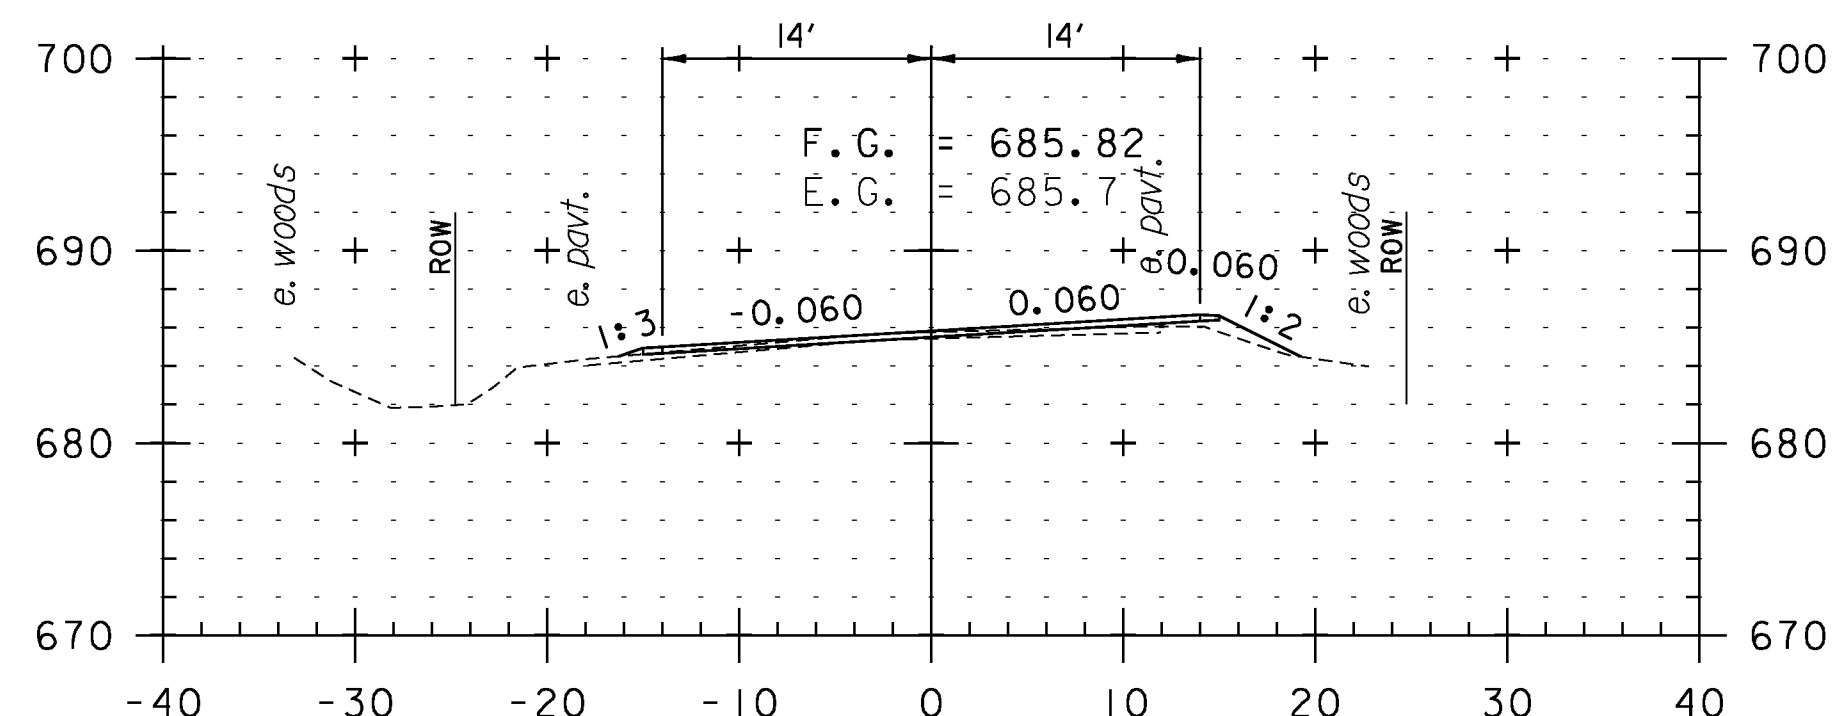

148+00

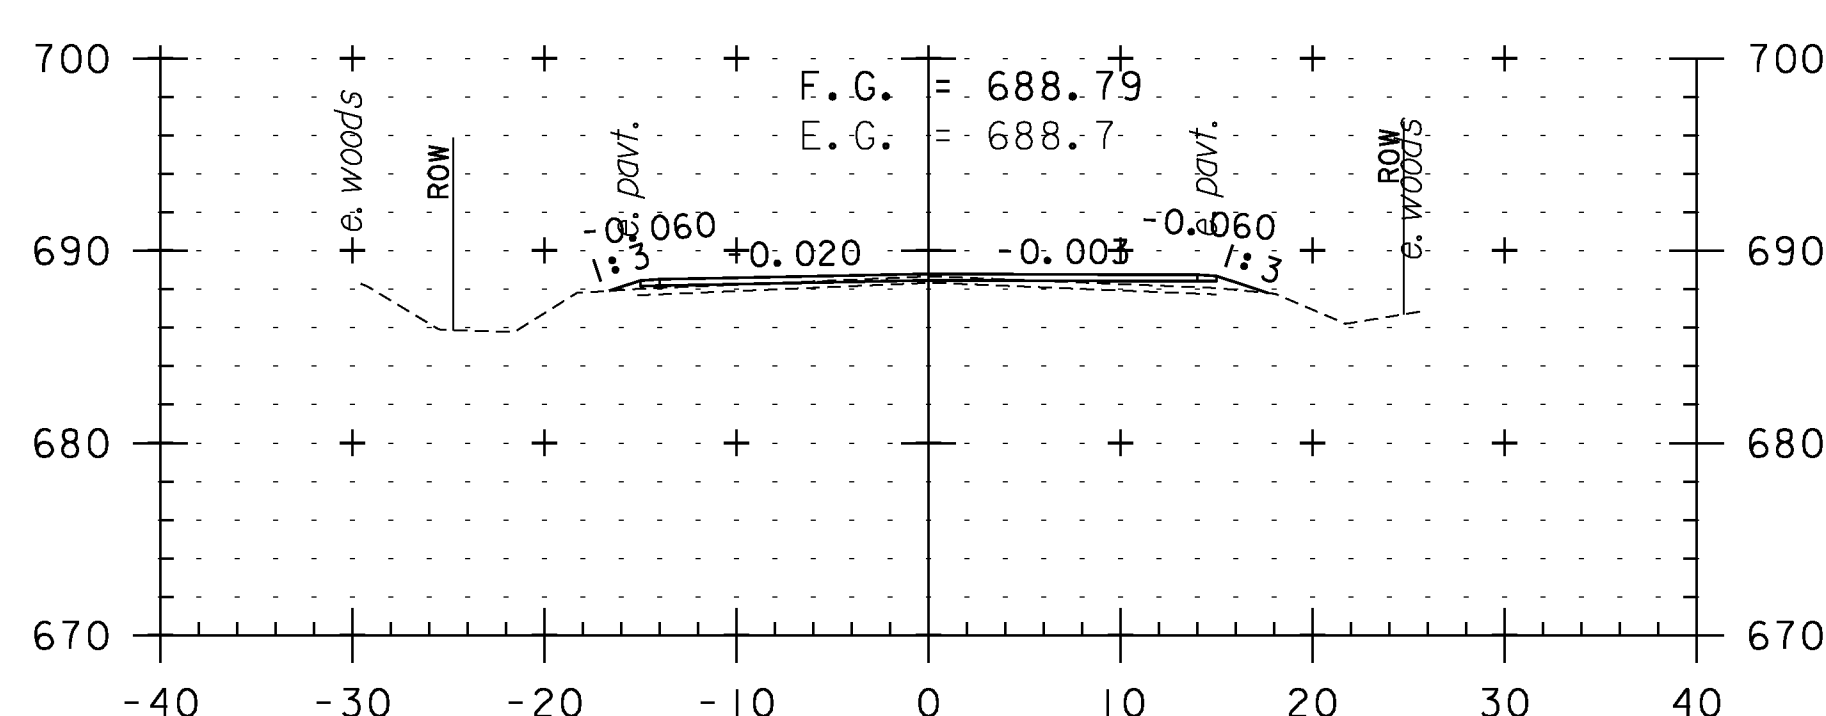

149+50

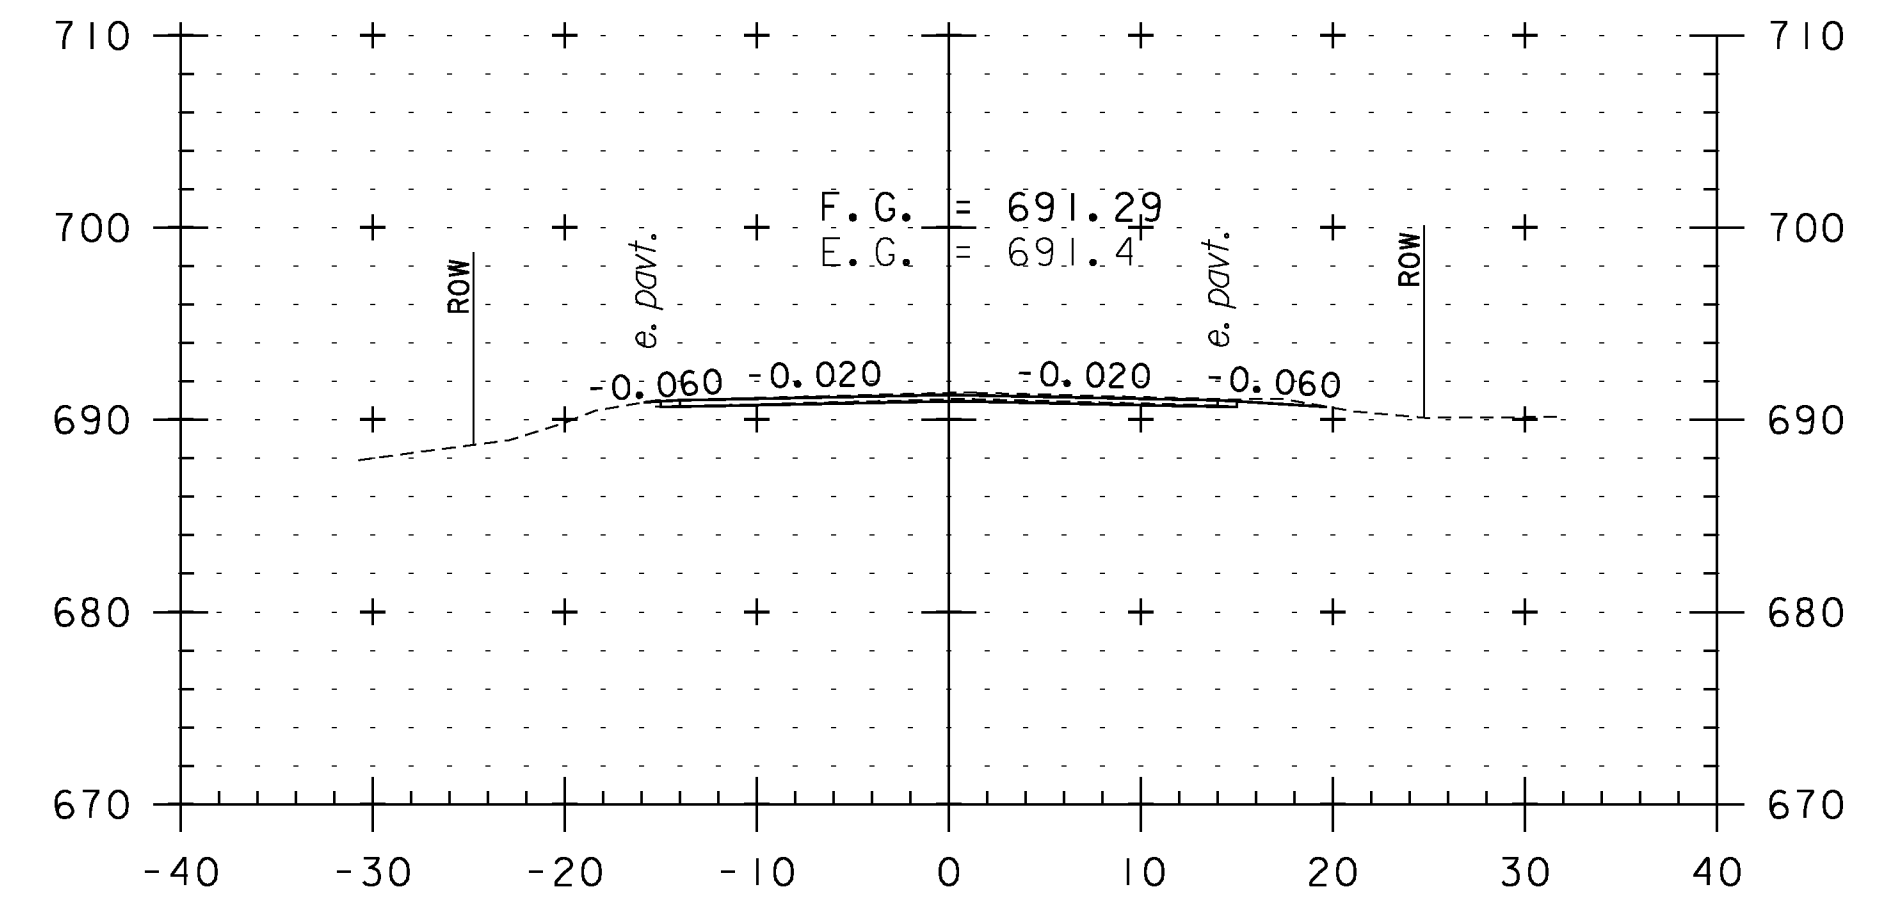

151+00

CROSS SECTION SHEET 20

PROJECT NAME: WEATHERSFIELD

PROJECT NUMBER: STP 2913(I)

FILE NAME: I0c228

PROJECT LEADER: PTS

DESIGNED BY: NLL


IPARM FILE NAME: pI0C228.I10

PLOT DATE: 2/7/2013

DRAWN BY: WWG

CHECKED BY: PTS

SHEET 110 OF 234

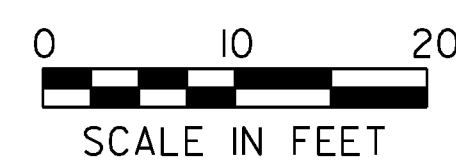

STA. 148+00 TO STA. 152+00