




167+00

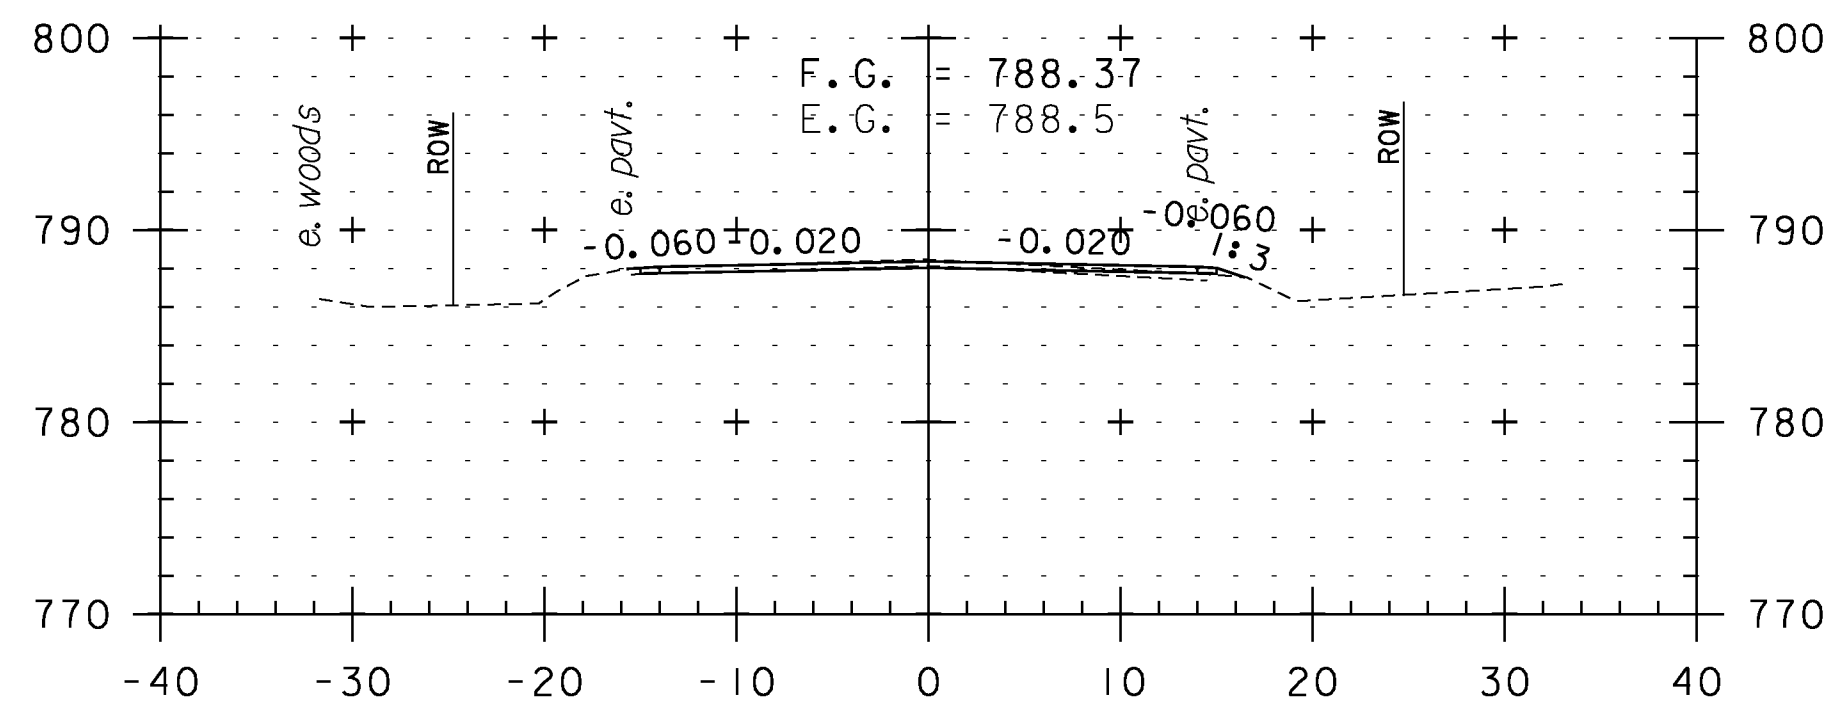


168+50

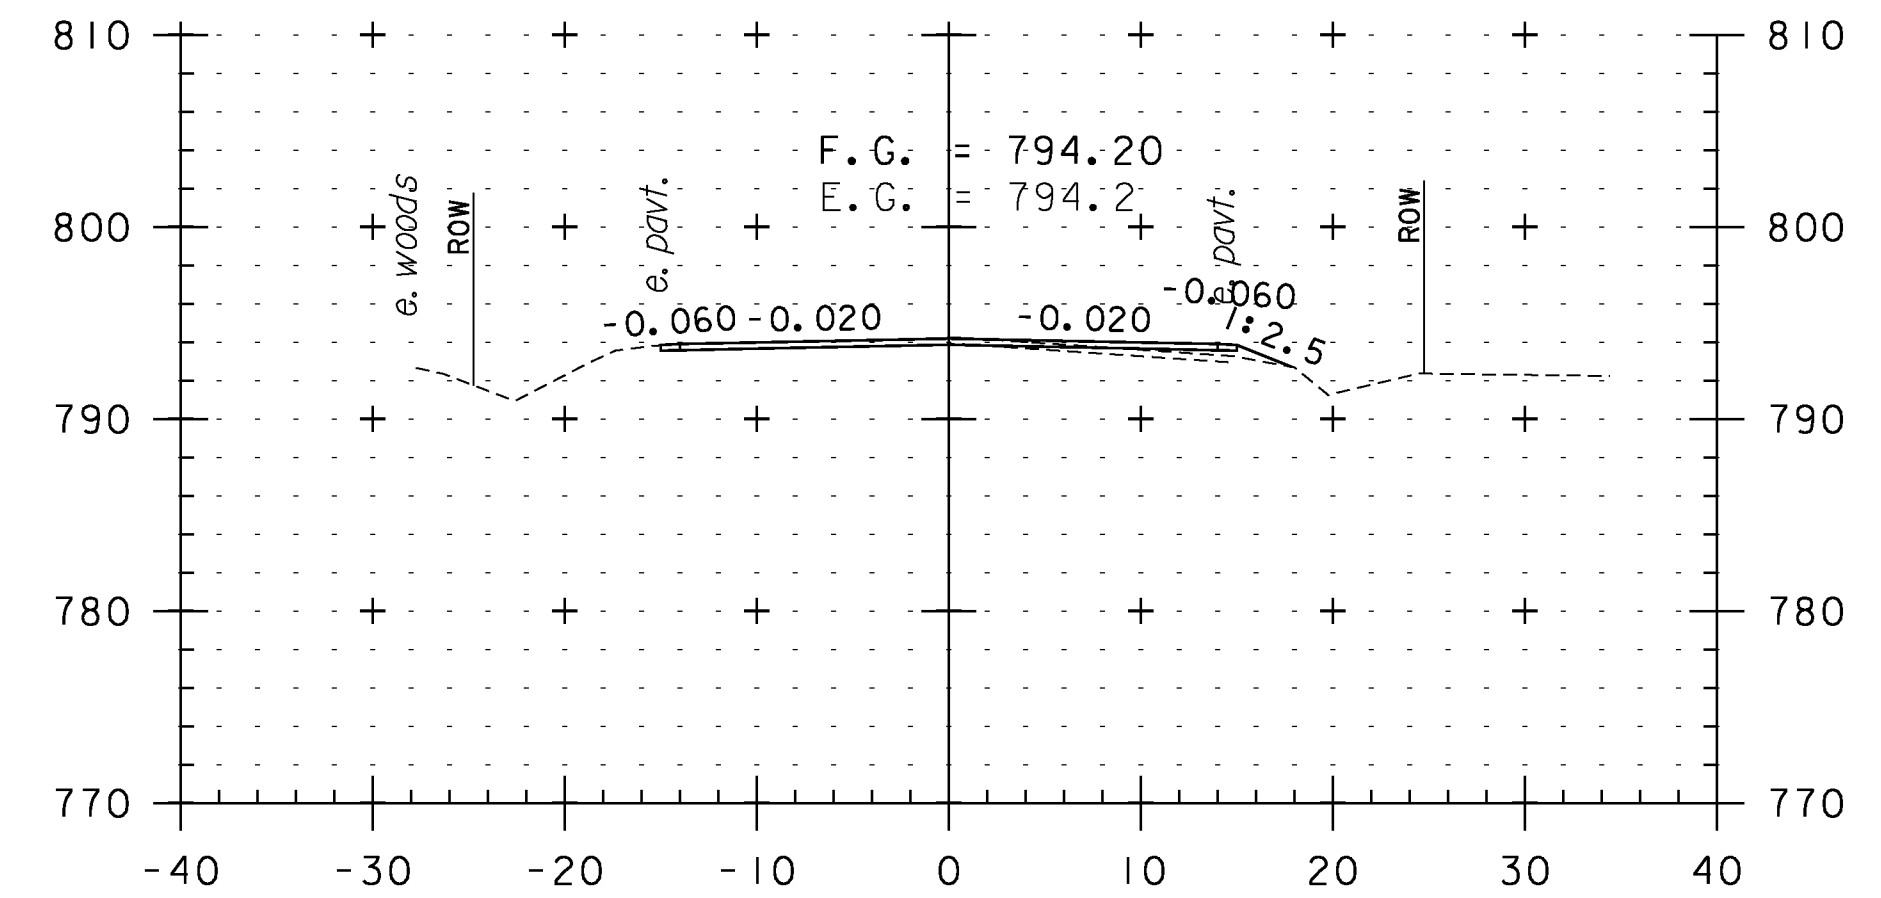


170+00

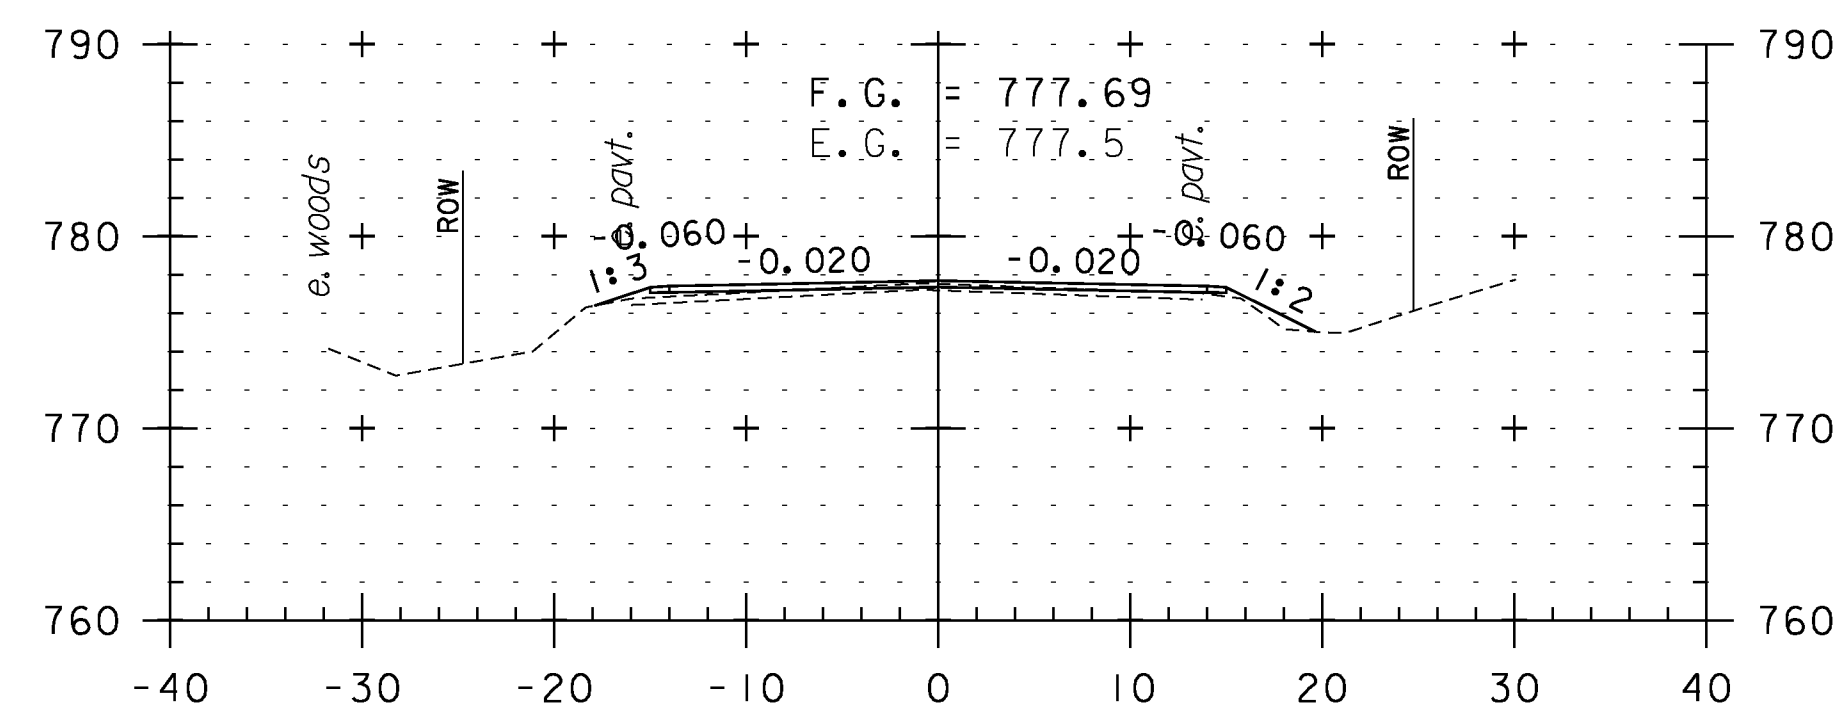


166+50

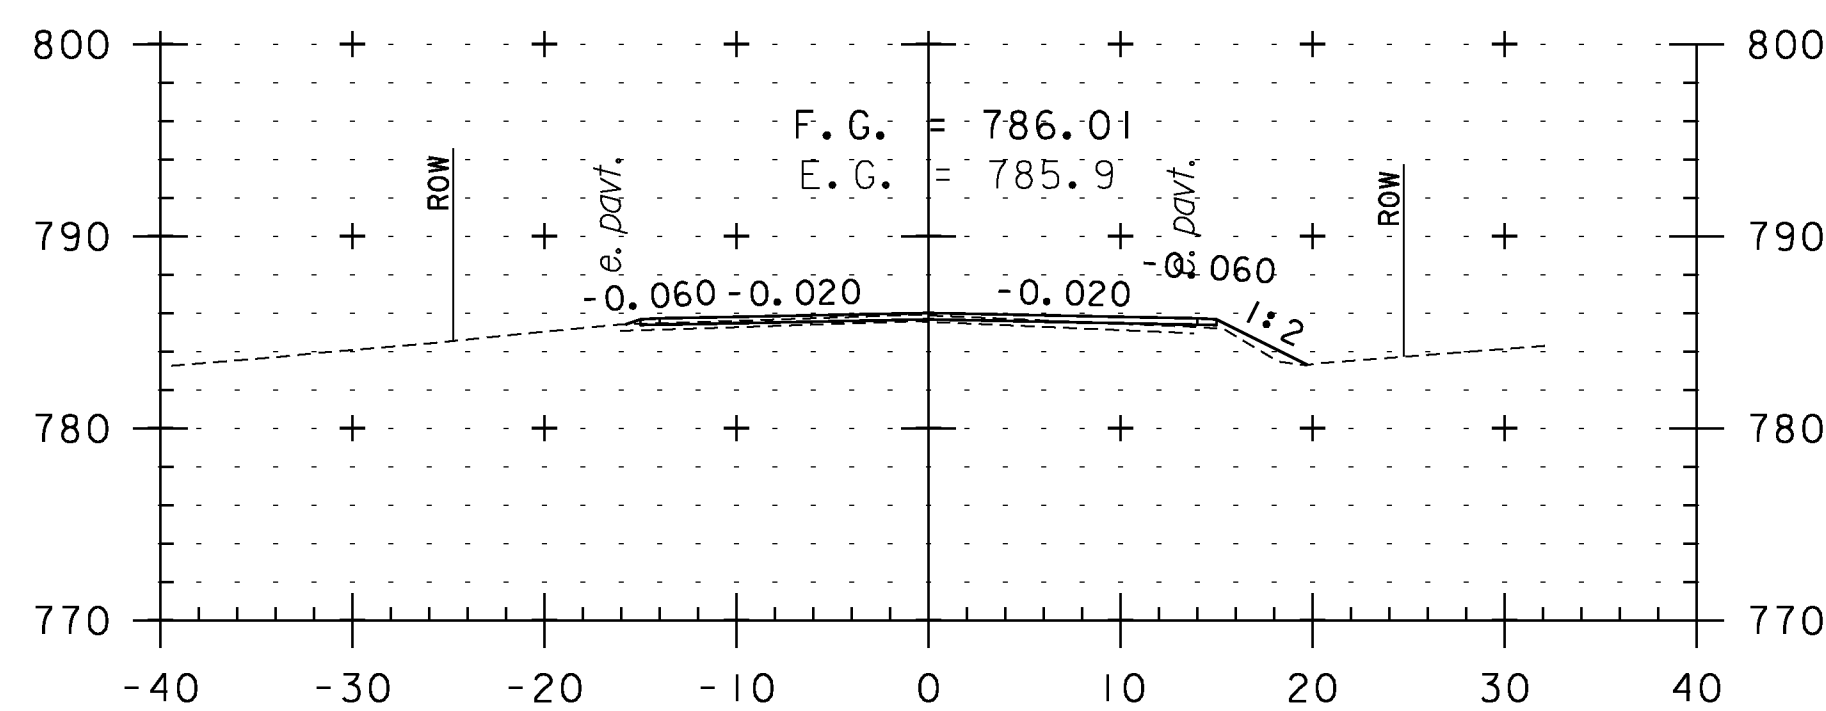


168+00

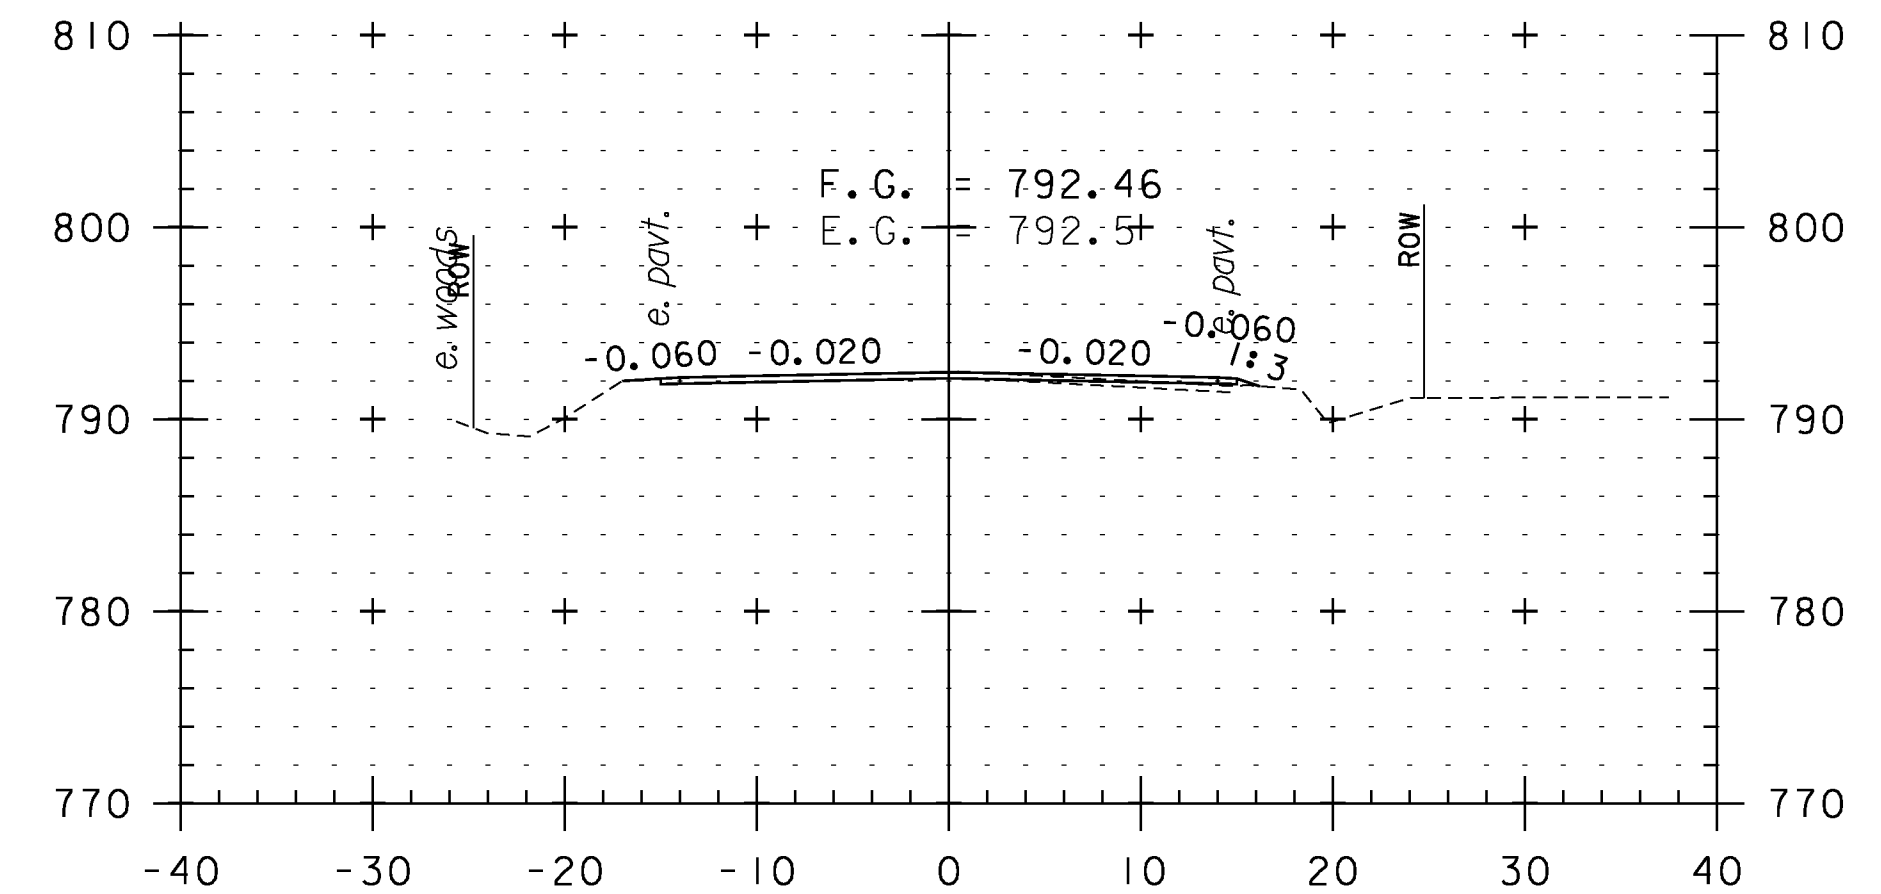


169+50

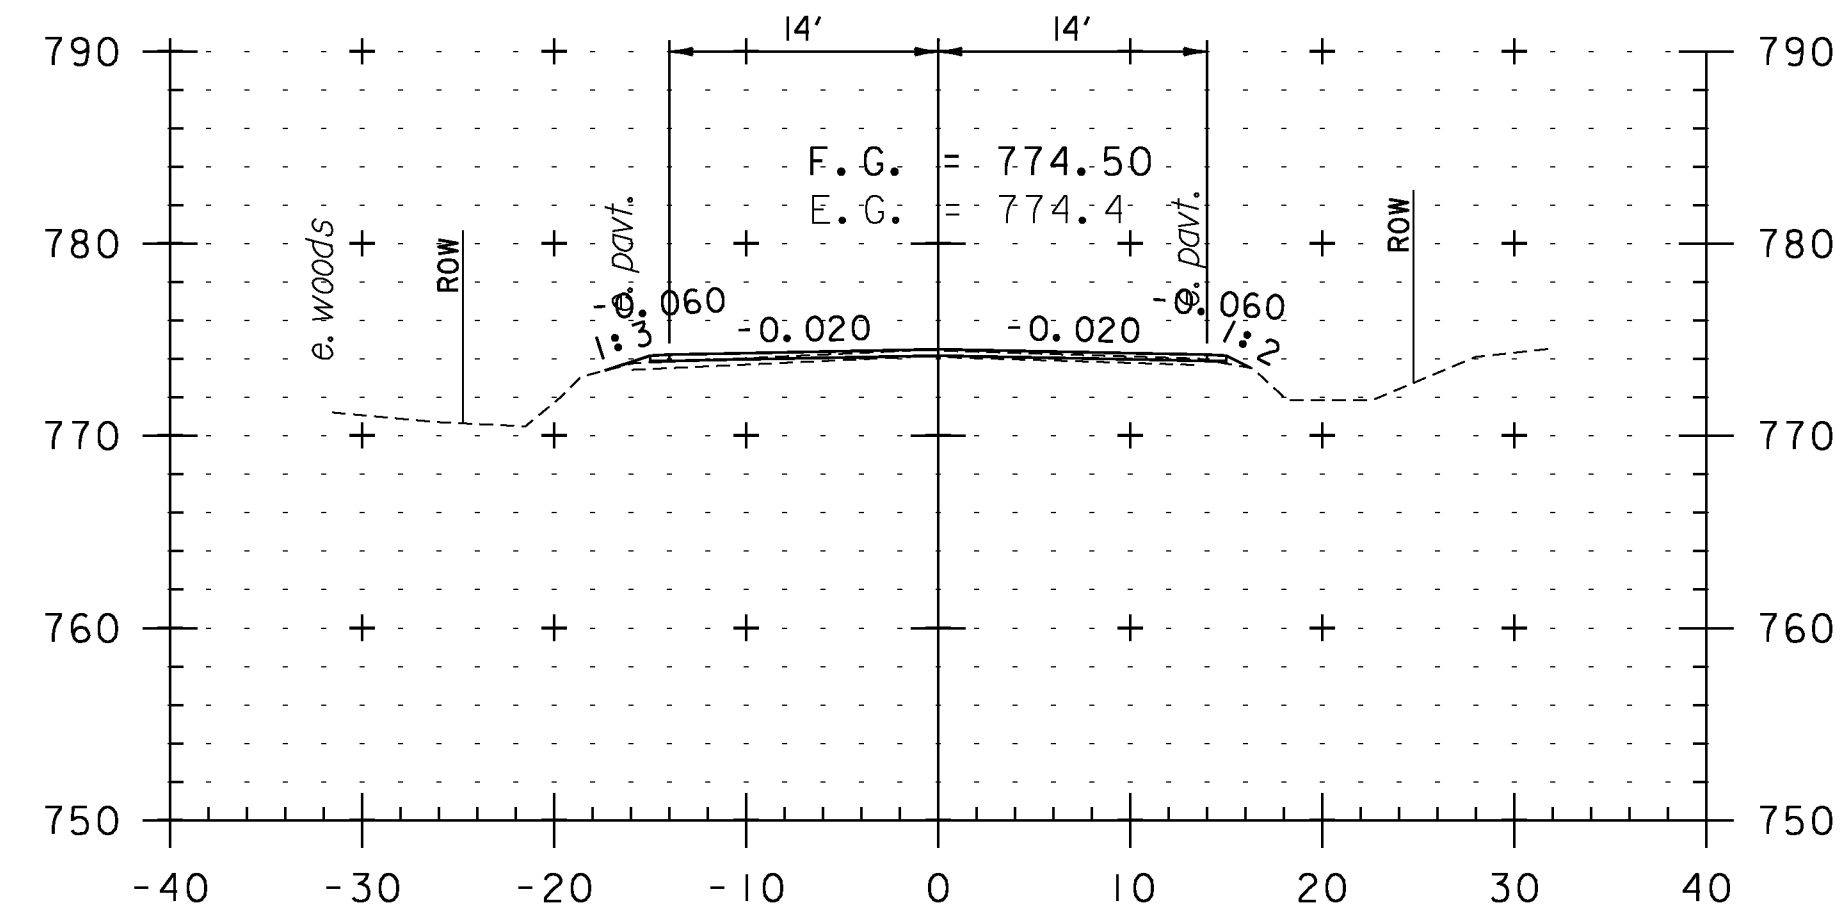

166+00

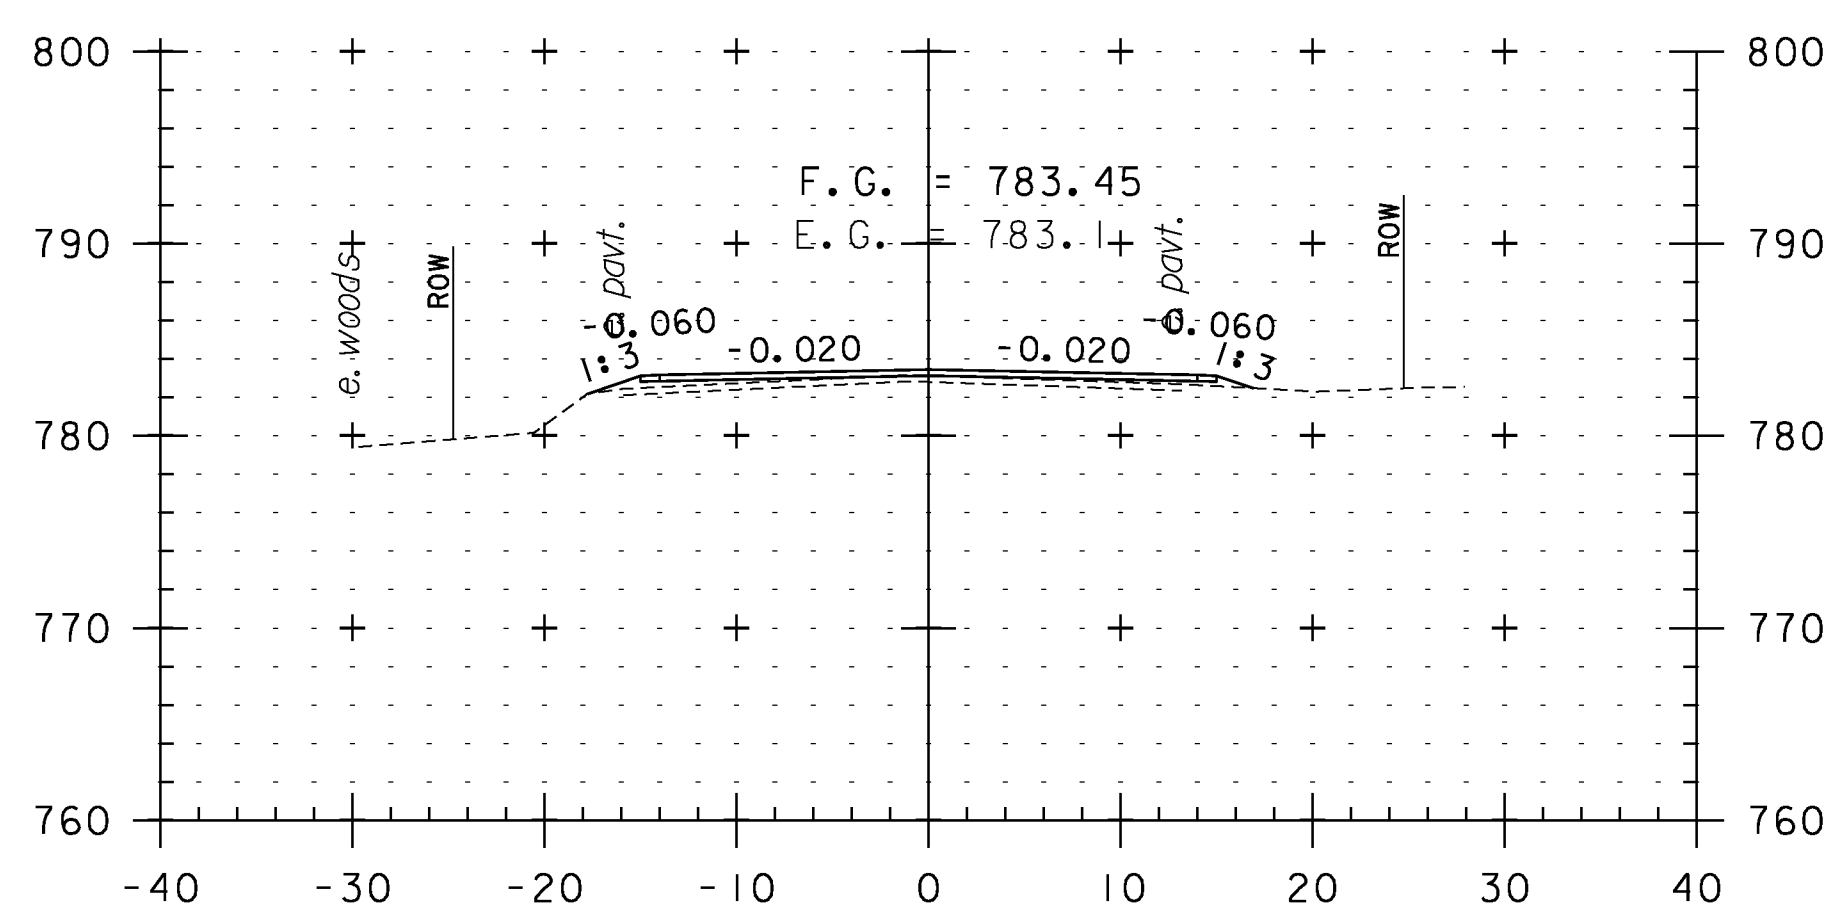

167+50

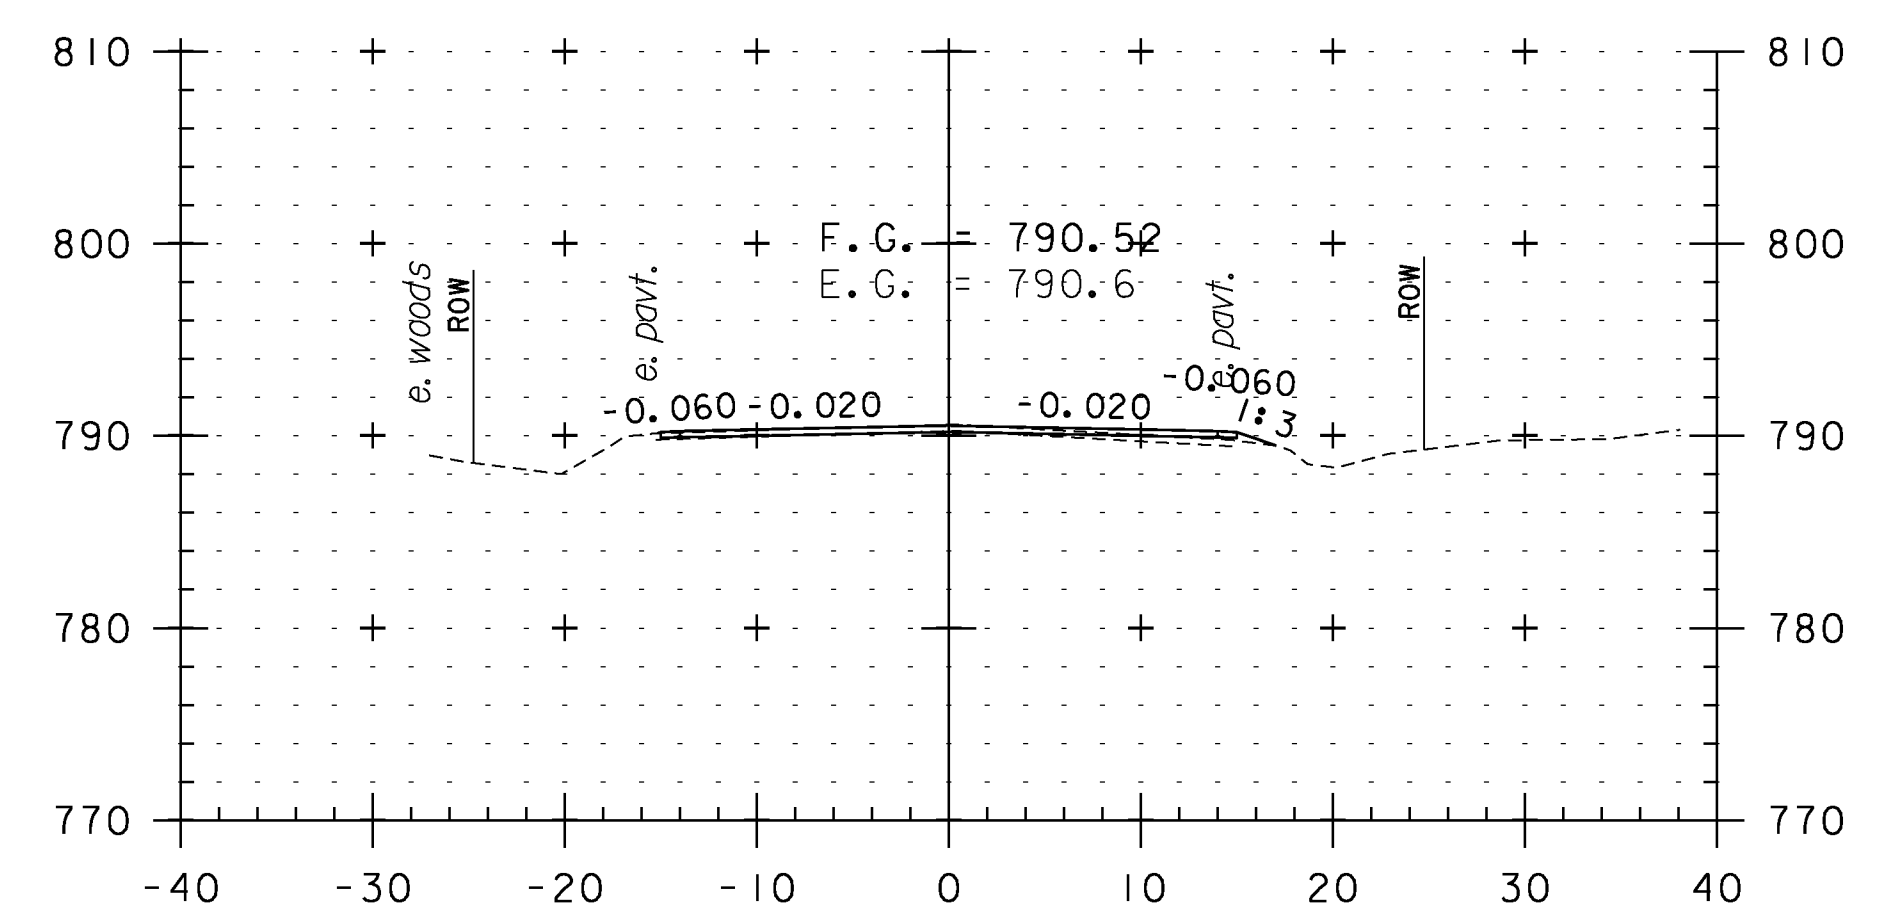

169+00

CROSS SECTION SHEET 24

PROJECT NAME: WEATHERSFIELD

PROJECT NUMBER: STP 2913(I)

FILE NAME: I0c228

PROJECT LEADER: PTS

DESIGNED BY: NLL


IPARM FILE NAME: pI0C228_I14

PLOT DATE: 2/7/2013

DRAWN BY: WWG

CHECKED BY: PTS

SHEET I14 OF 234

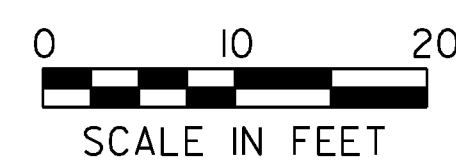

STA. 166+00 TO STA. 170+00