




184+50

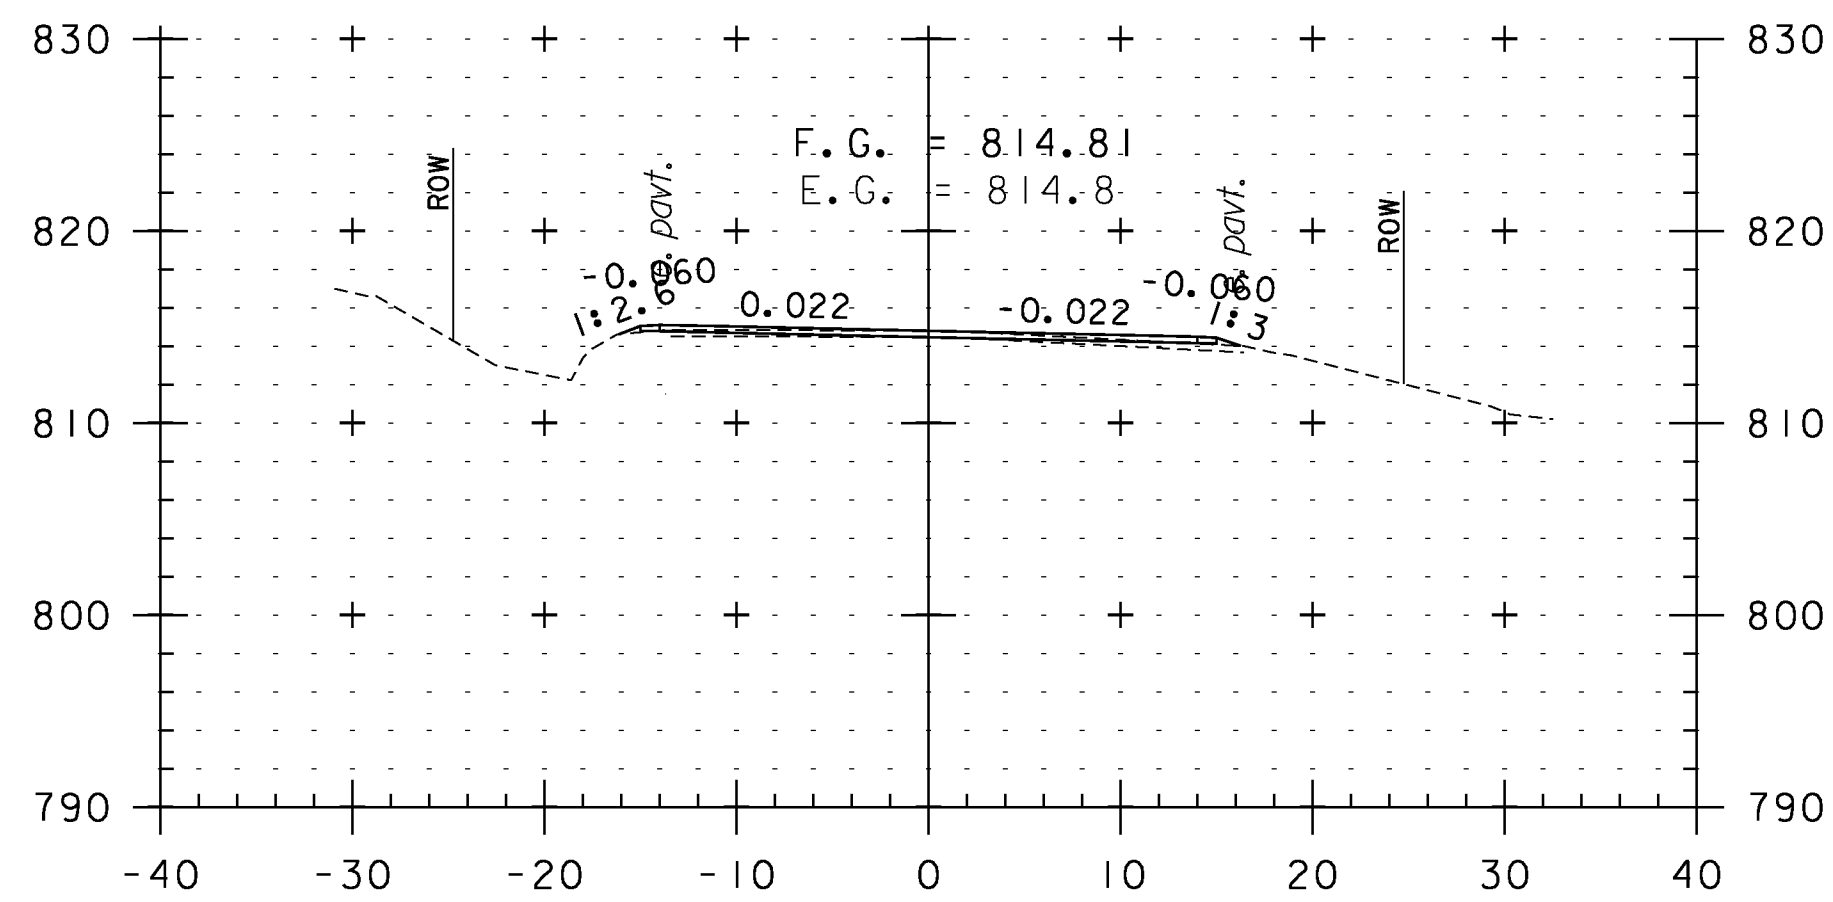


185+50

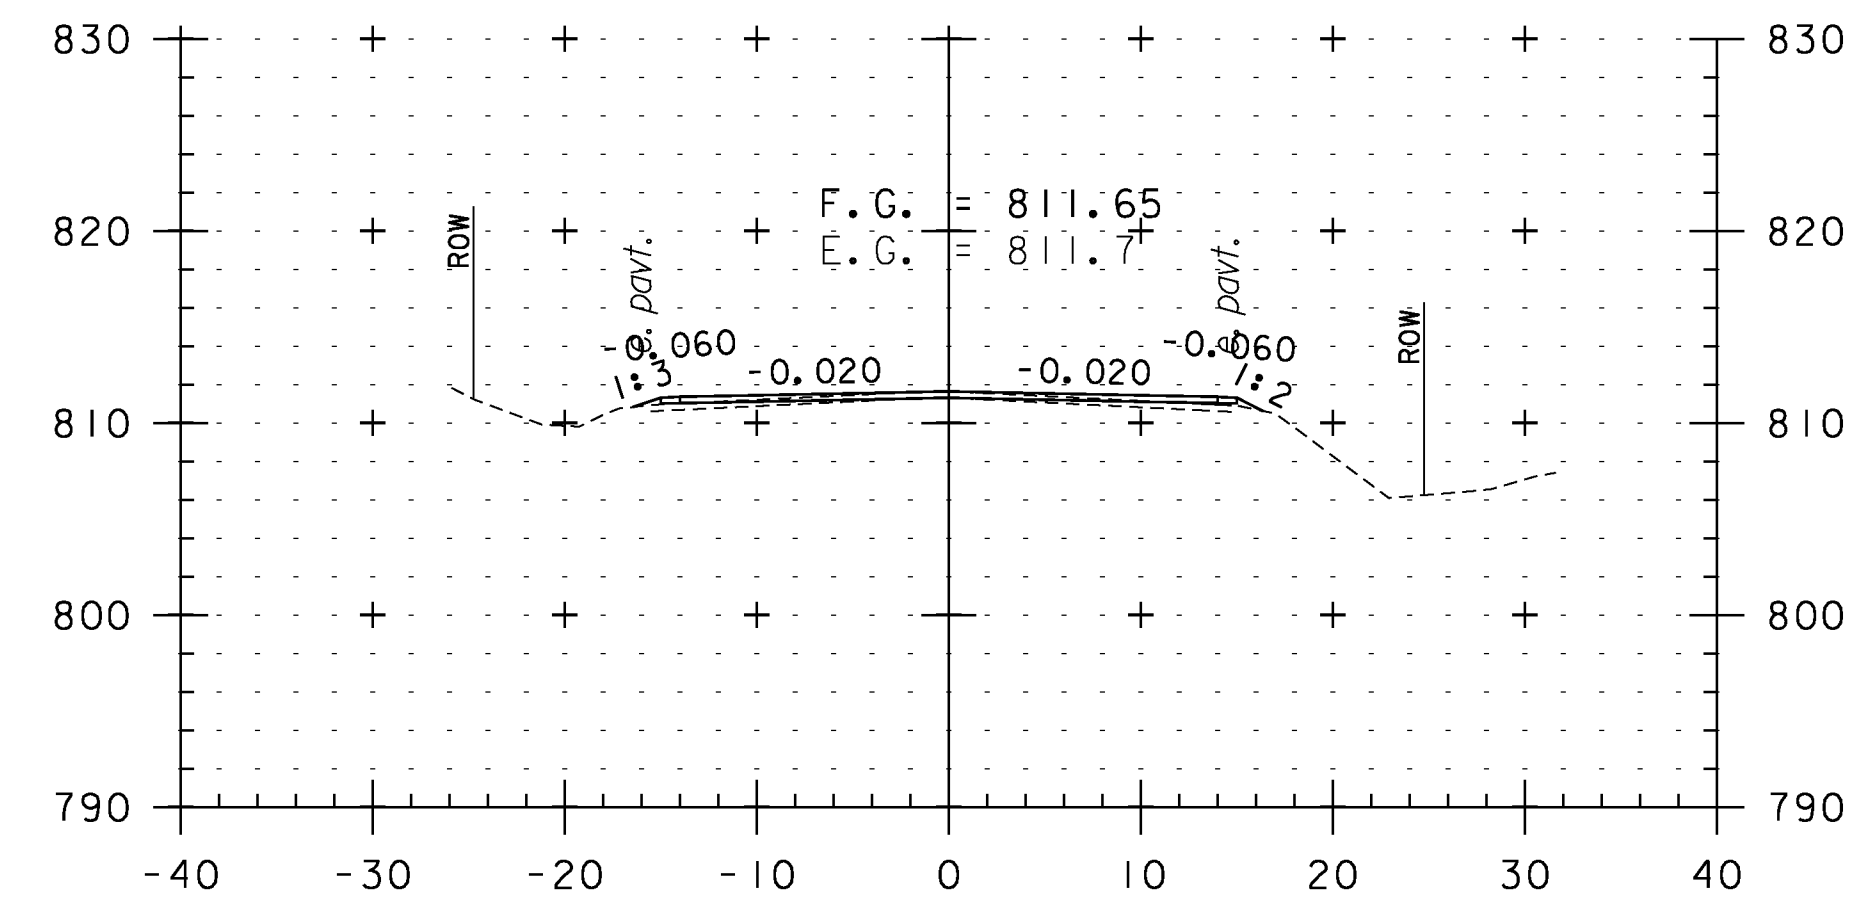


187+00

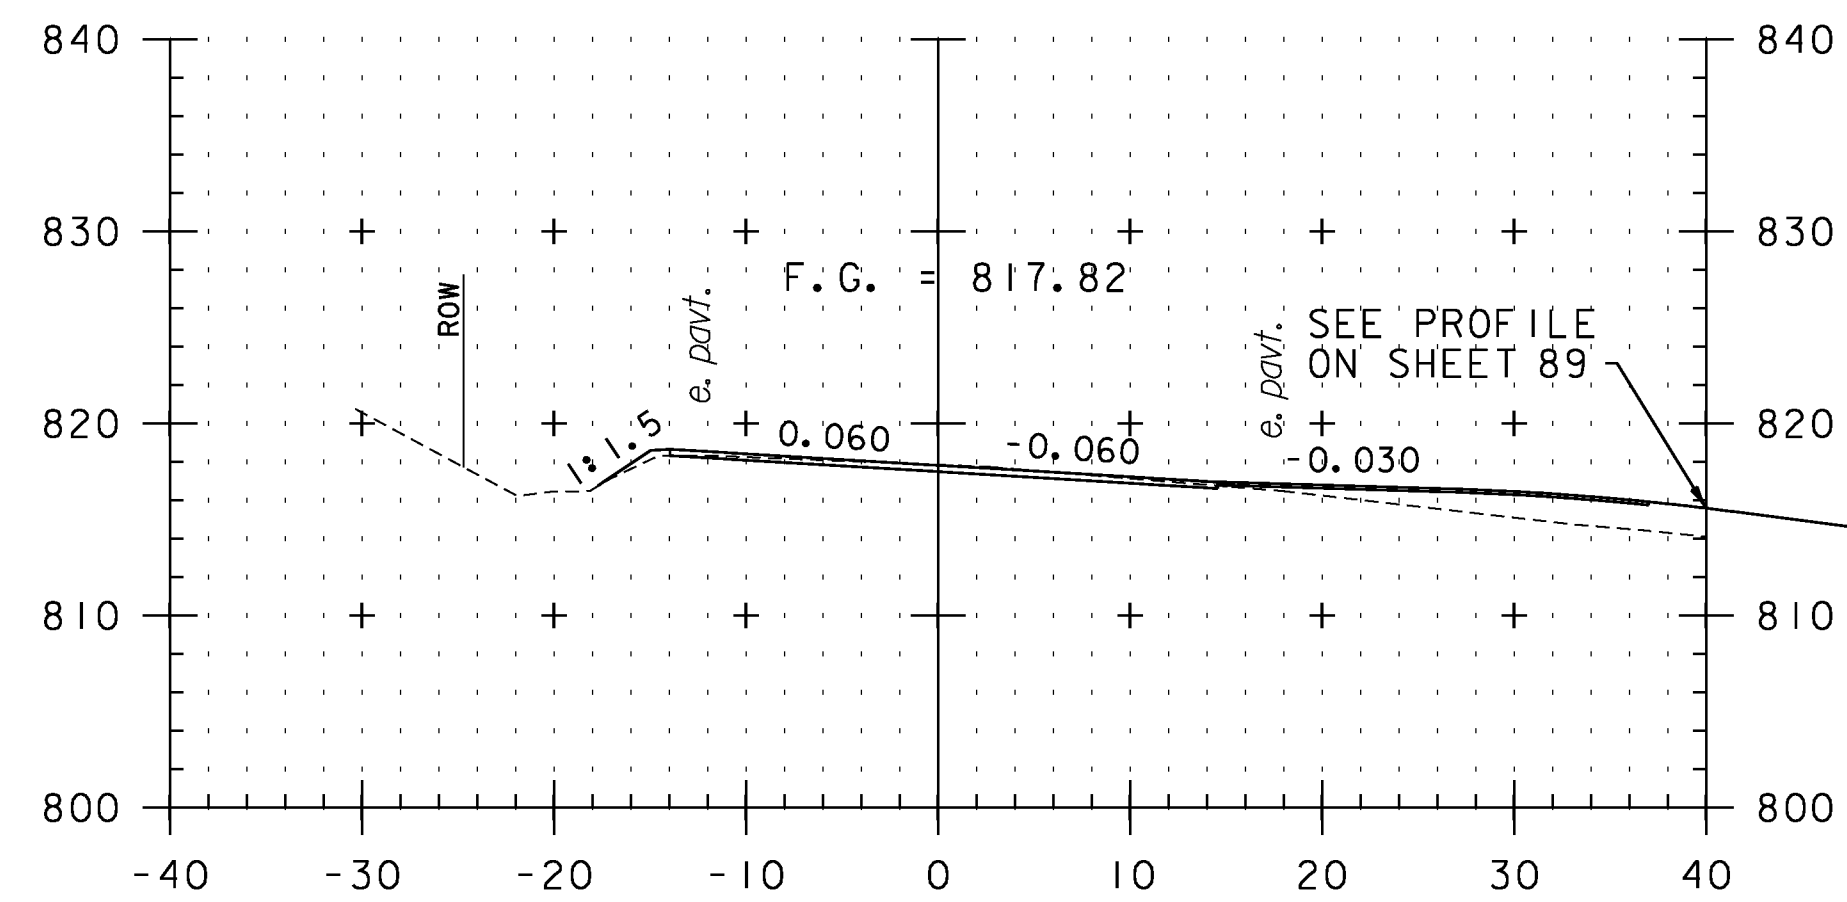


184+02
TH 4

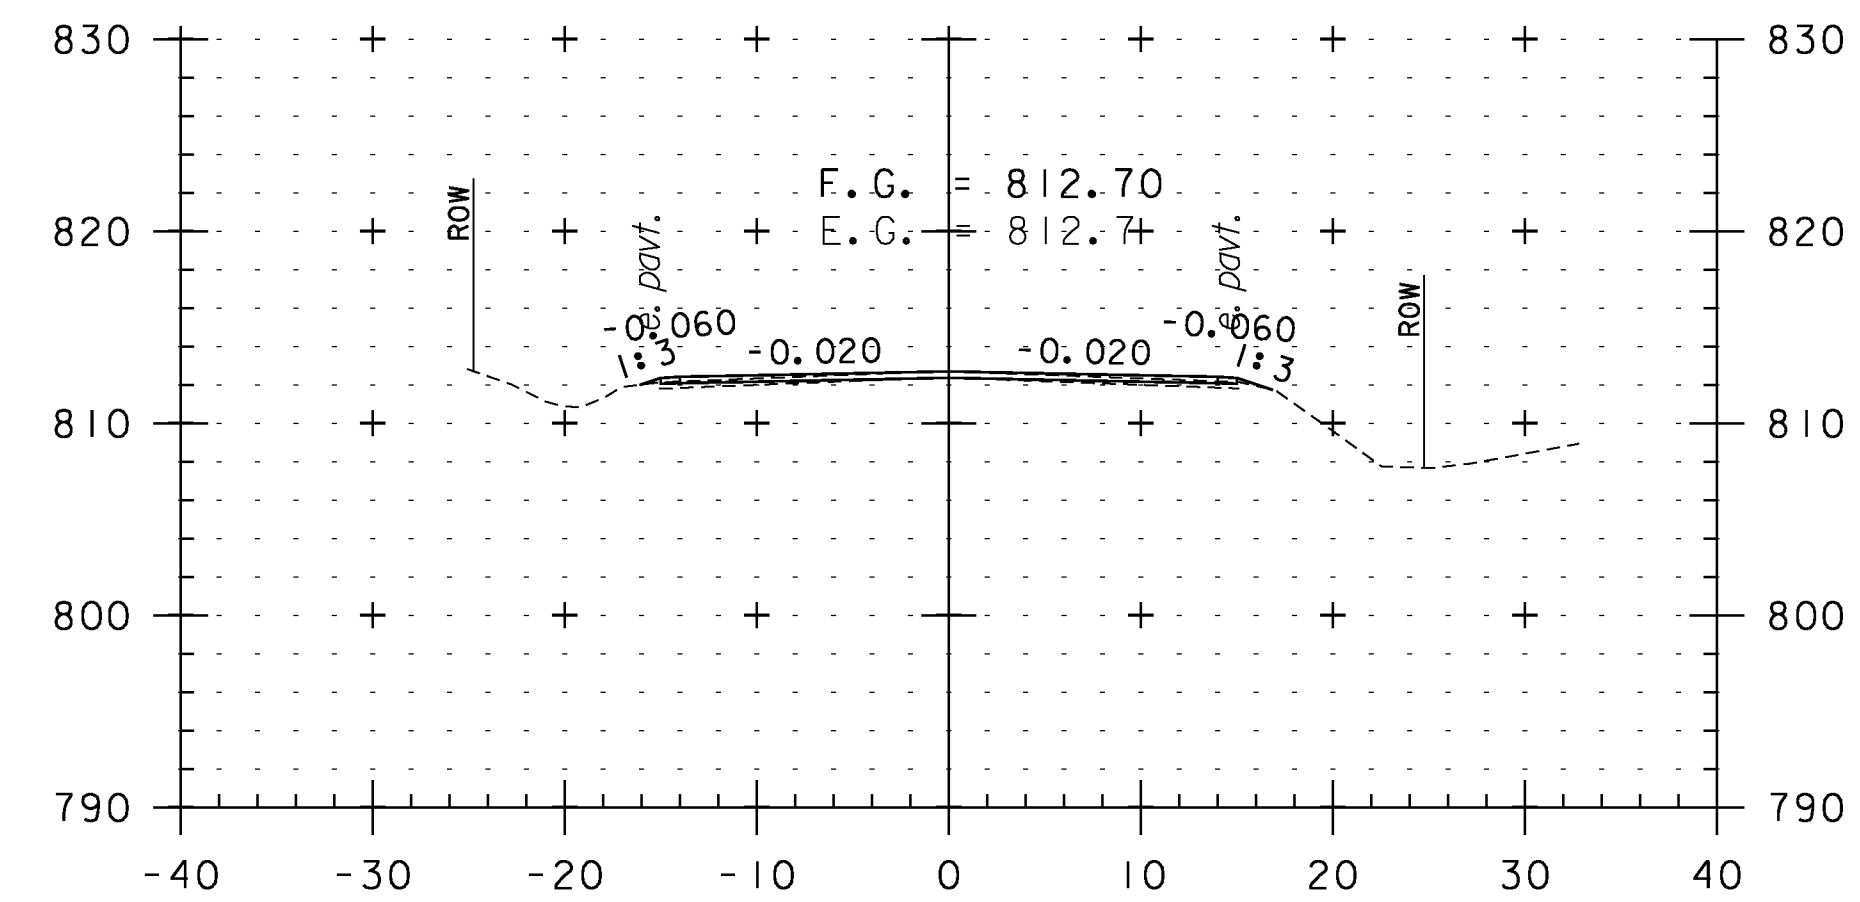


186+50

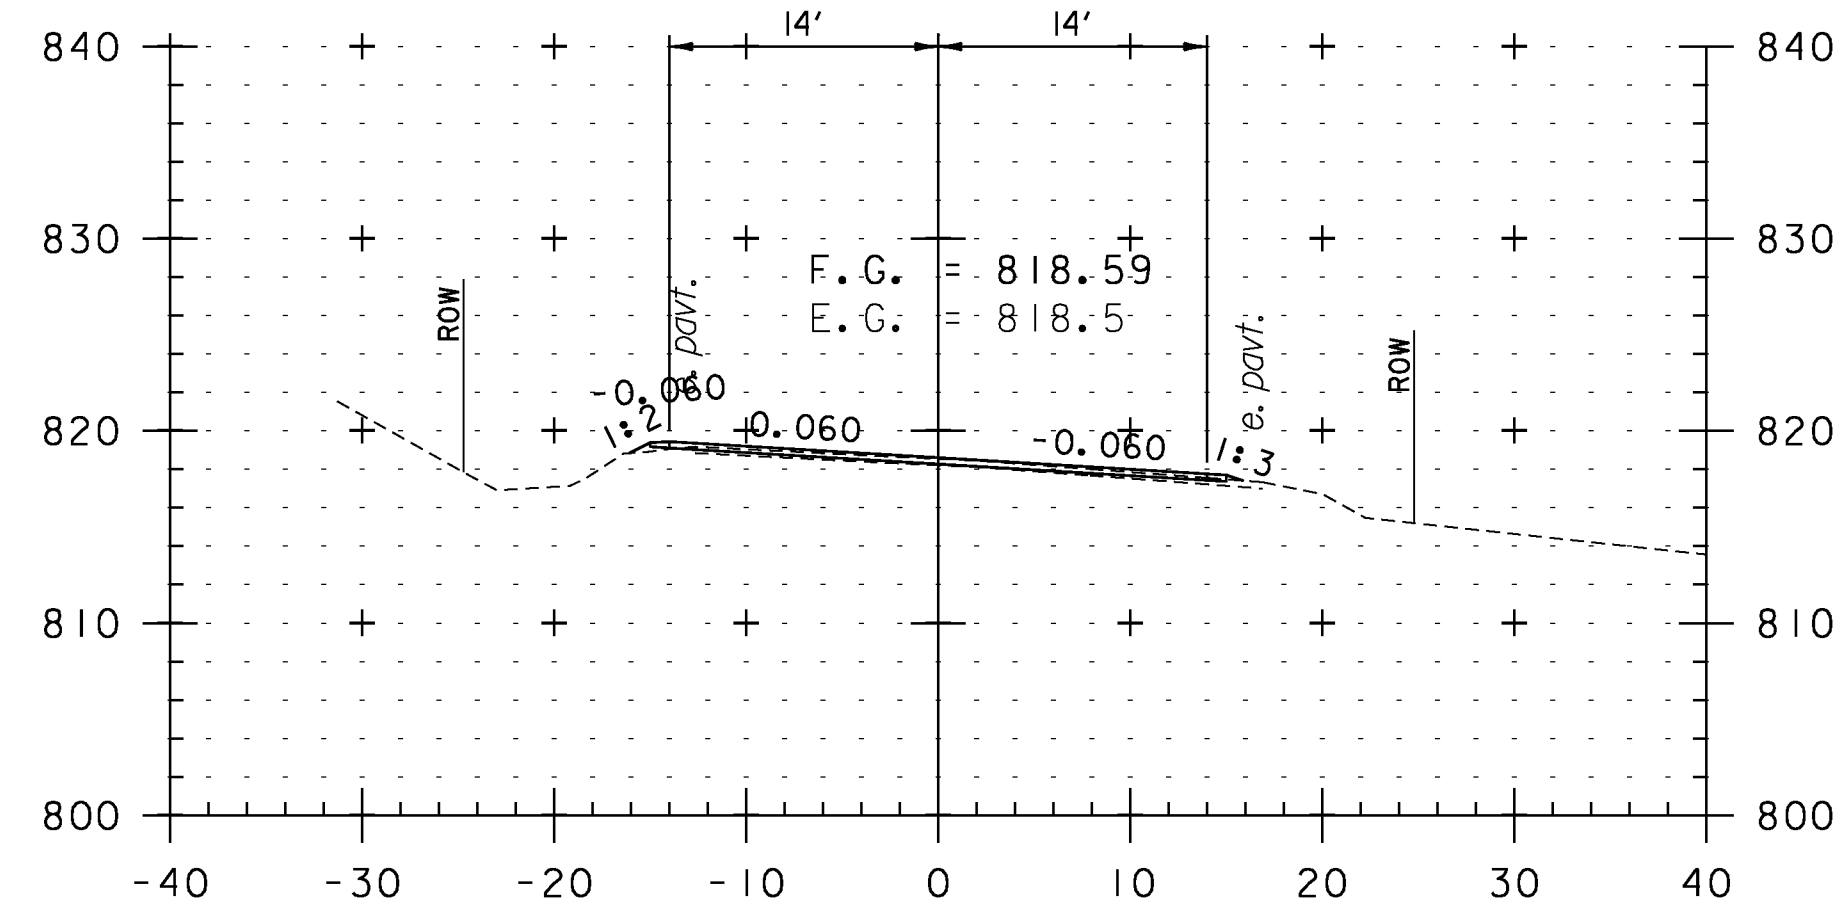

183+50

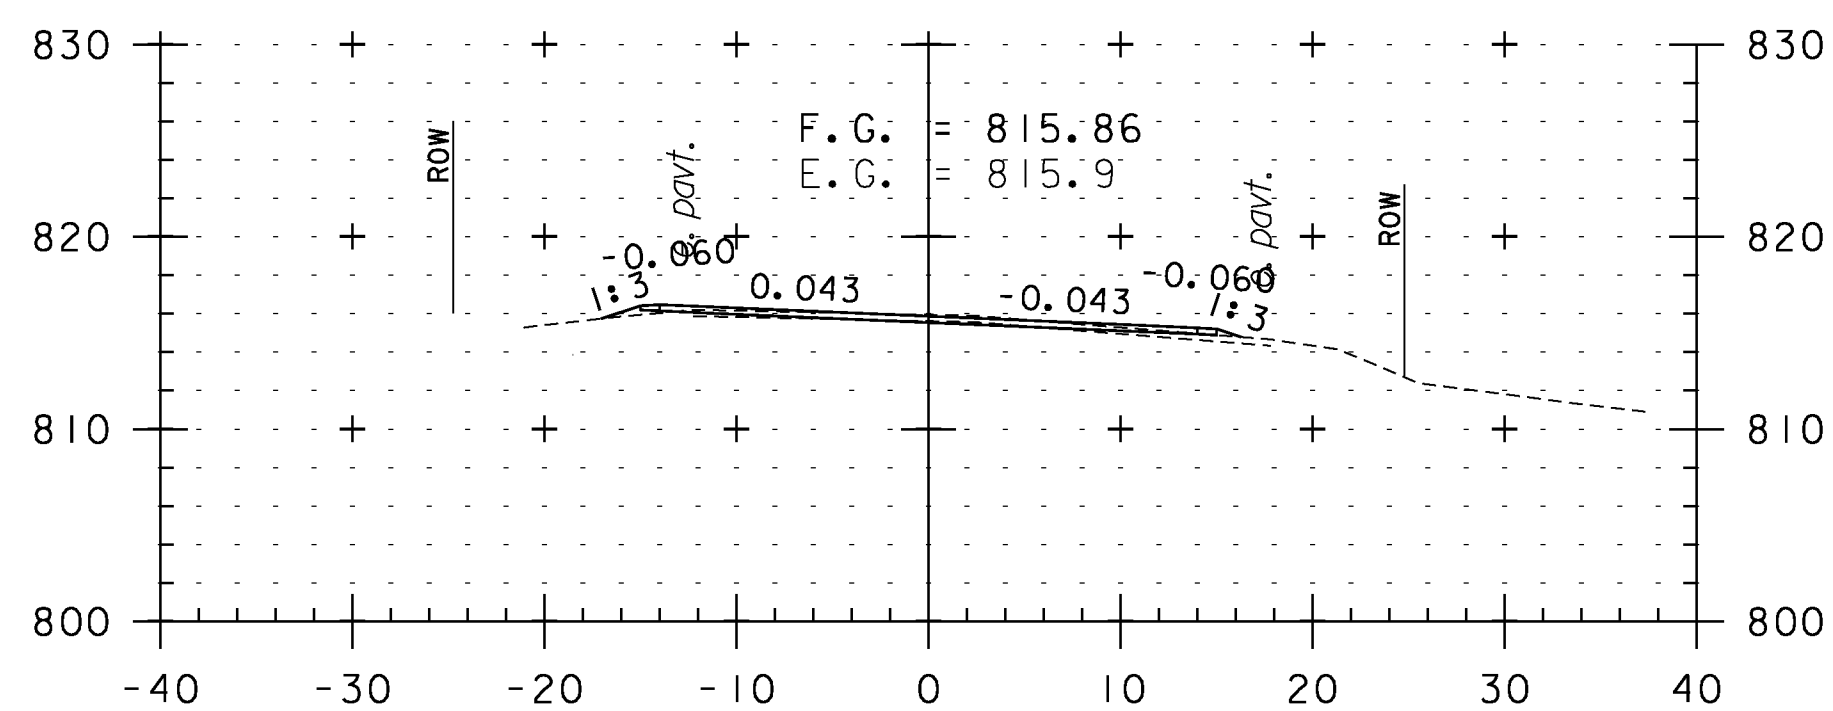


185+00

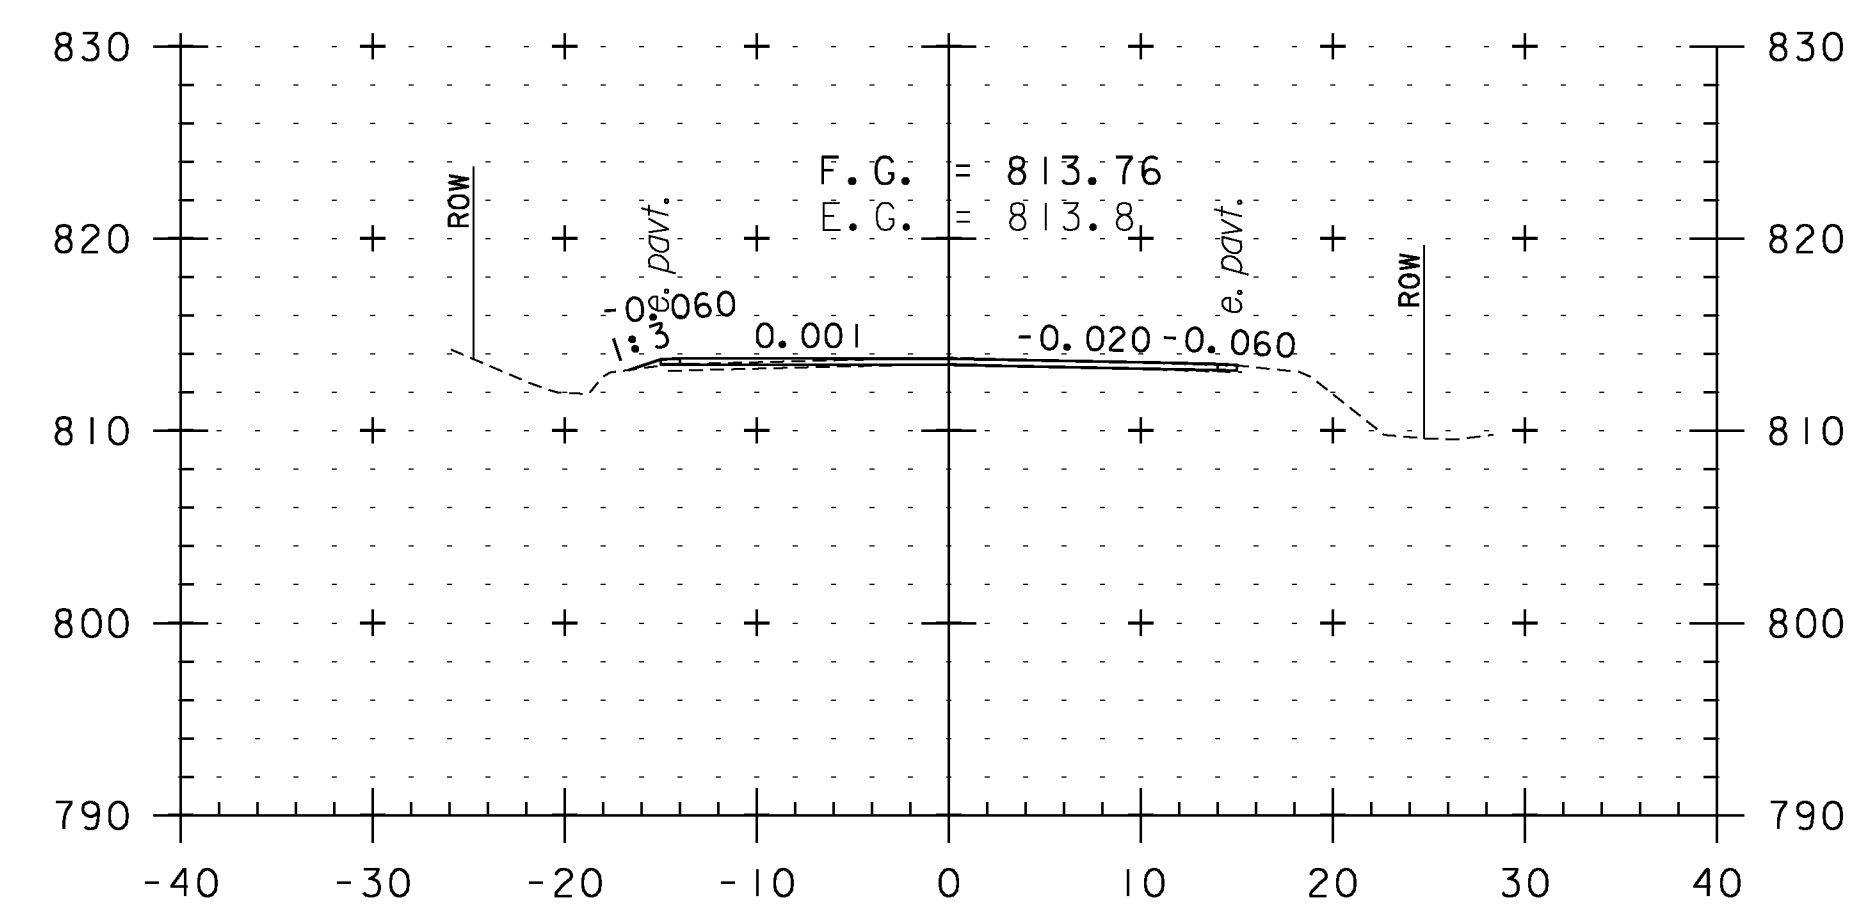

186+00

CROSS SECTION SHEET 28

PROJECT NAME: WEATHERSFIELD	PLOT DATE: 2/7/2013
PROJECT NUMBER: STP 2913(I)	DRAWN BY: WWG
FILE NAME: I0c228	CHECKED BY: PTS
PROJECT LEADER: PTS	SHEET 118 OF 234
DESIGNED BY: NLL	
IPARM FILE NAME: pI0C228_118	

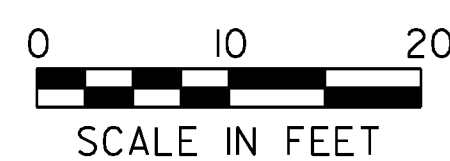

STA. 183+50 TO STA. 187+00