




193+00

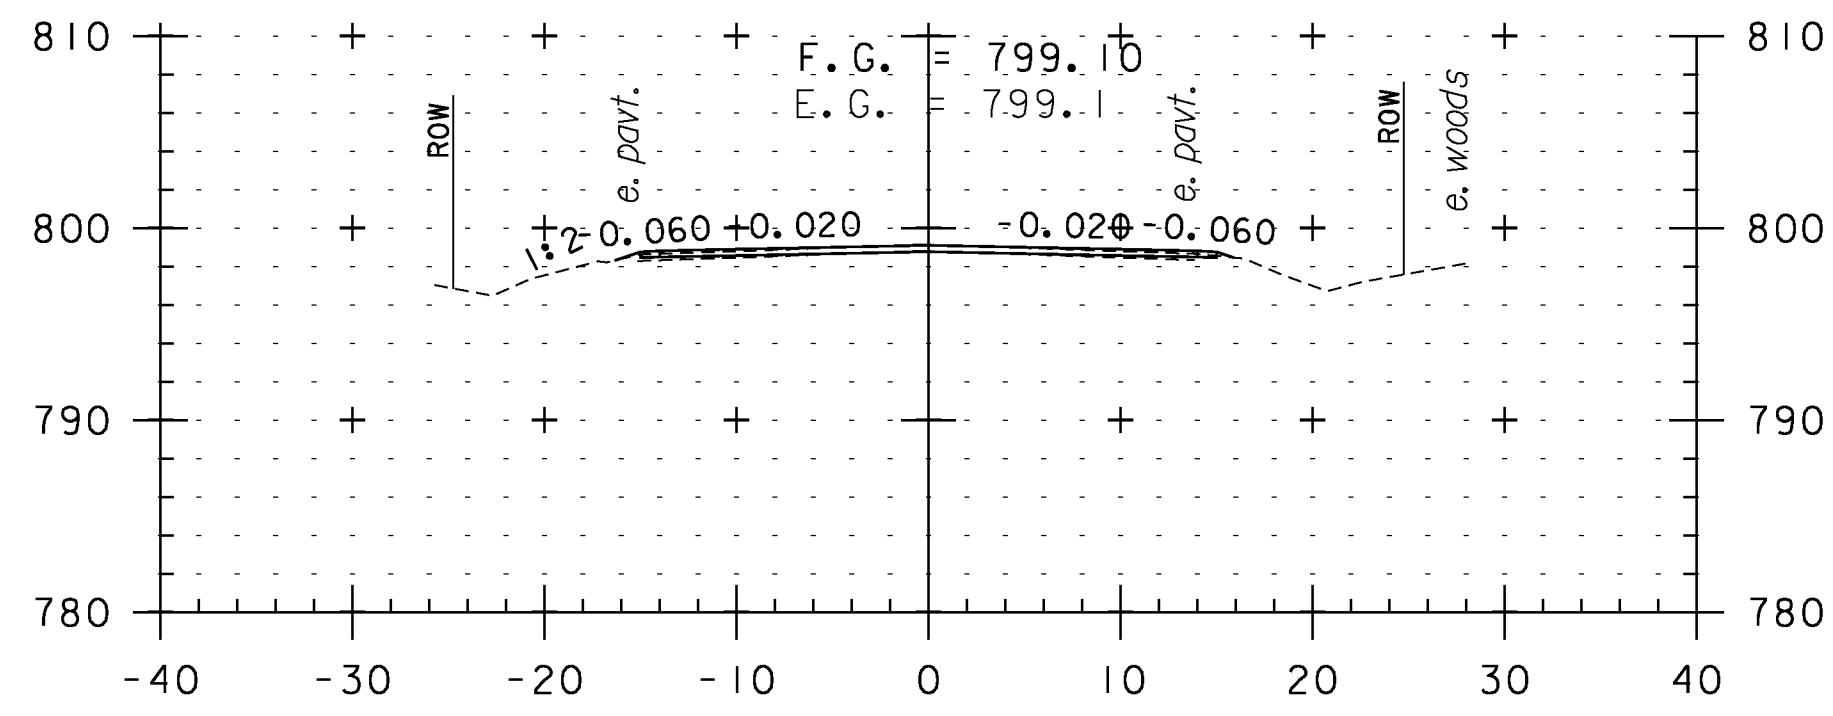


194+50

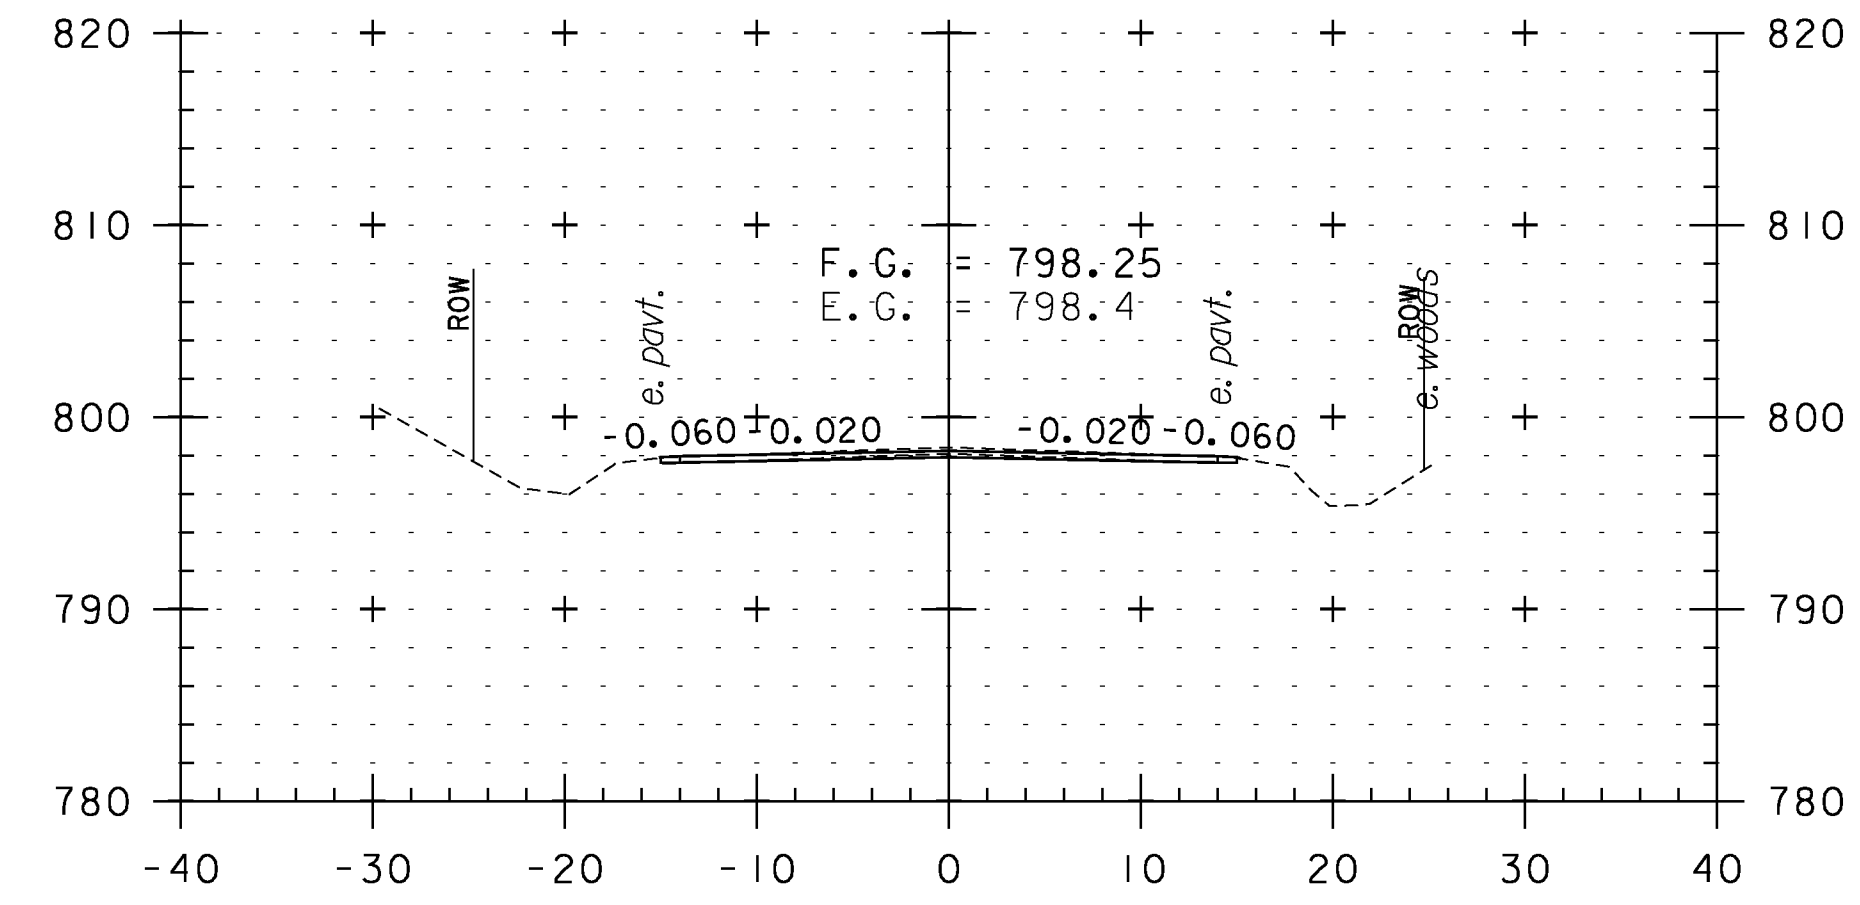


196+00

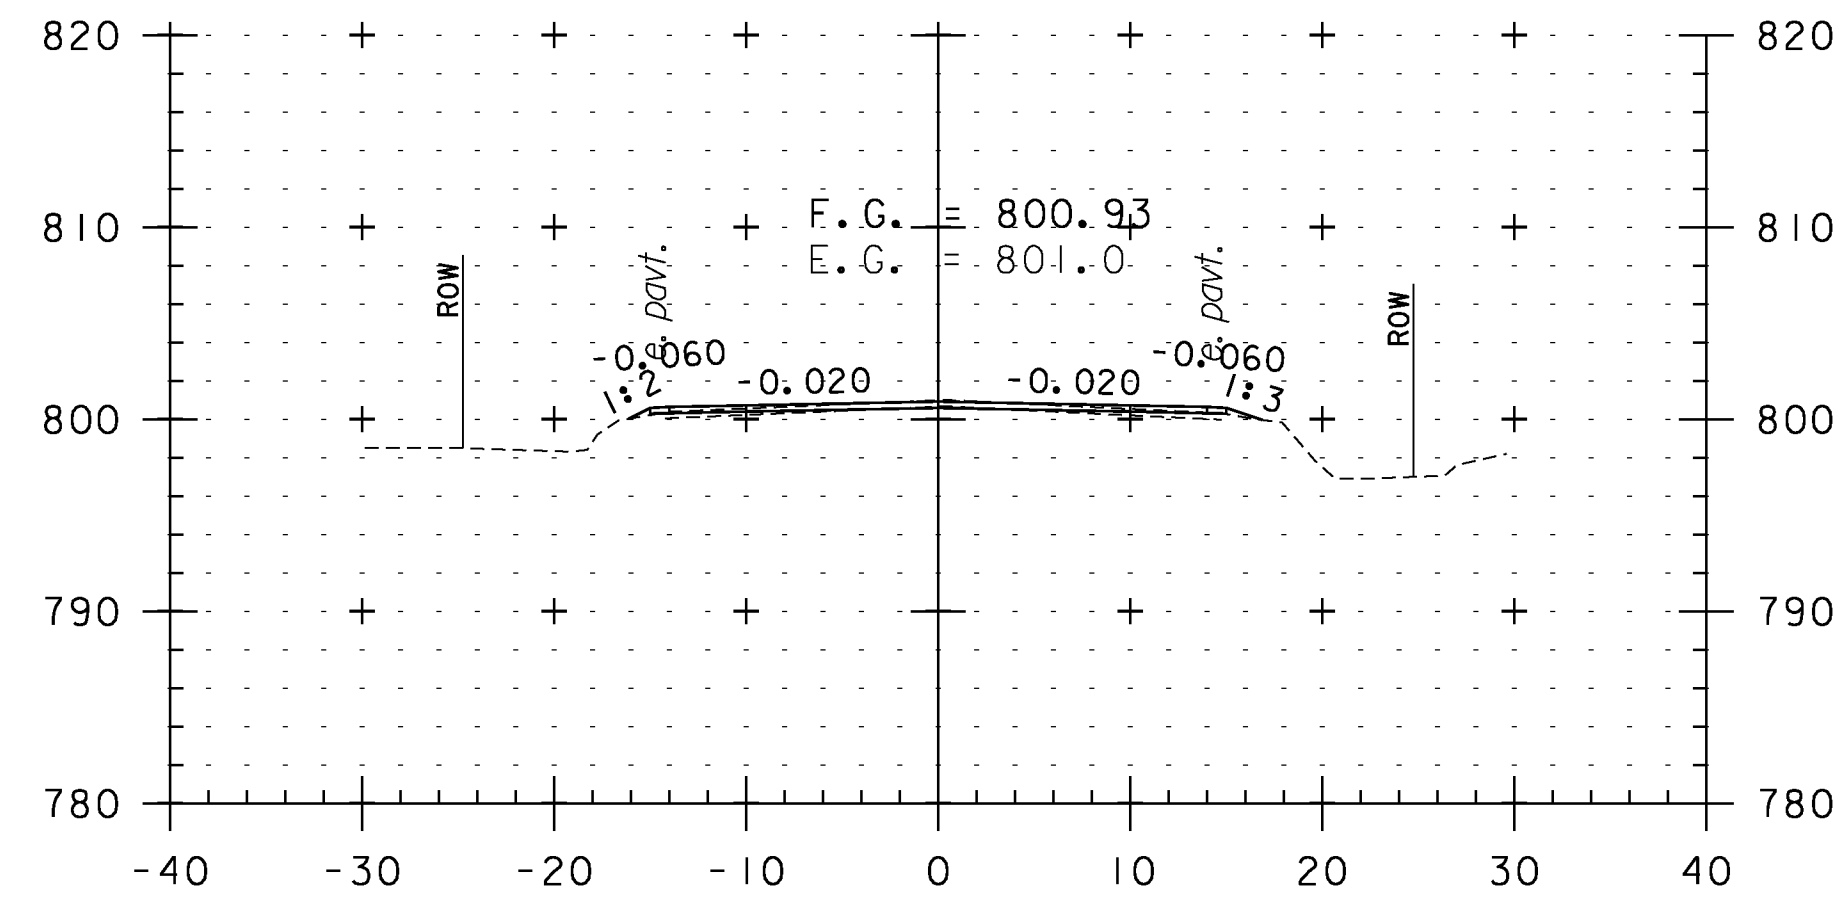


192+50

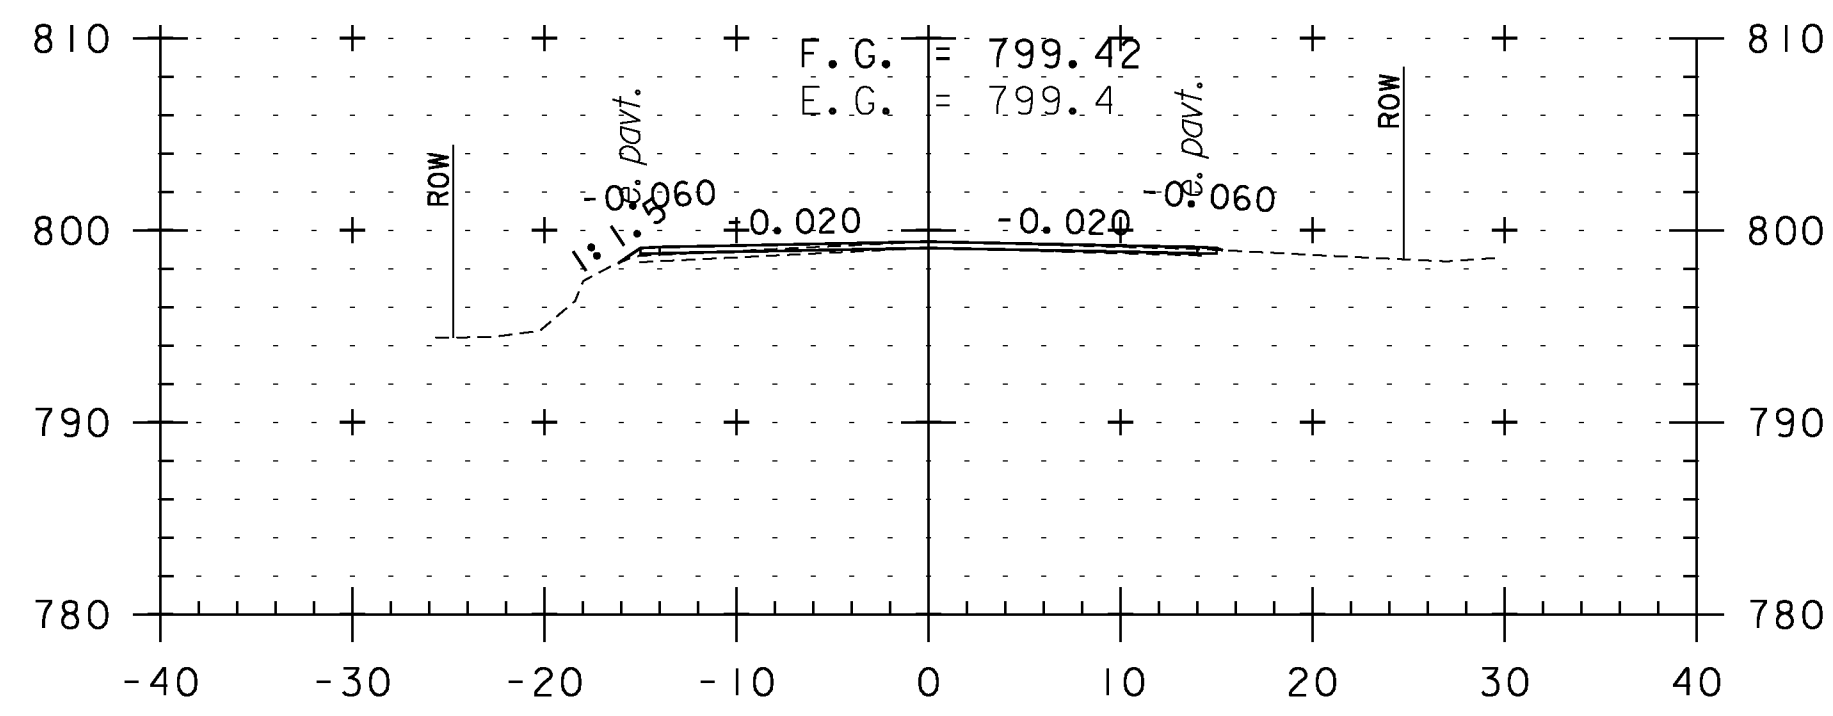


194+00

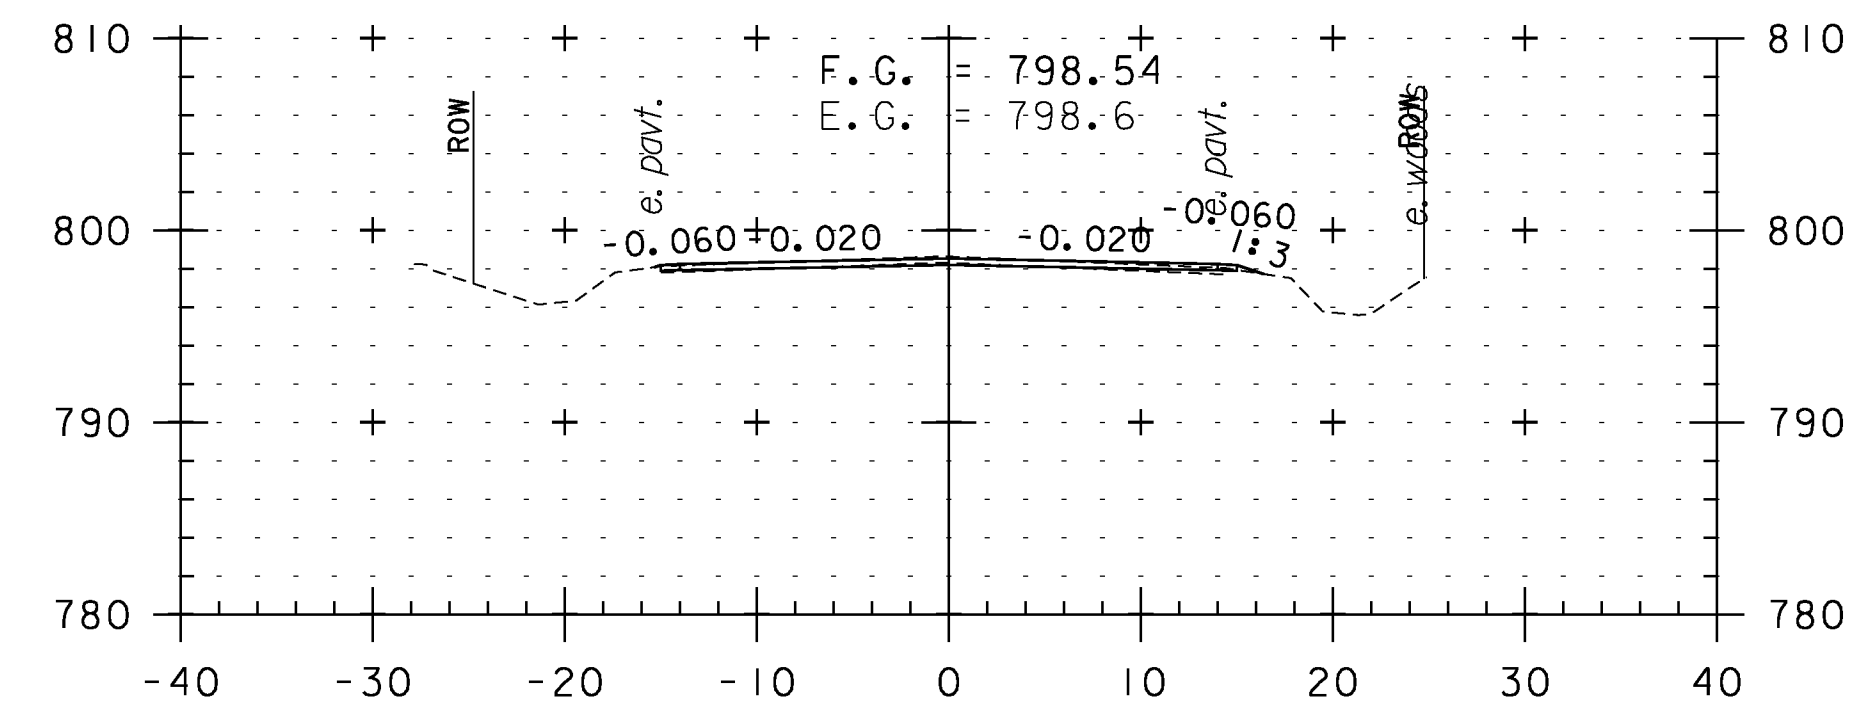


195+50

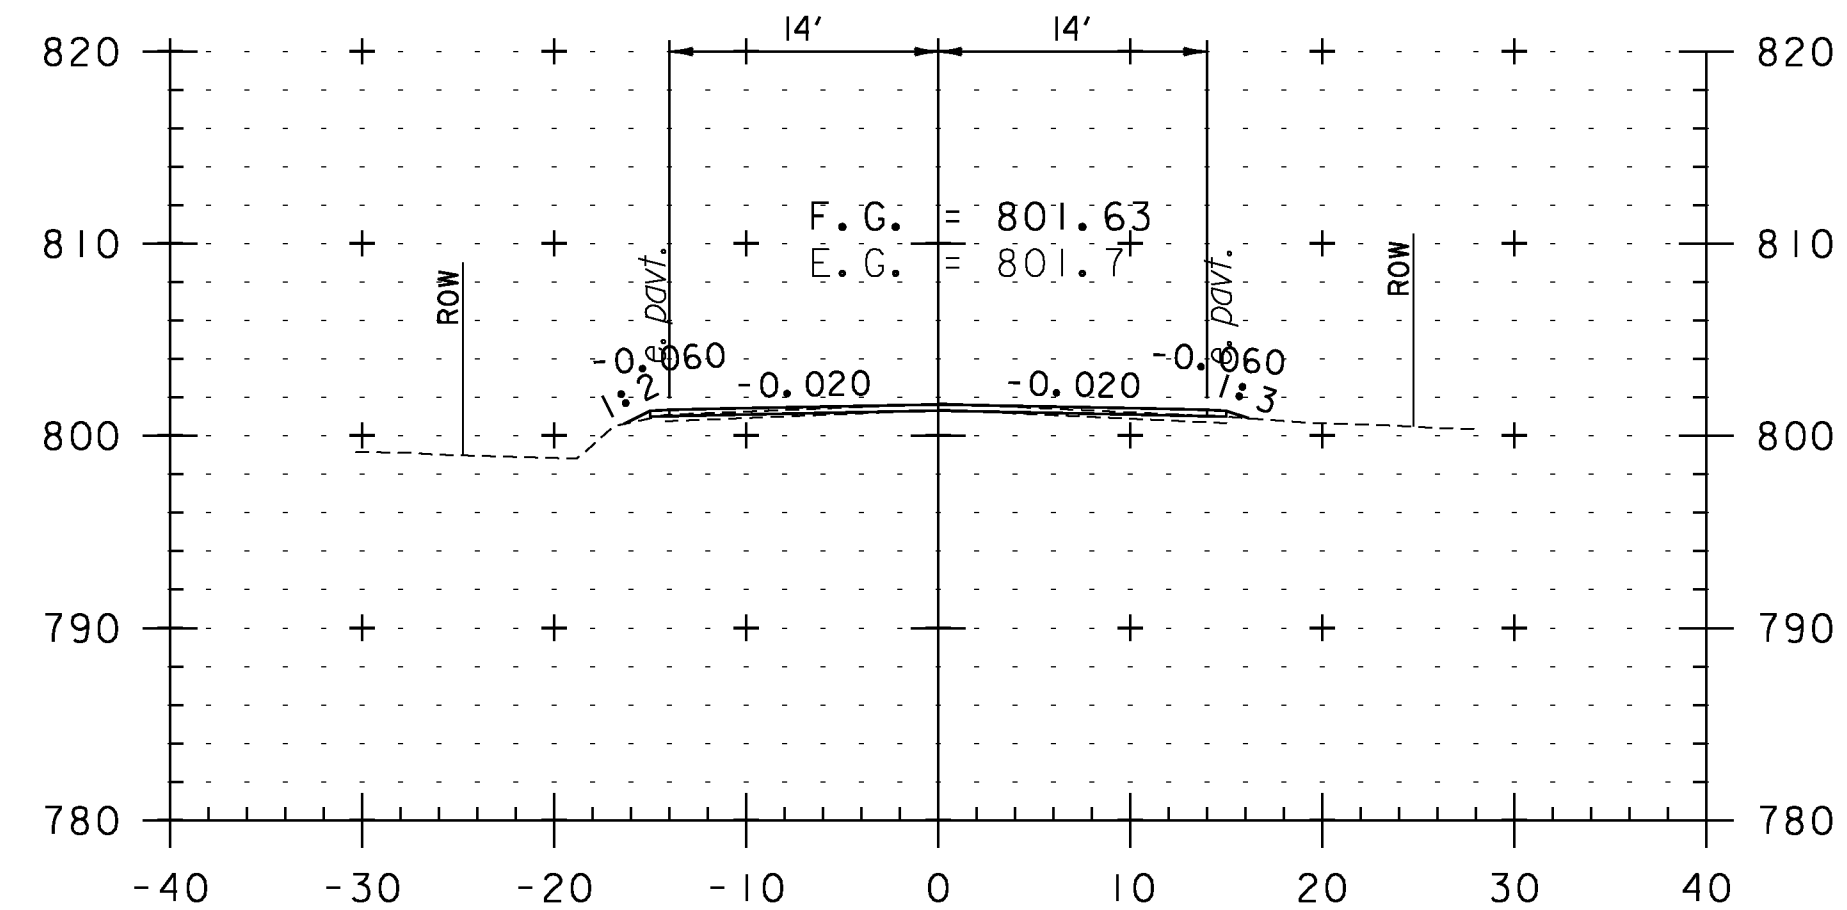

192+00

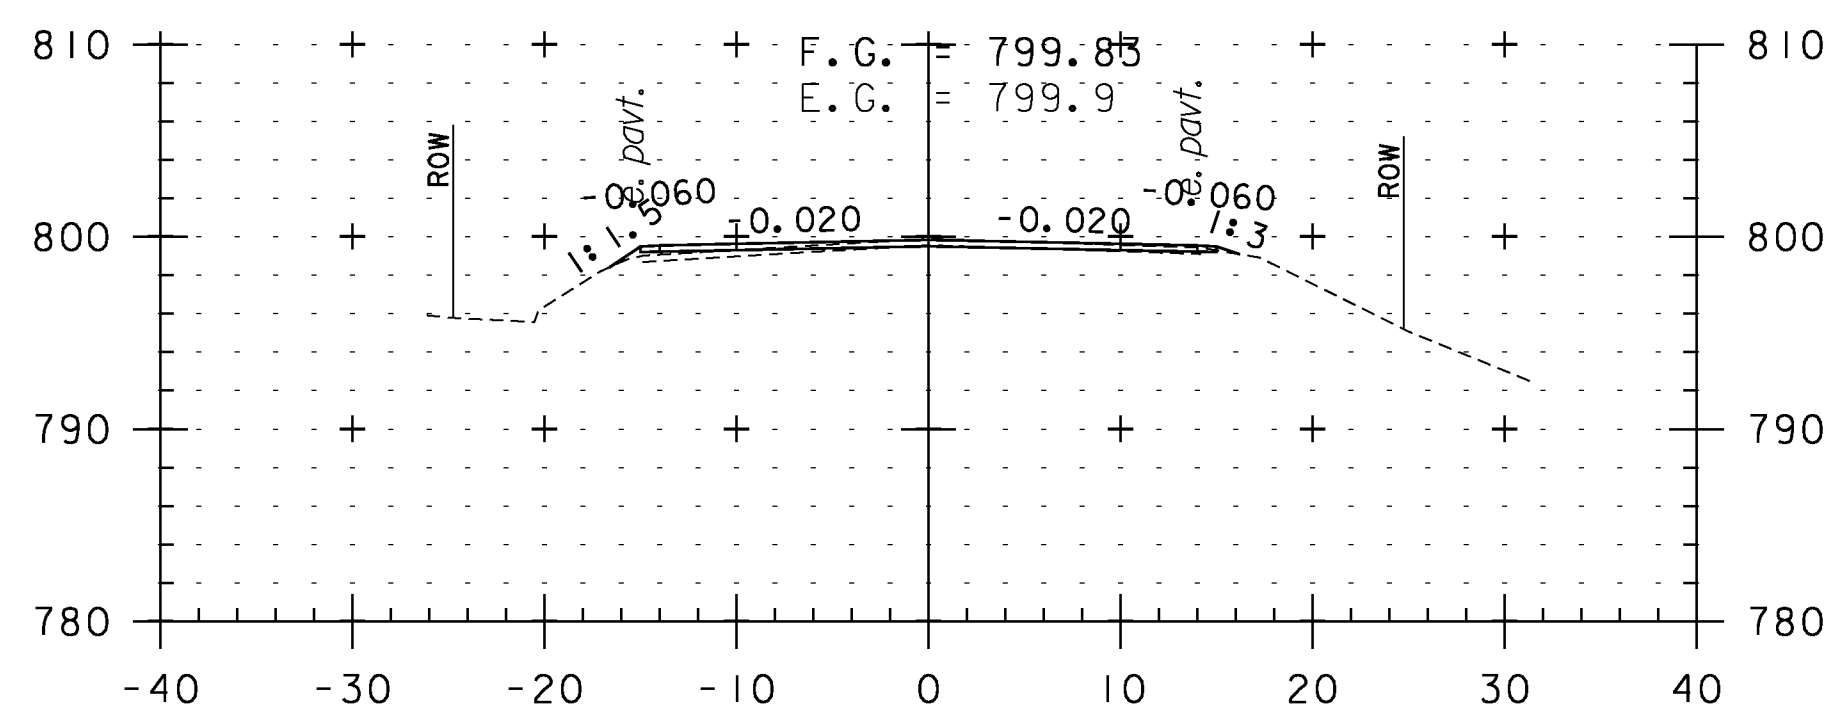

193+50

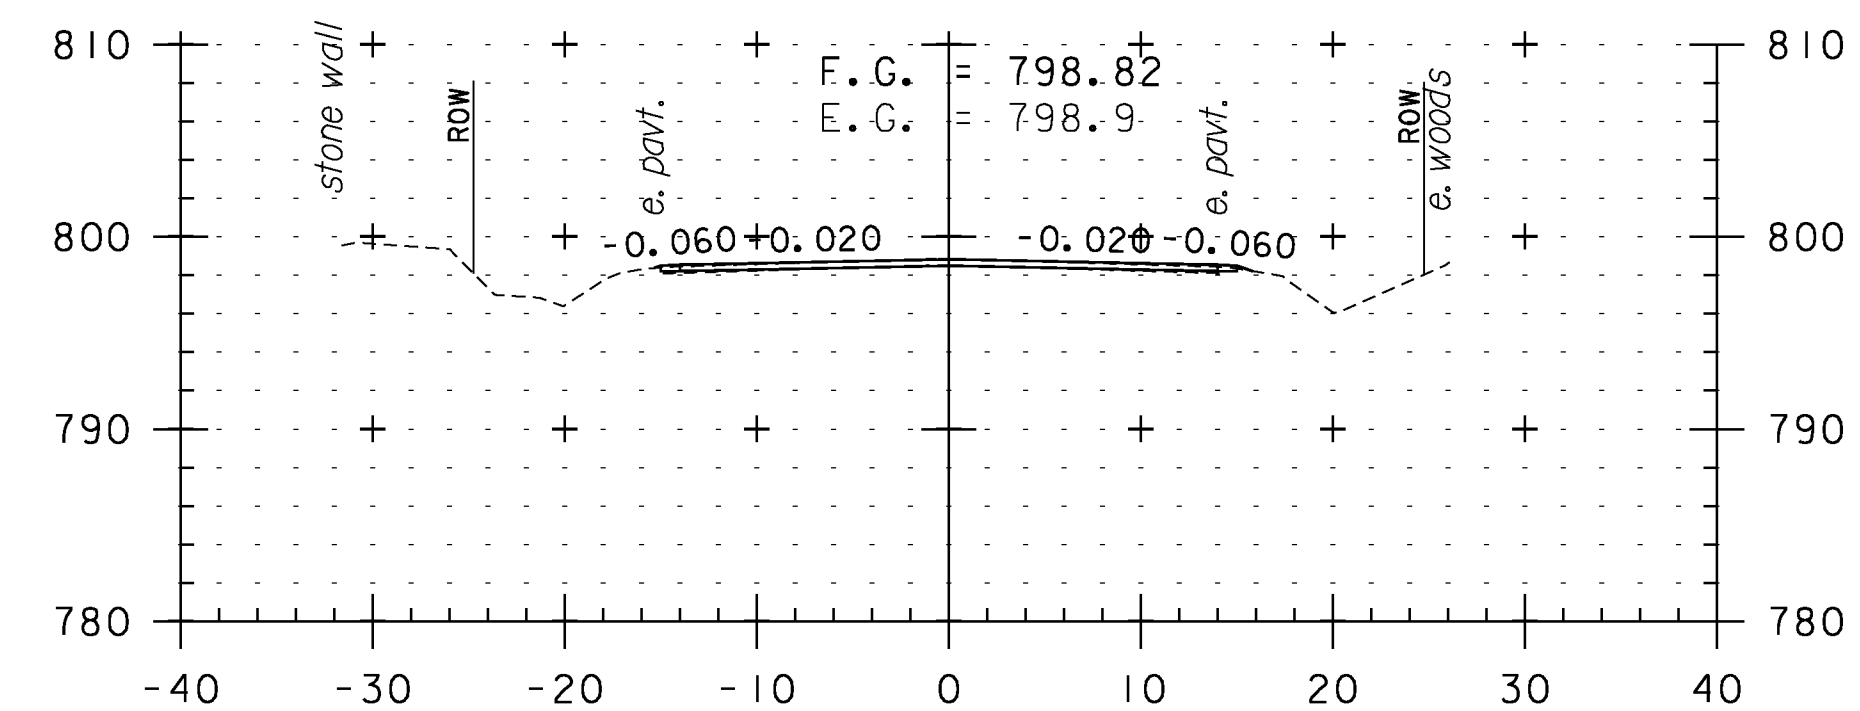

195+00

CROSS SECTION SHEET 30

PROJECT NAME: WEATHERSFIELD	
PROJECT NUMBER: STP 2913(I)	
FILE NAME: I0c228	PLOT DATE: 2/7/2013
PROJECT LEADER: PTS	DRAWN BY: WWG
DESIGNED BY: NLL	CHECKED BY: PTS
IPARM FILE NAME: pI0C228.I20	SHEET 120 OF 234



STA. 192+00 TO STA. 196+00