




201+00

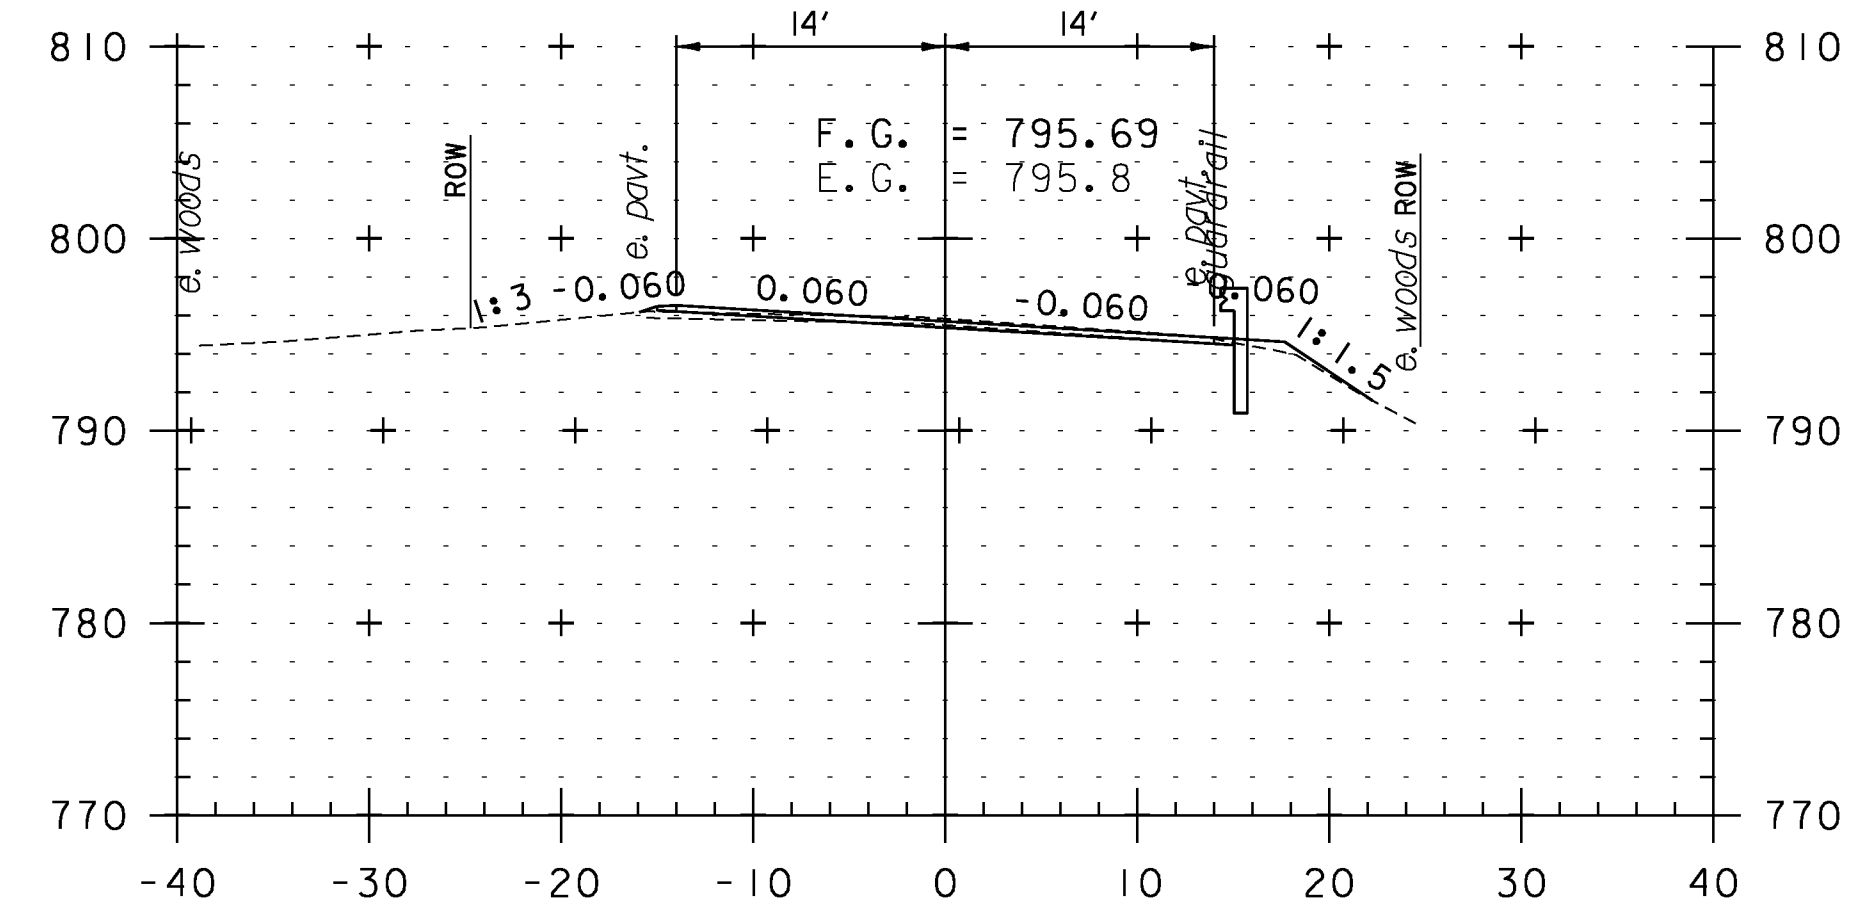


200+50

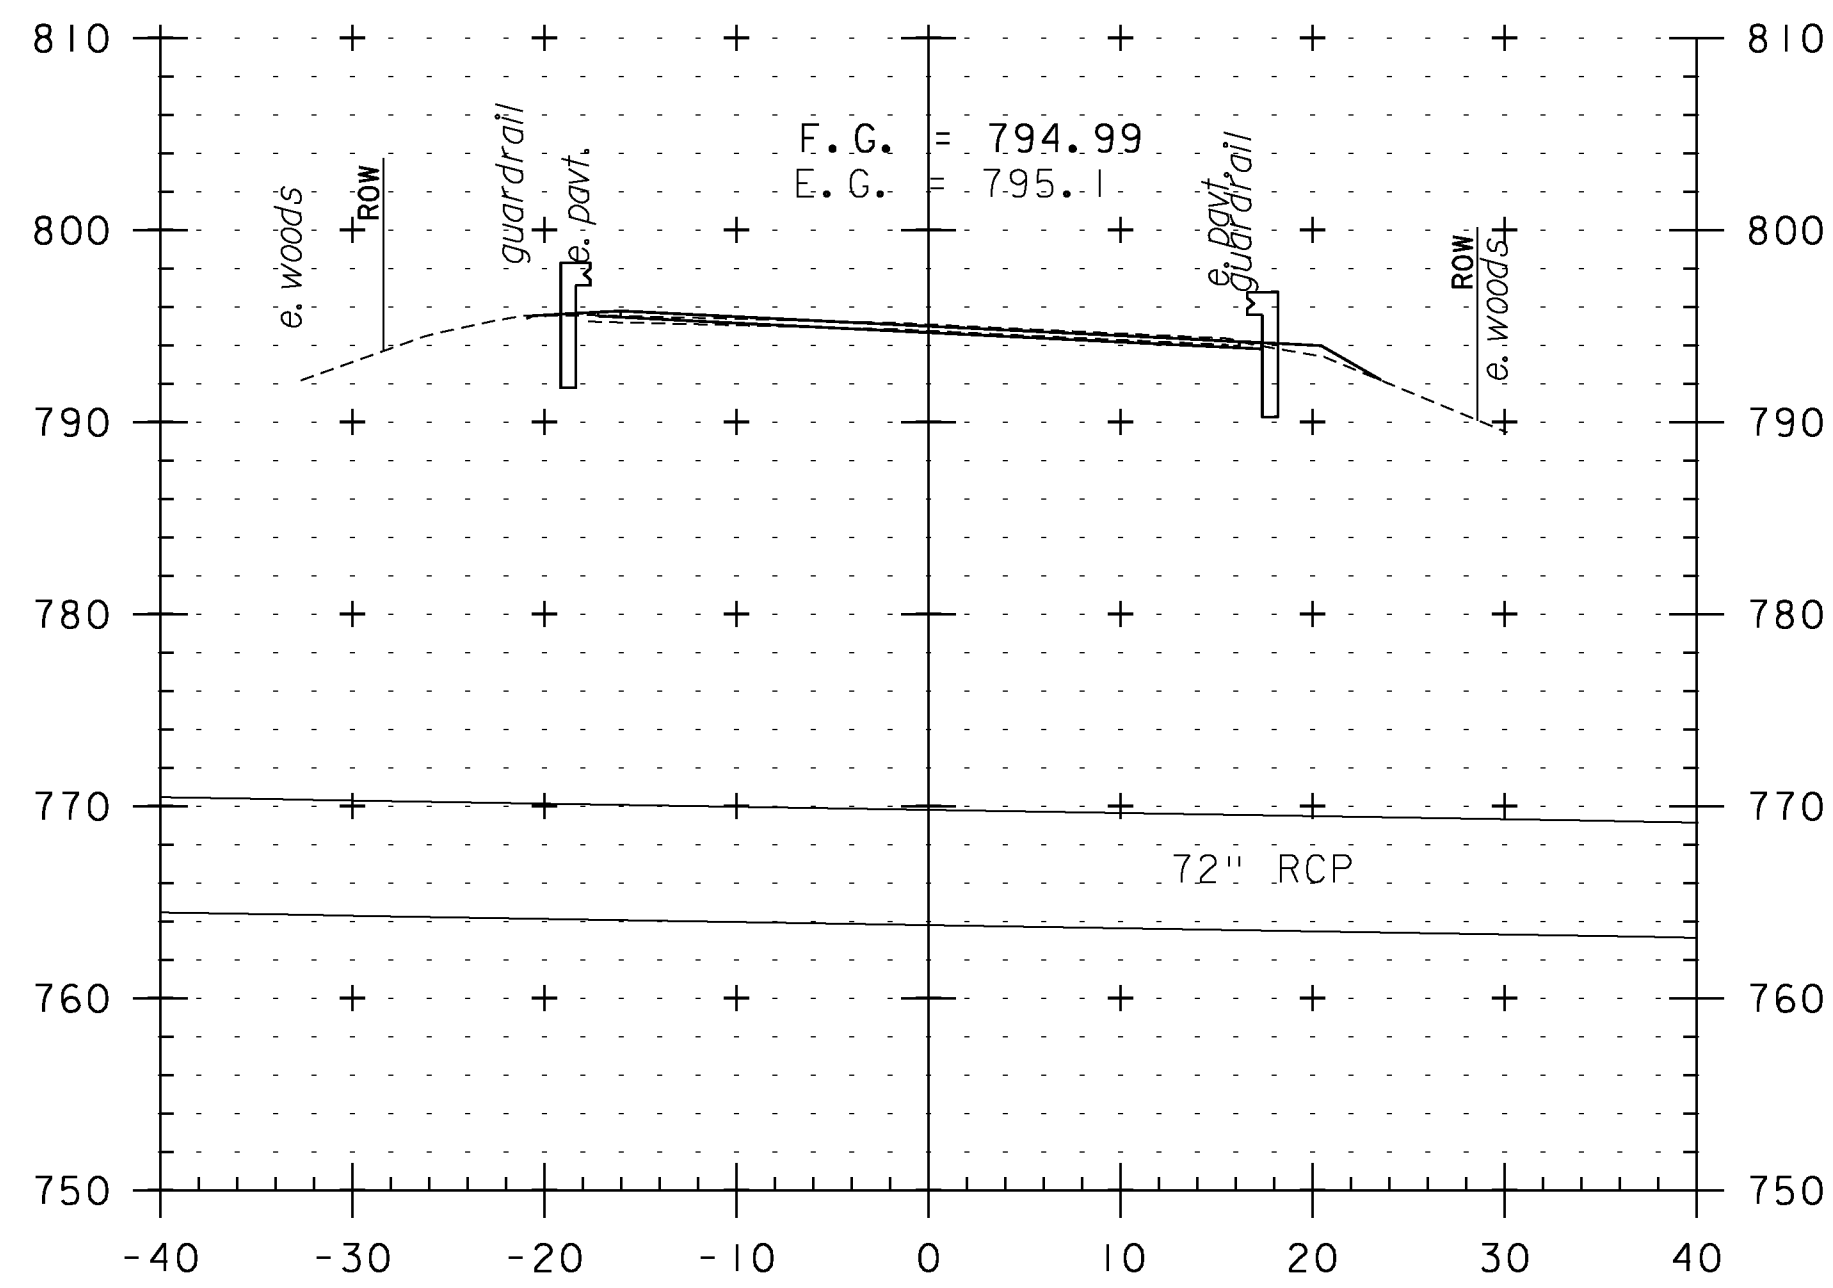


201+73
BRIDGE IIB

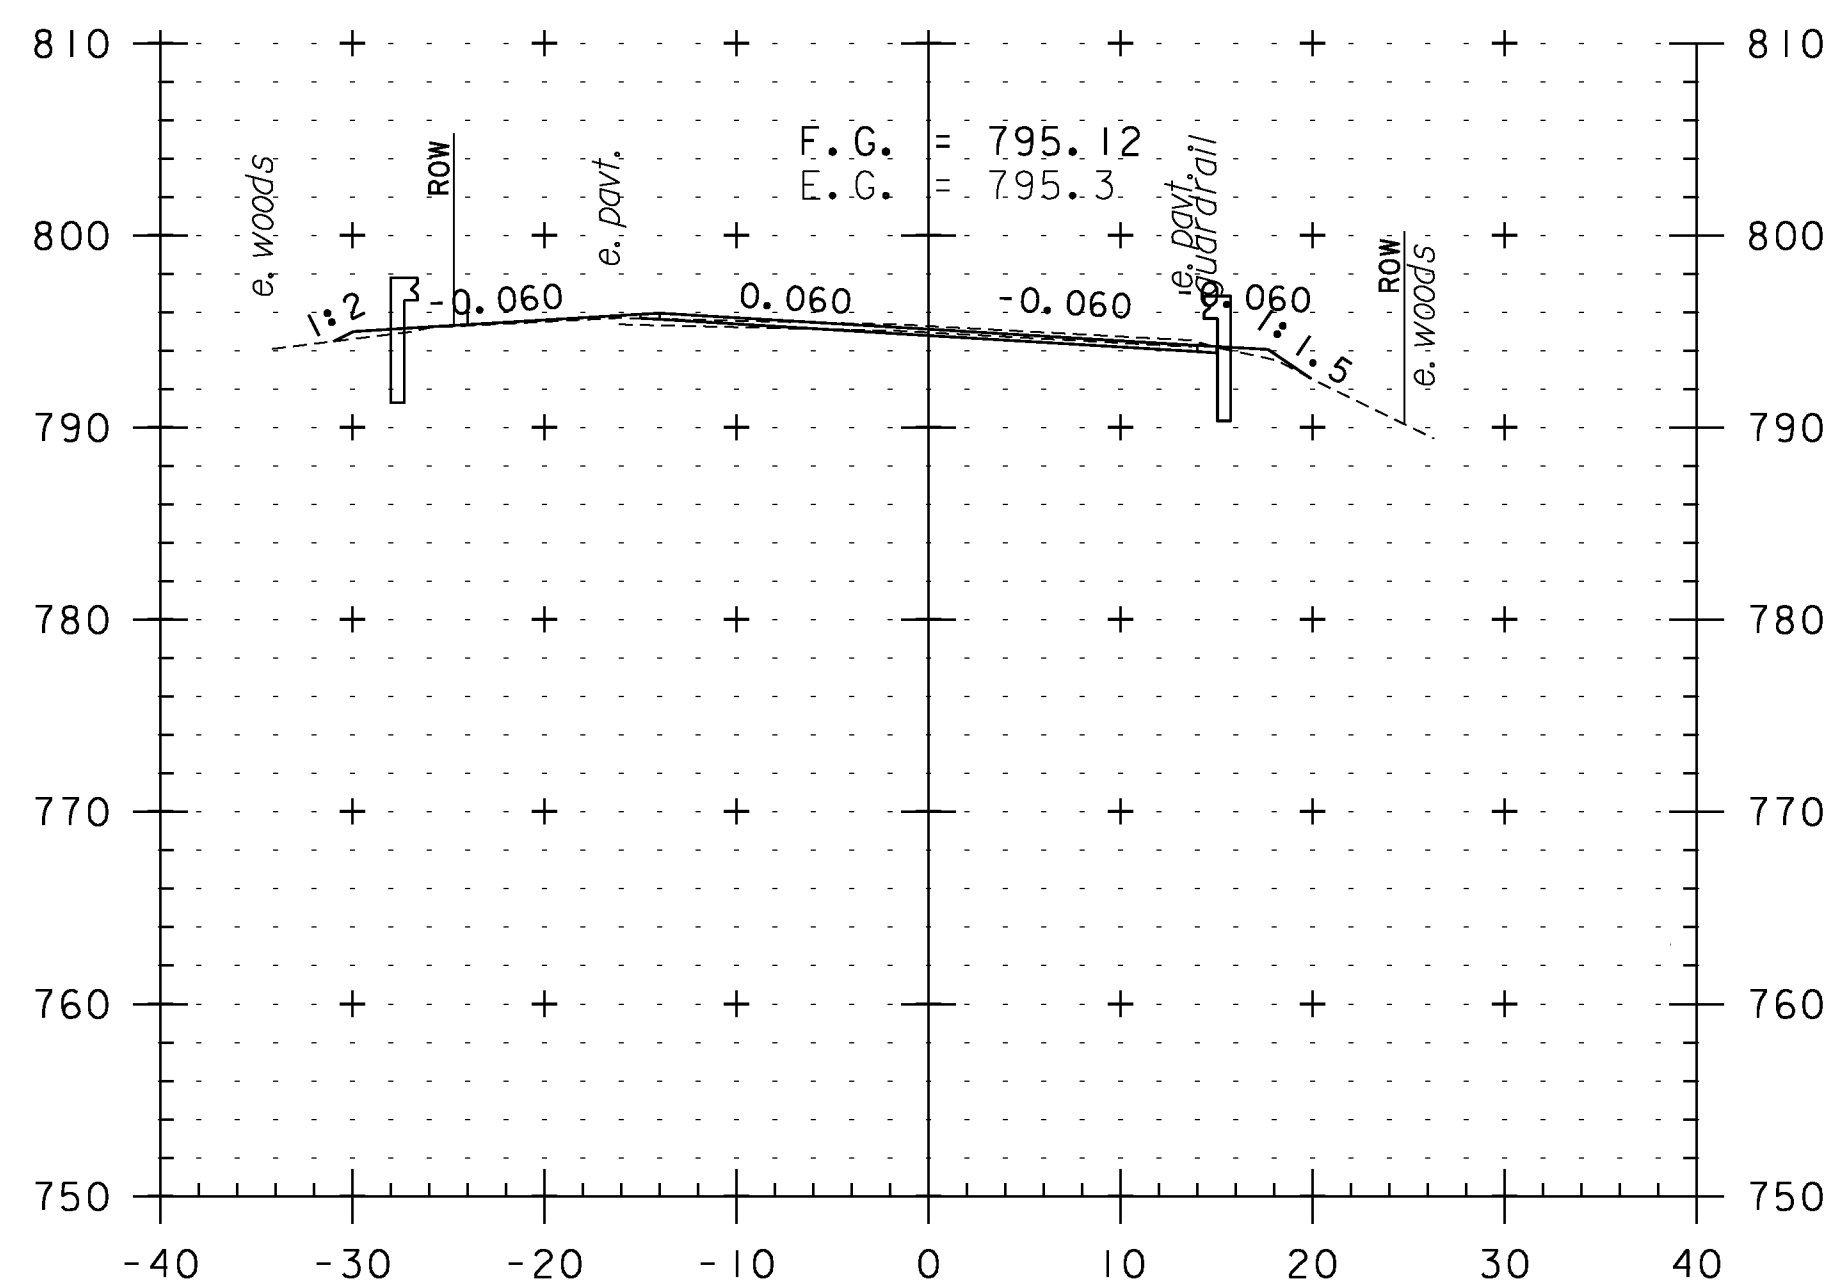


201+50

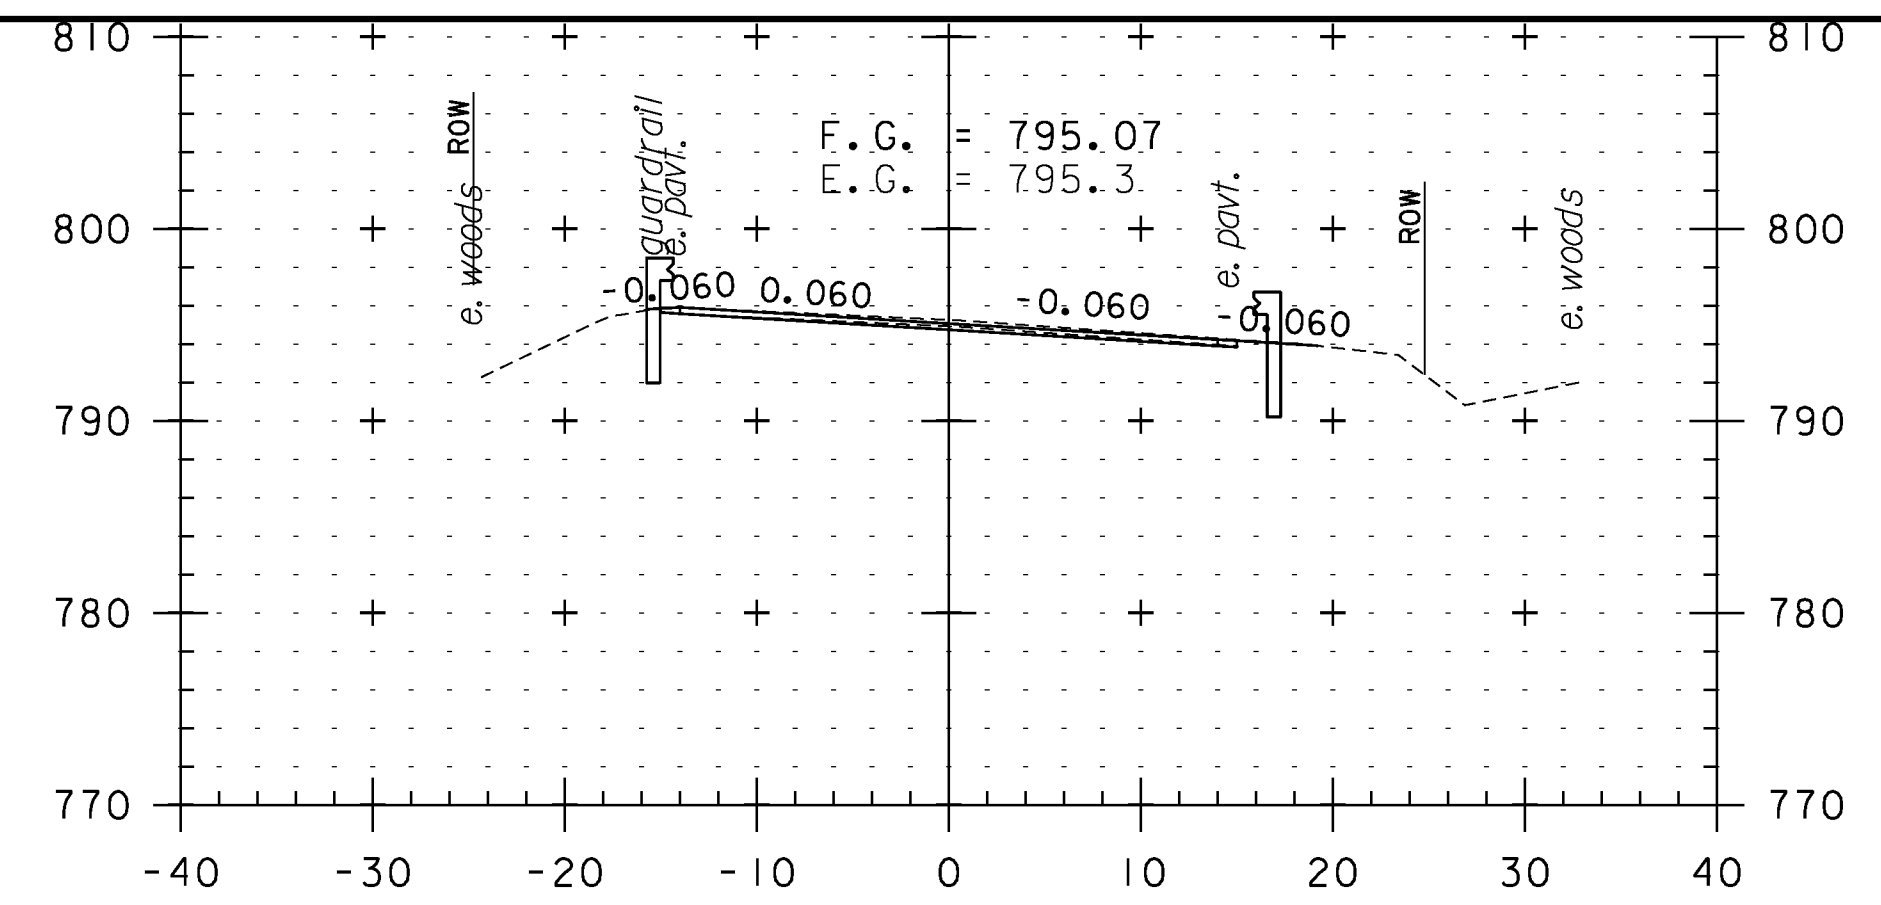

203+00

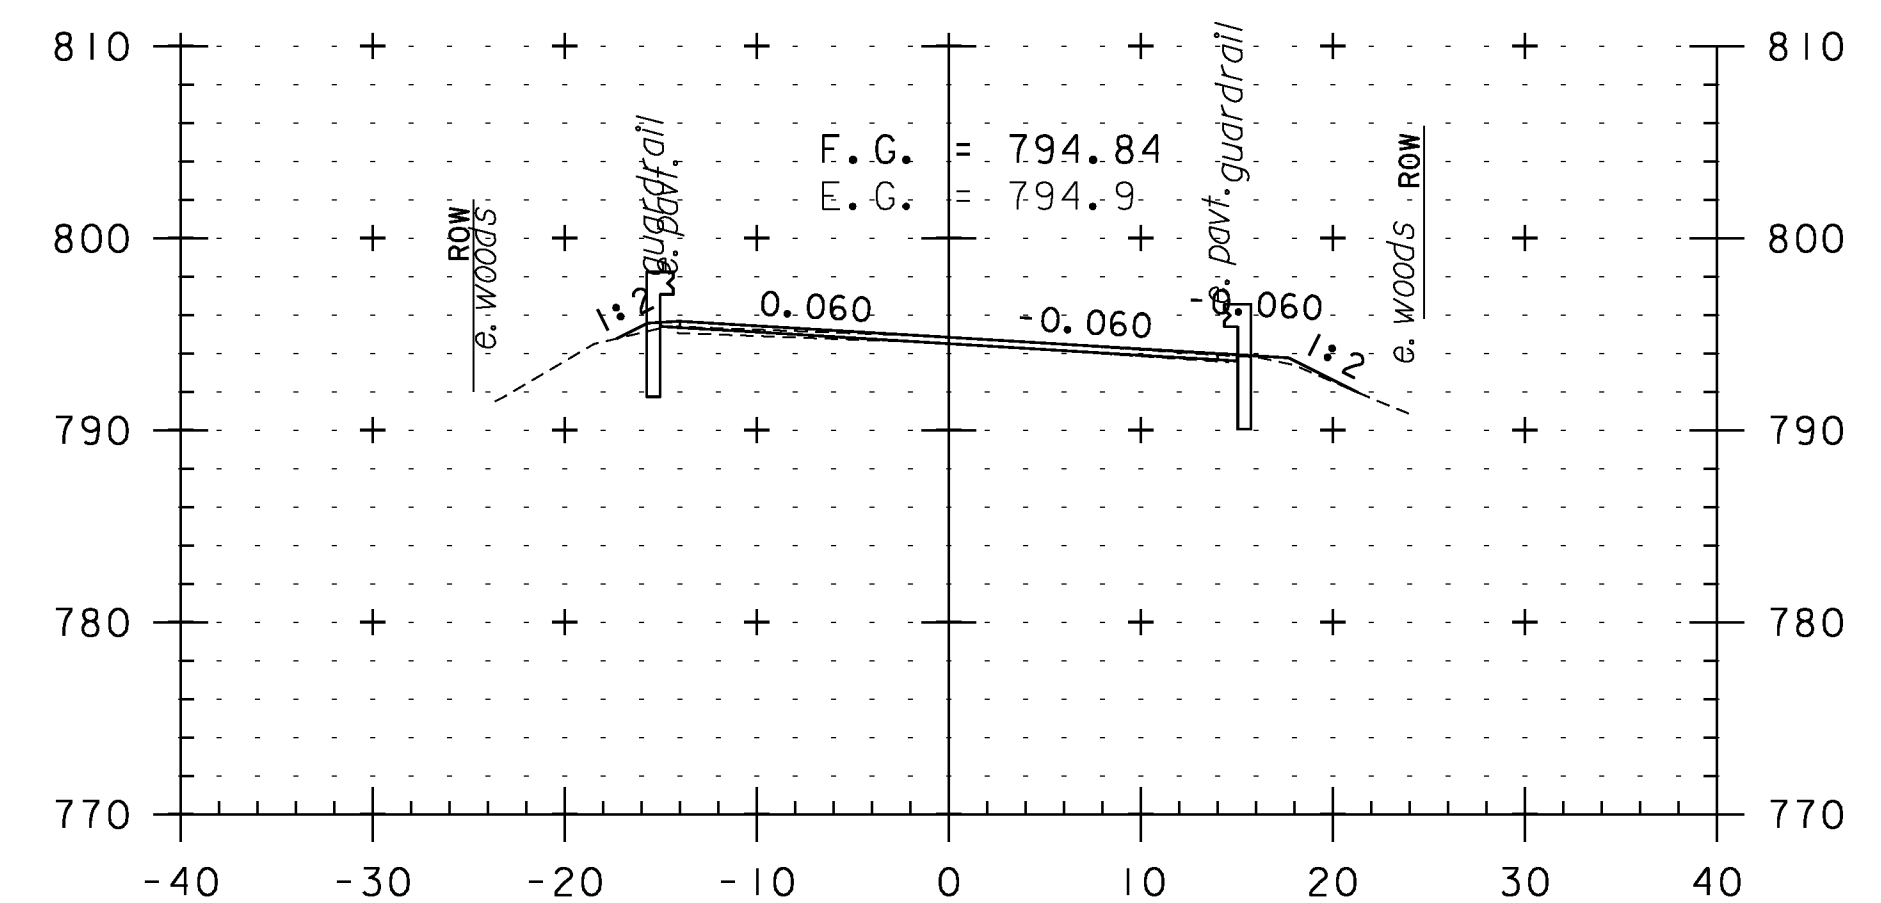

202+50

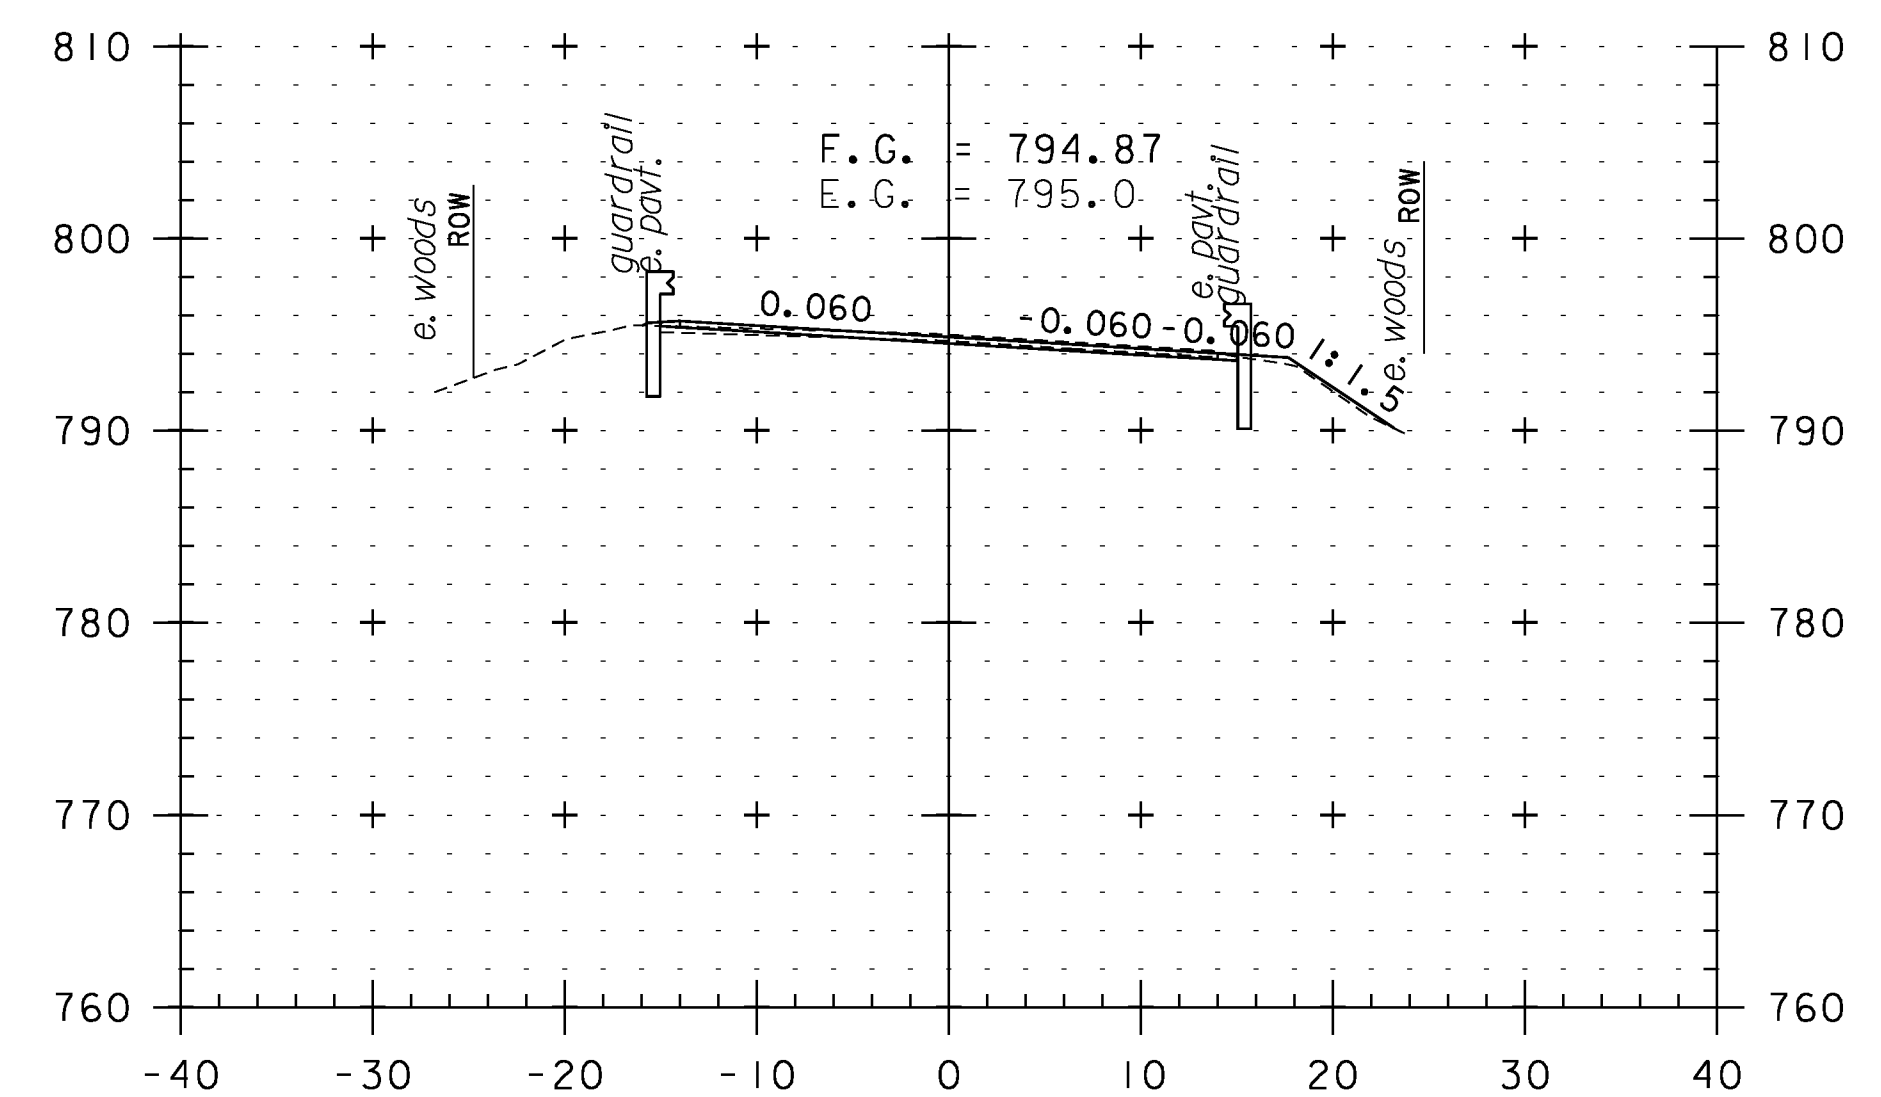

202+00

CROSS SECTION SHEET 32

PROJECT NAME: WEATHERSFIELD

PROJECT NUMBER: STP 2913(I)

FILE NAME: I0c228

PROJECT LEADER: PTS

DESIGNED BY: NLL


IPARM FILE NAME: pI0c228_I22

PLOT DATE: 2/7/2013

DRAWN BY: WWG

CHECKED BY: PTS

SHEET I22 OF 234

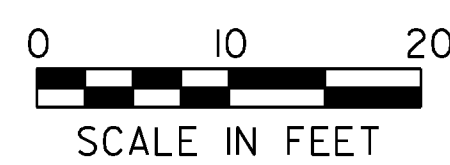

STA. 200+50 TO STA. 203+00