




209+00

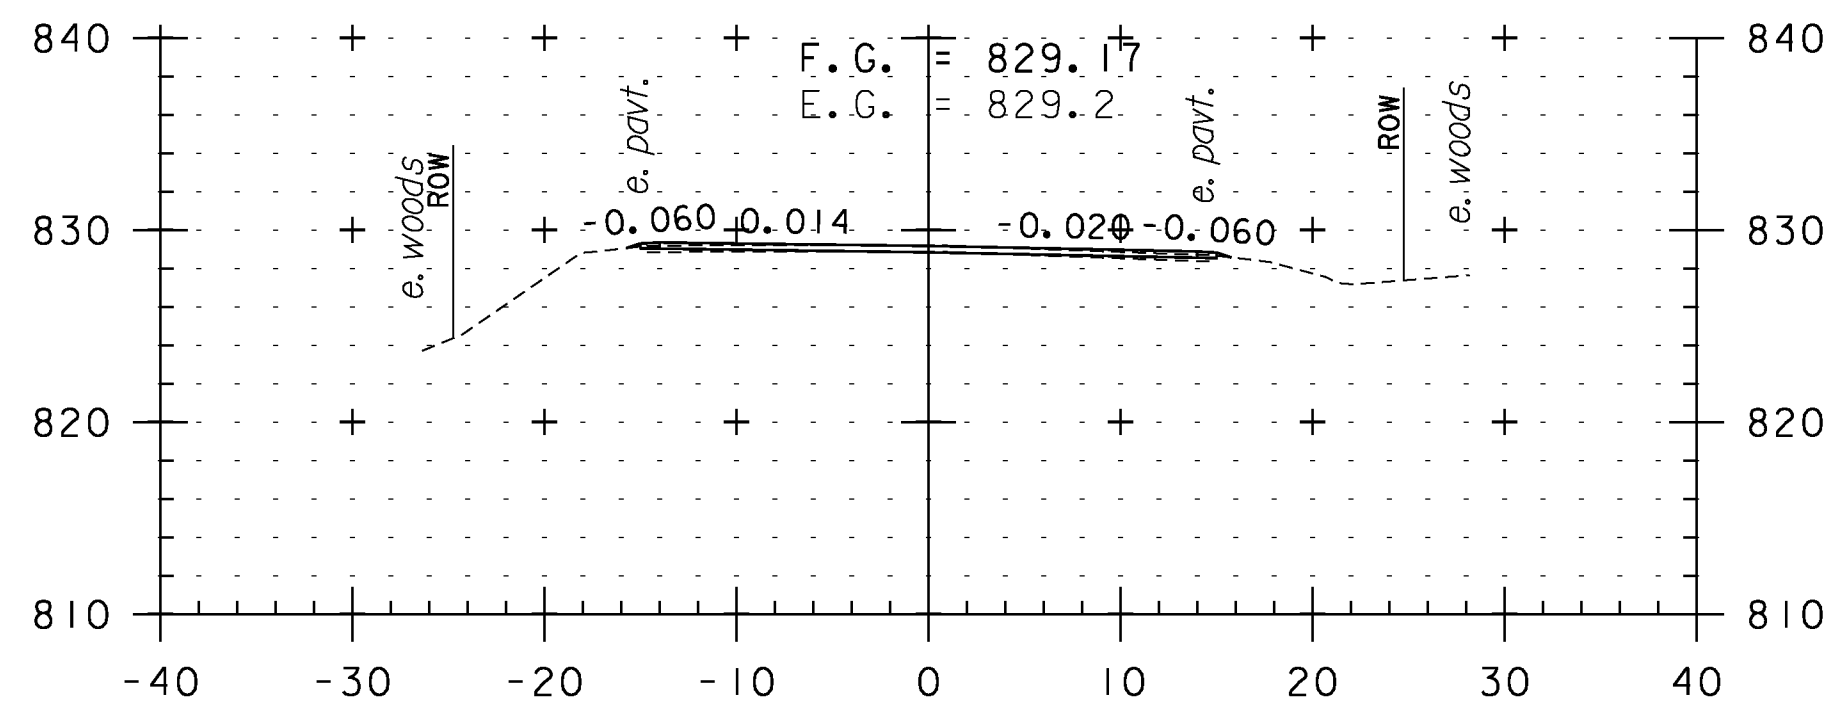


210+50

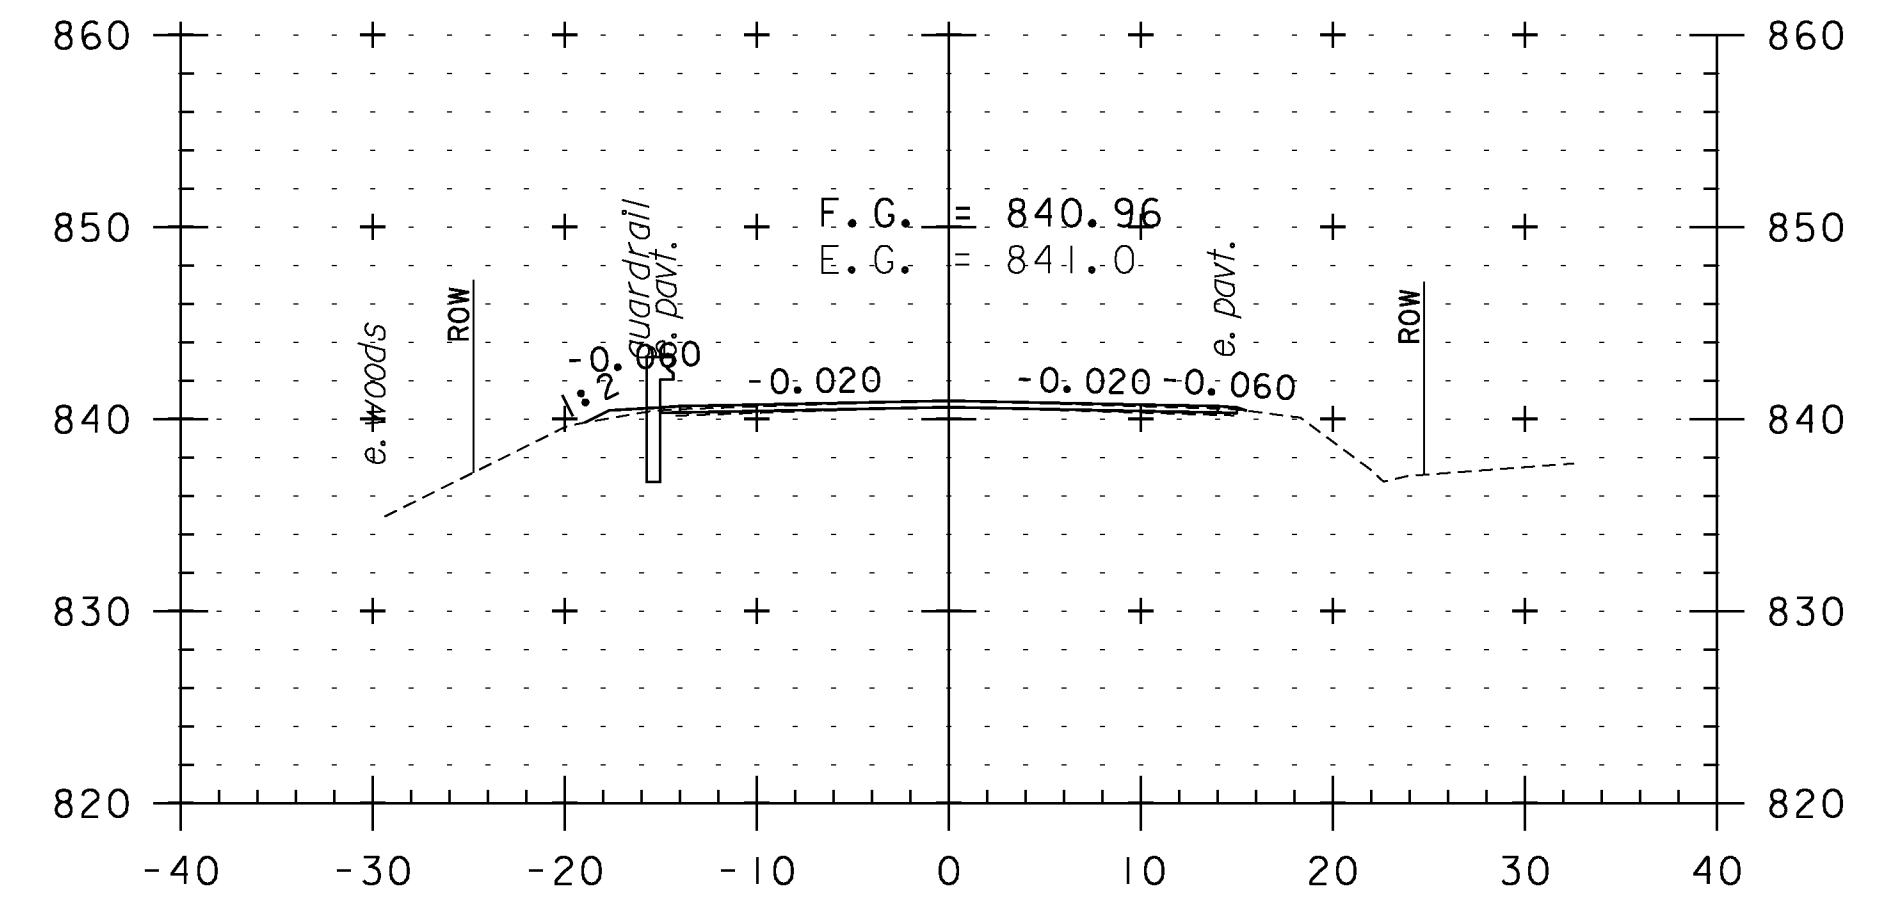


212+00

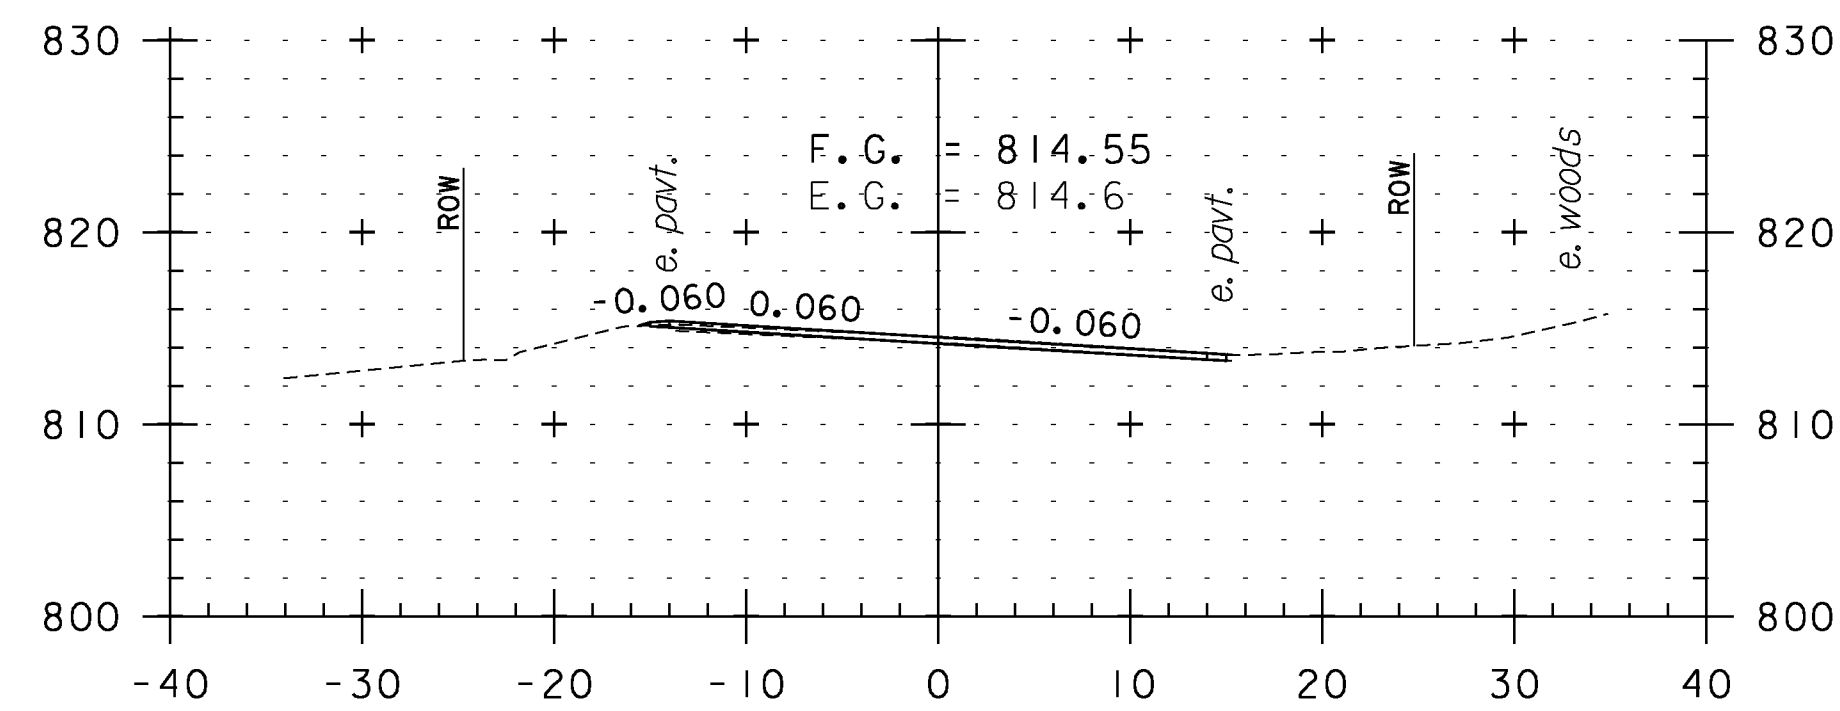


208+50

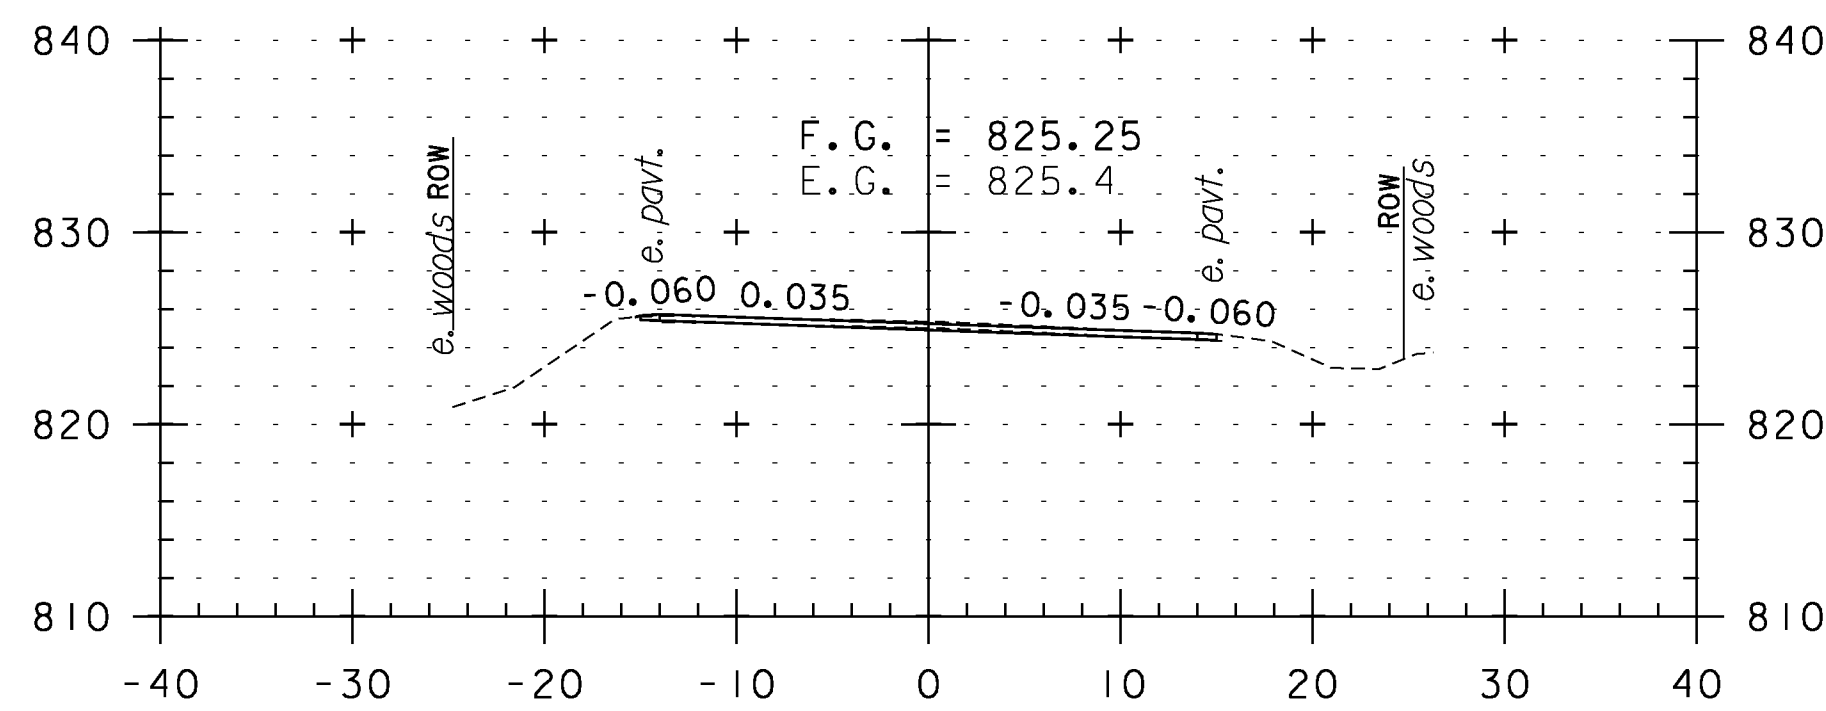


210+00

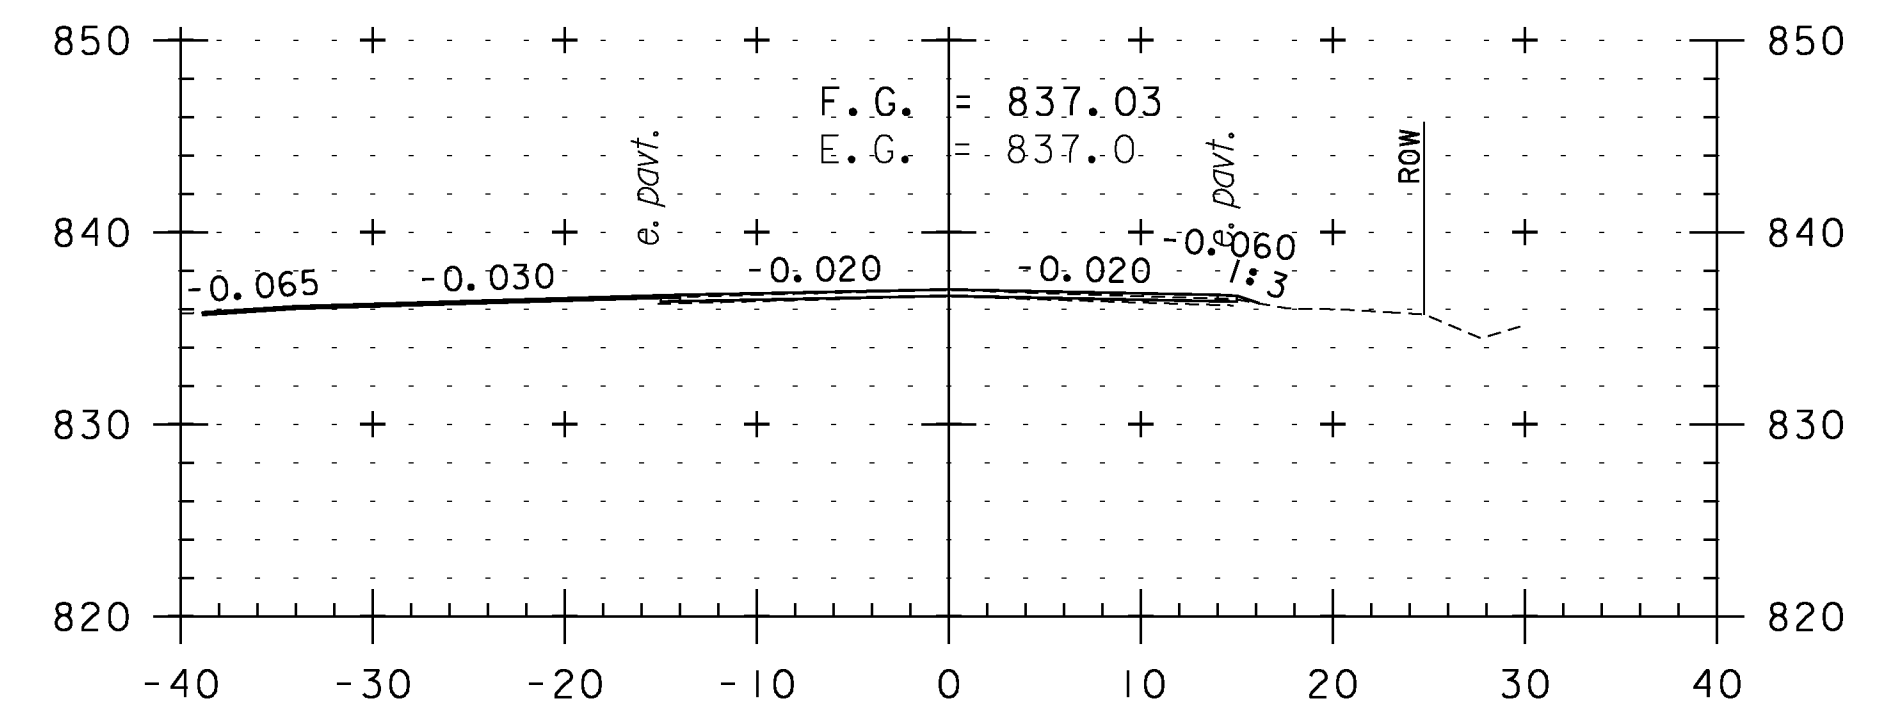


211+50  
TH 7

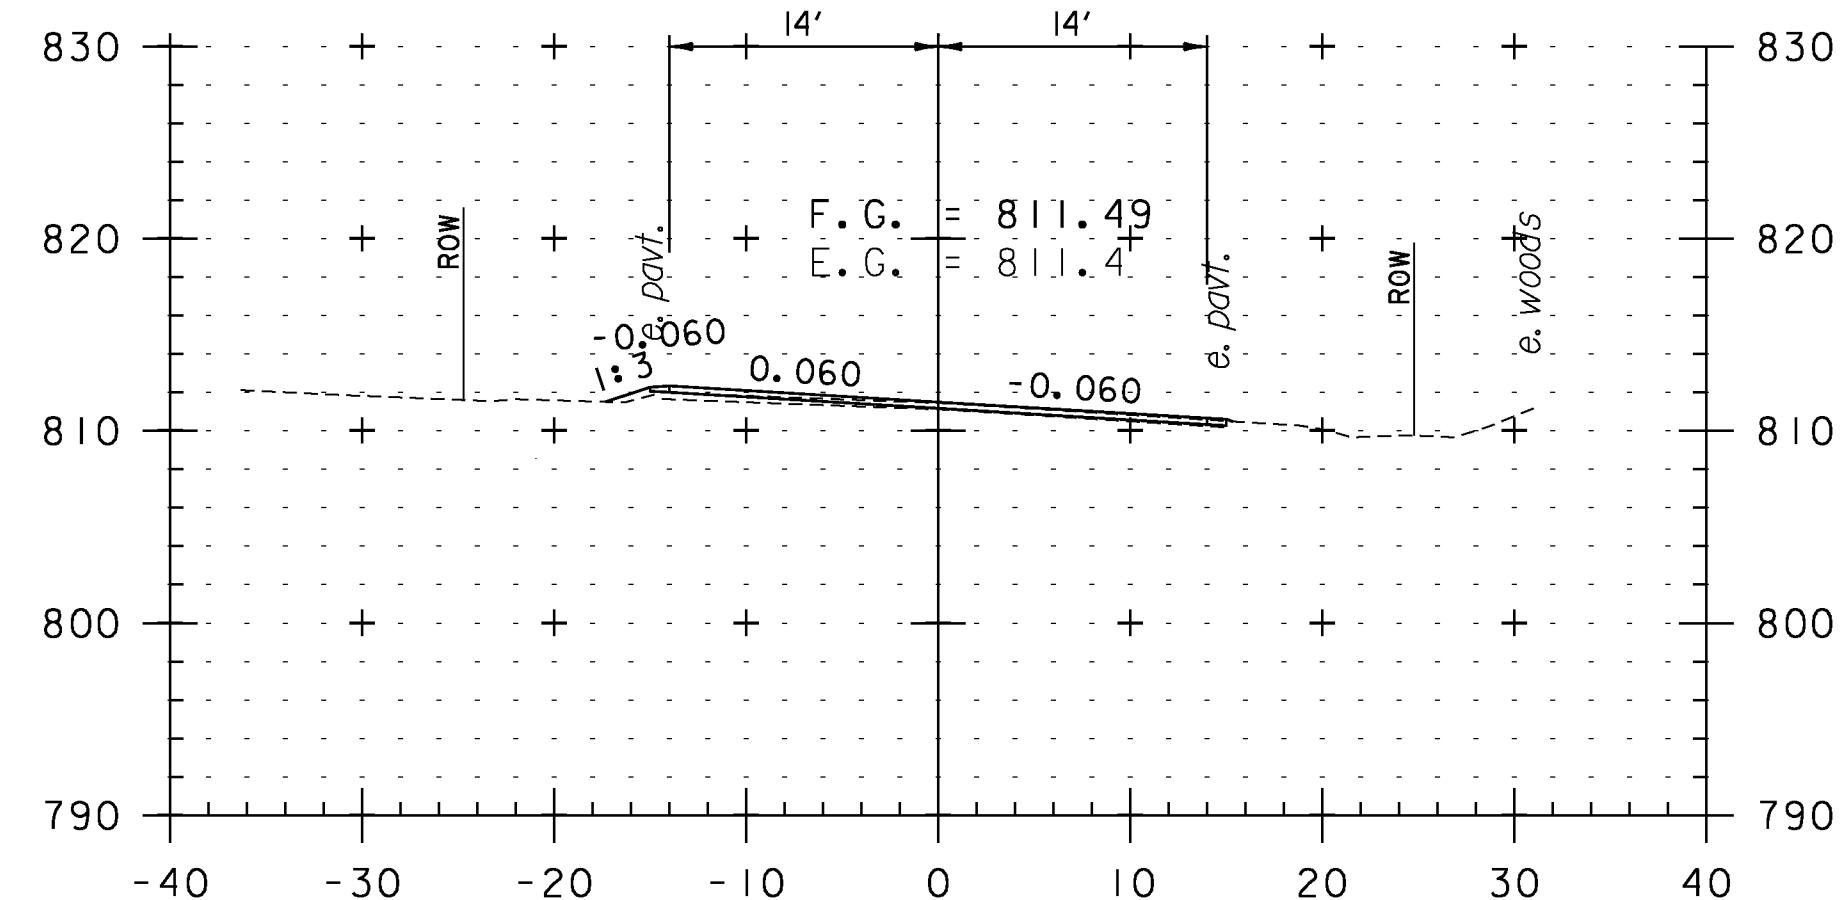

208+00

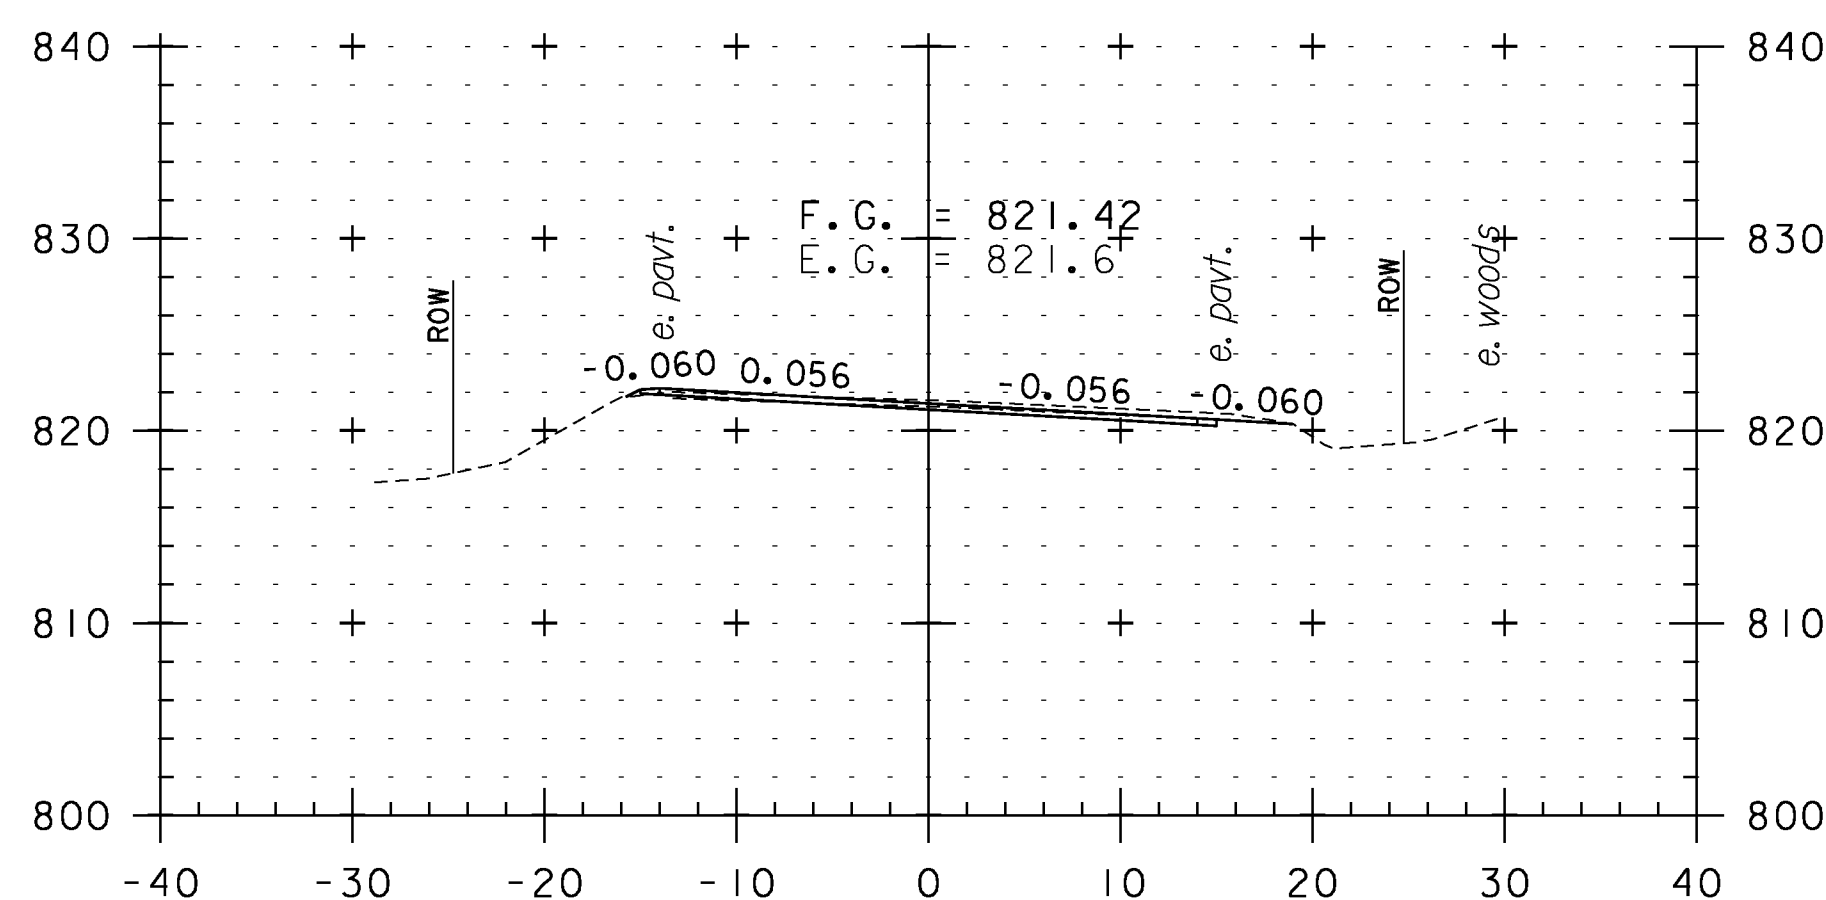


209+50

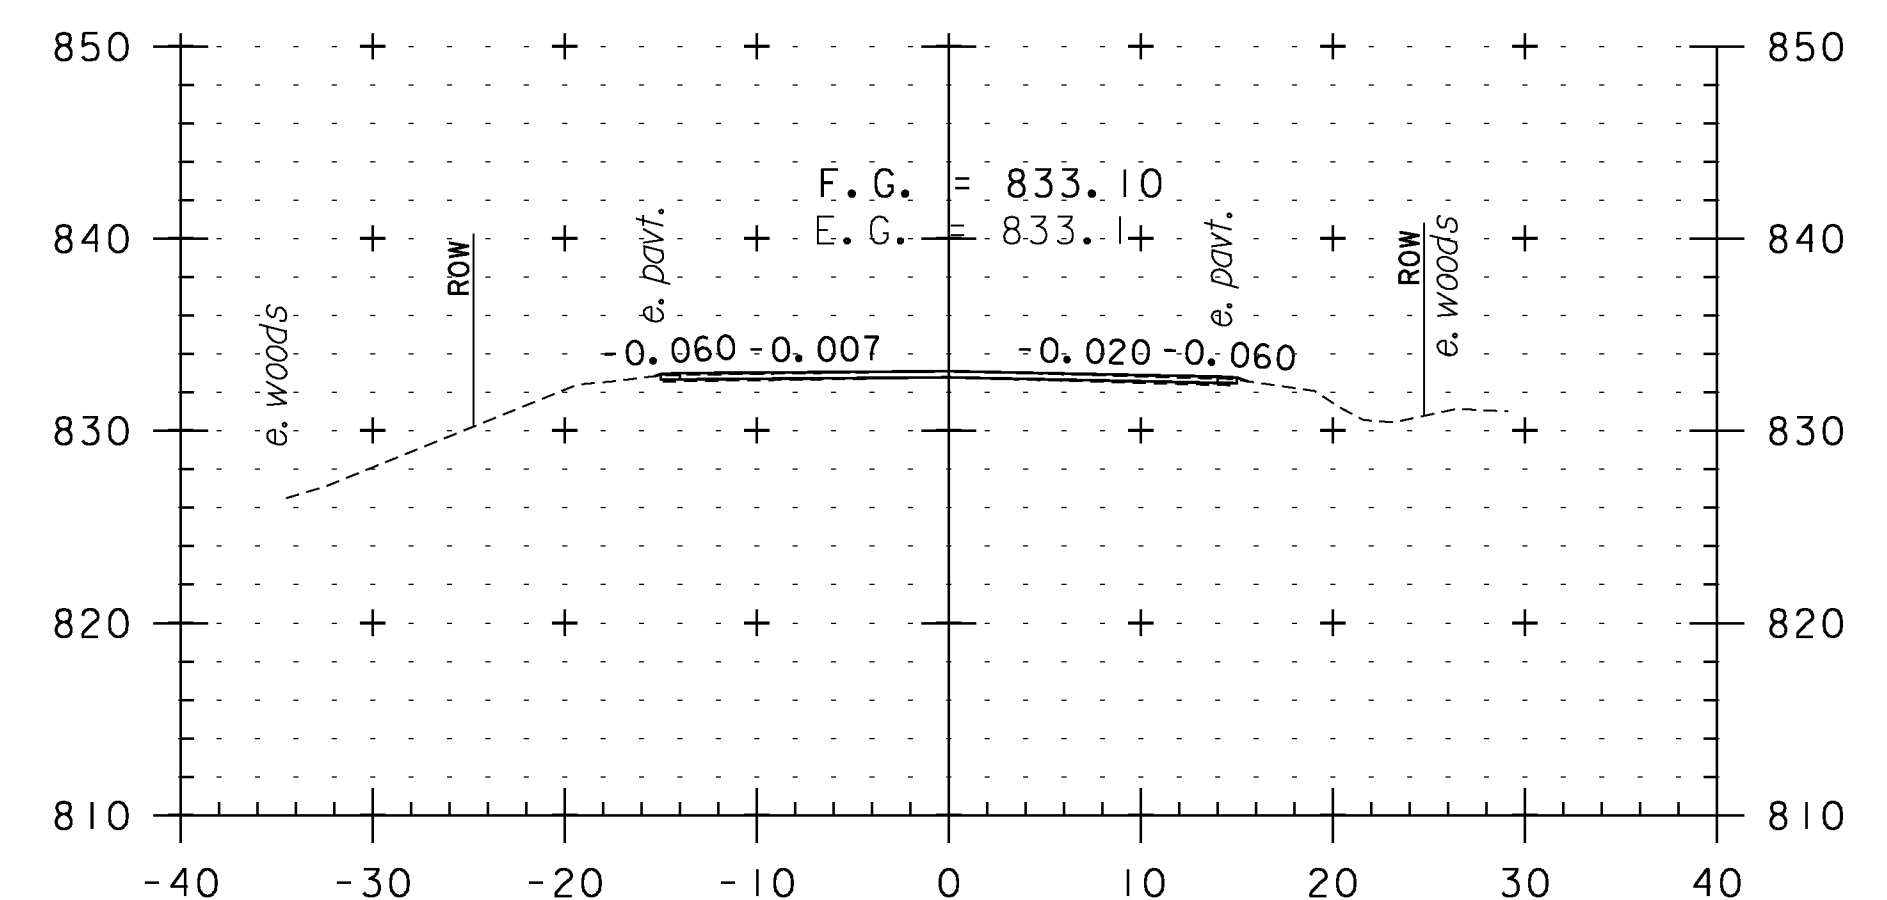

211+00

**CROSS SECTION SHEET 34**

PROJECT NAME: WEATHERSFIELD	
PROJECT NUMBER: STP 2913(I)	
FILE NAME: I0c228	PLOT DATE: 2/7/2013
PROJECT LEADER: PTS	DRAWN BY: WWG
DESIGNED BY: NLL	CHECKED BY: PTS
IPARM FILE NAME: pI0c228_I24	SHEET I24 OF 234

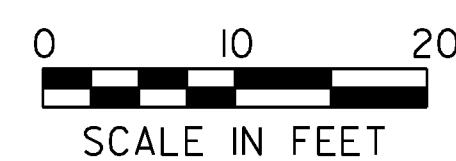

STA. 208+00 TO STA. 212+00