




213+00

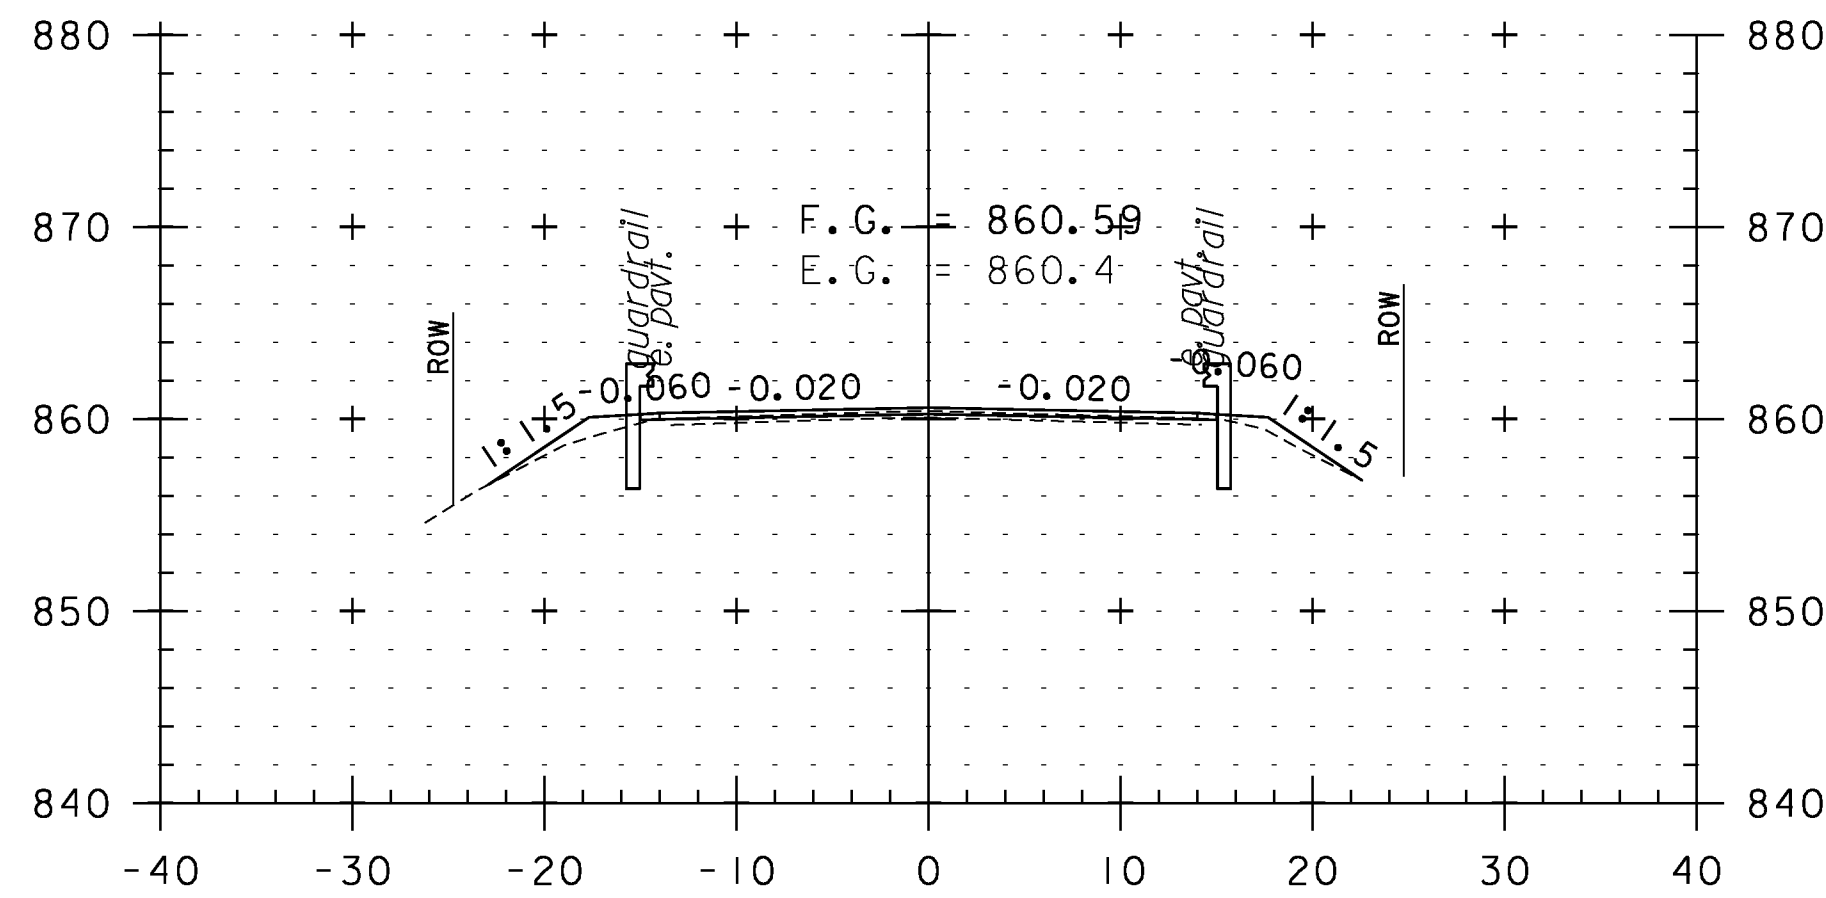


214+50

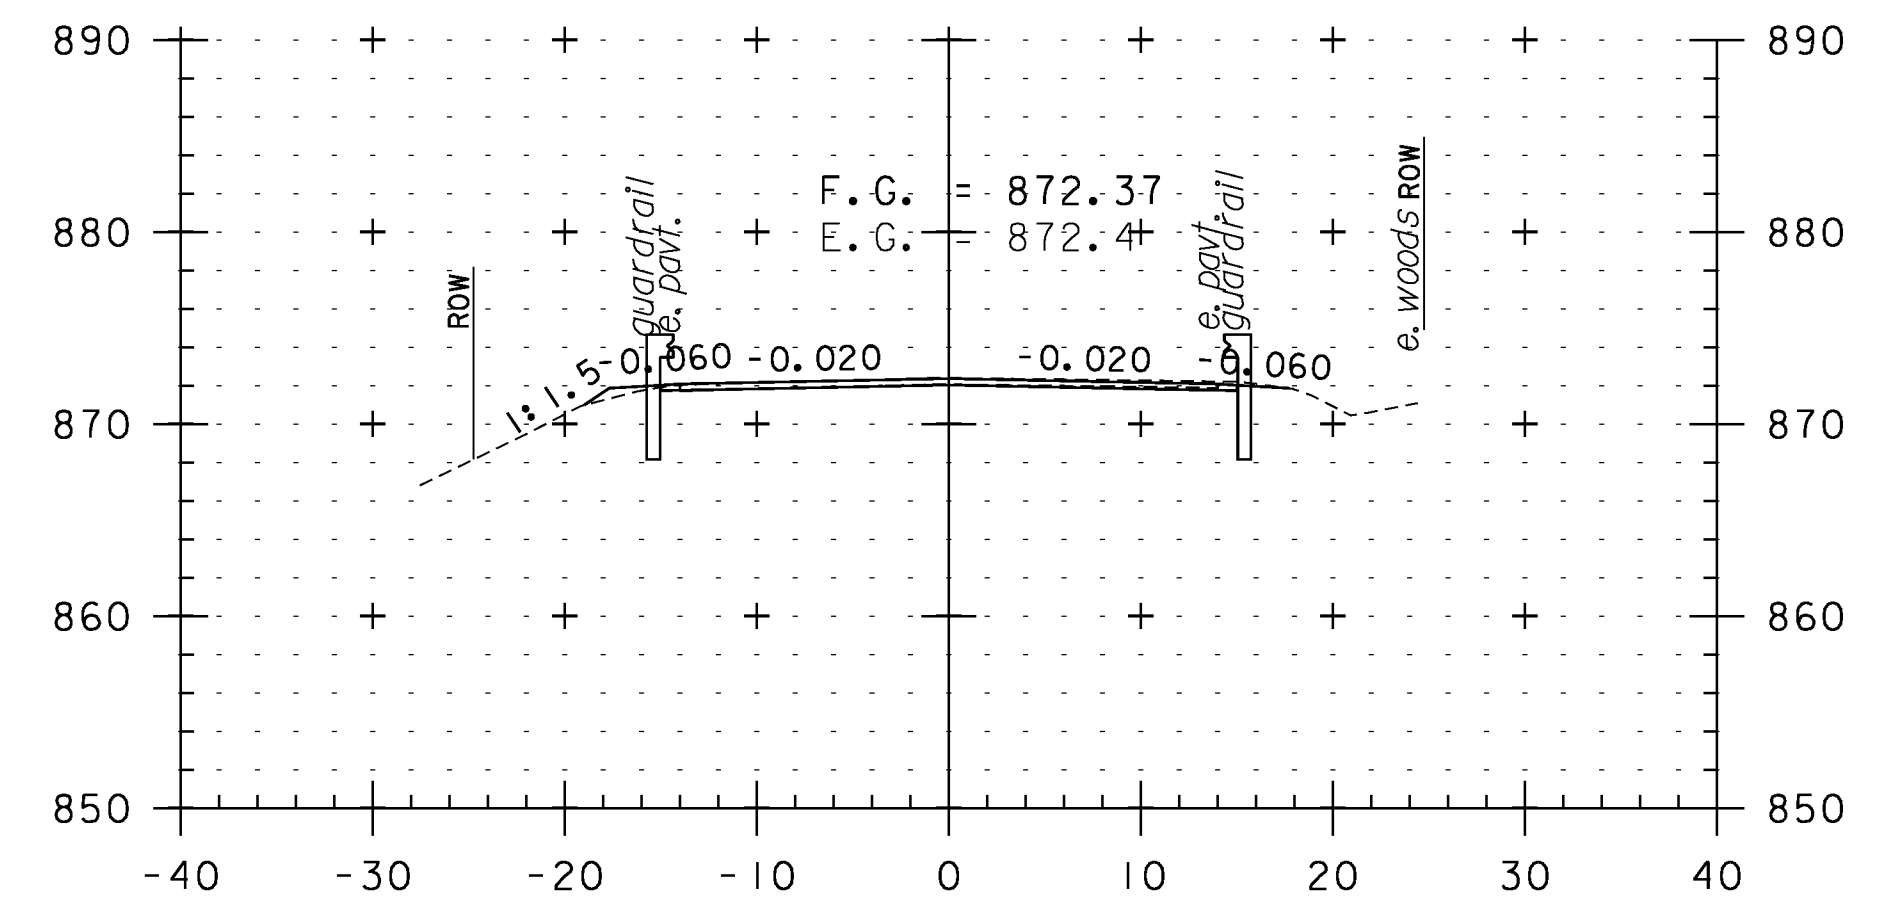


216+00

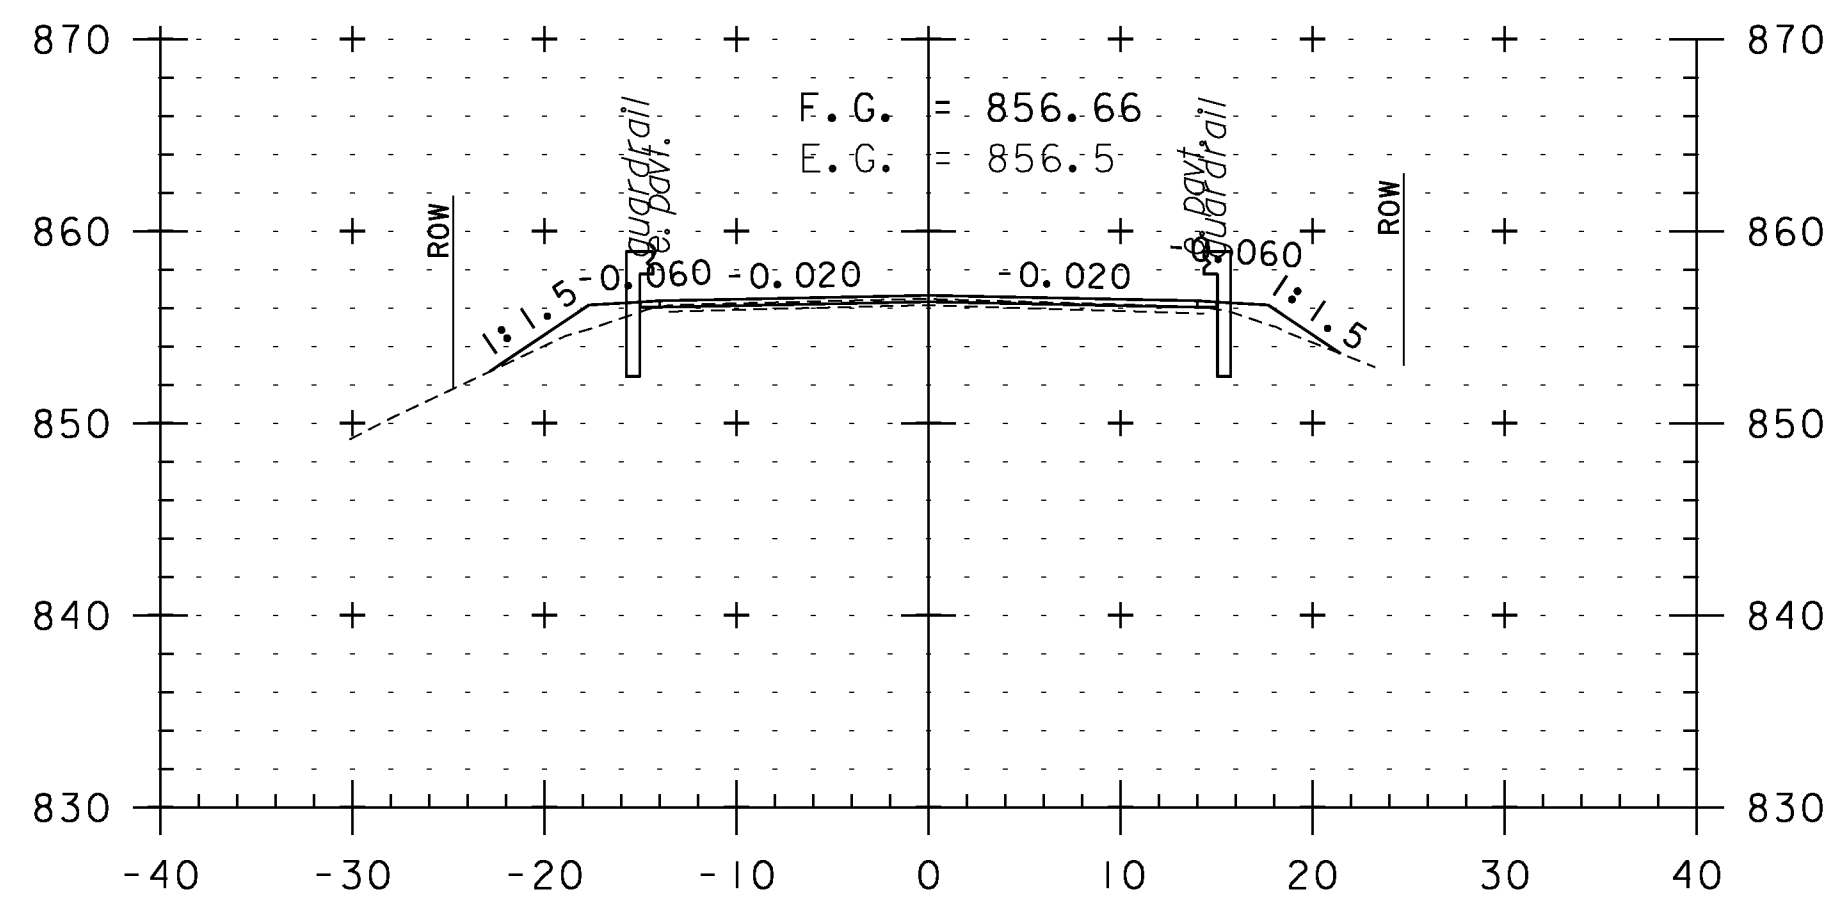


214+00

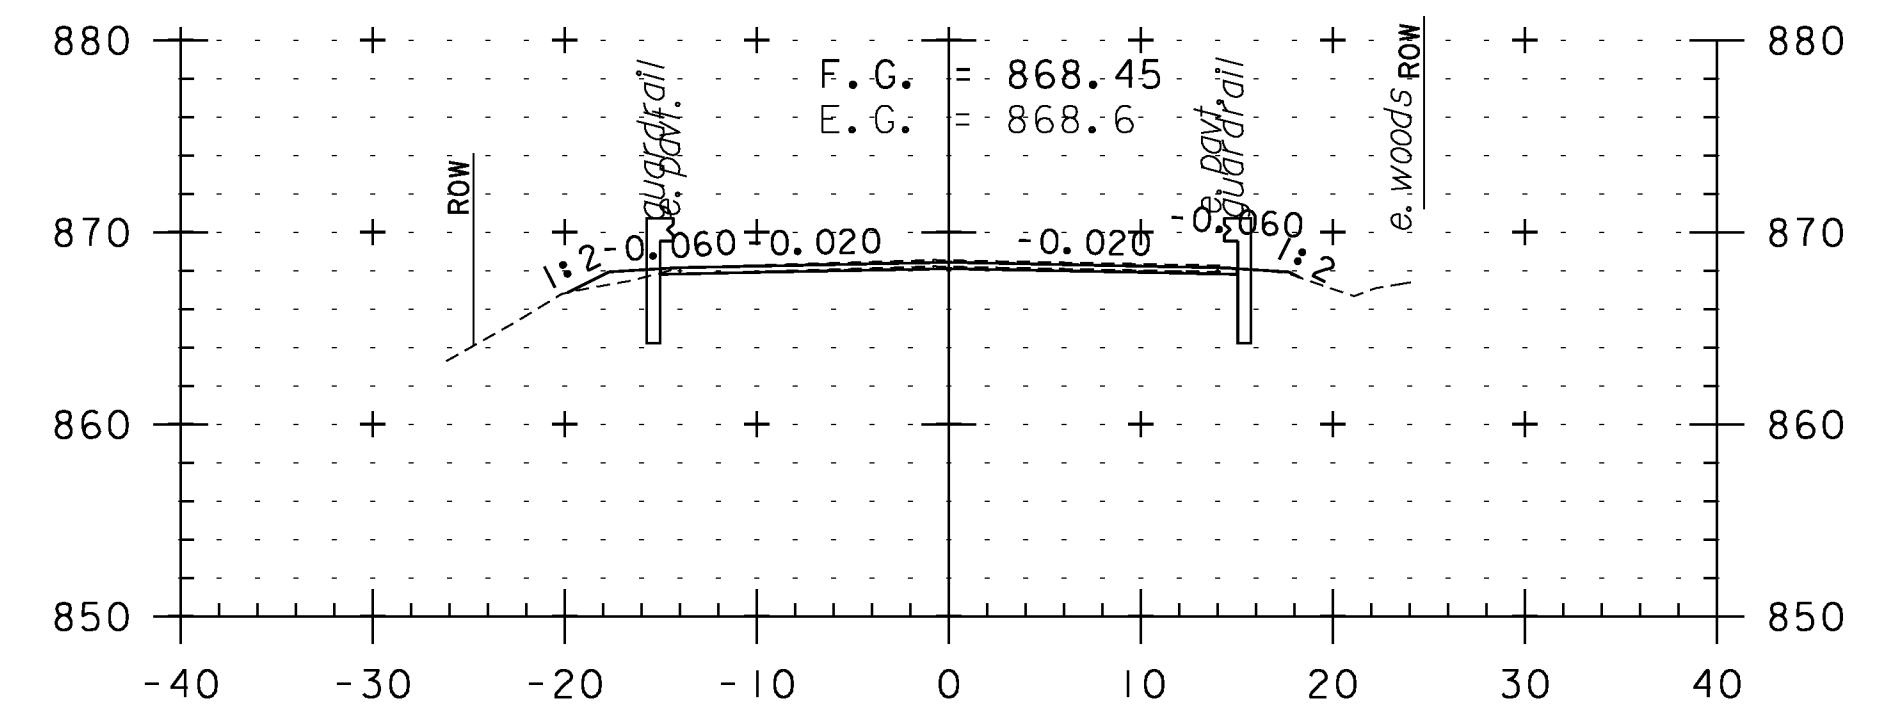


215+50

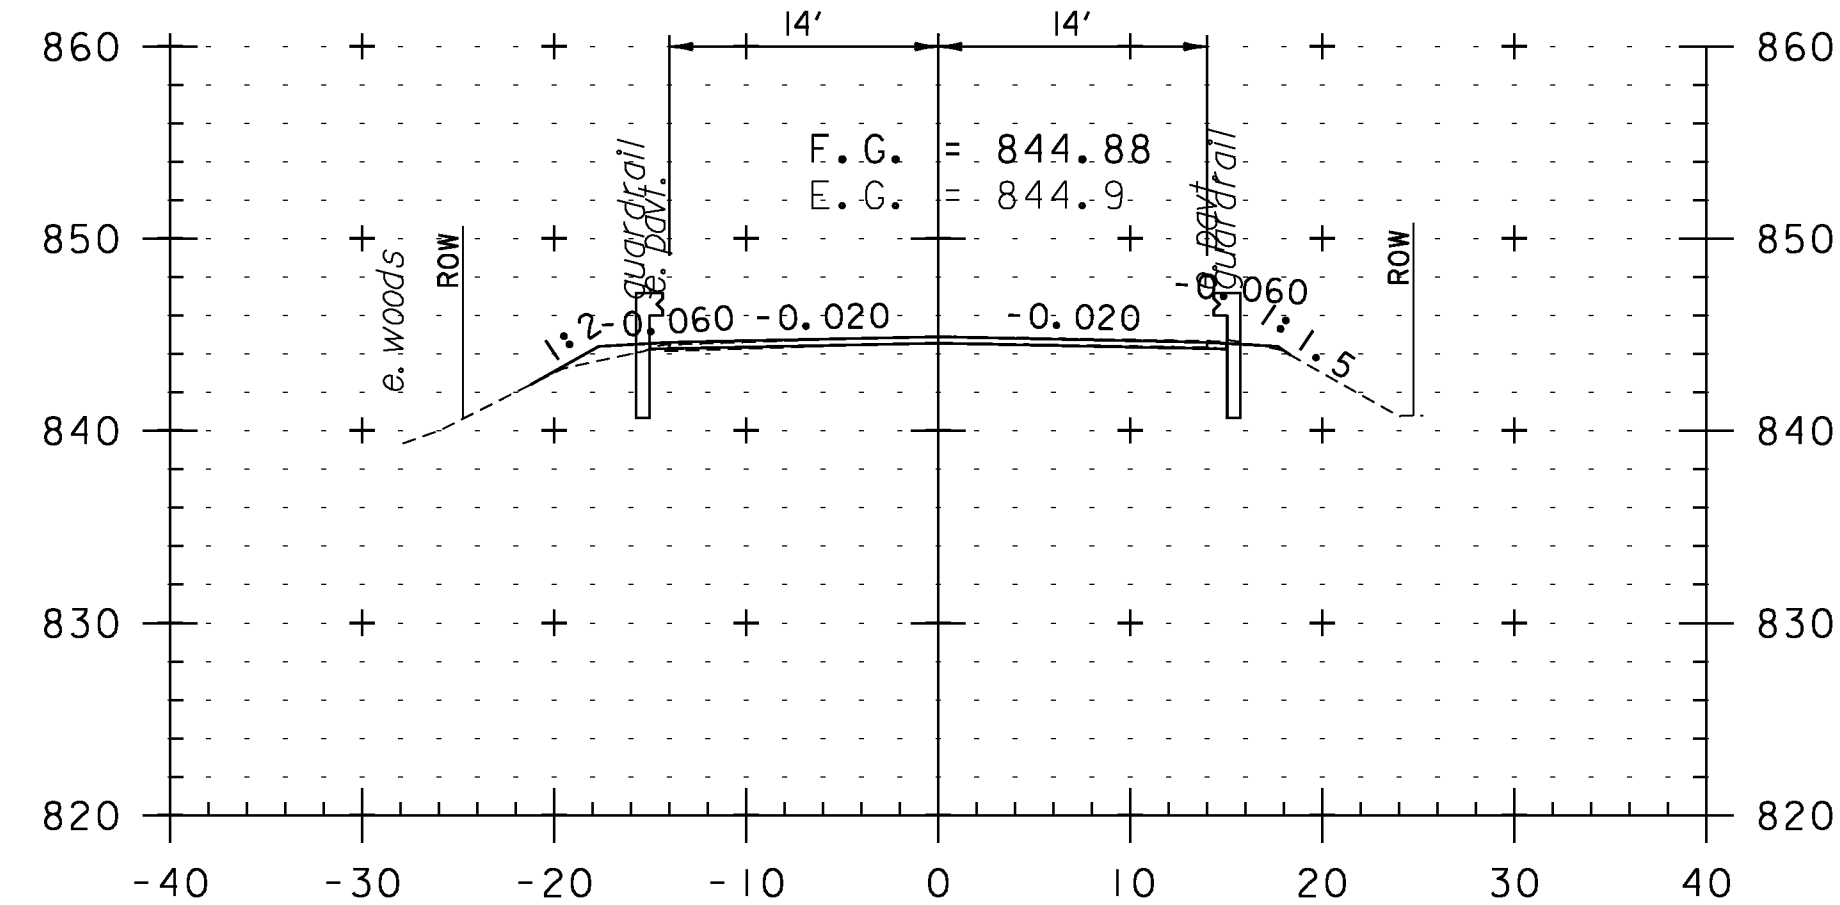

212+50

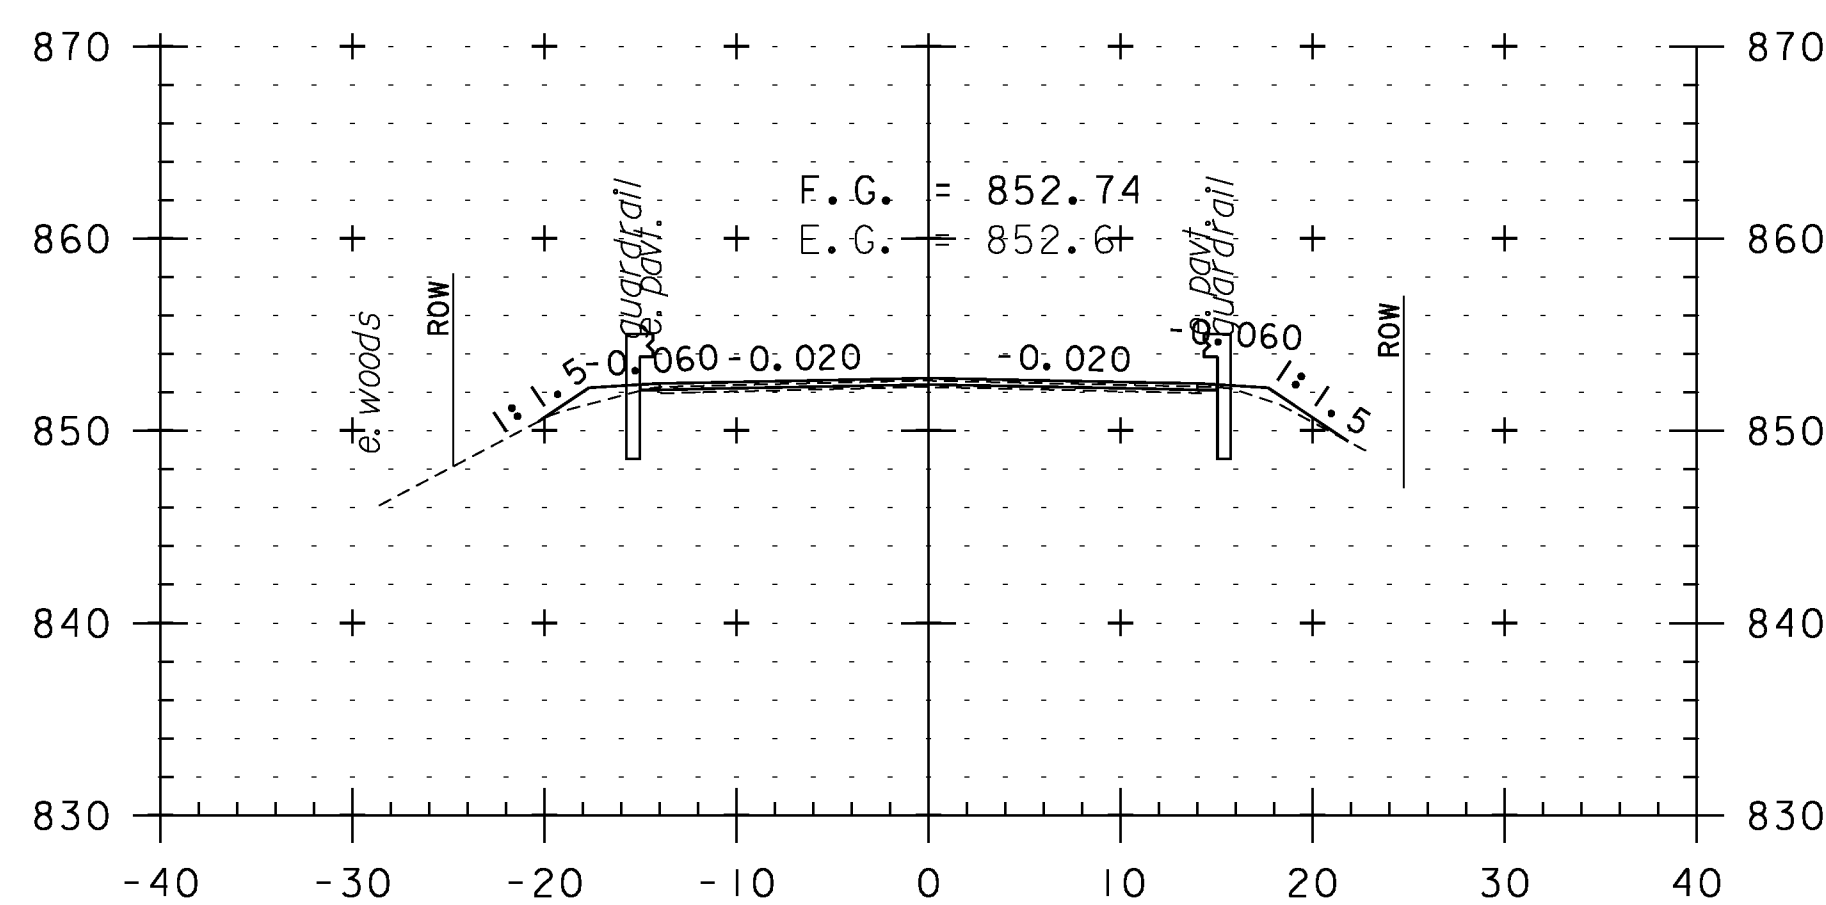

213+50

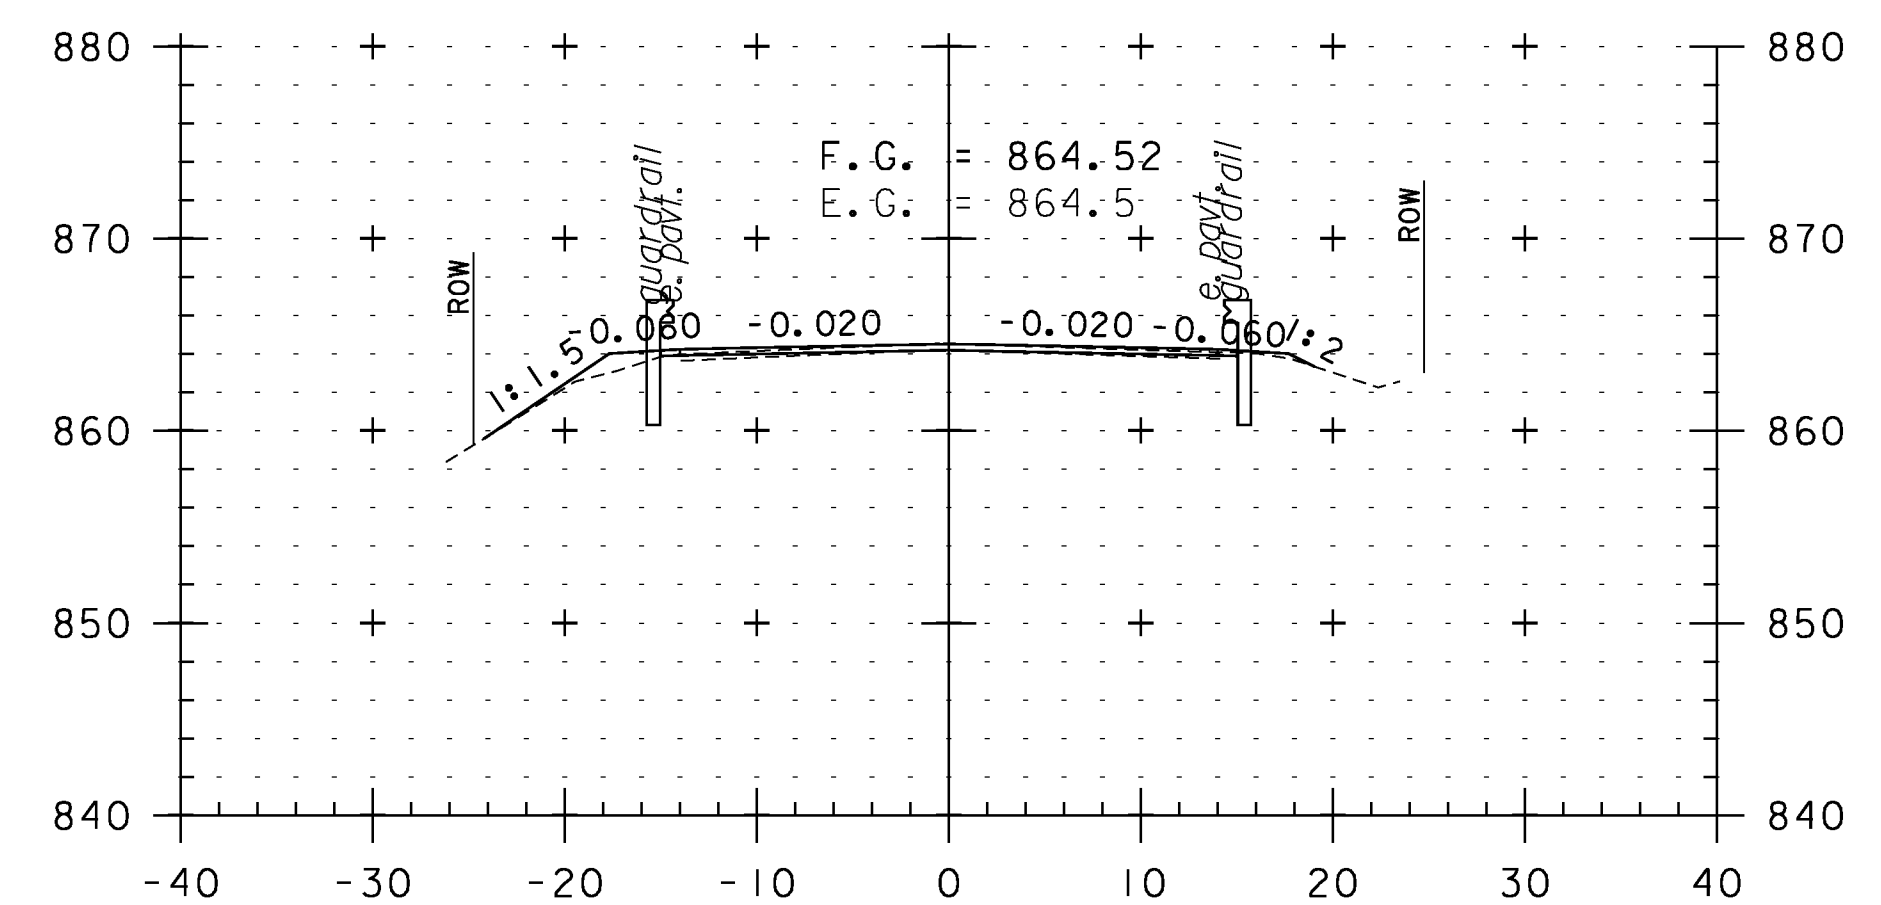

215+00

**CROSS SECTION SHEET 35**

PROJECT NAME: WEATHERSFIELD	PLOT DATE: 2/7/2013
PROJECT NUMBER: STP 2913(I)	DRAWN BY: WWG
FILE NAME: I0c228	CHECKED BY: PTS
PROJECT LEADER: PTS	SHEET 125 OF 234
DESIGNED BY: NLL	
IPARM FILE NAME: pI0c228_125	



STA. 212+50 TO STA. 216+00