




217+50

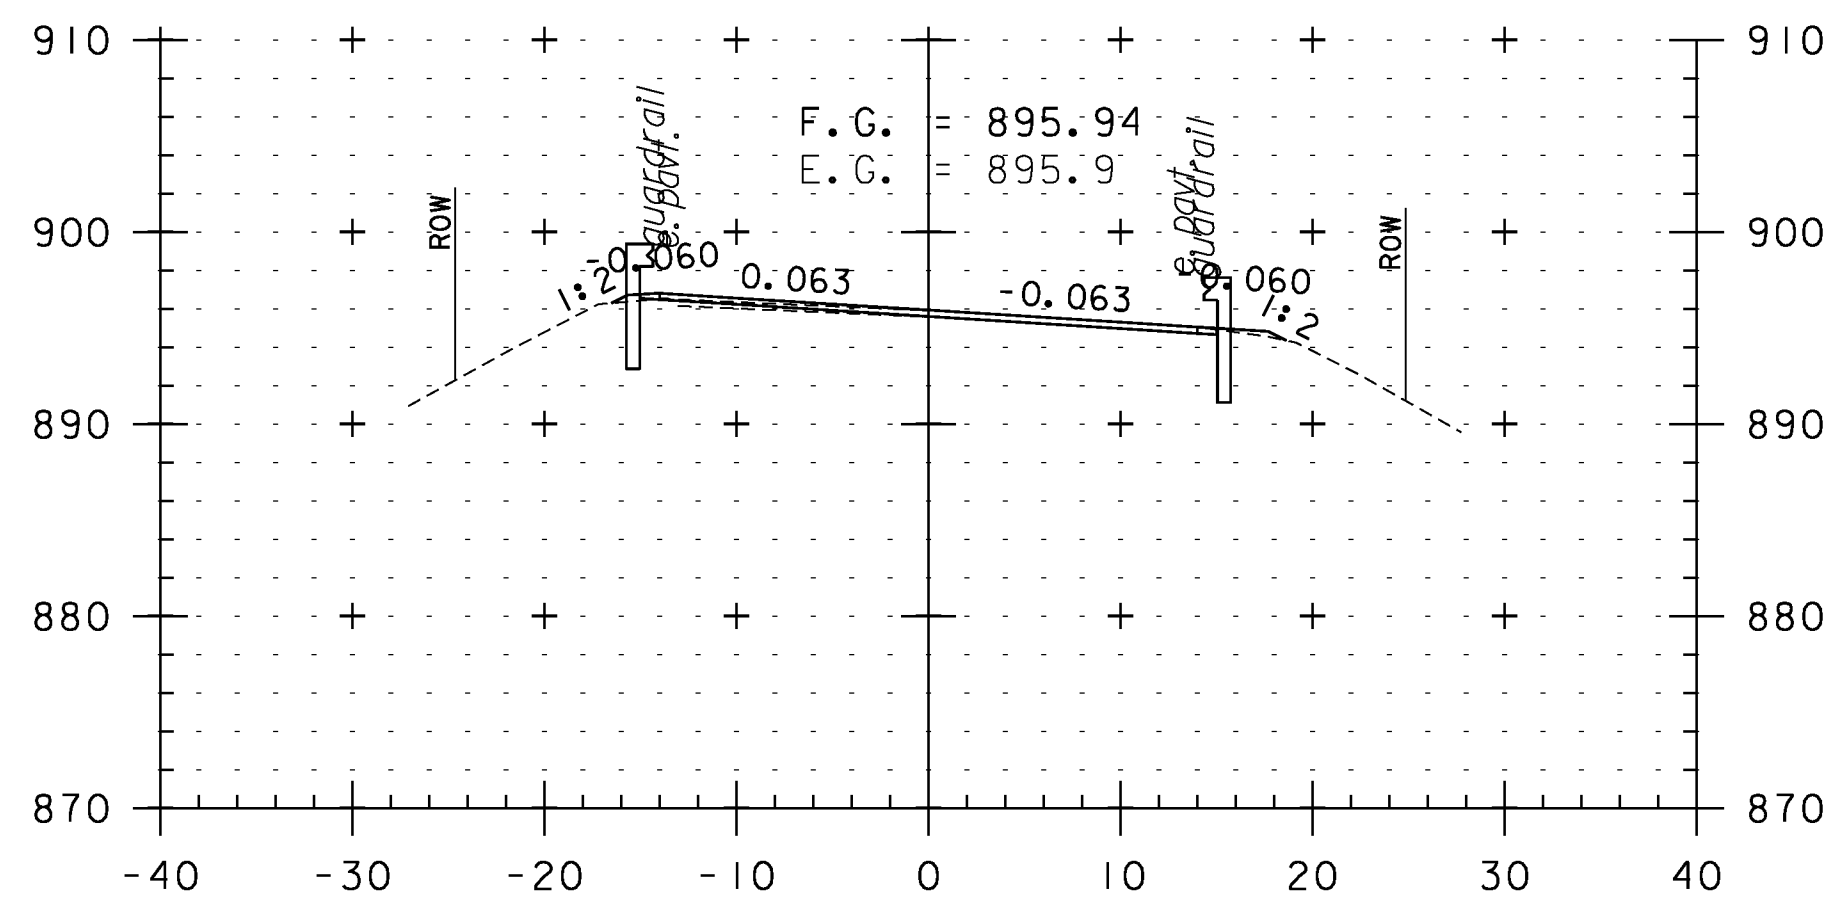


219+00

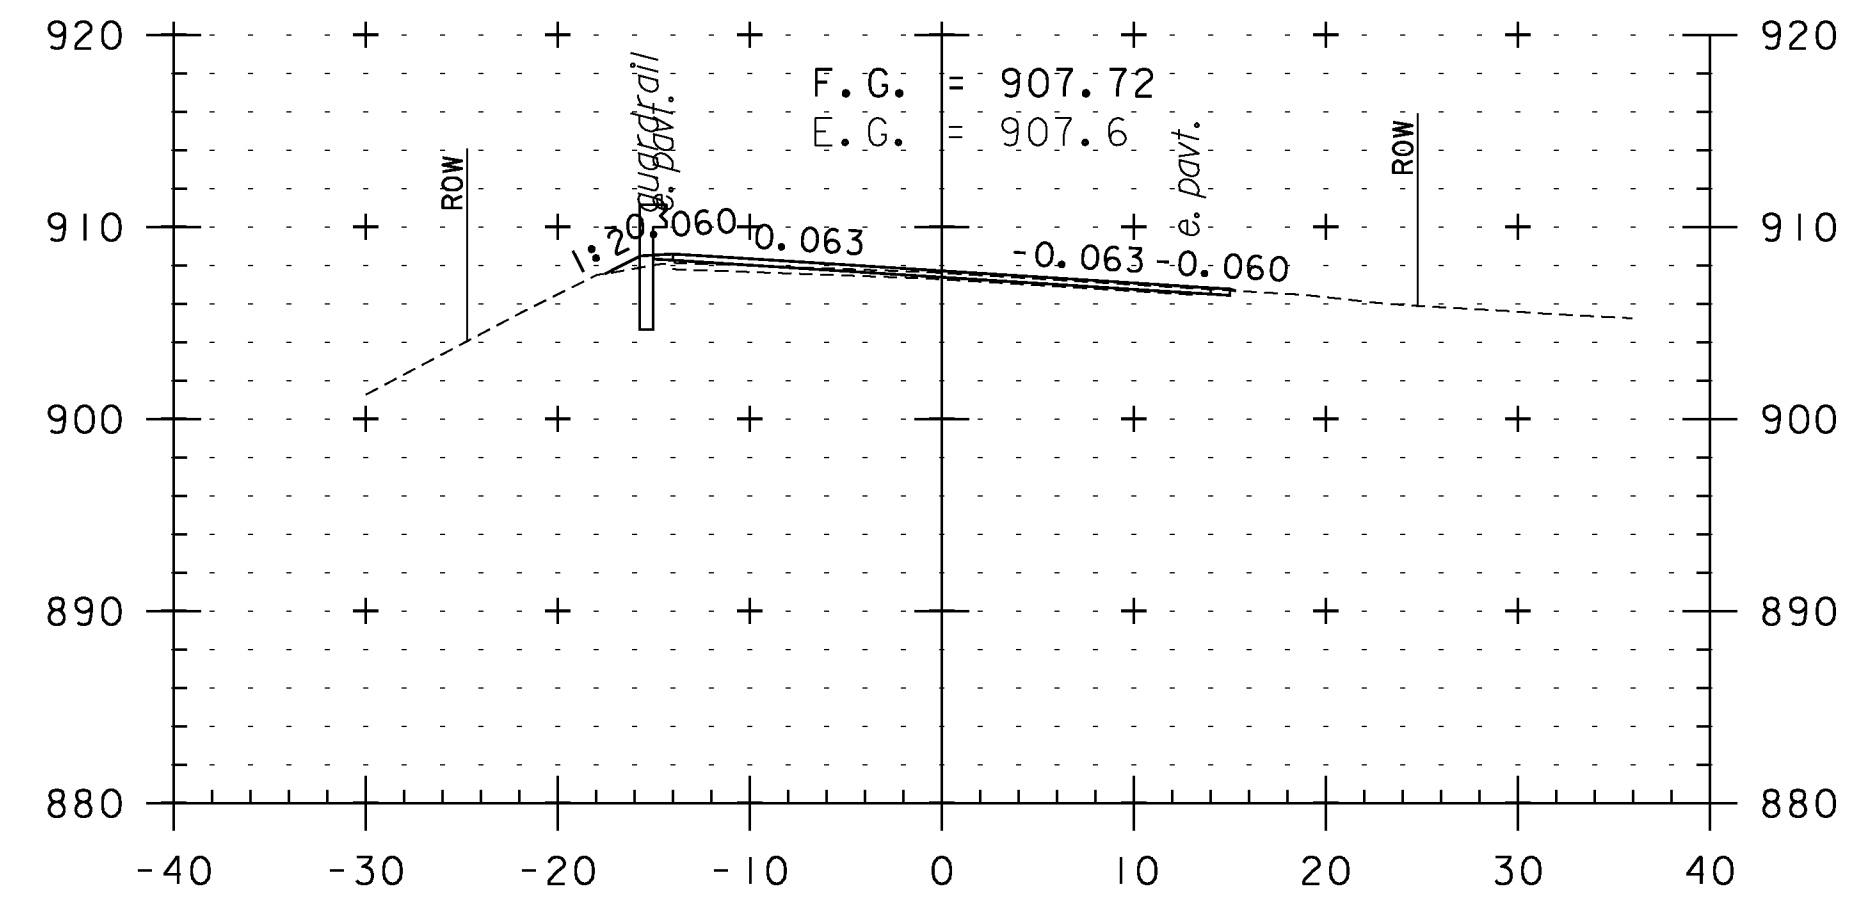


220+50

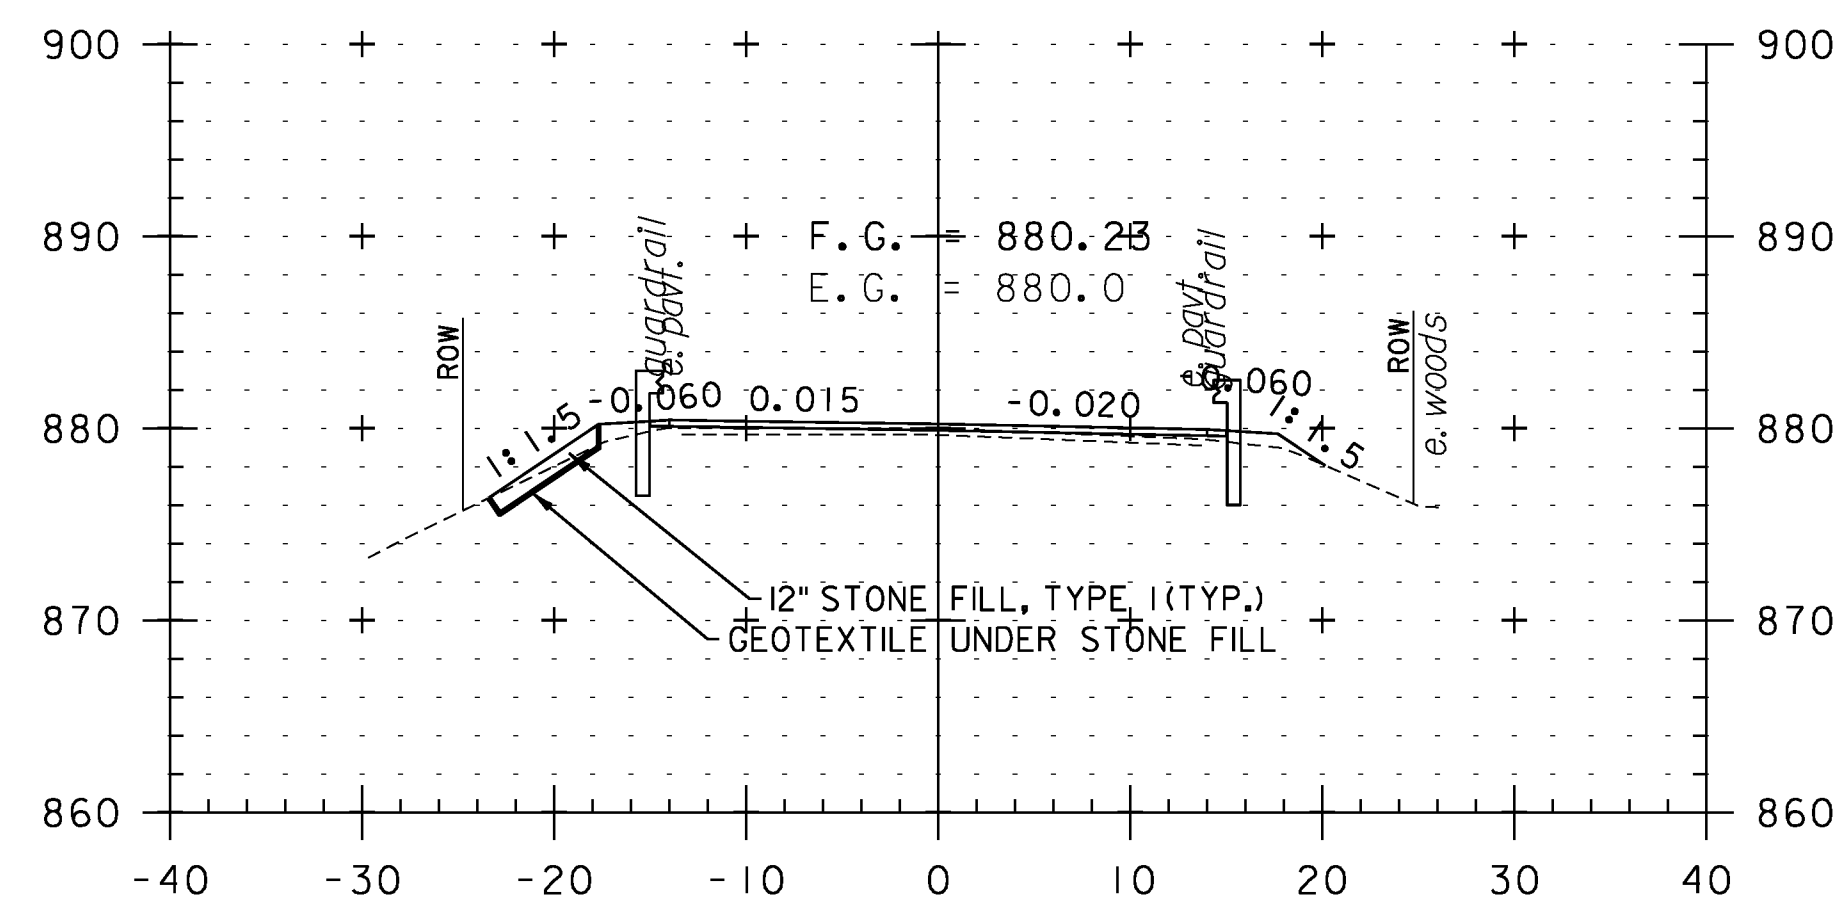


217+00

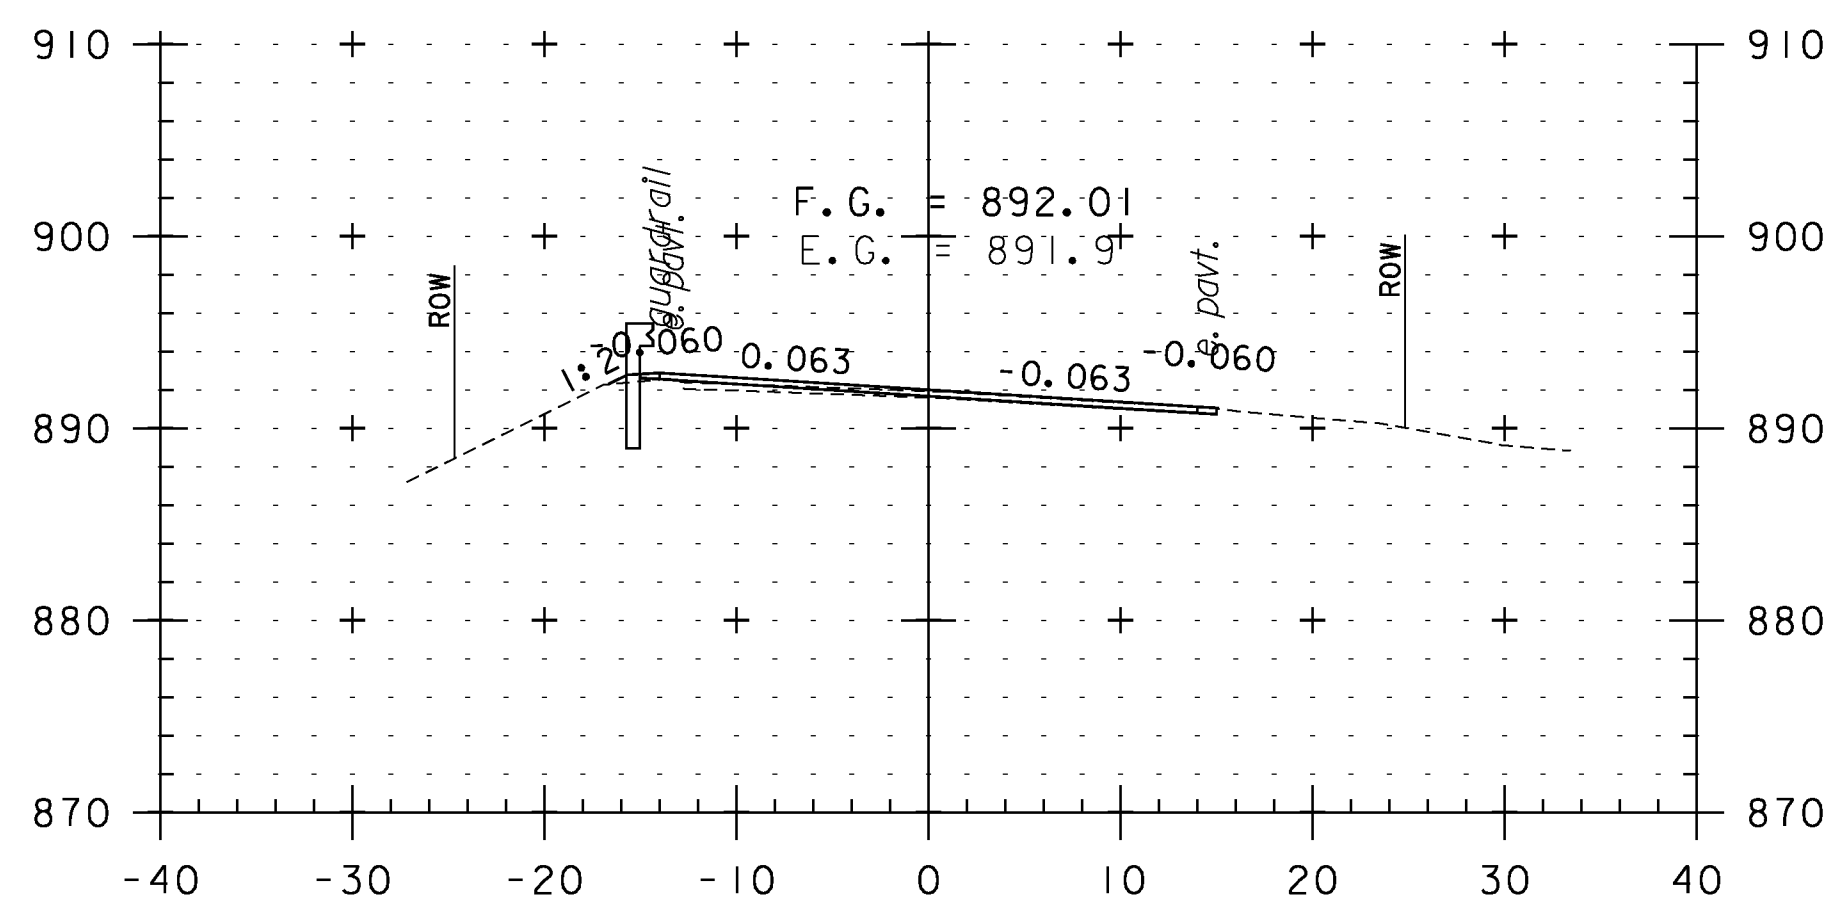


218+50

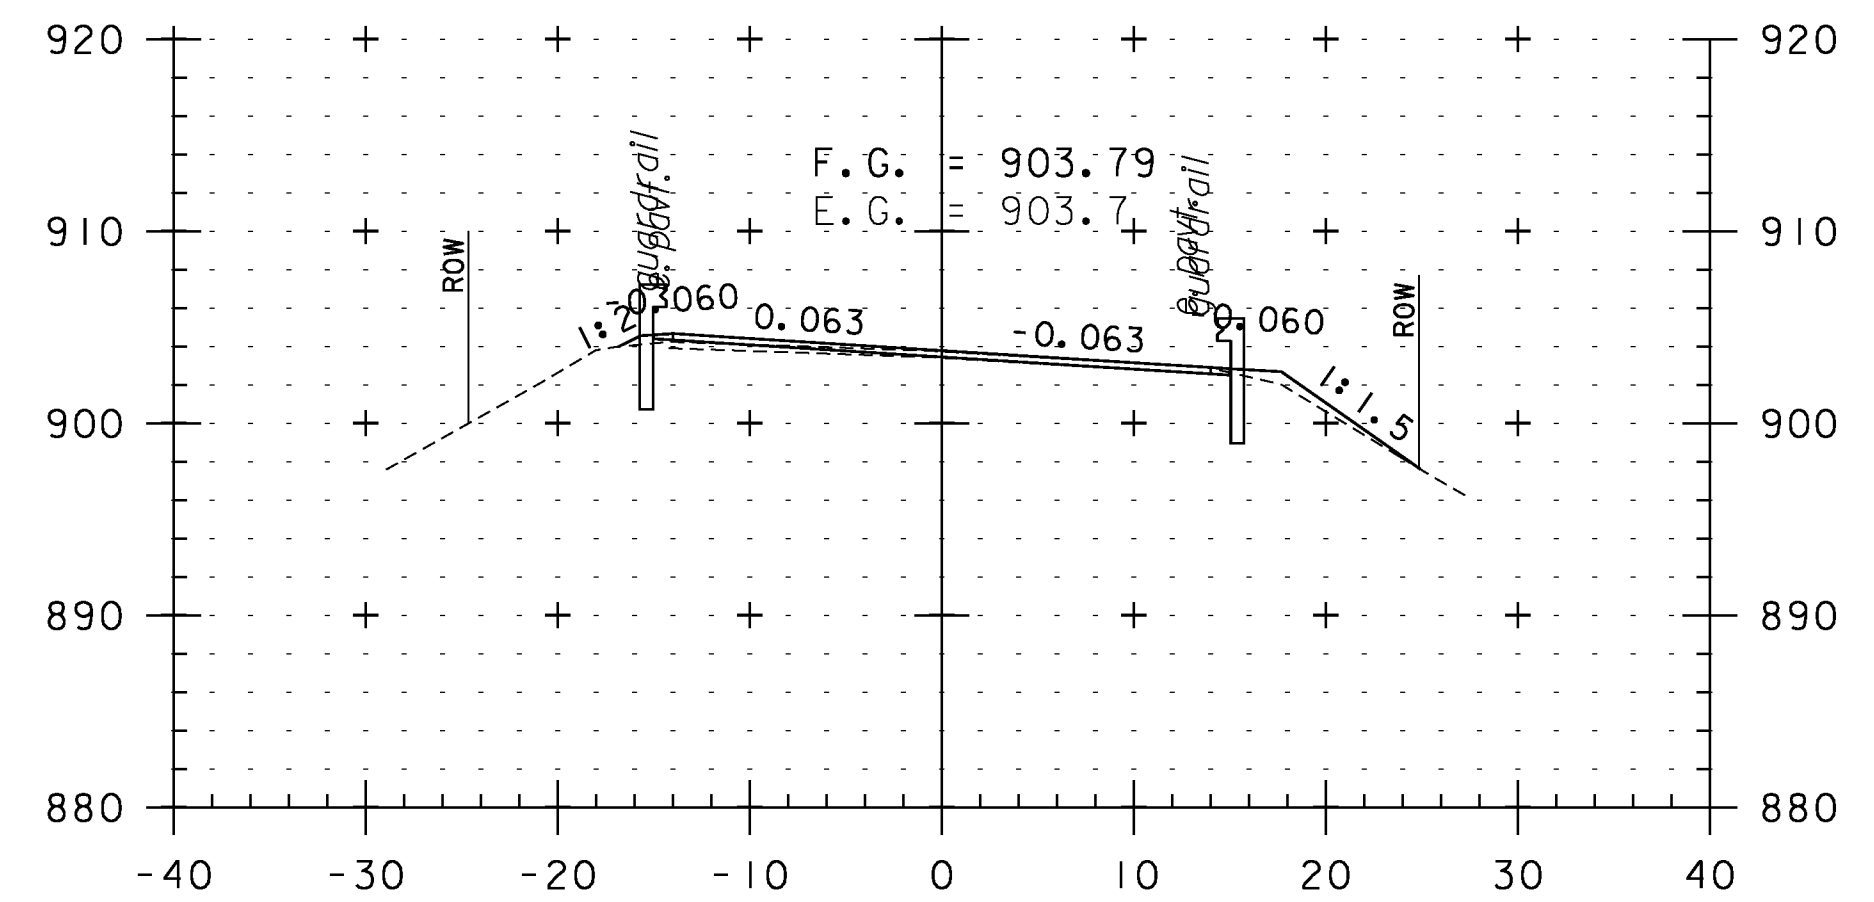


220+00

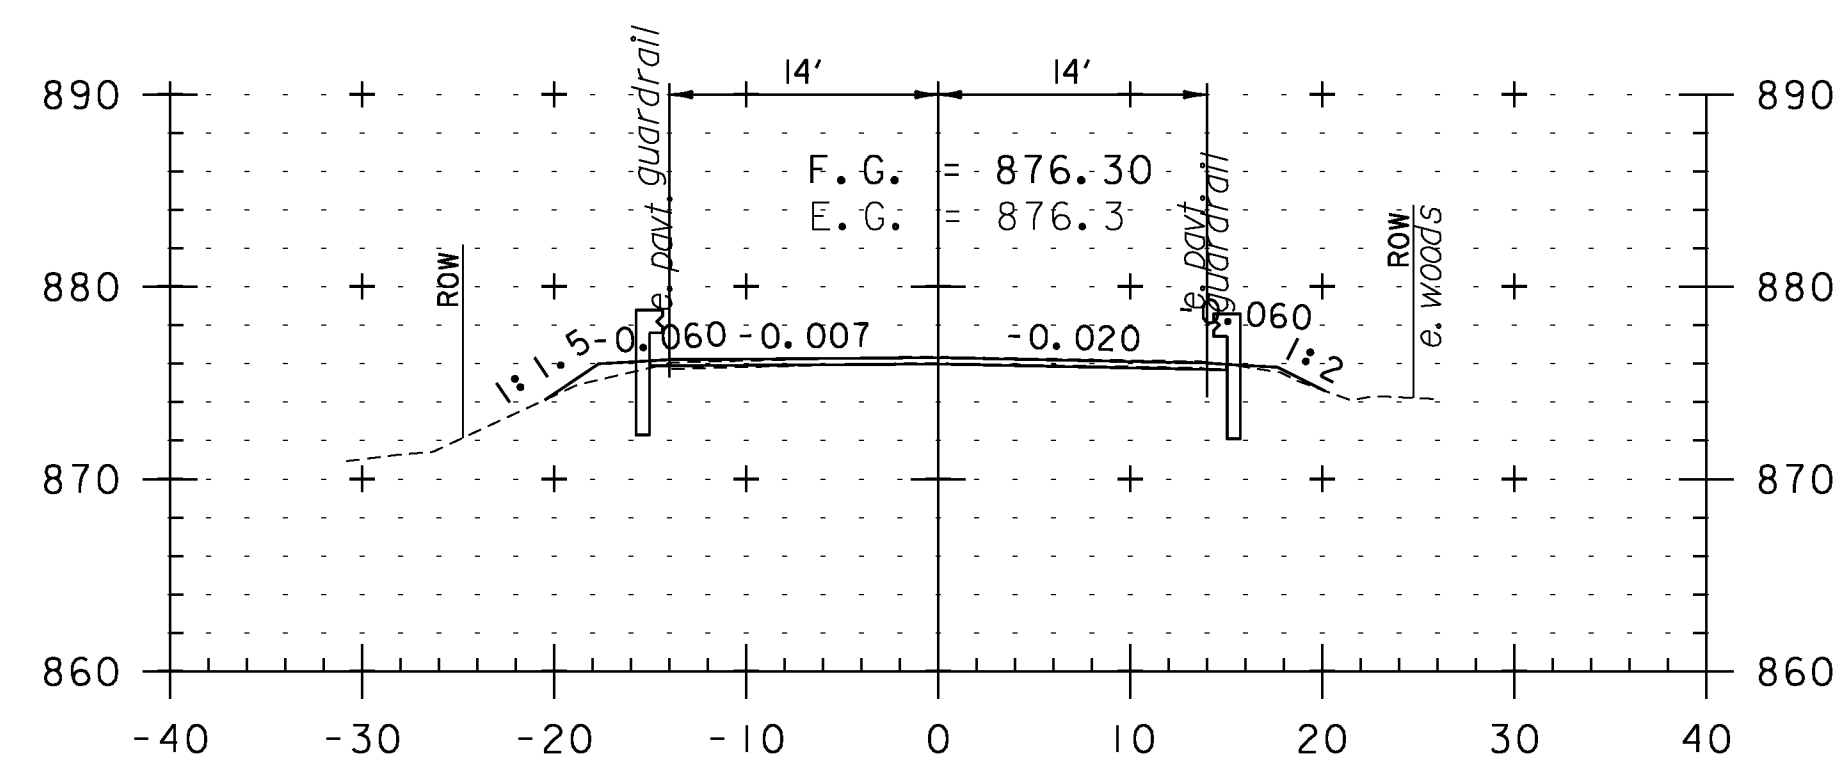

216+50

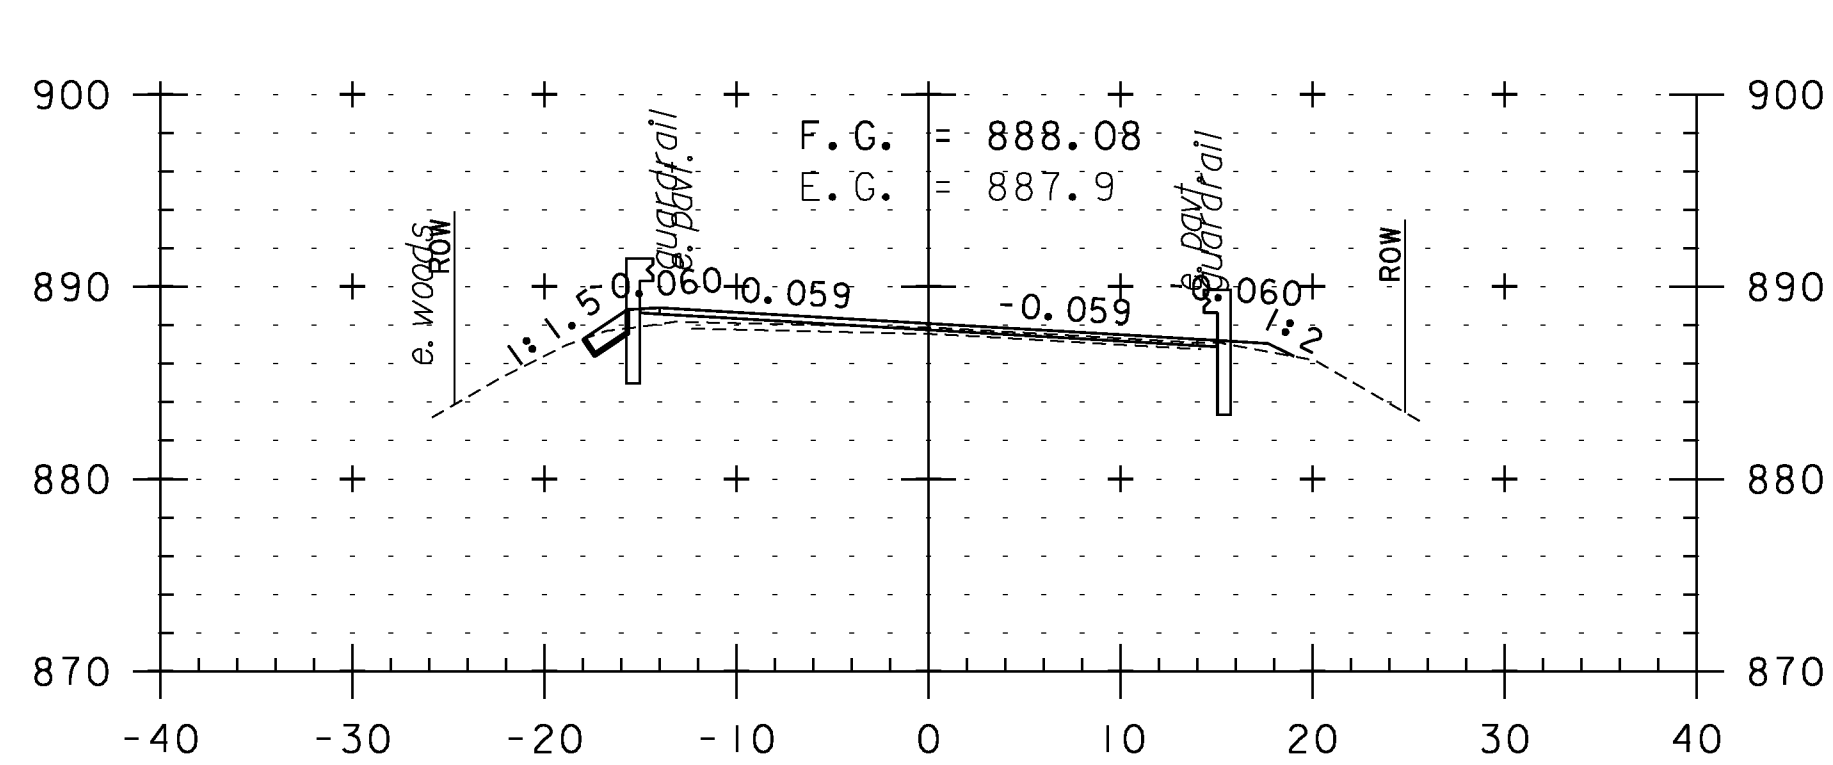


218+00

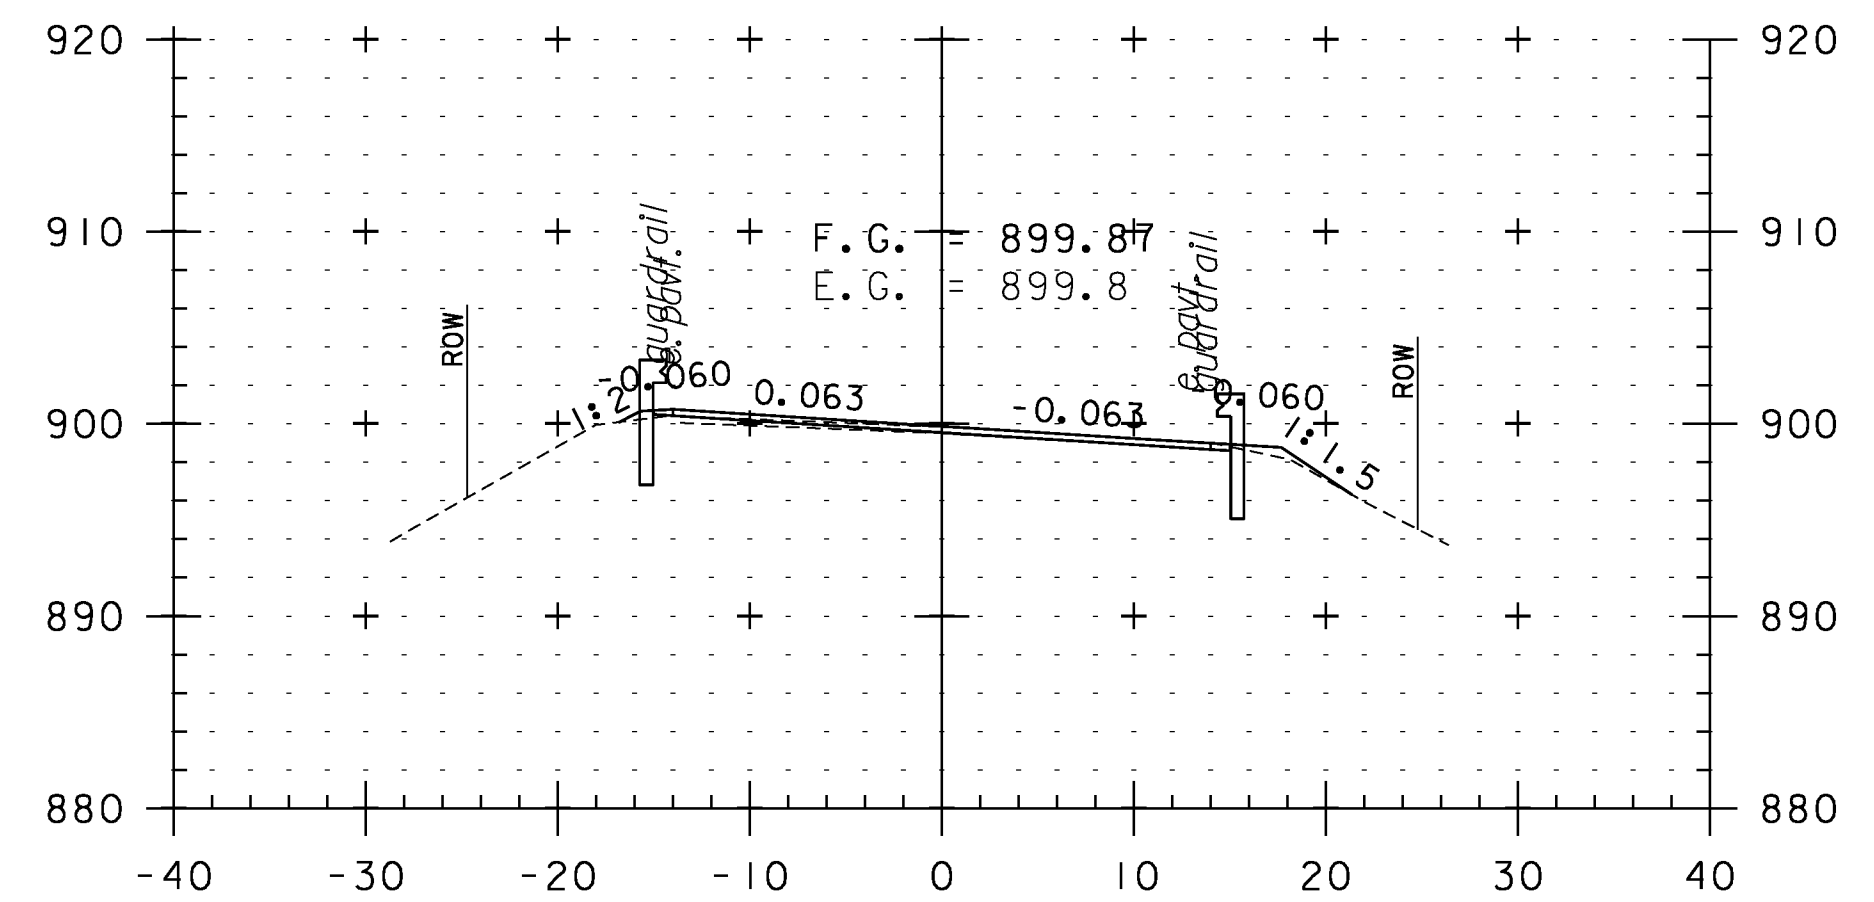

219+50

CROSS SECTION SHEET 36

PROJECT NAME: WEATHERSFIELD	PLOT DATE: 2/7/2013
PROJECT NUMBER: STP 2913(I)	DRAWN BY: WWG
FILE NAME: I0c228	CHECKED BY: PTS
PROJECT LEADER: PTS	SHEET I26 OF 234
DESIGNED BY: NLL	
IPARM FILE NAME: pI0c228_I26	

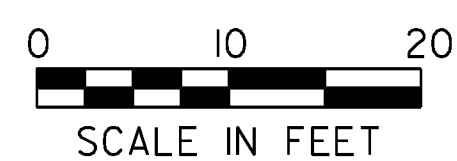

STA. 216+50 TO STA. 220+50