




226+50

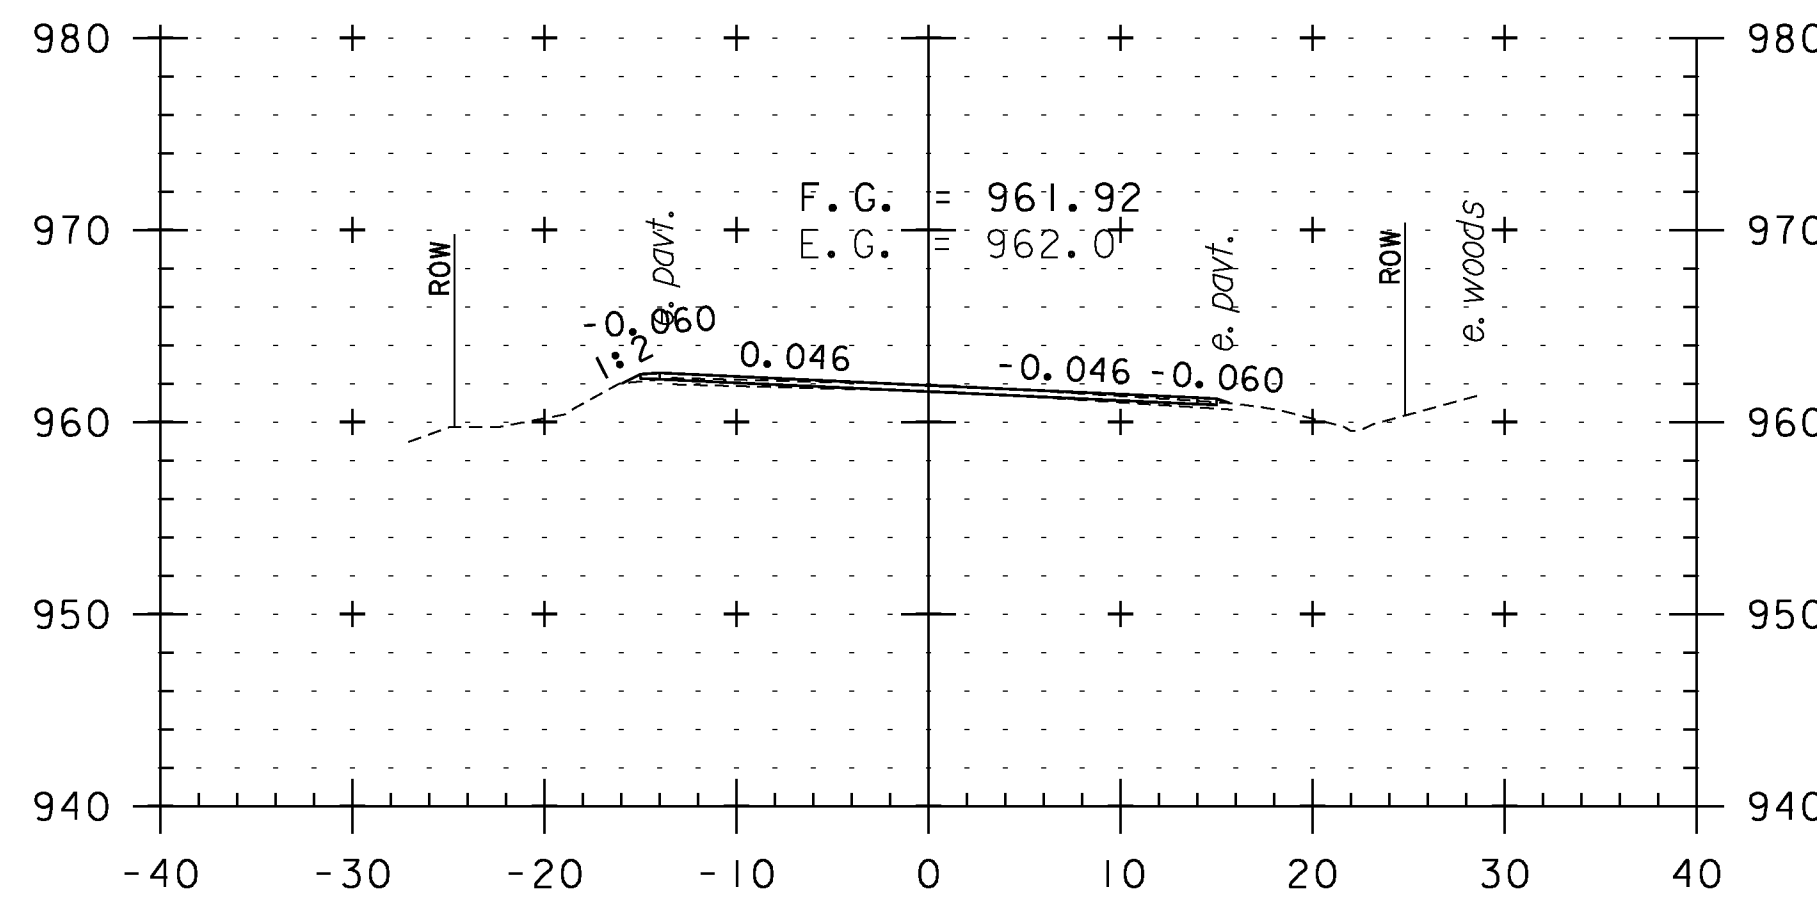


228+00

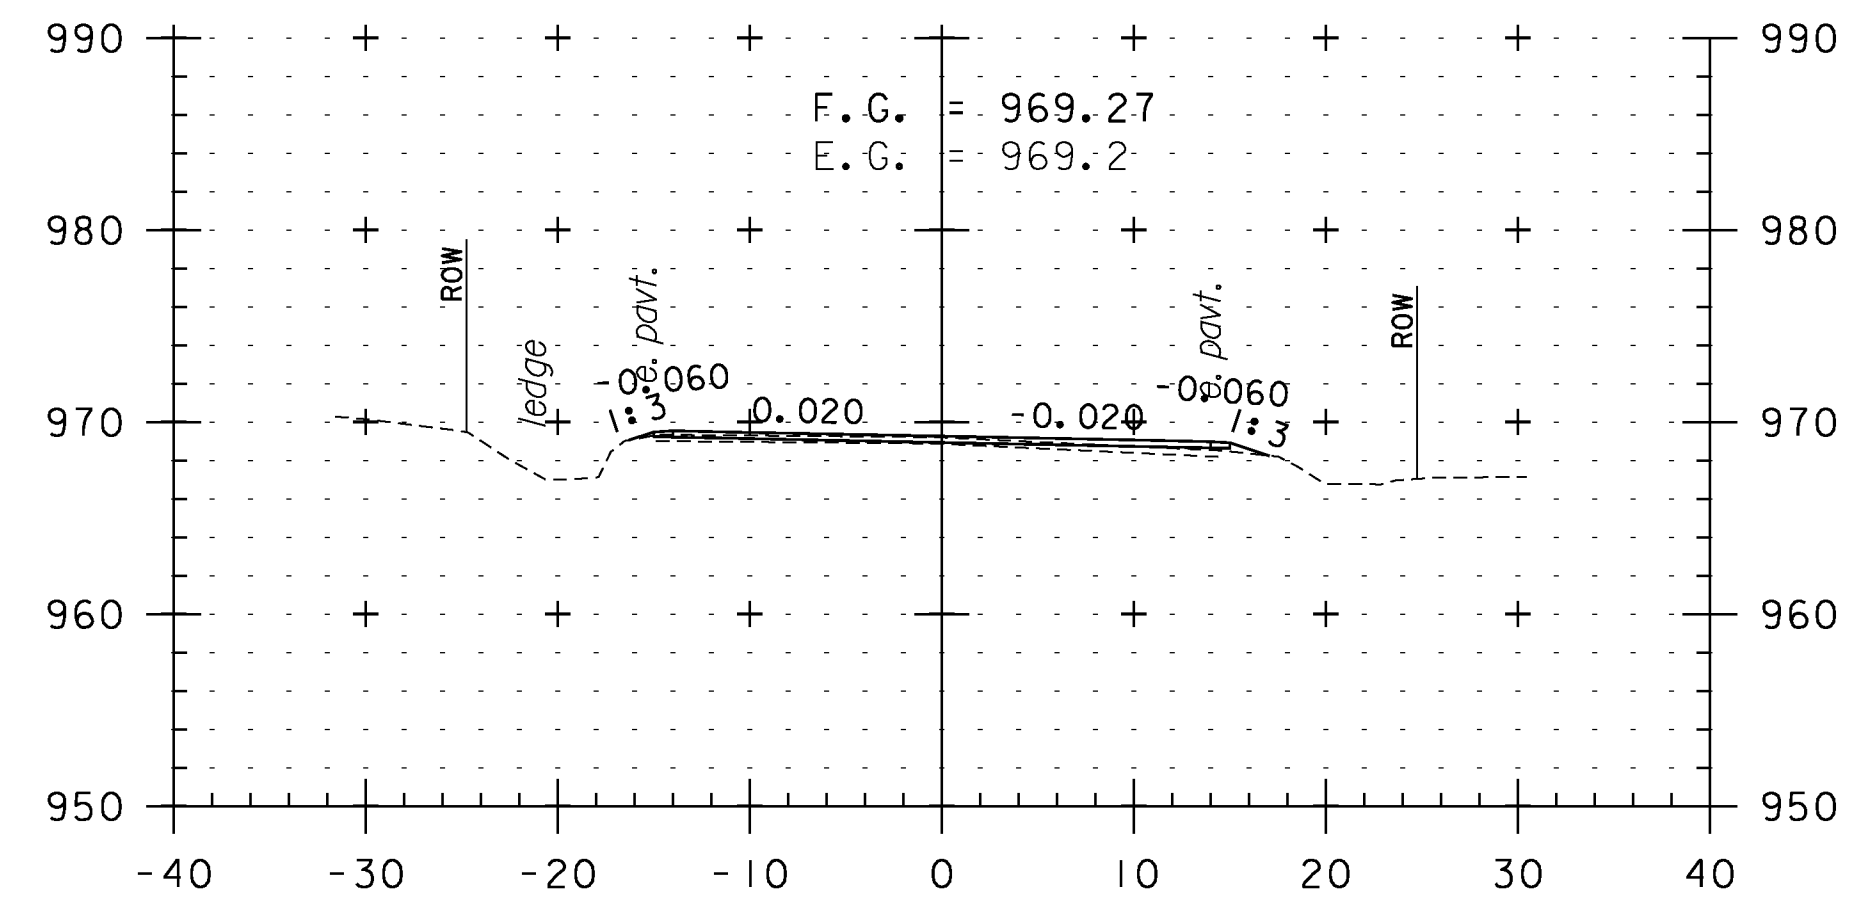


229+50

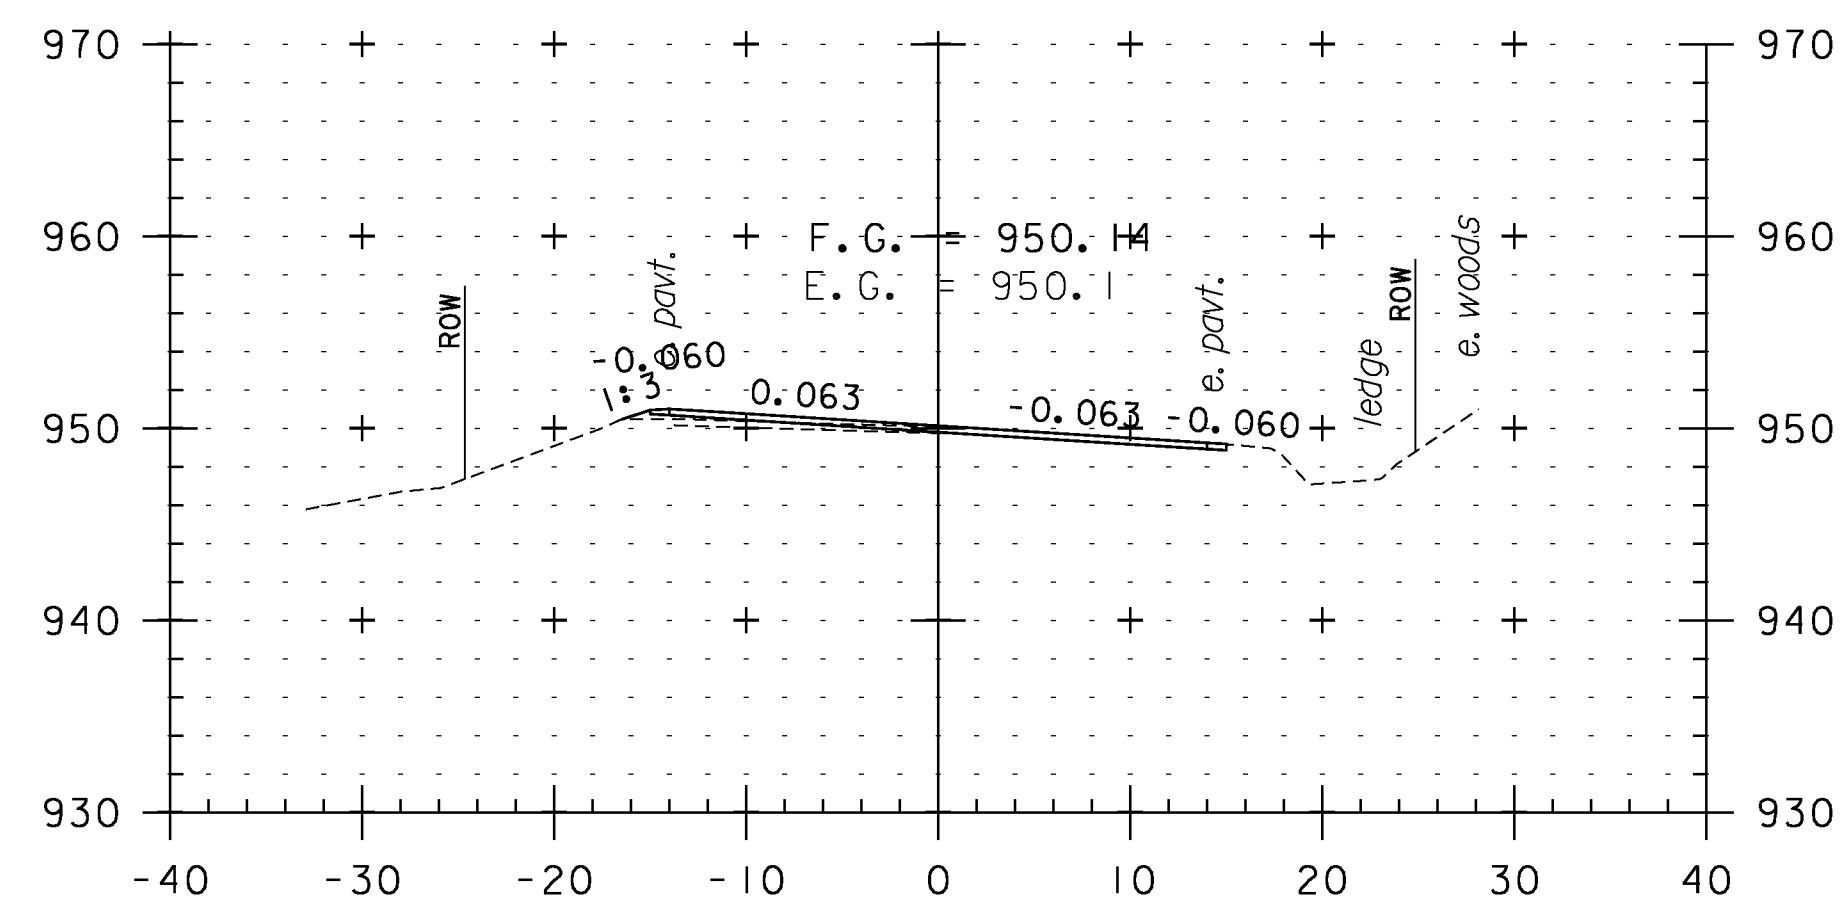


226+00

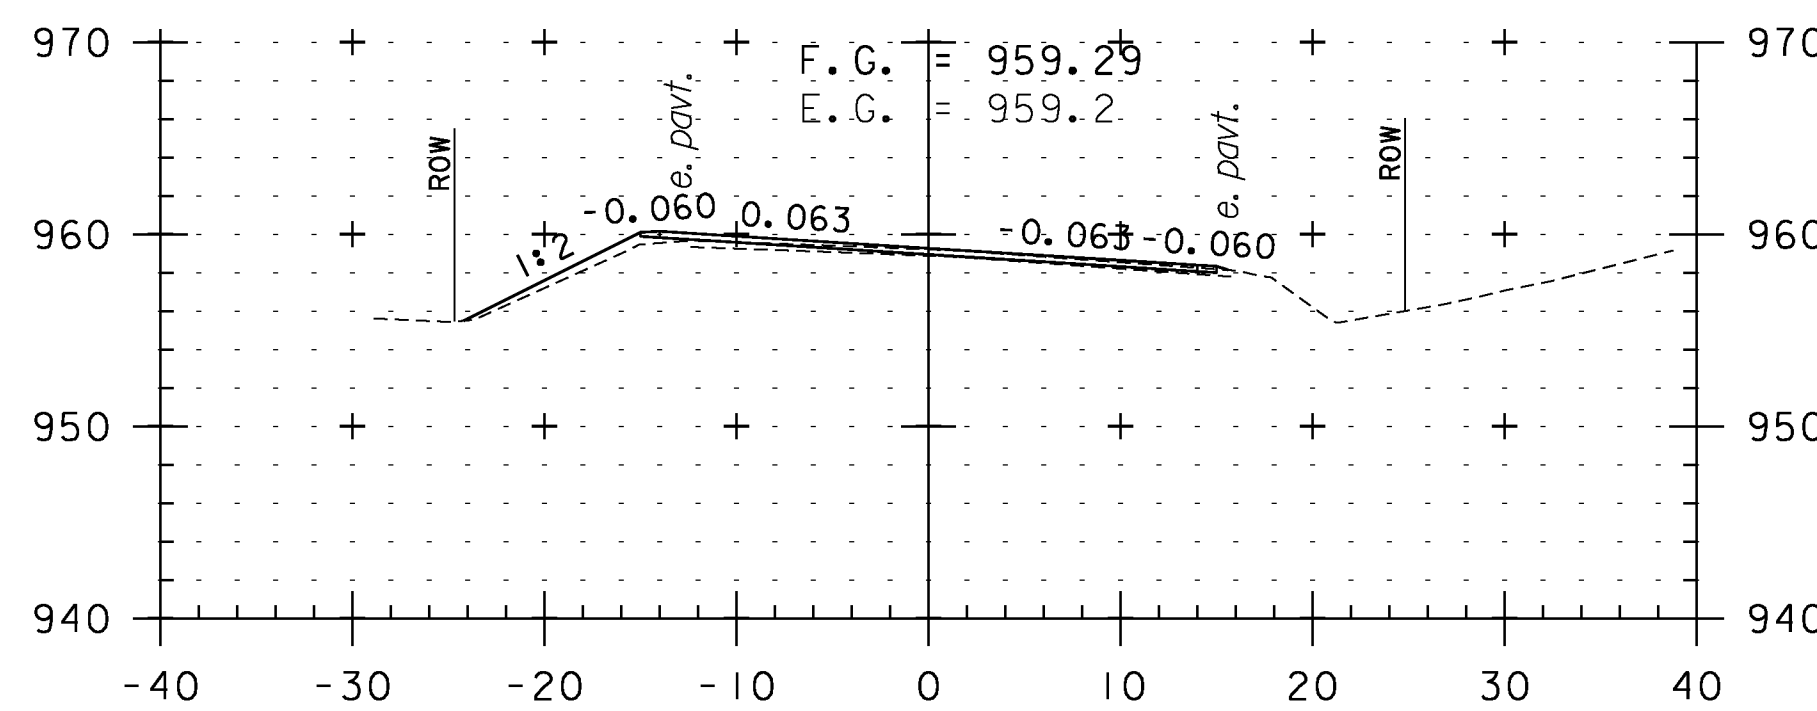


227+50

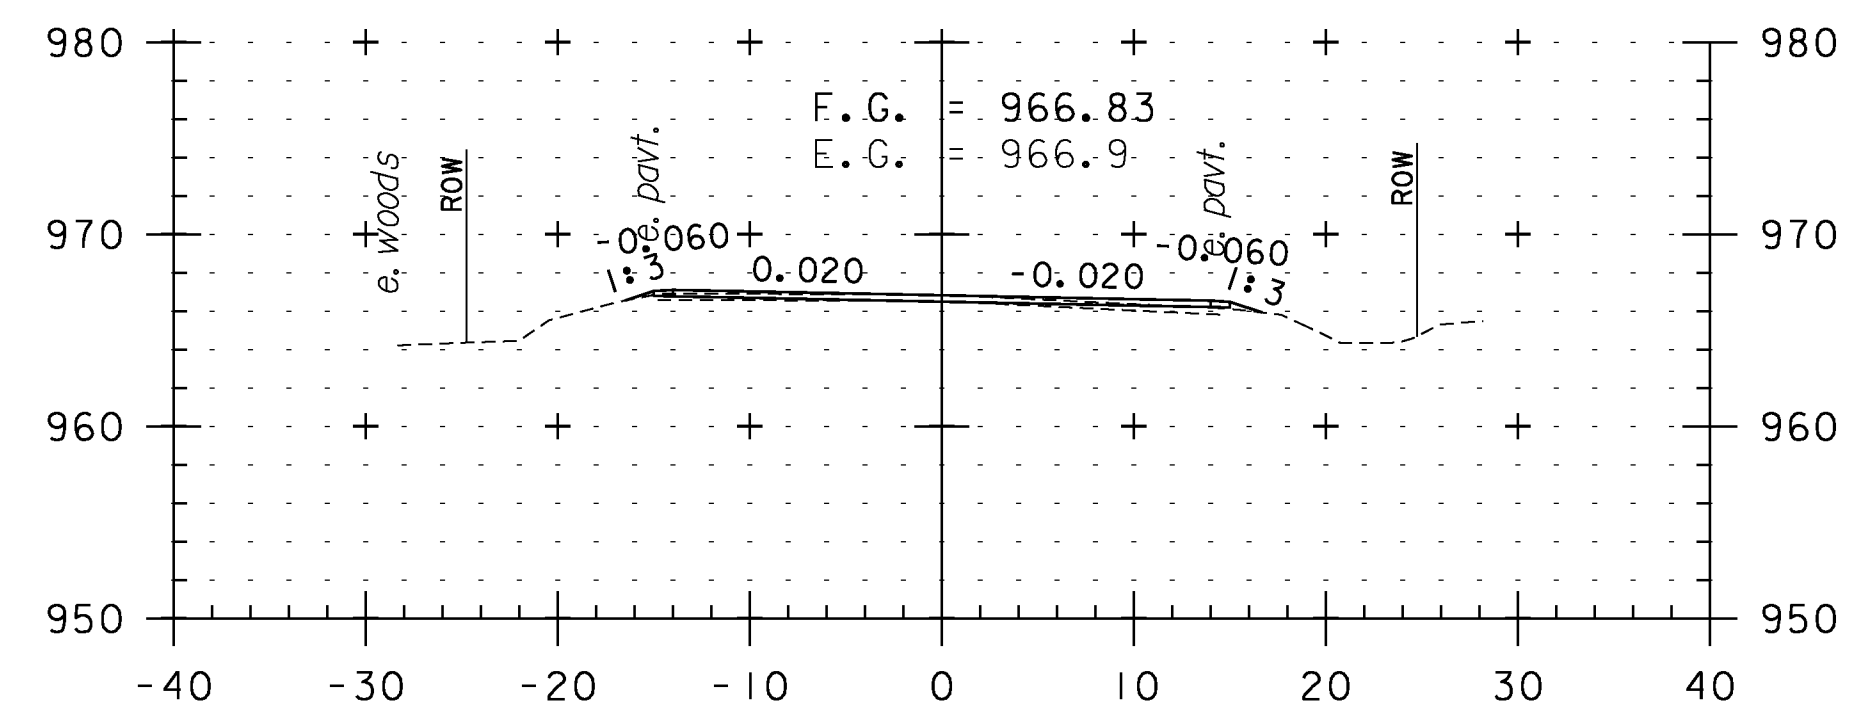


229+00

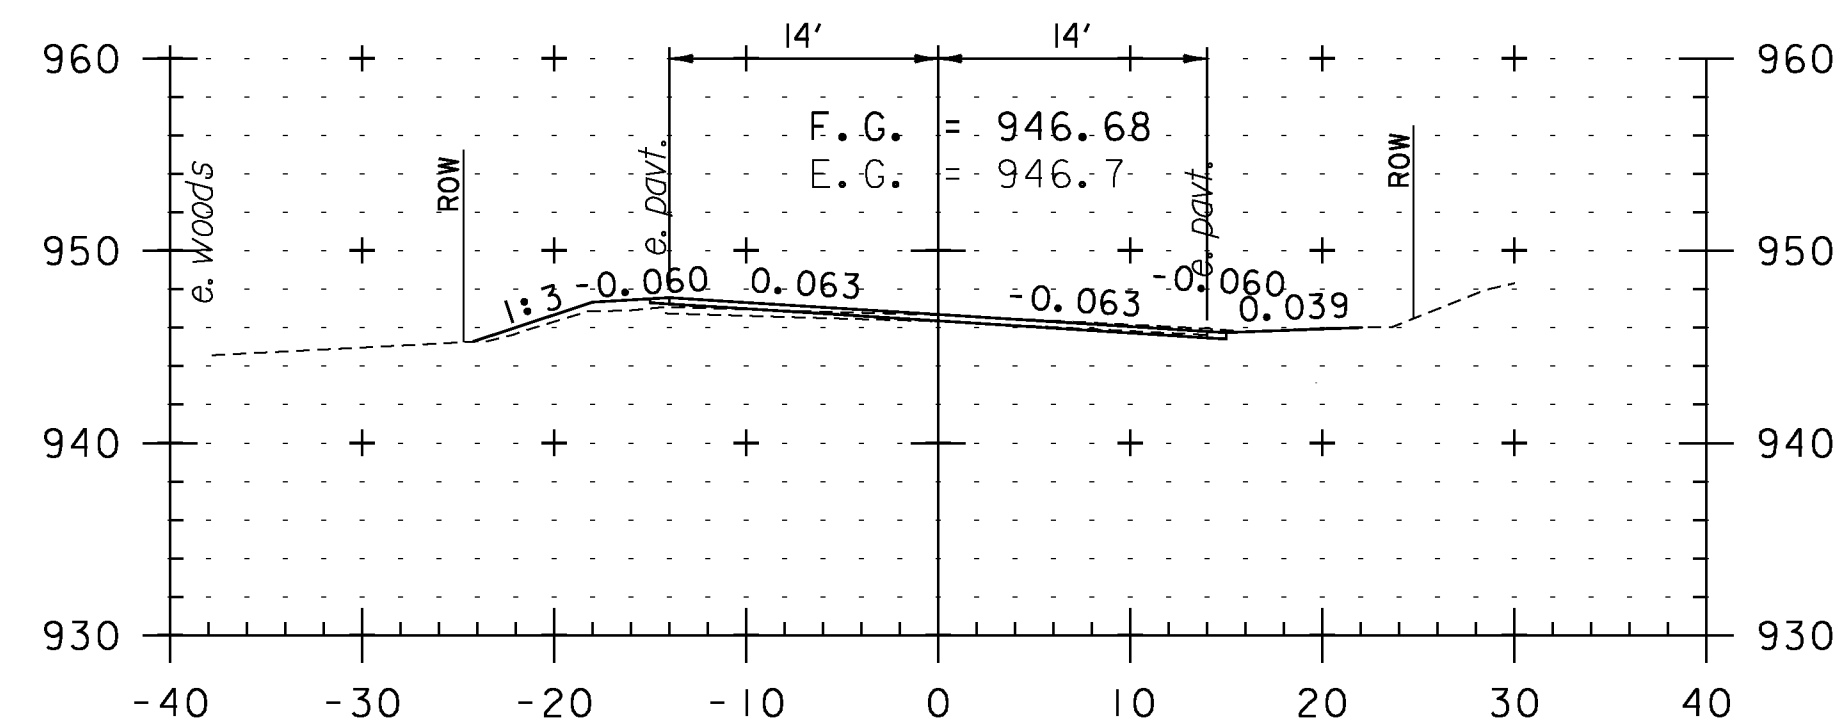

225+50

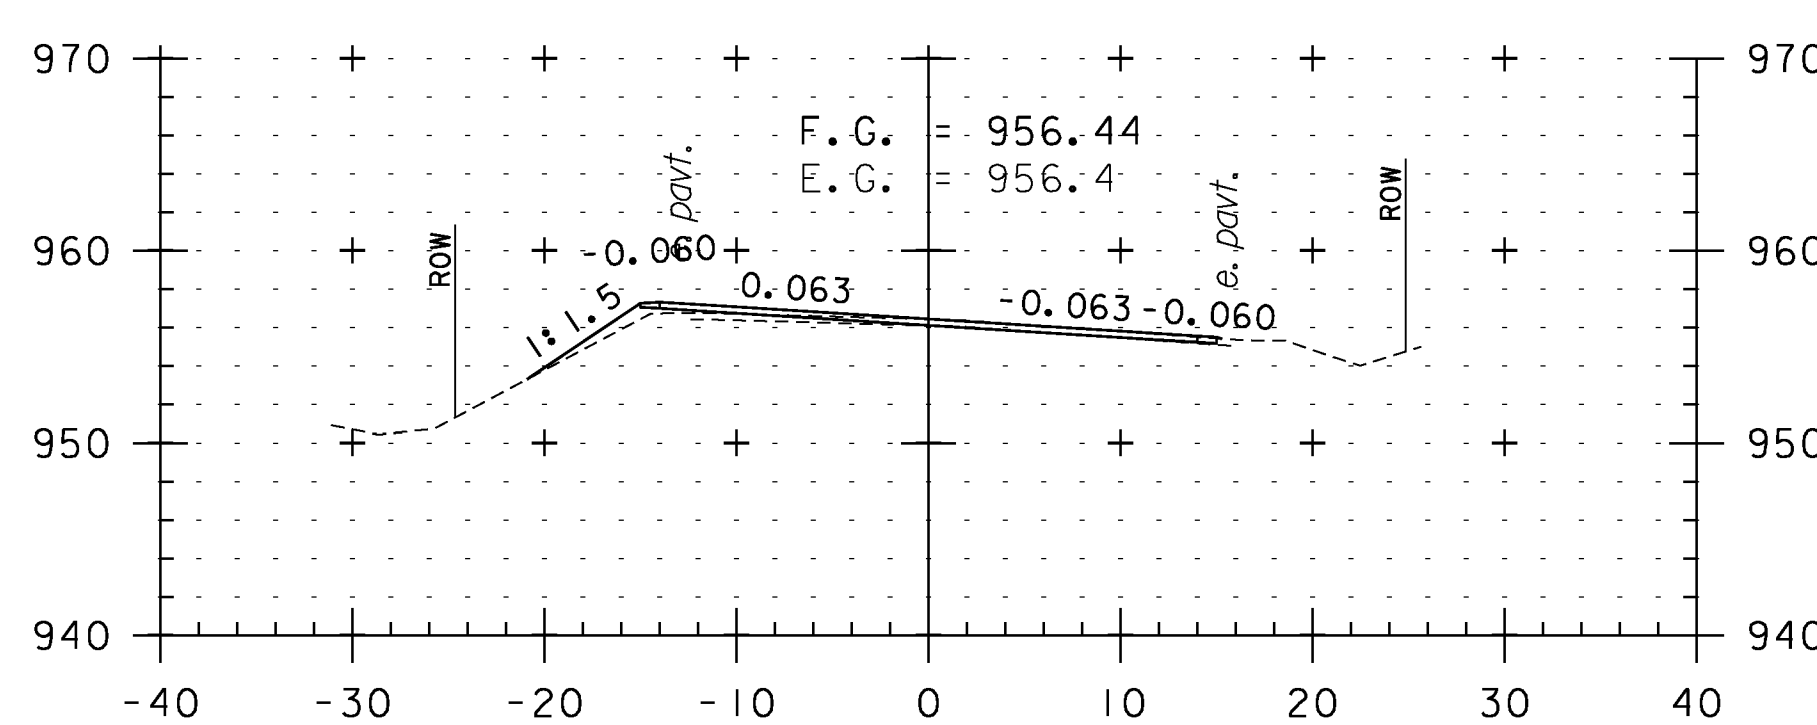

227+00

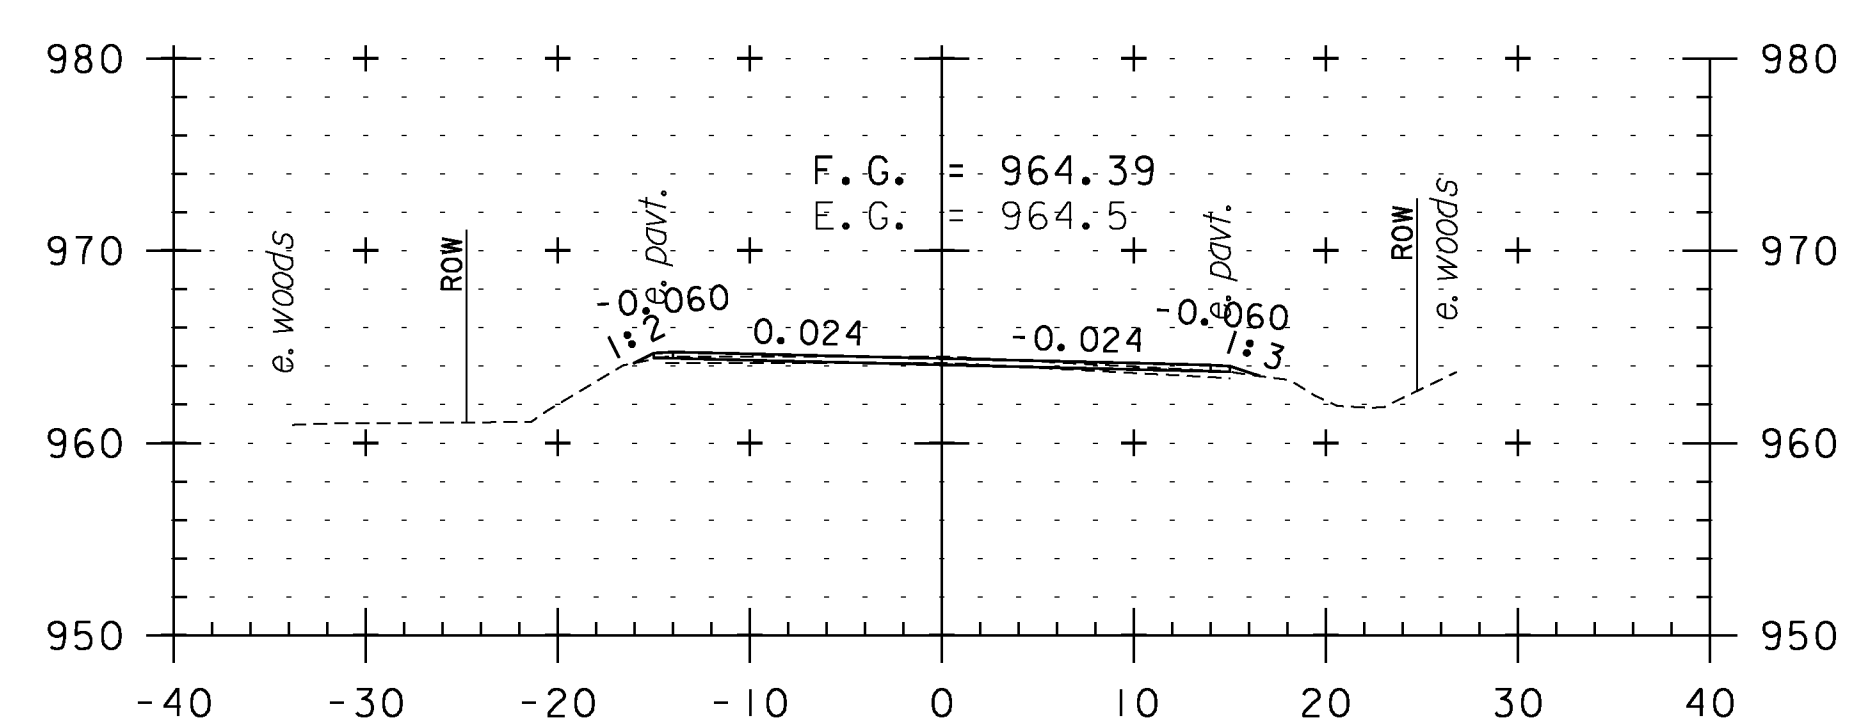

228+50

CROSS SECTION SHEET 38

PROJECT NAME: WEATHERSFIELD

PROJECT NUMBER: STP 2913(I)

FILE NAME: I0c228

PROJECT LEADER: PTS

DESIGNED BY: NLL


IPARM FILE NAME: pI0c228_I28

PLOT DATE: 2/7/2013

DRAWN BY: WWG

CHECKED BY: PTS

SHEET 128 OF 234

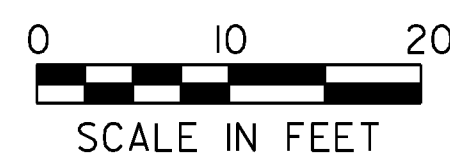

STA. 225+50 TO STA. 229+50