




249+00

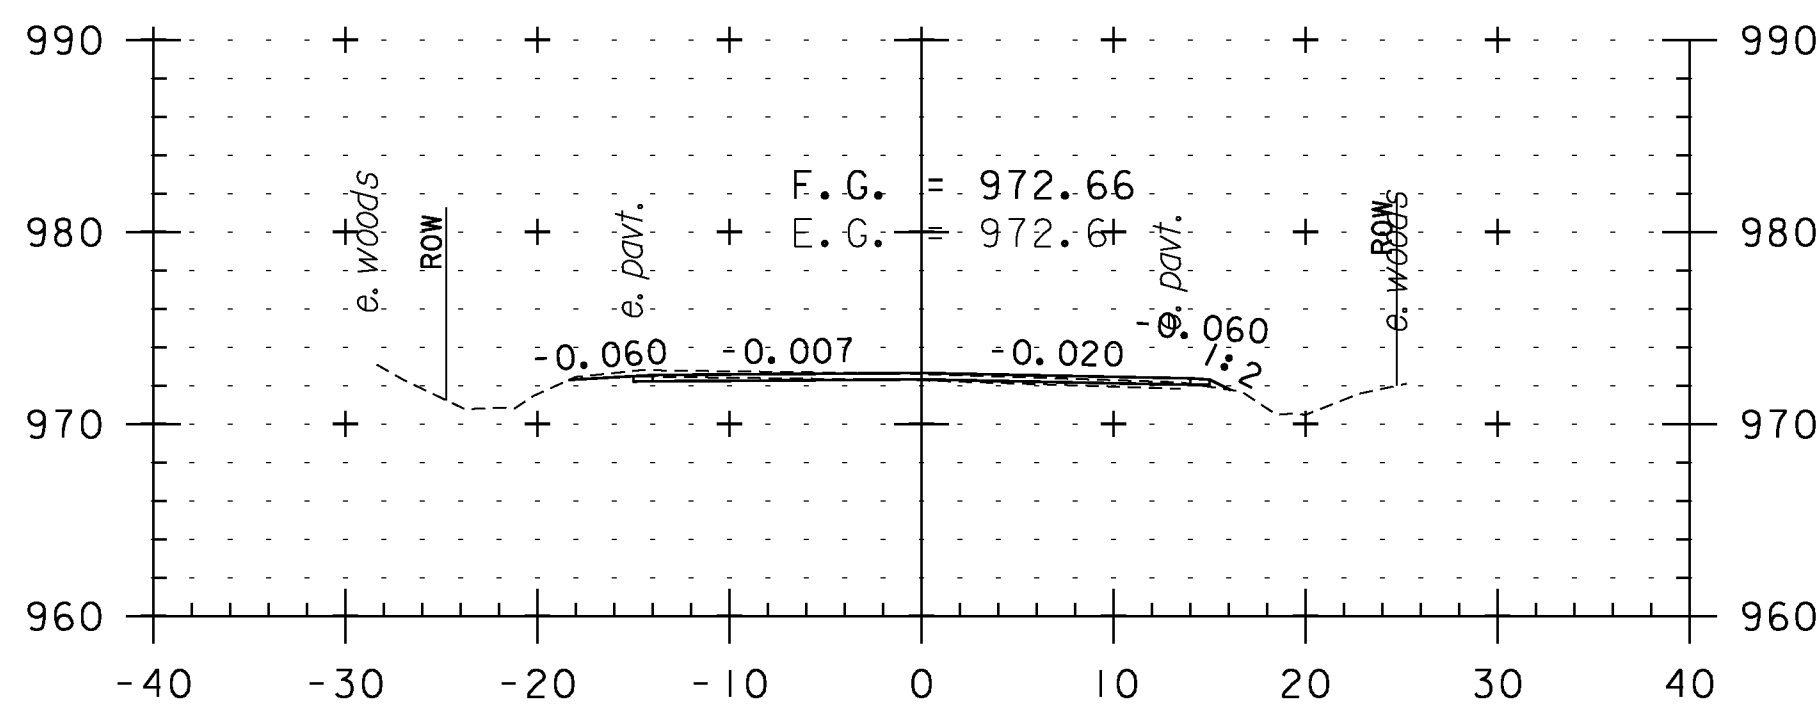


250+50

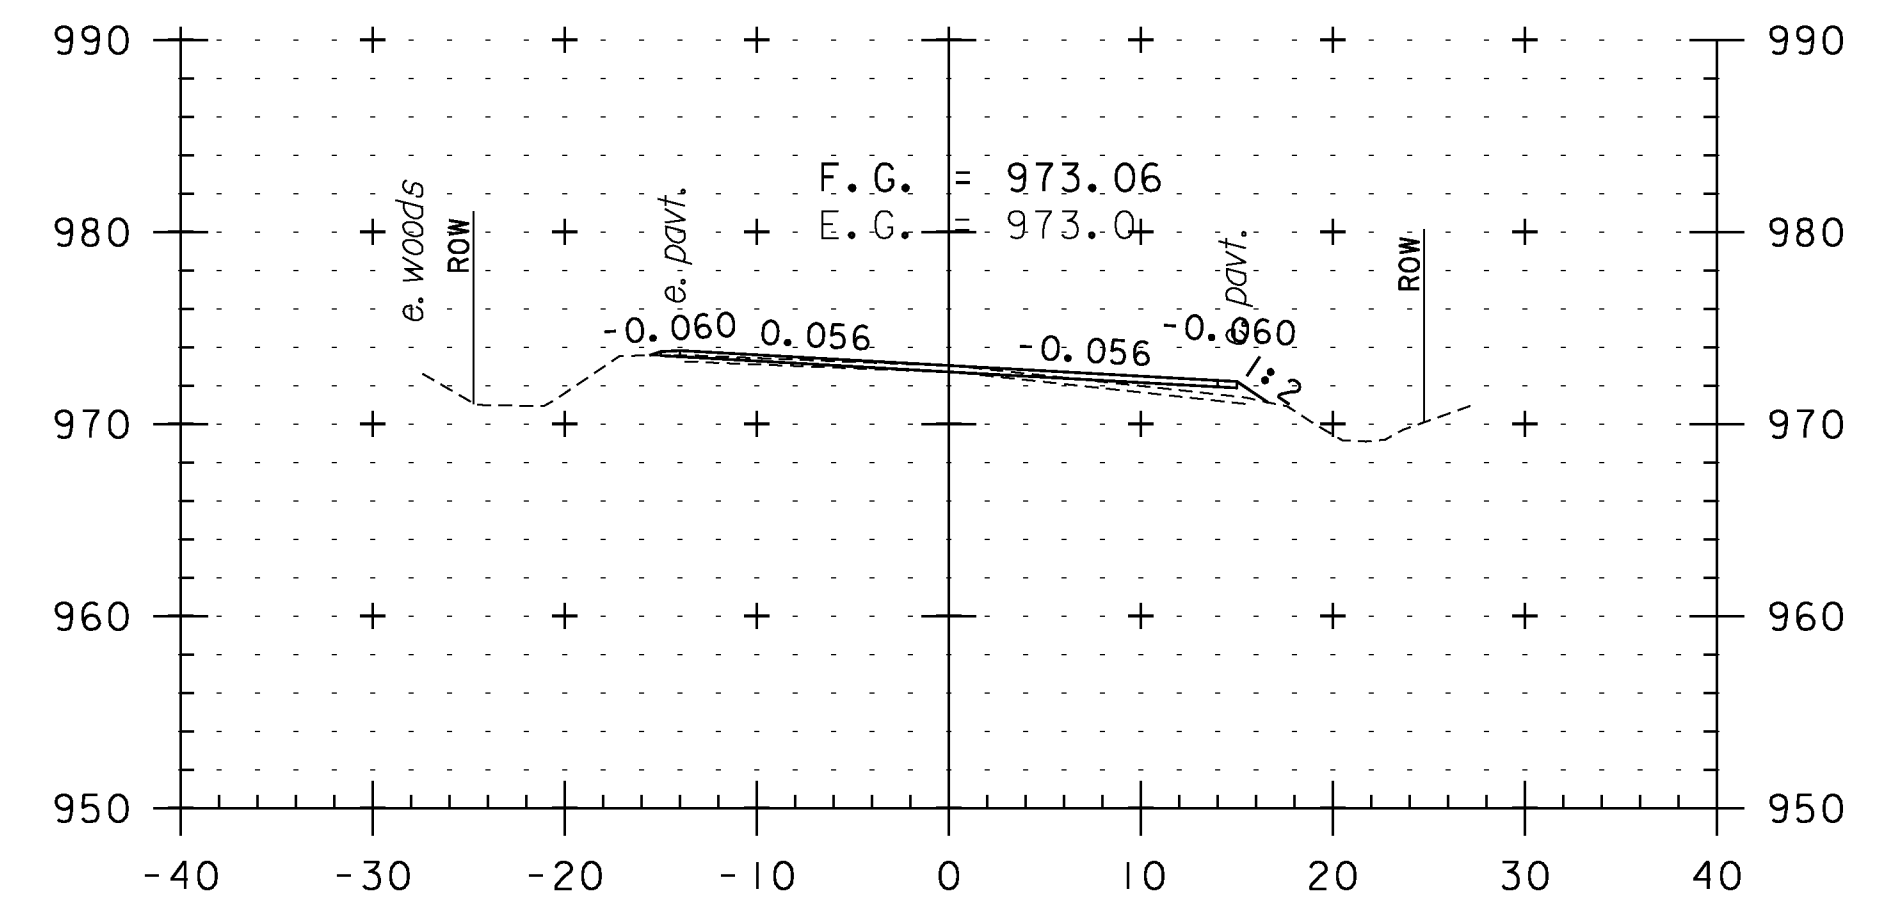


252+00

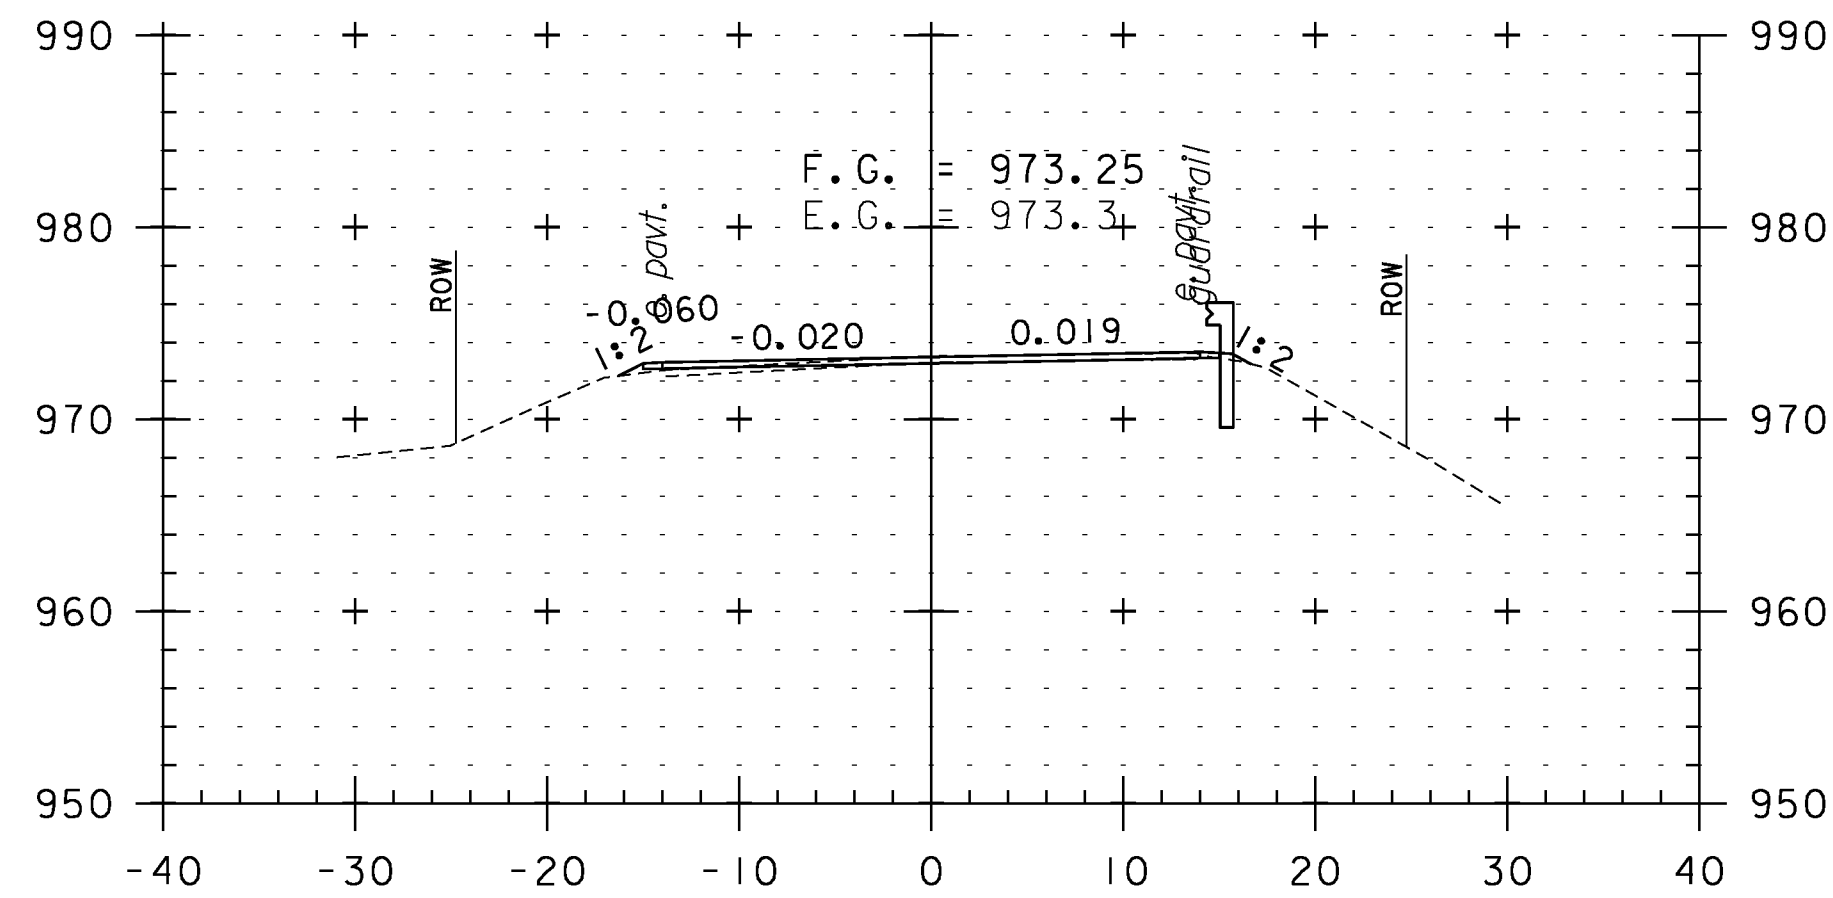


248+50

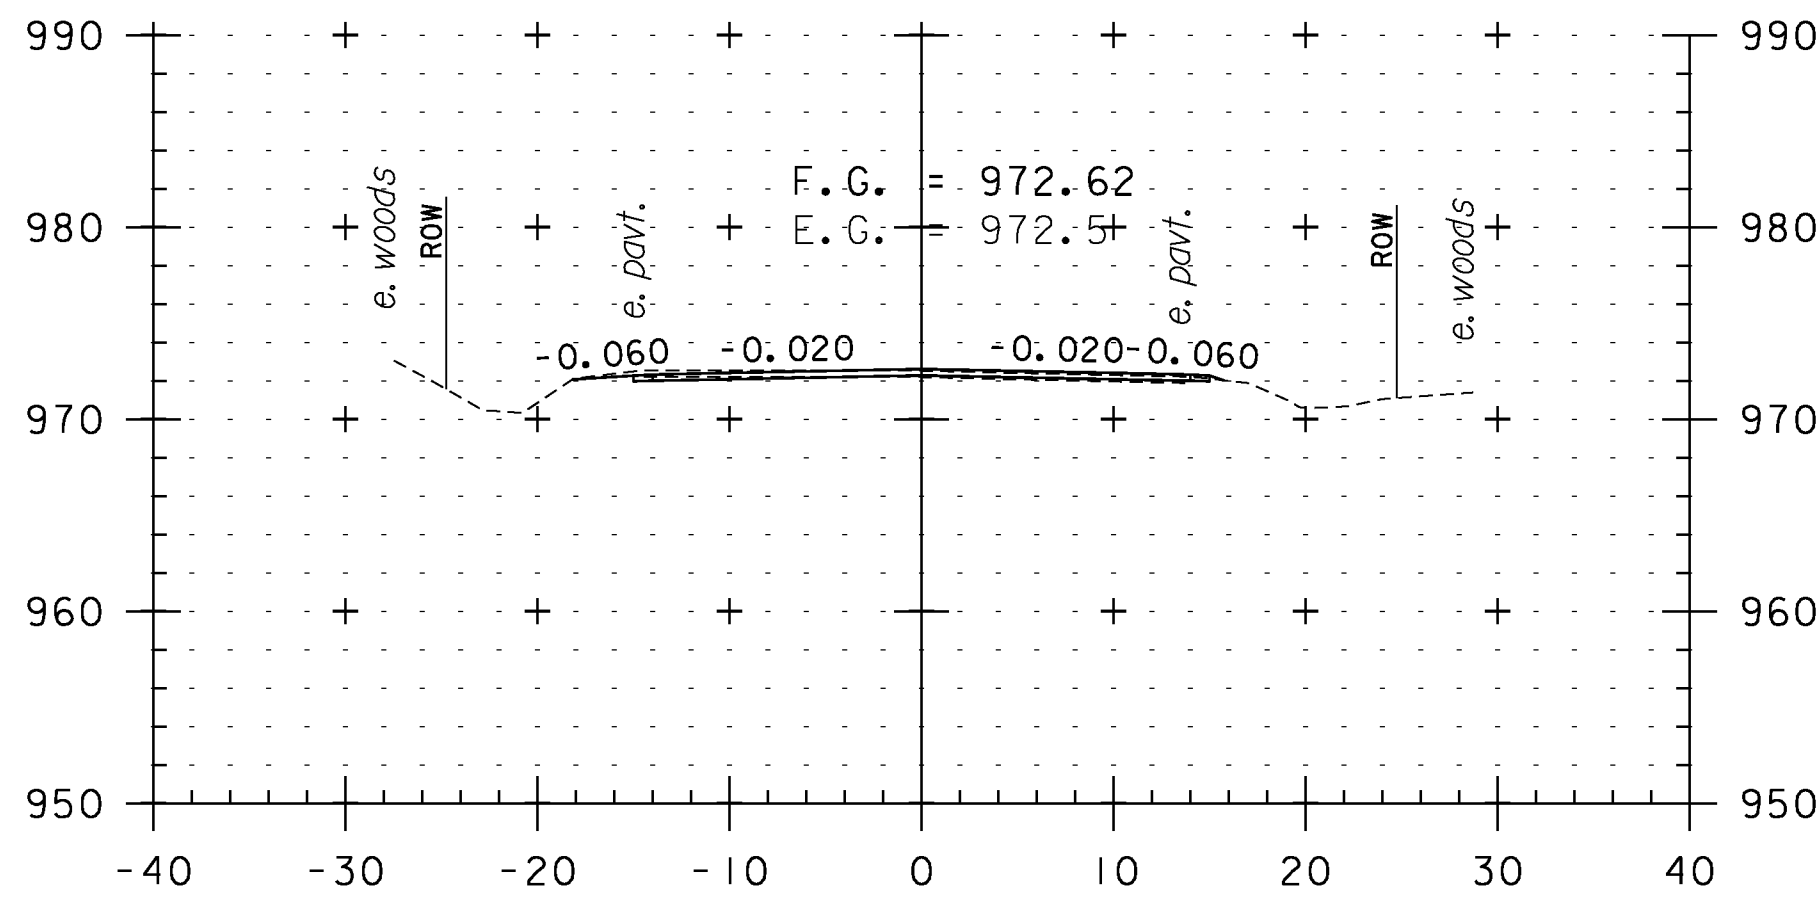


250+00

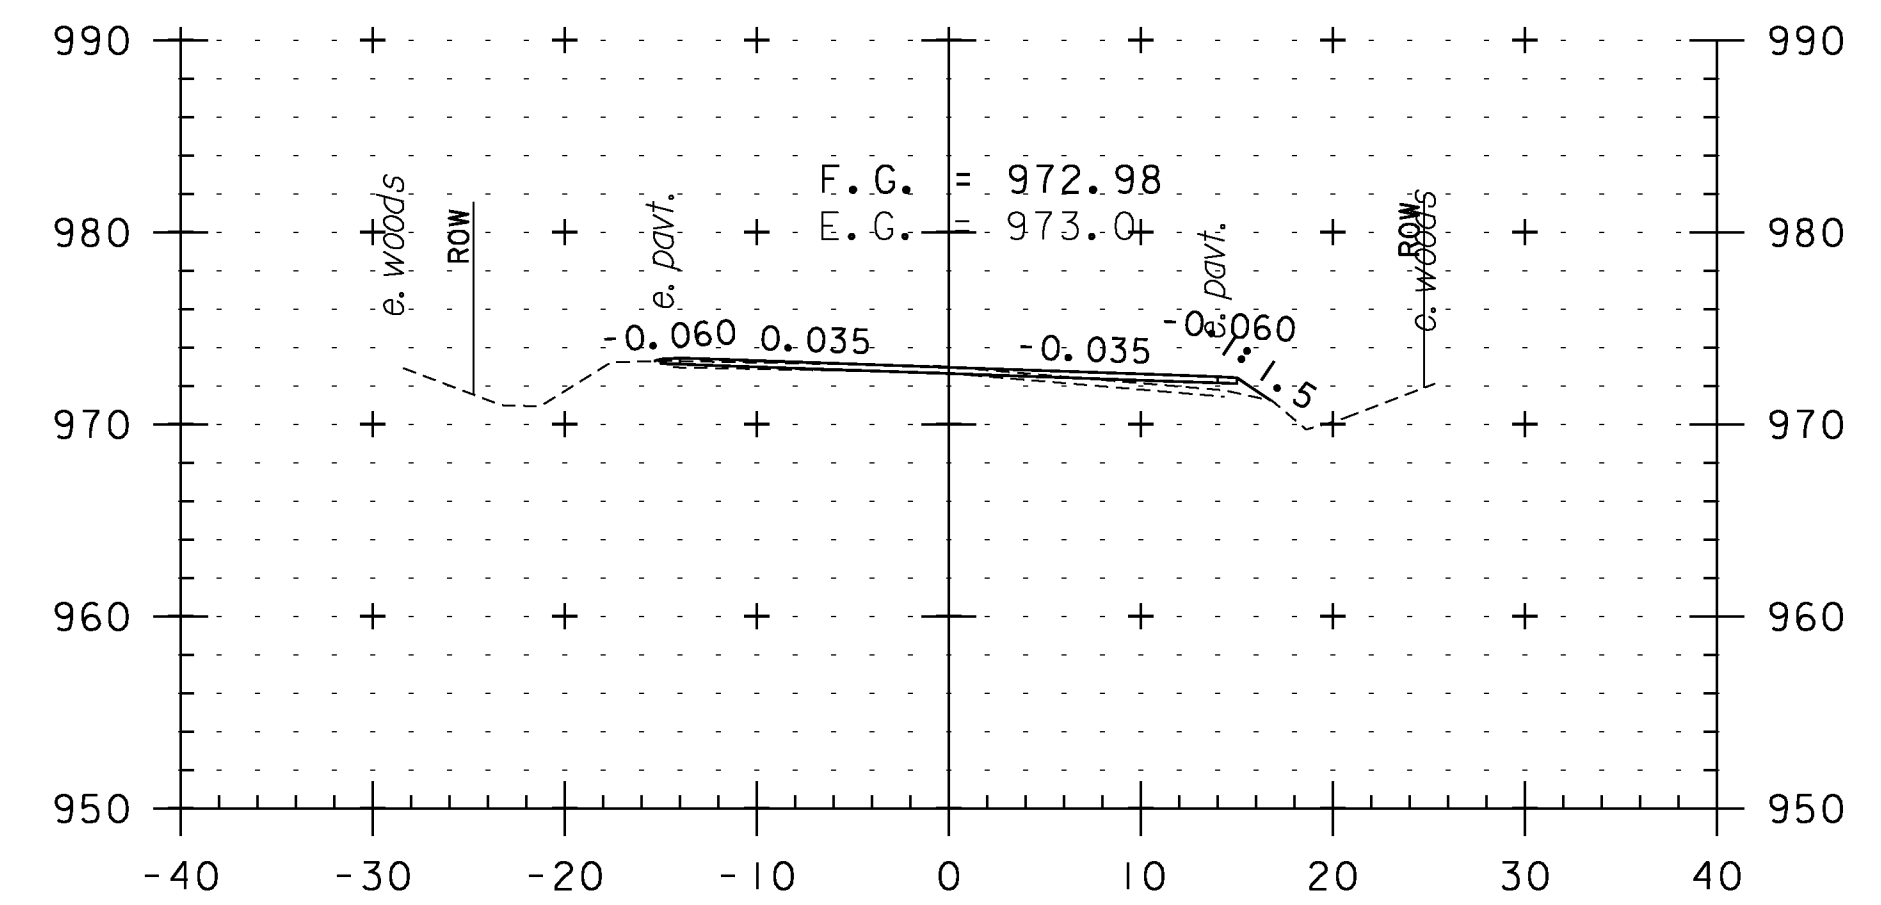


251+50

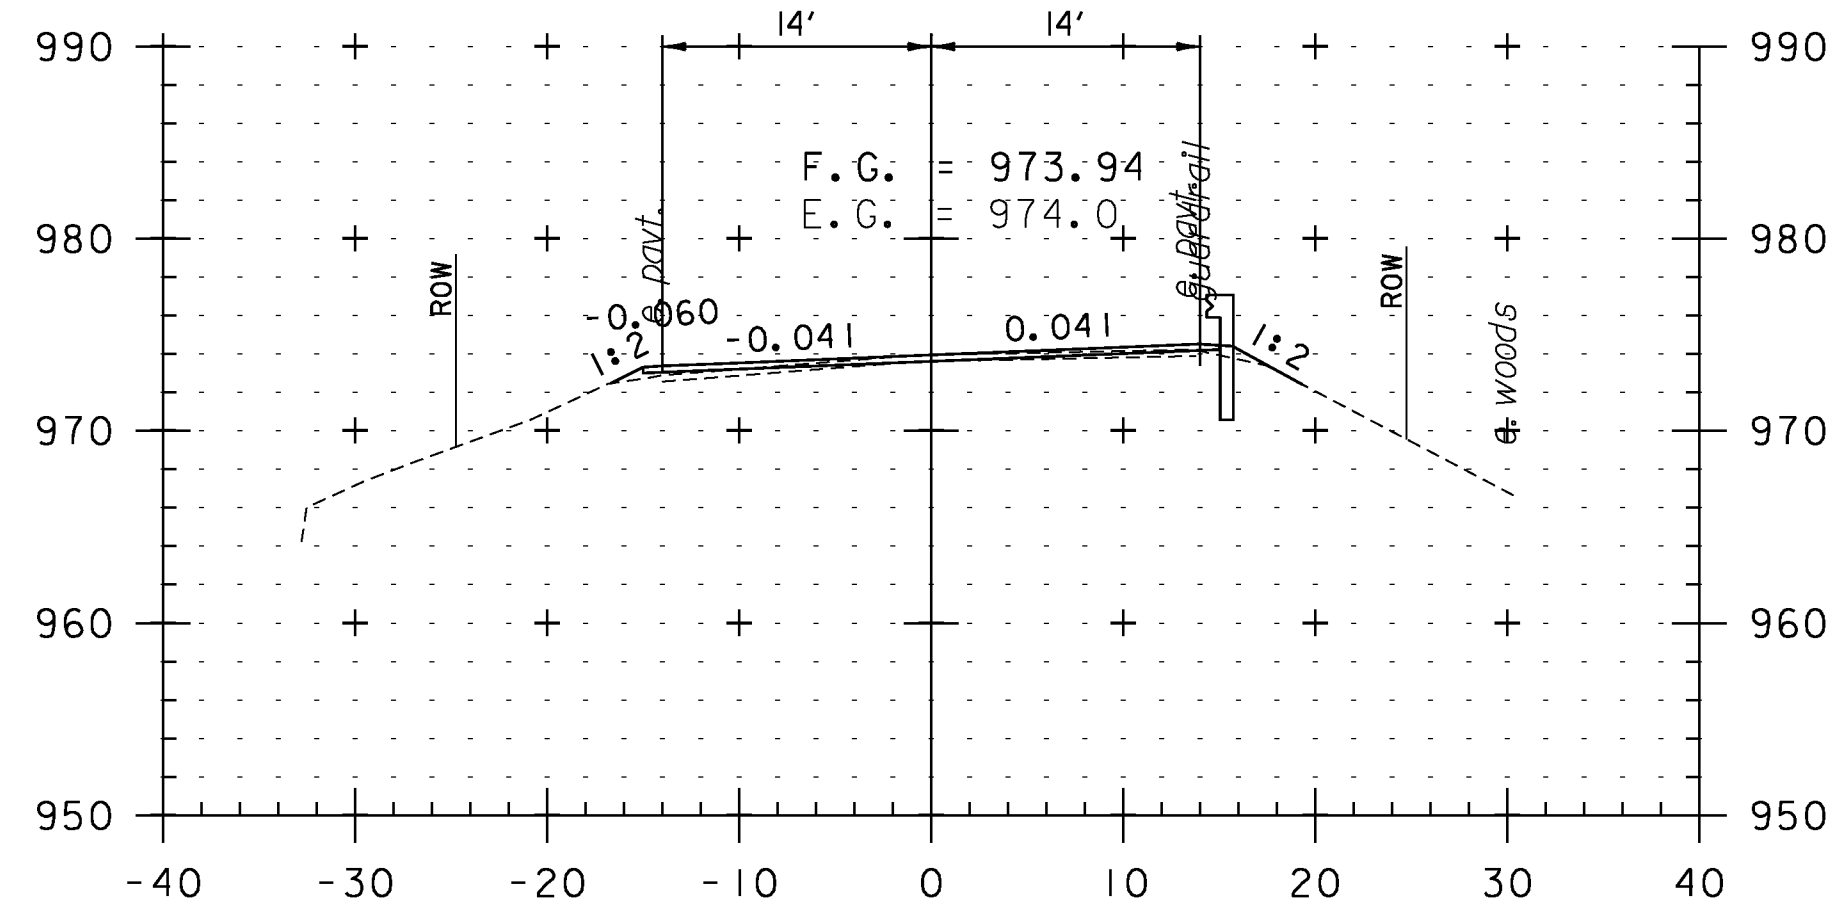

248+00

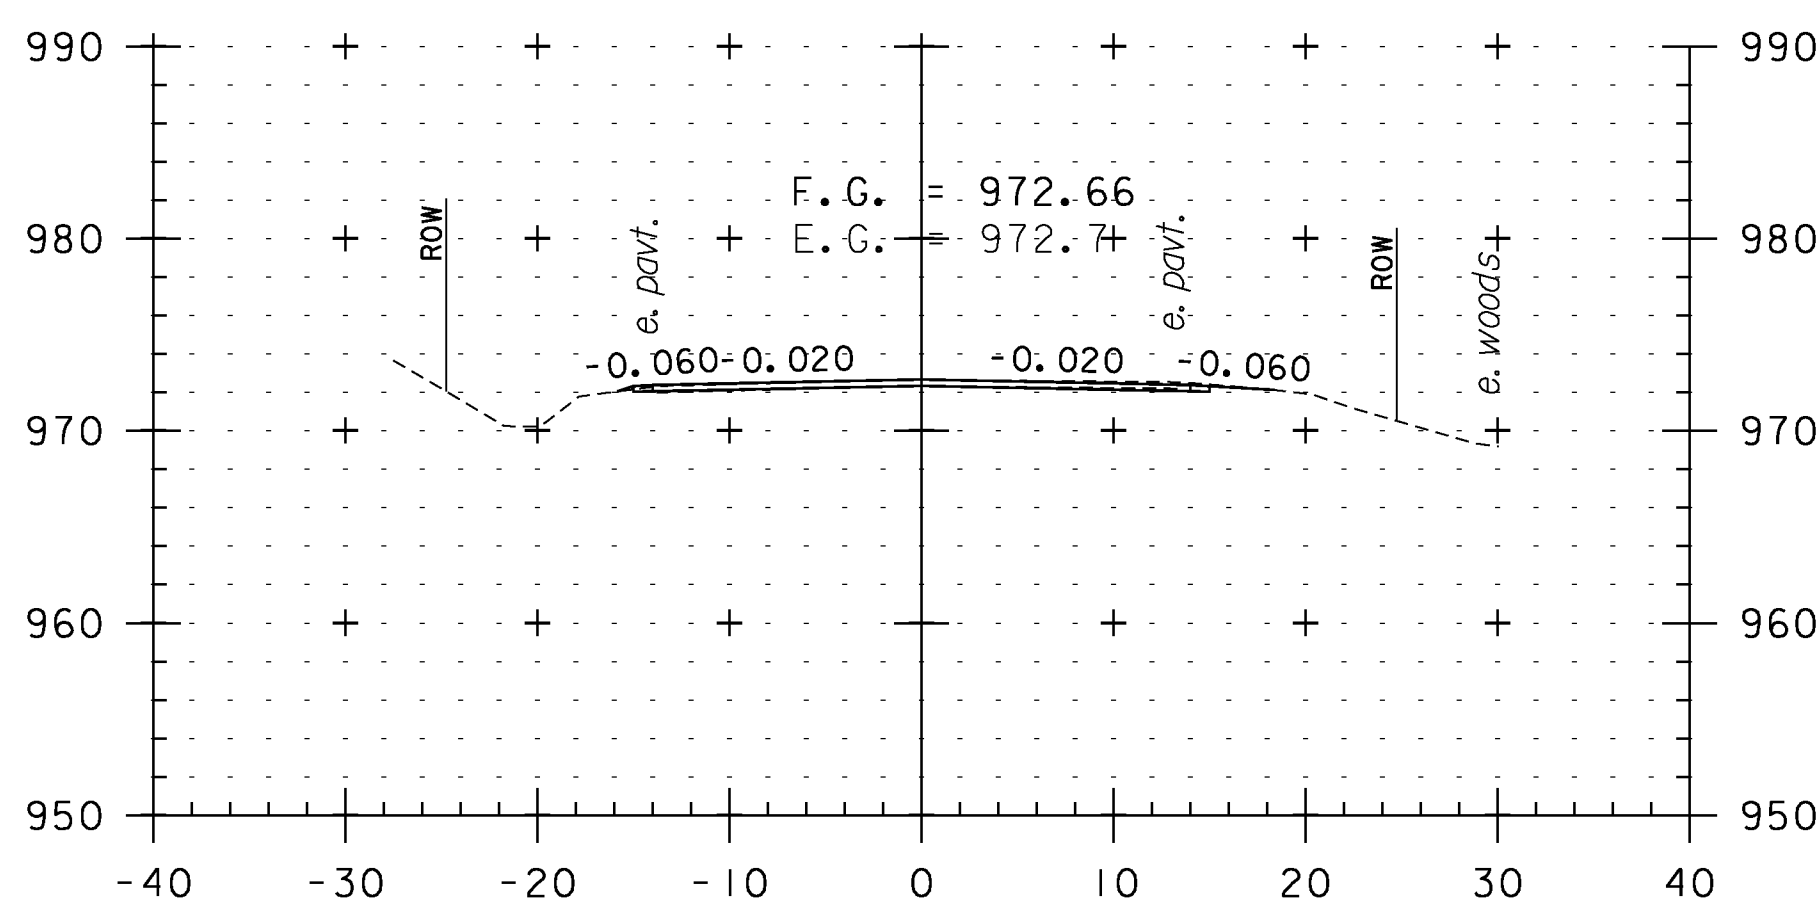

249+50

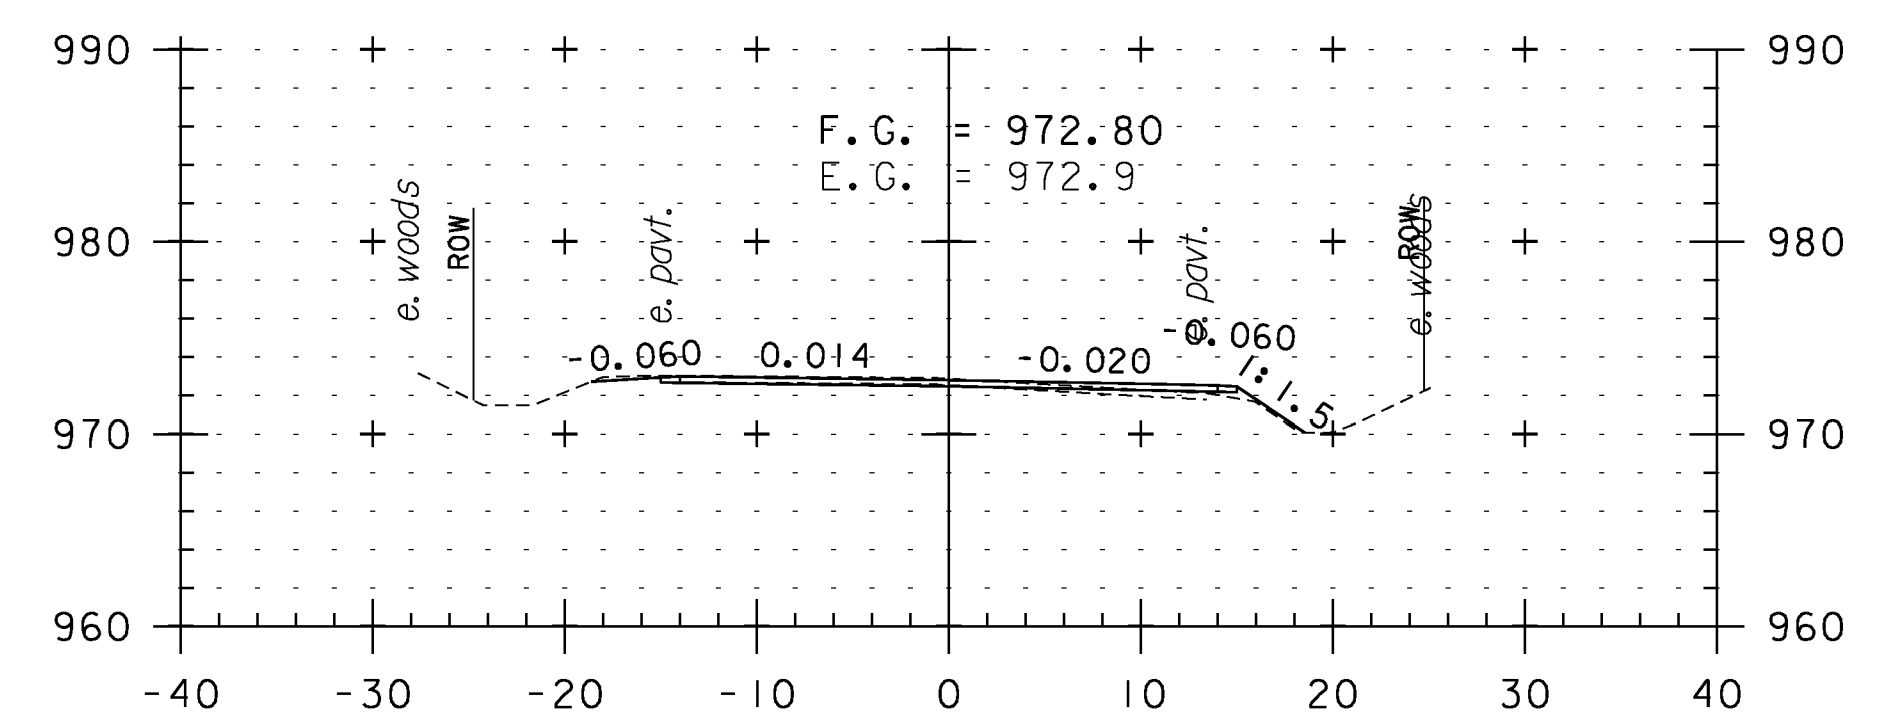

251+00

**CROSS SECTION SHEET 43**

PROJECT NAME: WEATHERSFIELD	PLOT DATE: 2/7/2013
PROJECT NUMBER: STP 2913(I)	DRAWN BY: WWG
FILE NAME: I0c228	CHECKED BY: PTS
PROJECT LEADER: PTS	SHEET 133 OF 234
DESIGNED BY: NLL	
IPARM FILE NAME: pI0c228.I33	



STA. 248+00 TO STA. 252+00