




257+50

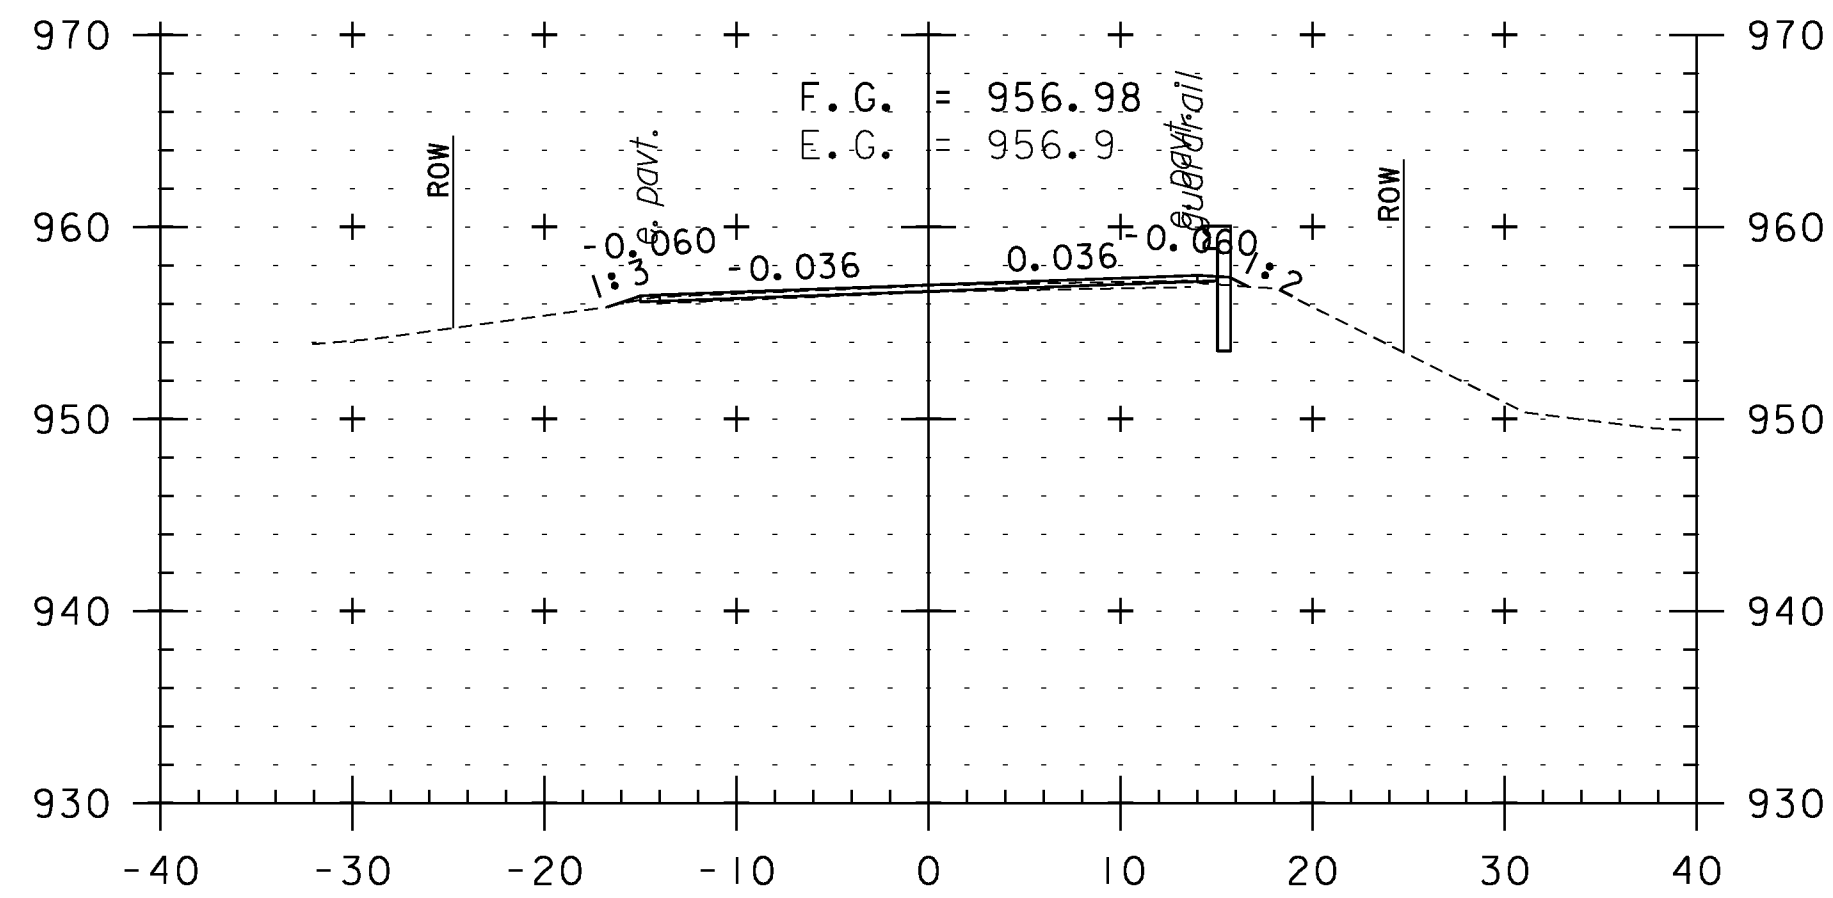


259+00

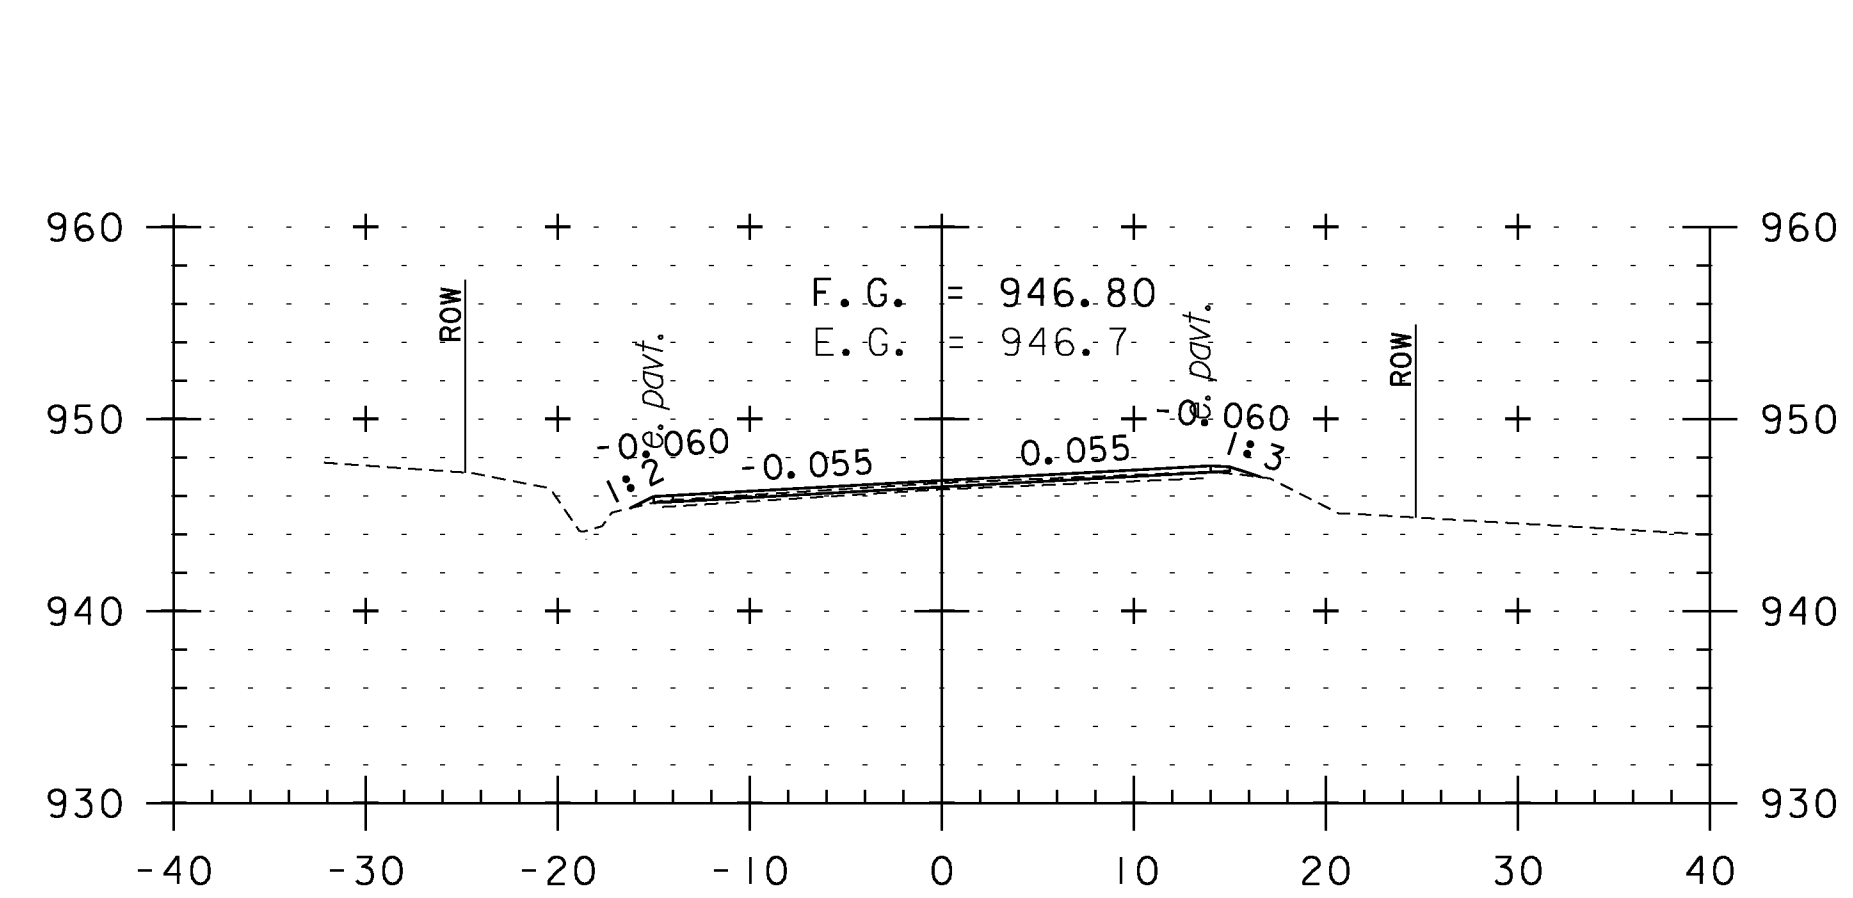


260+50

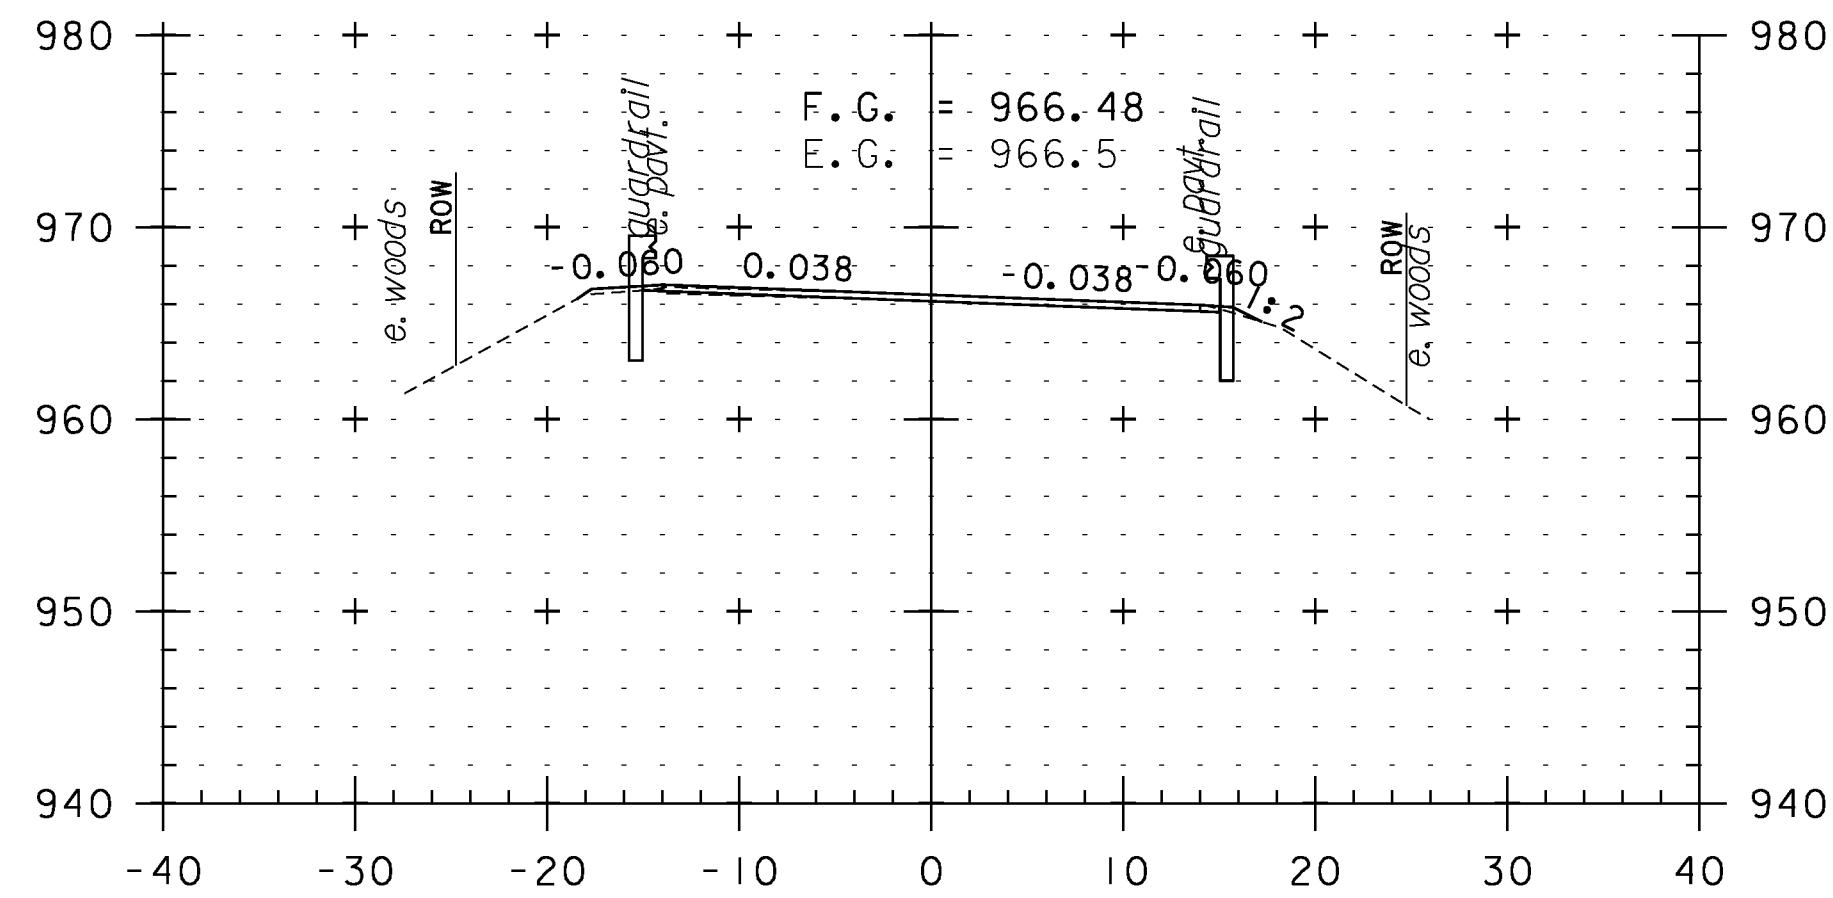


257+00

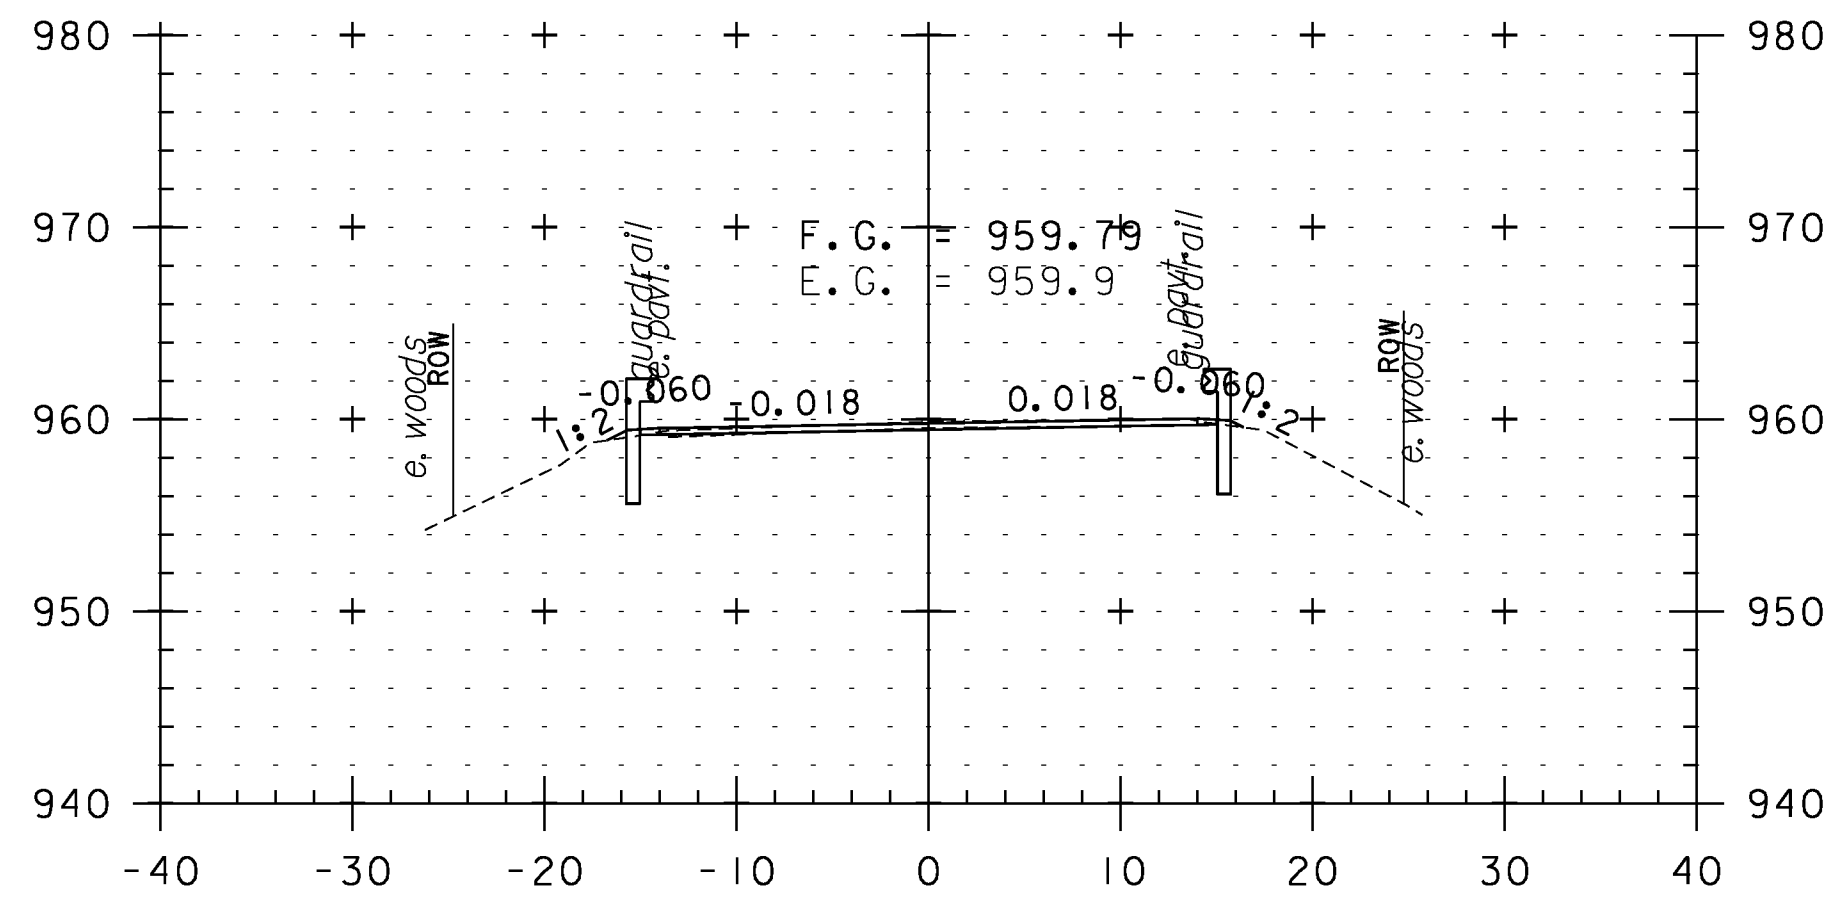


258+50

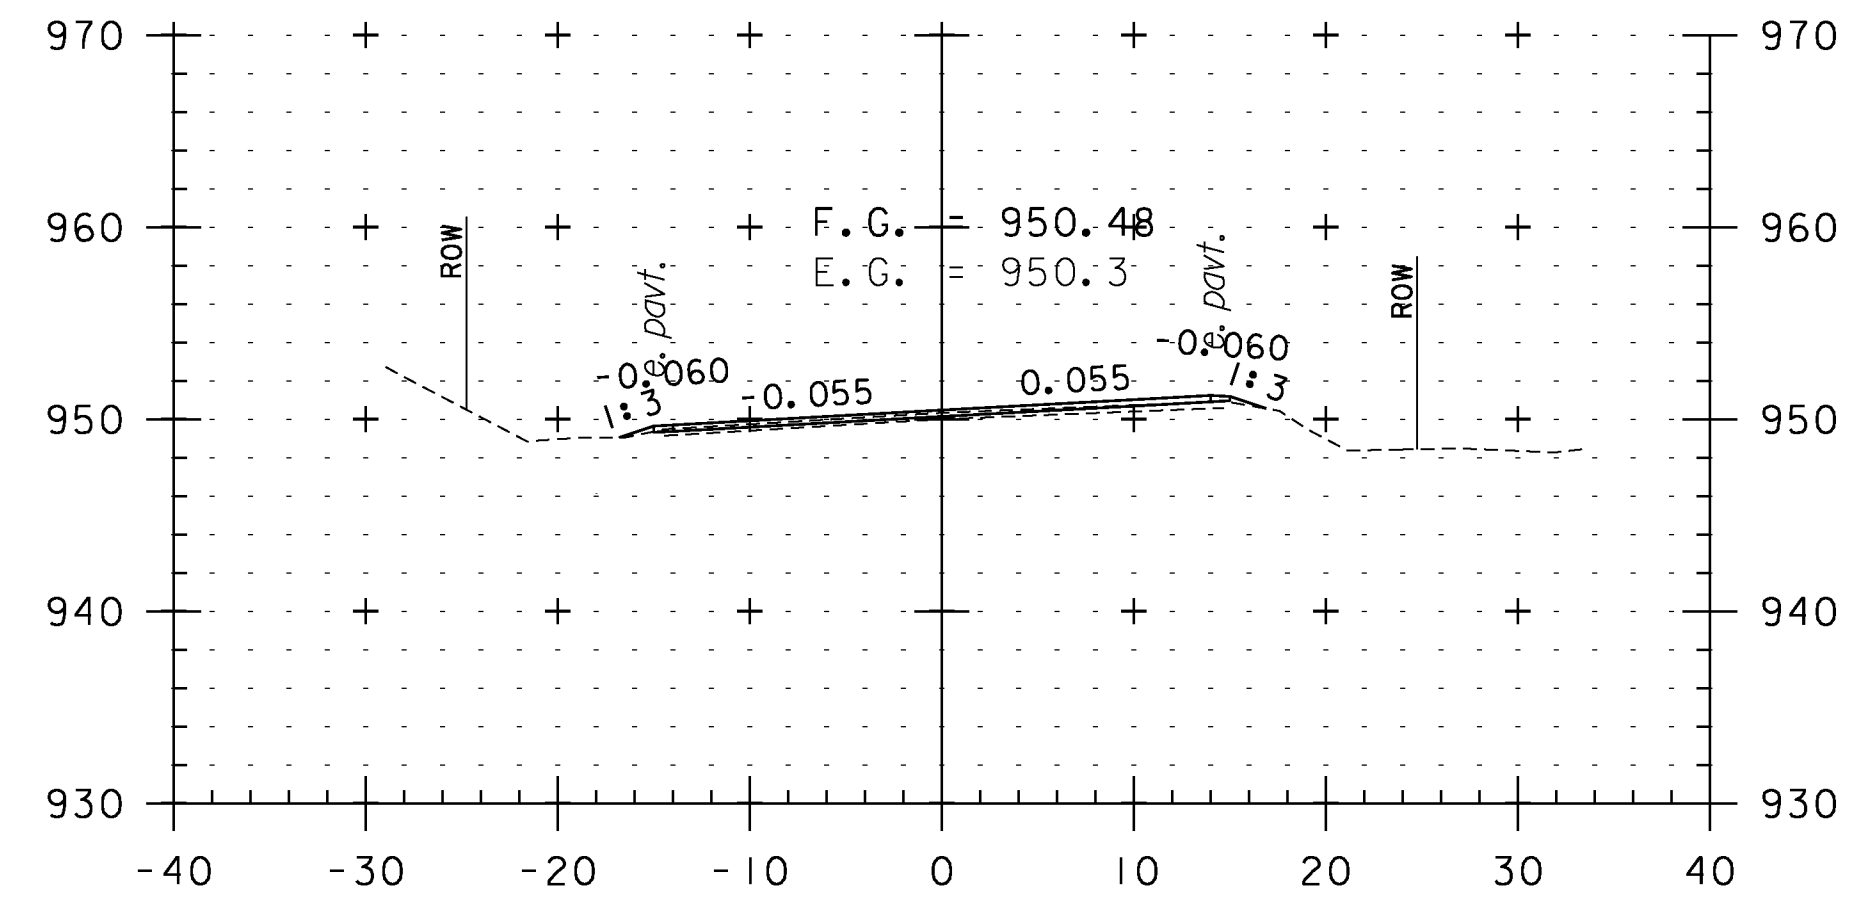


260+00

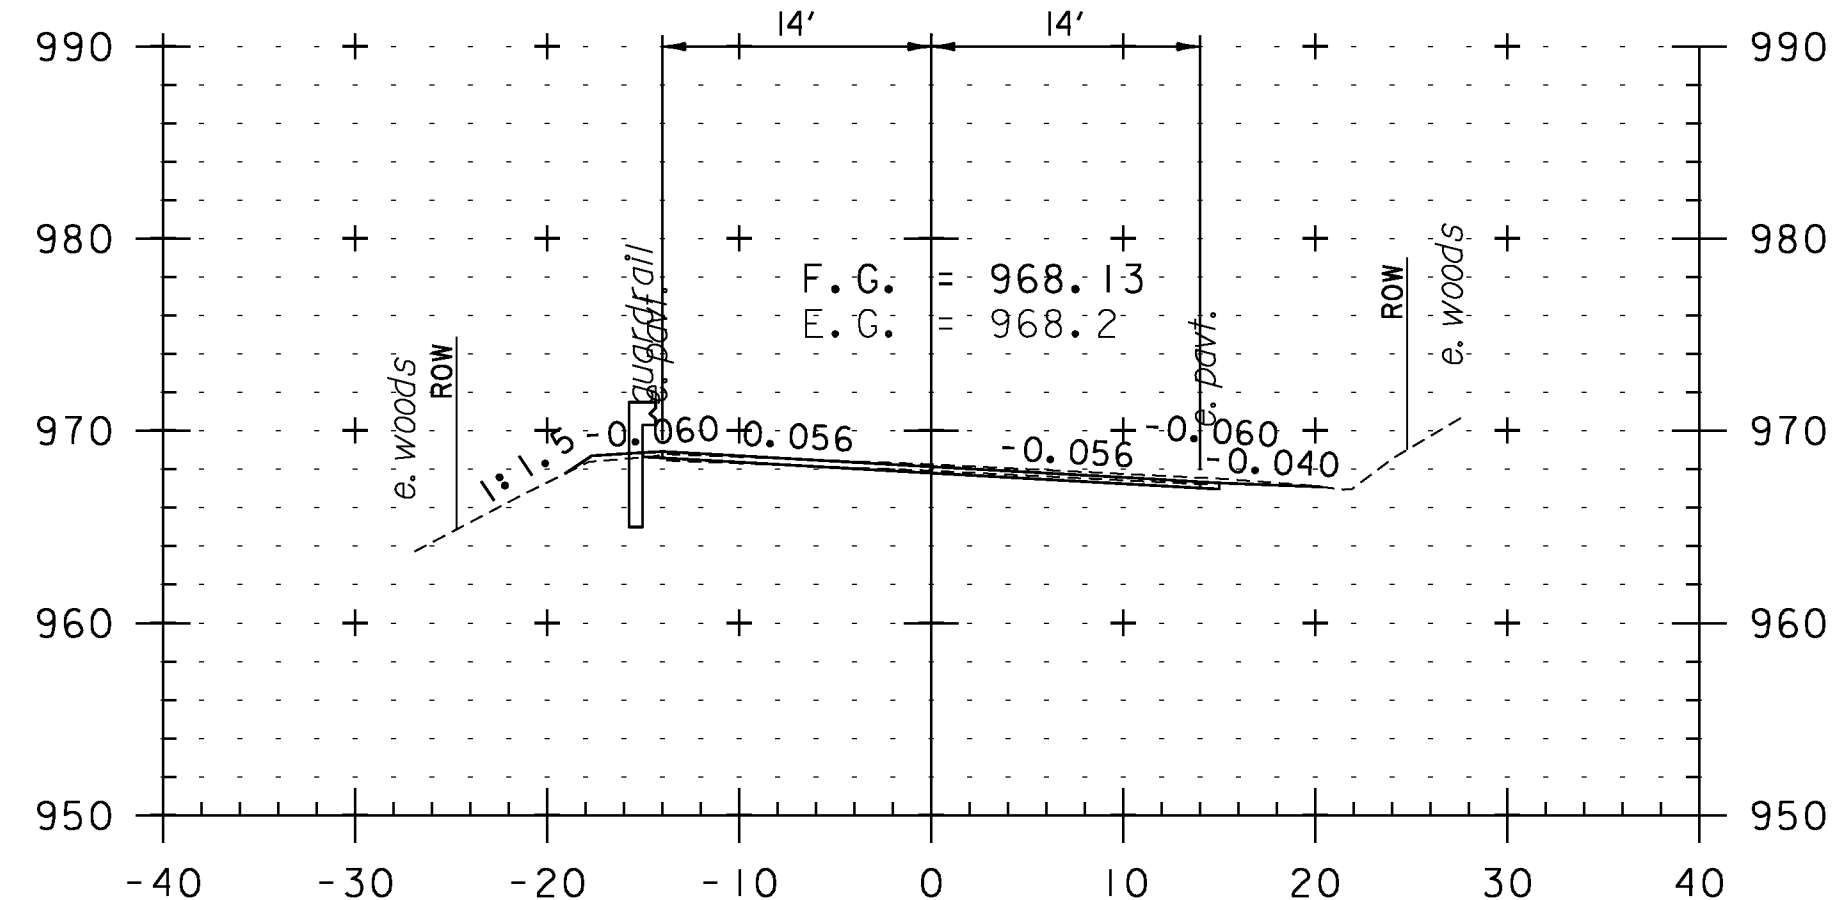

256+50

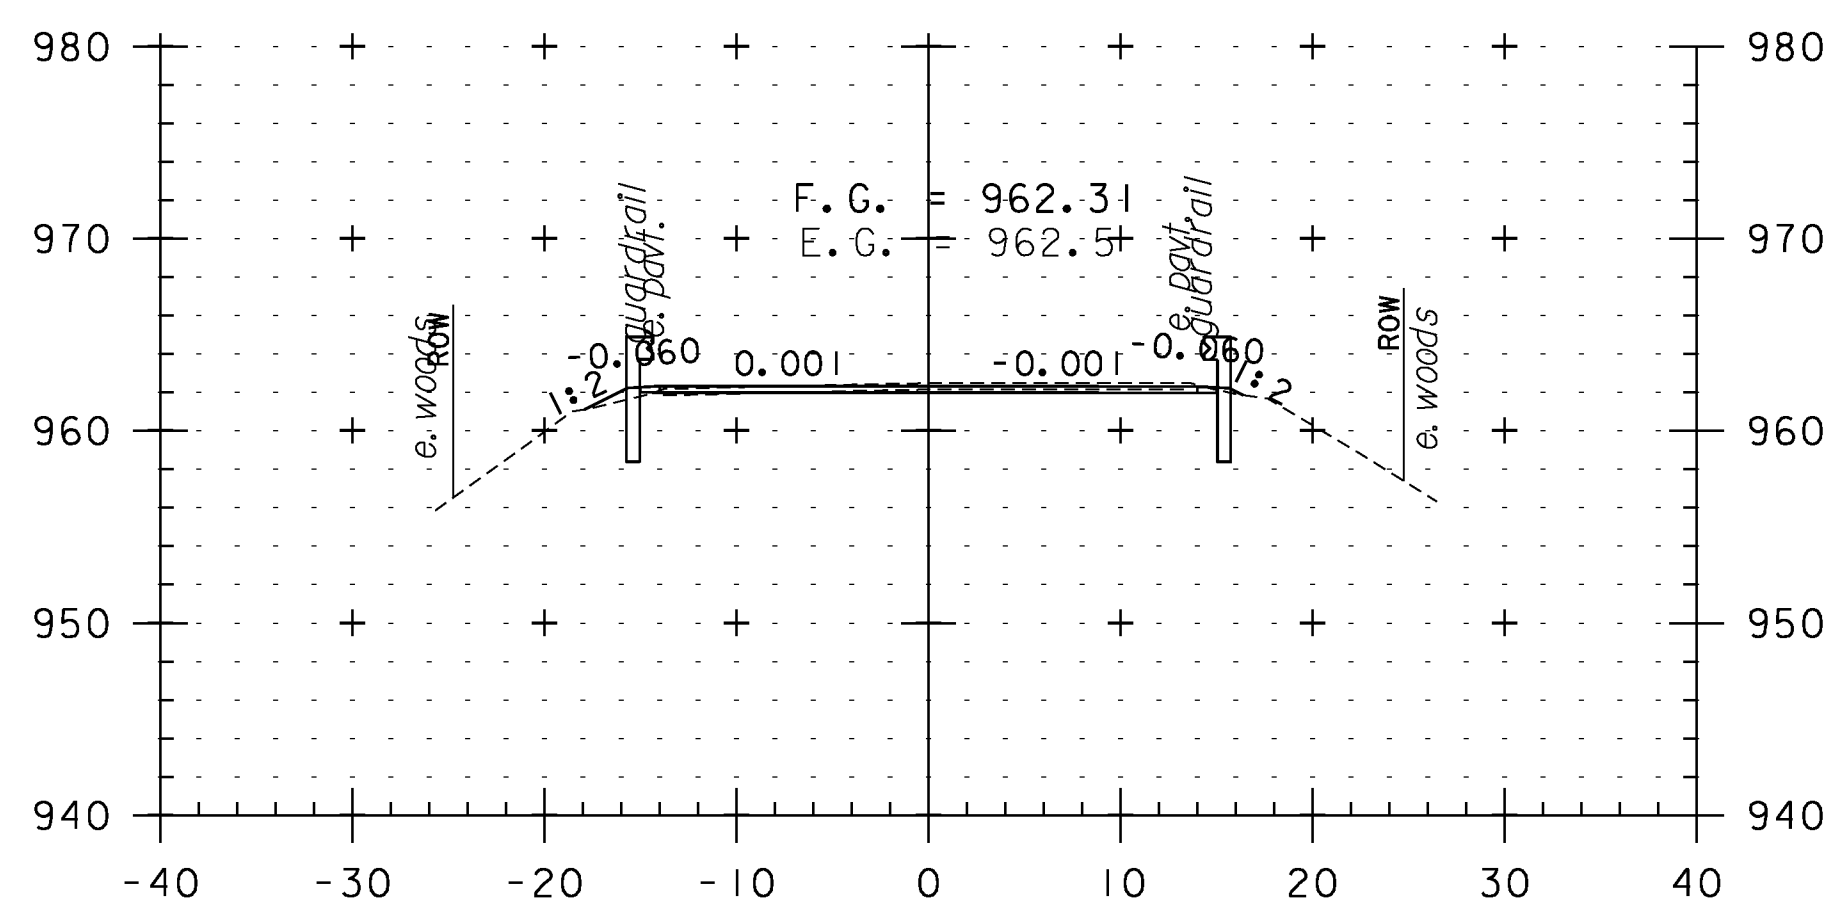


258+00

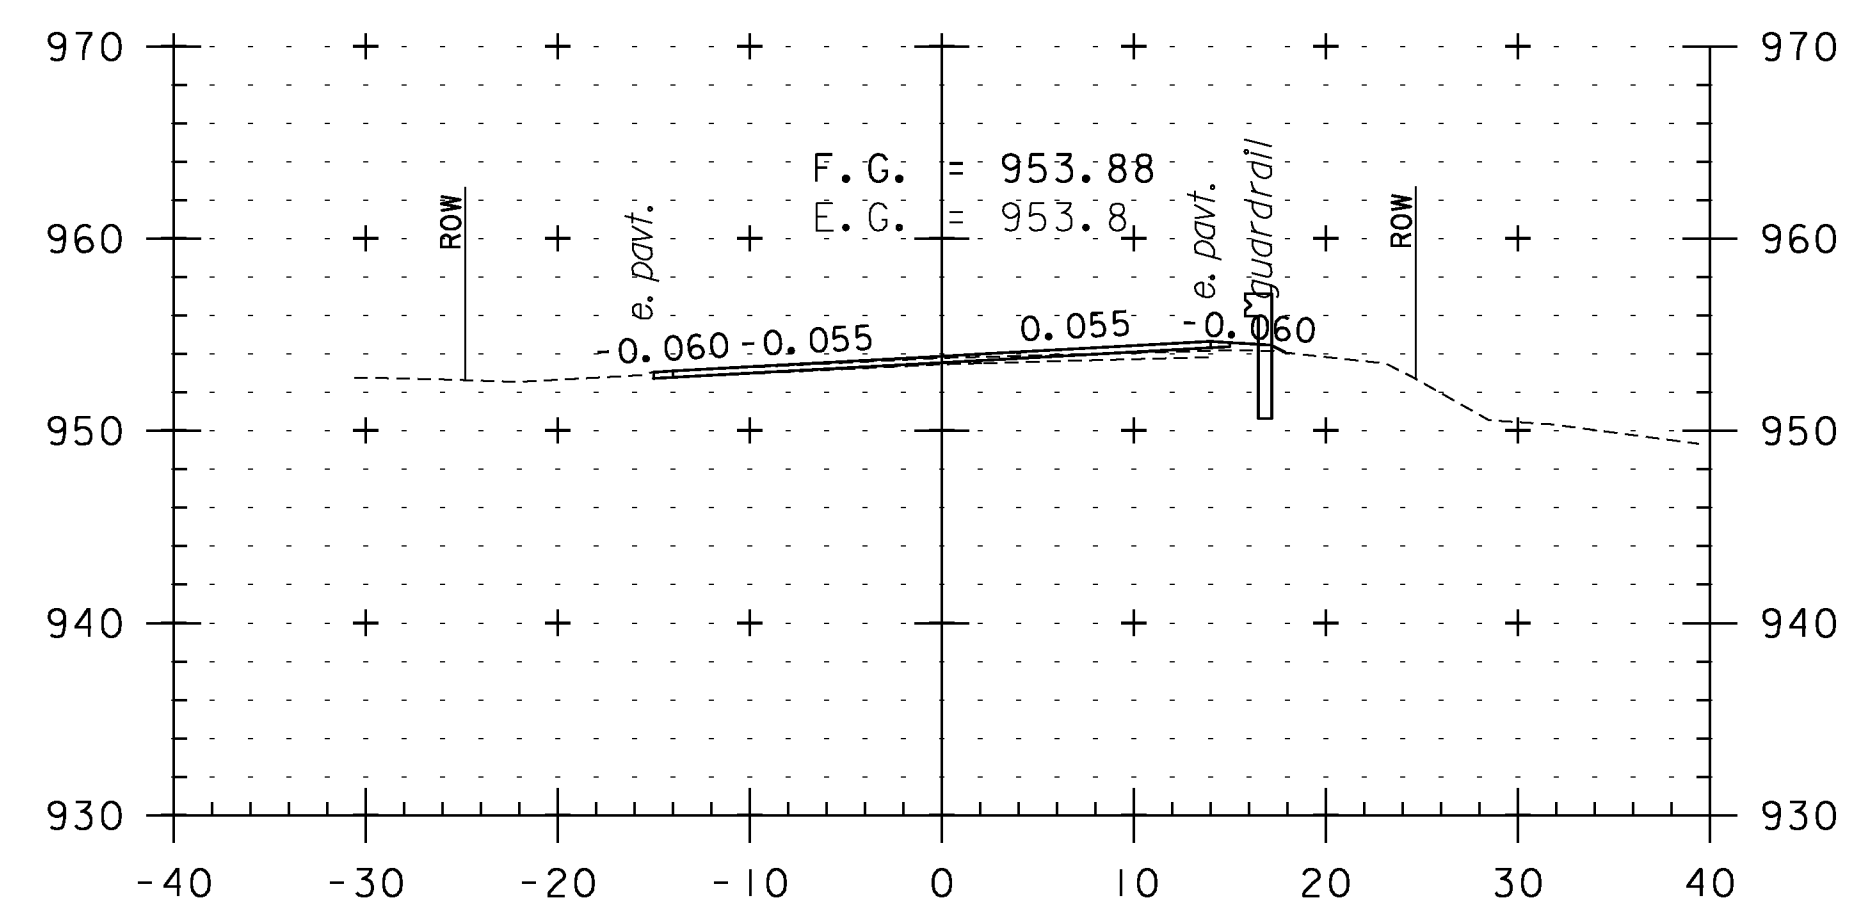

259+50

**CROSS SECTION SHEET 45**

PROJECT NAME:	WEATHERSFIELD
PROJECT NUMBER:	STP 2913(I)
FILE NAME:	I0c228
PROJECT LEADER:	PTS
DESIGNED BY:	NLL
IPARM FILE NAME:	pI0C228.I35
PLOT DATE:	2/7/2013
DRAWN BY:	WWG
CHECKED BY:	PTS
SHEET	135 OF 234

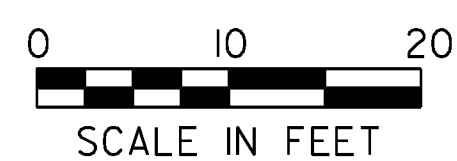

STA. 256+50 TO STA. 260+50