




282+50

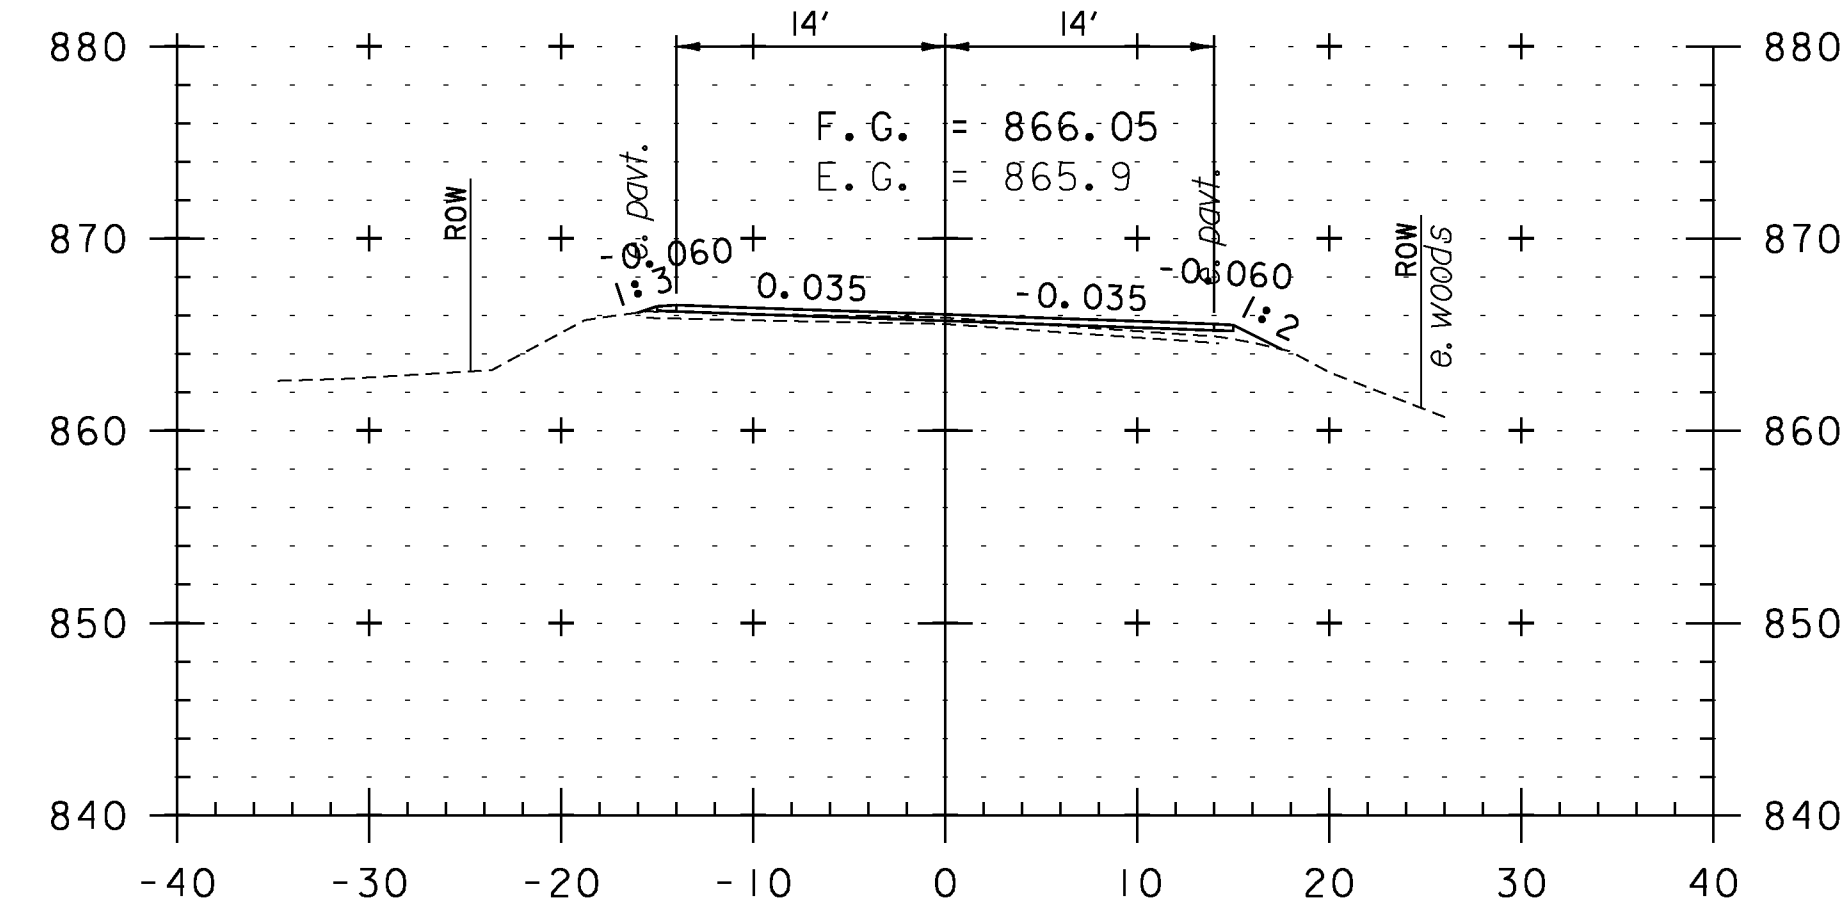


282+00

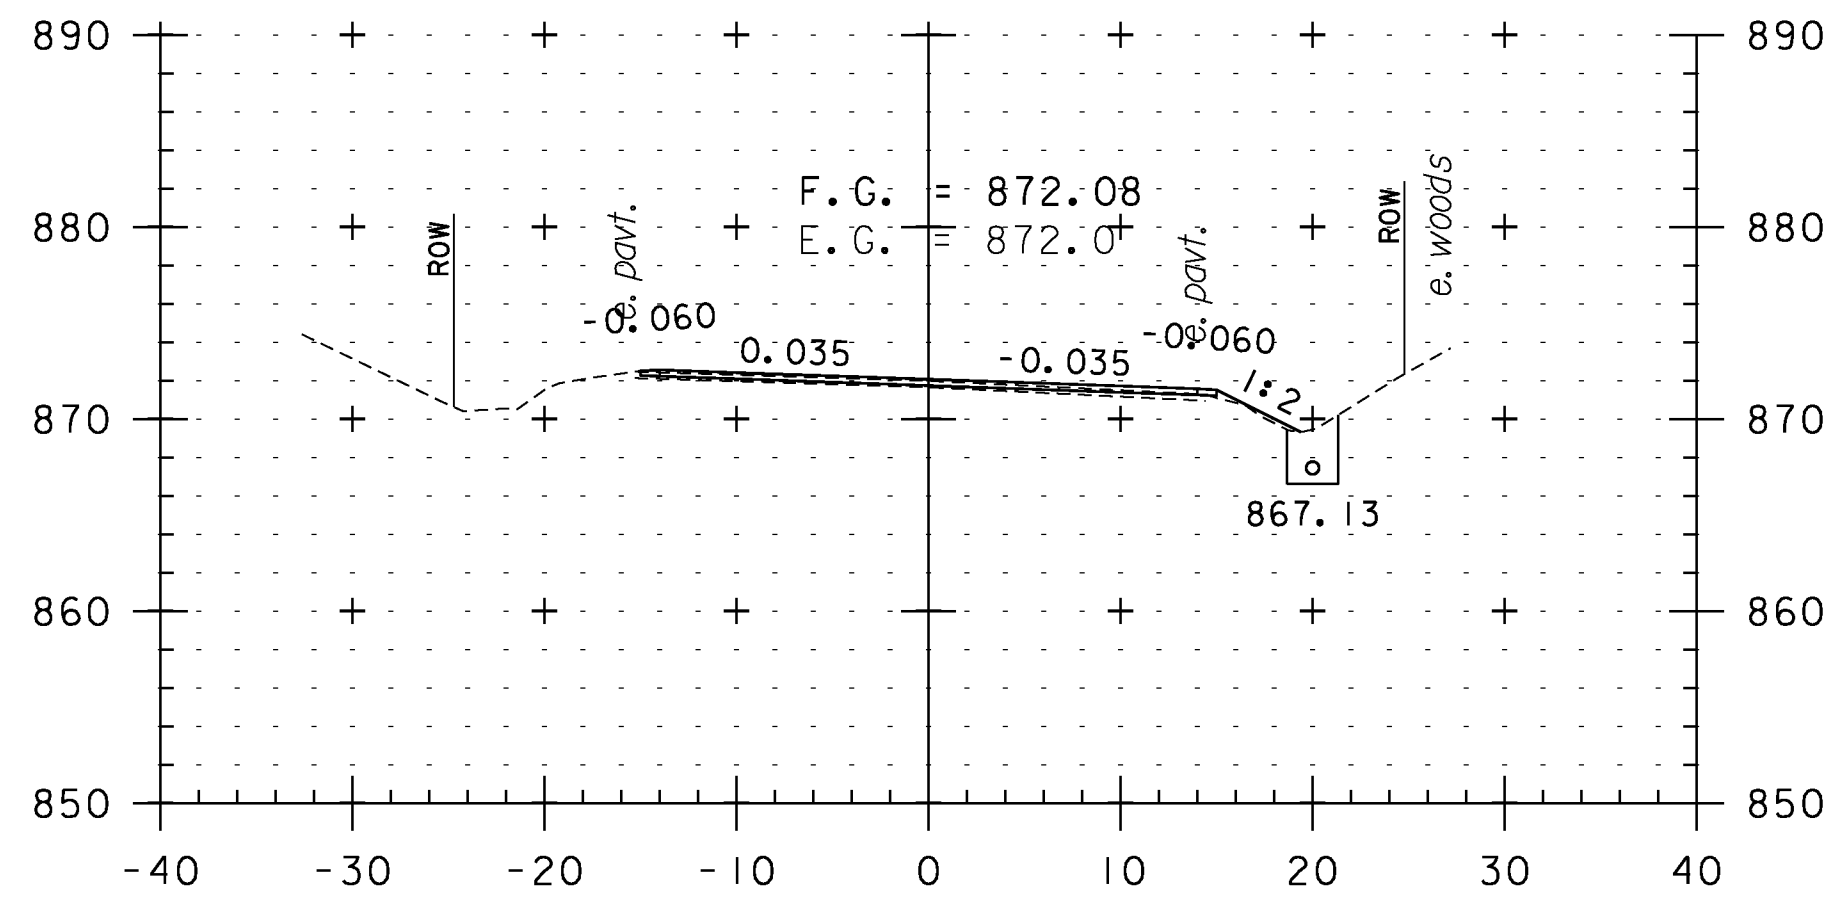


284+00

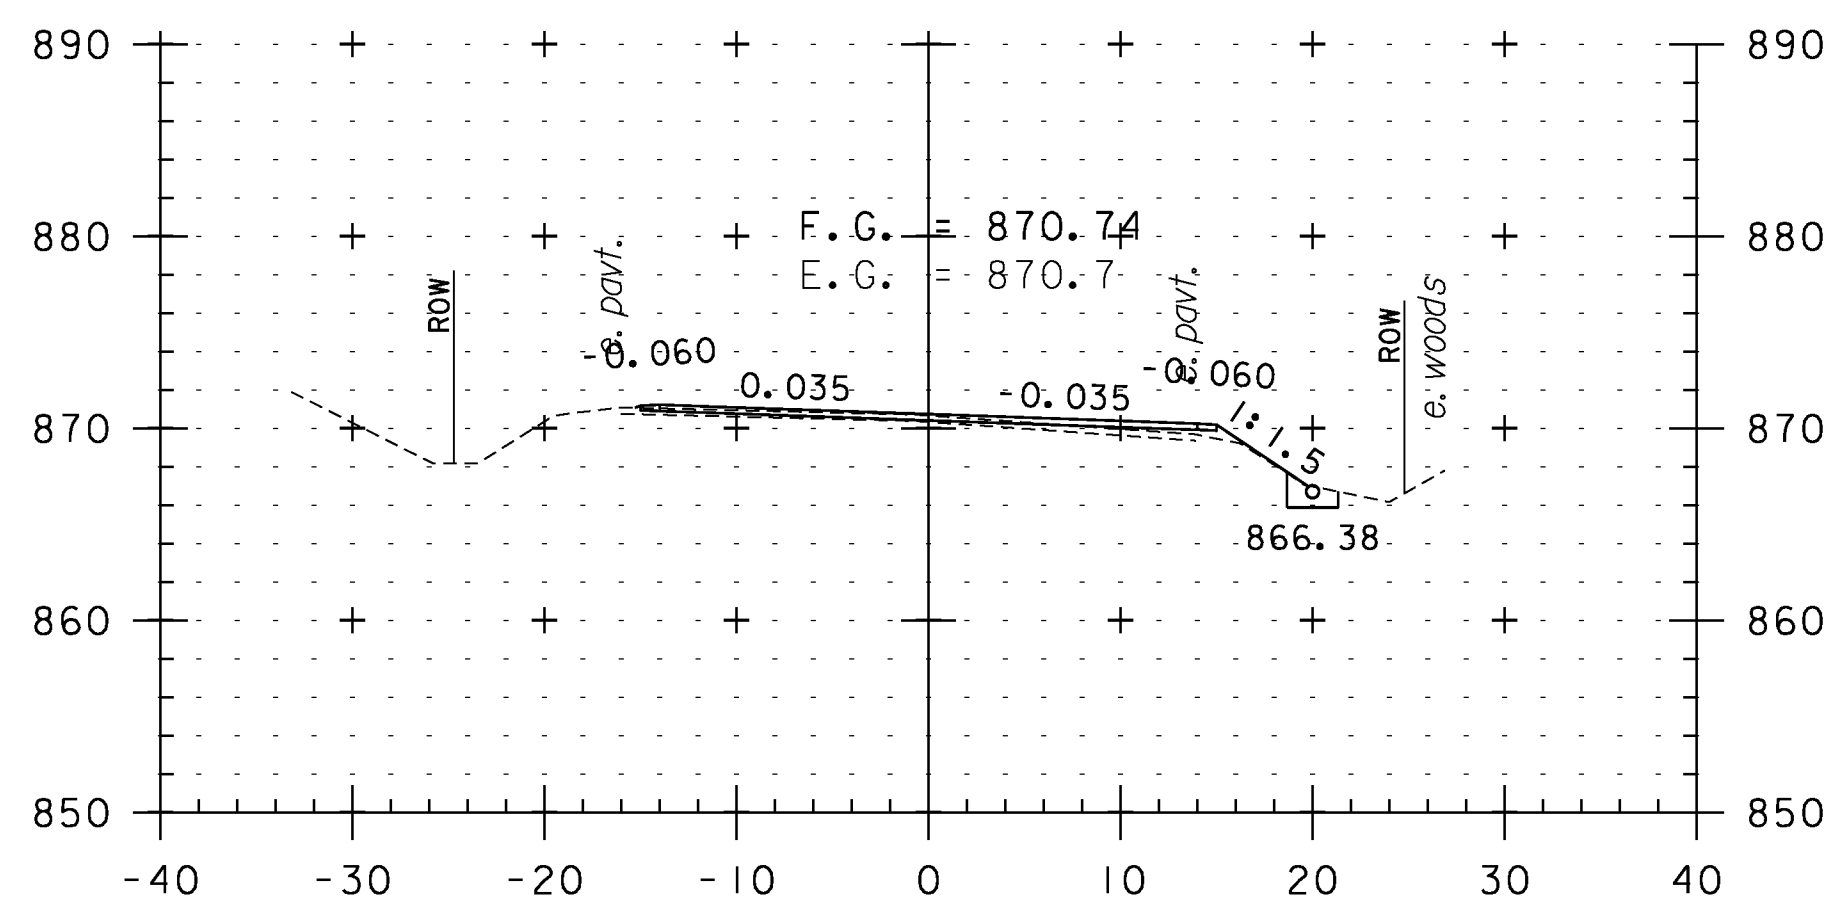


283+50

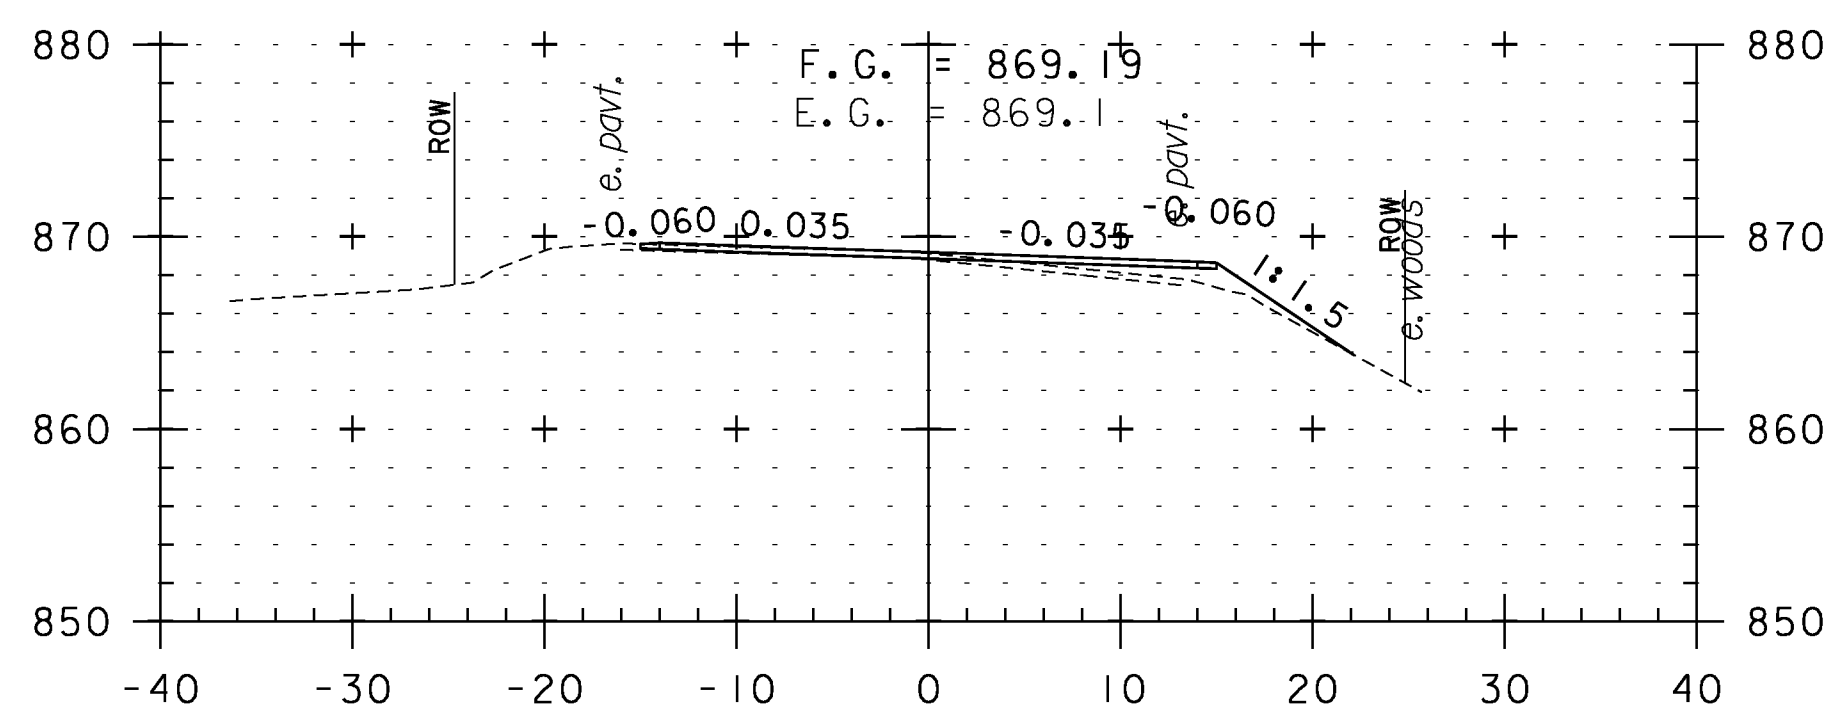


283+00

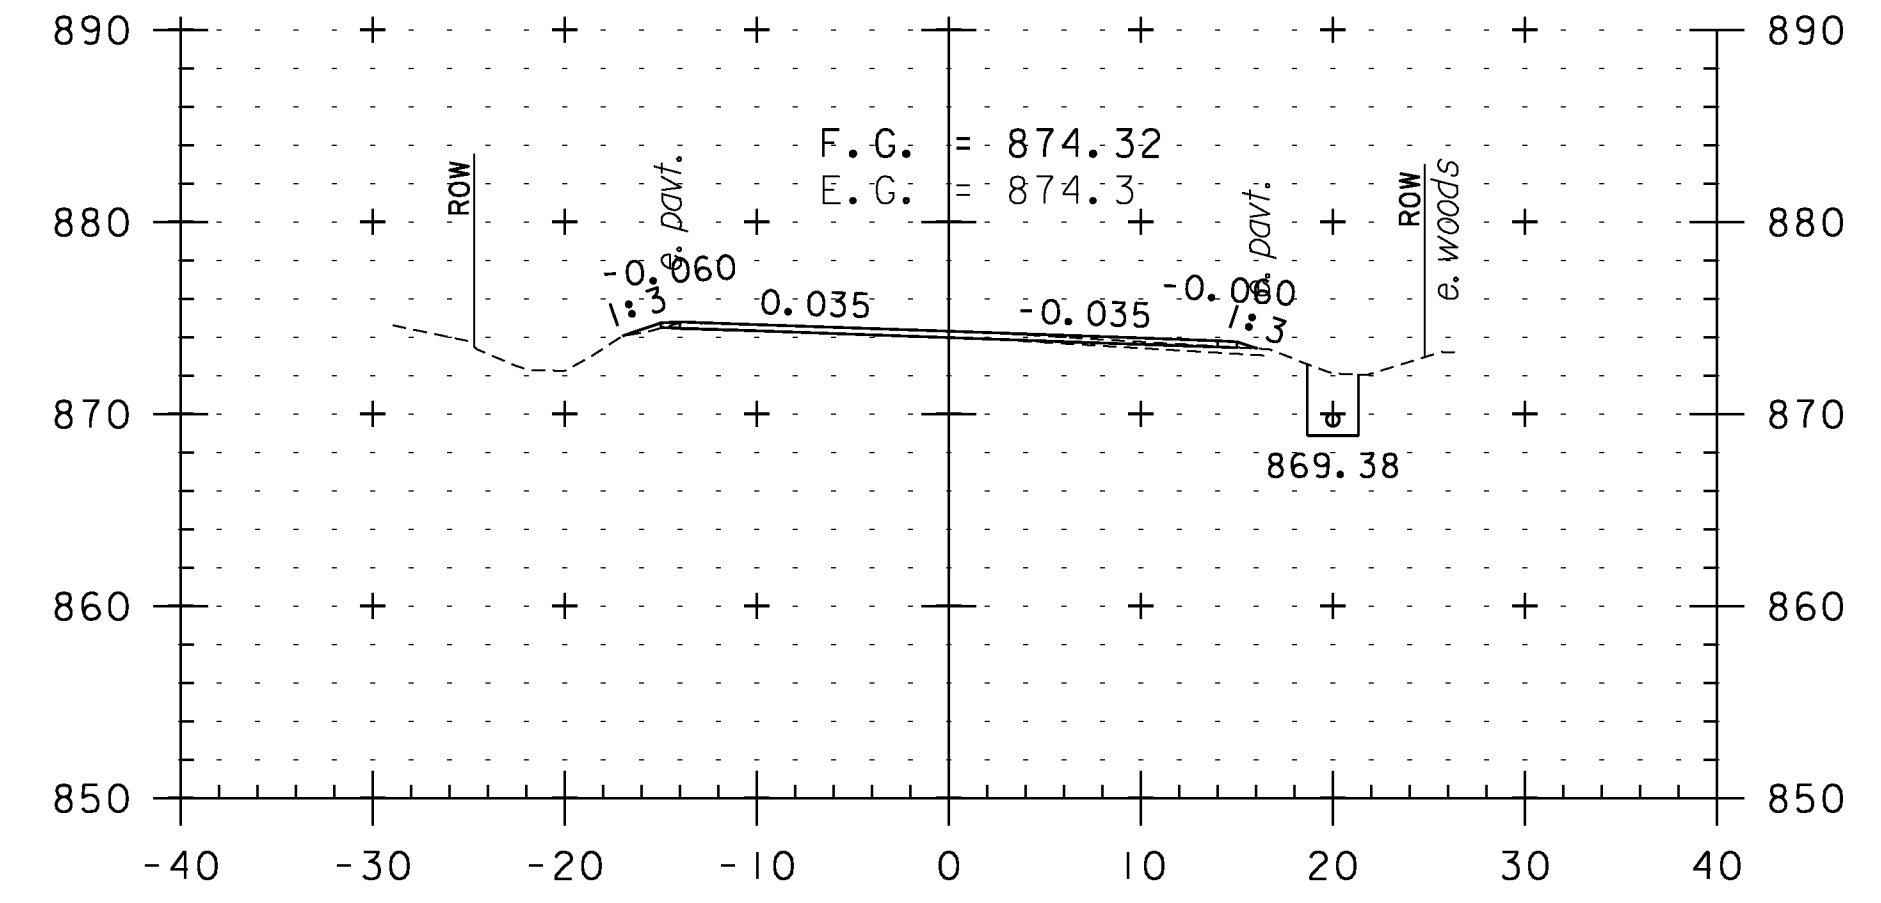

285+50

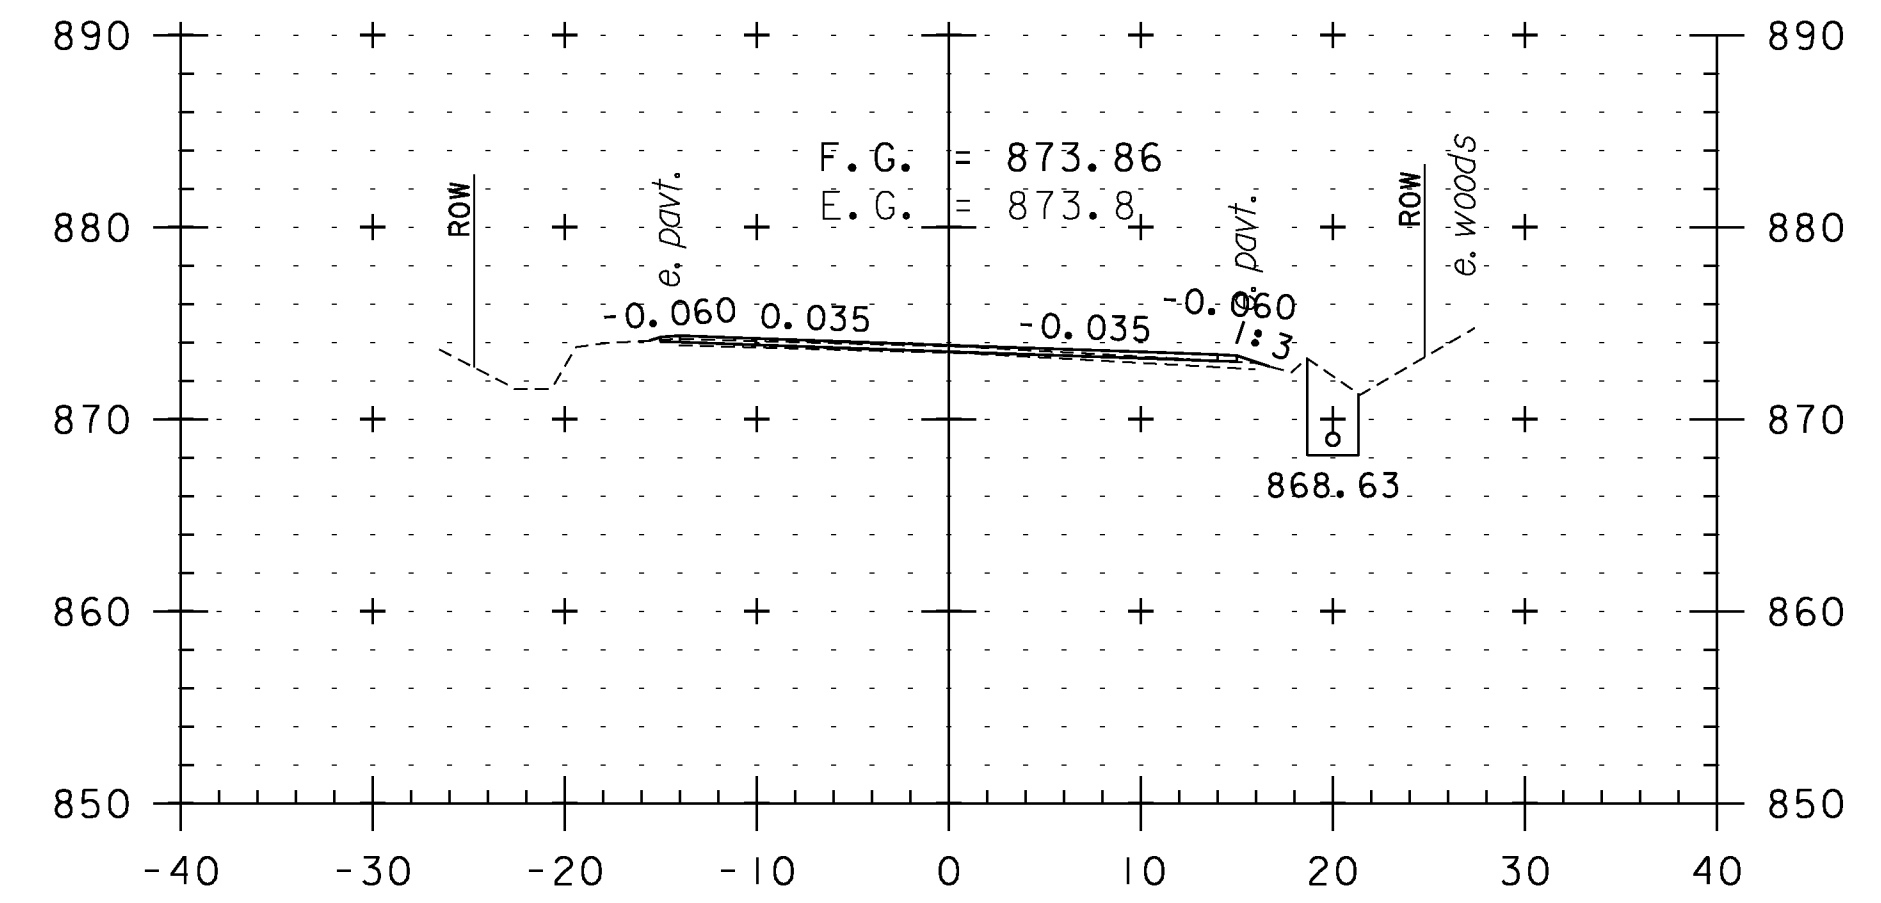

285+00

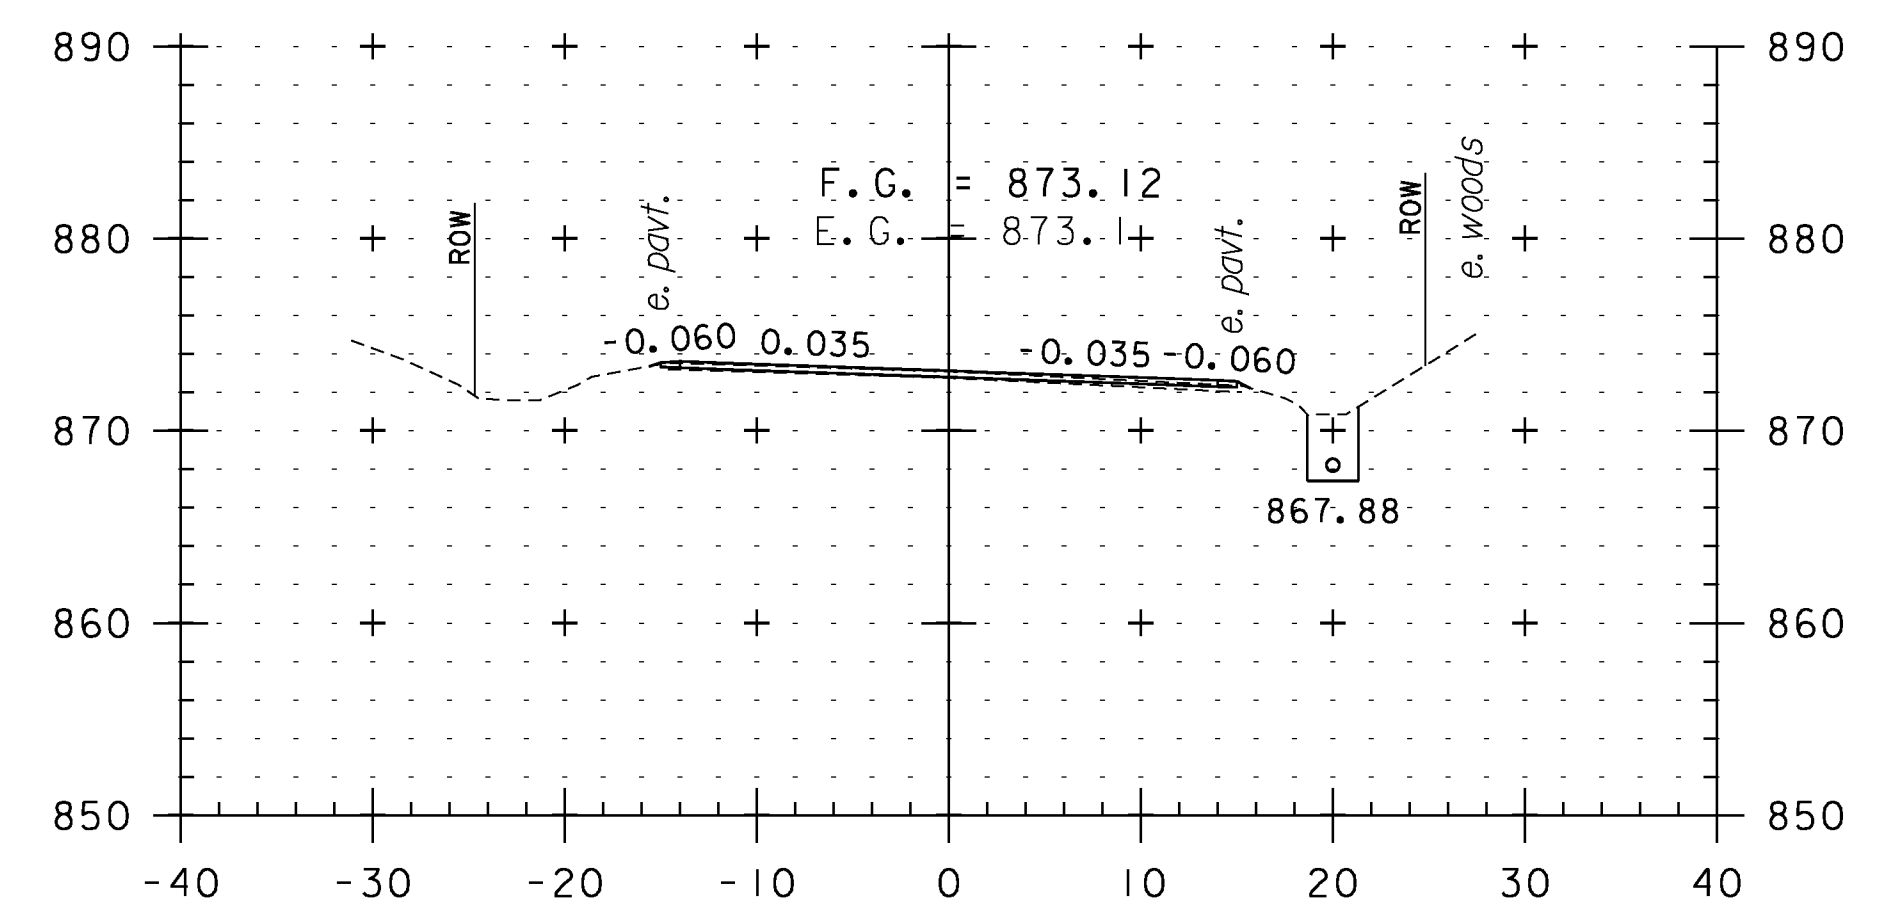

284+50

**CROSS SECTION SHEET 51**

PROJECT NAME: WEATHERSFIELD

PROJECT NUMBER: STP 2913(I)

FILE NAME: I0c228

PROJECT LEADER: PTS

DESIGNED BY: NLL


IPARM FILE NAME: pI0C228\_I41

PLOT DATE: 2/7/2013

DRAWN BY: WWG

CHECKED BY: PTS

SHEET 141 OF 234

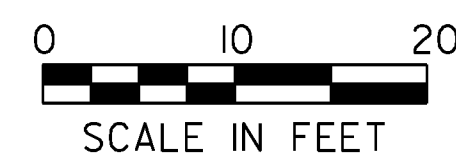

STA. 282+00 TO STA. 285+50