




291+50

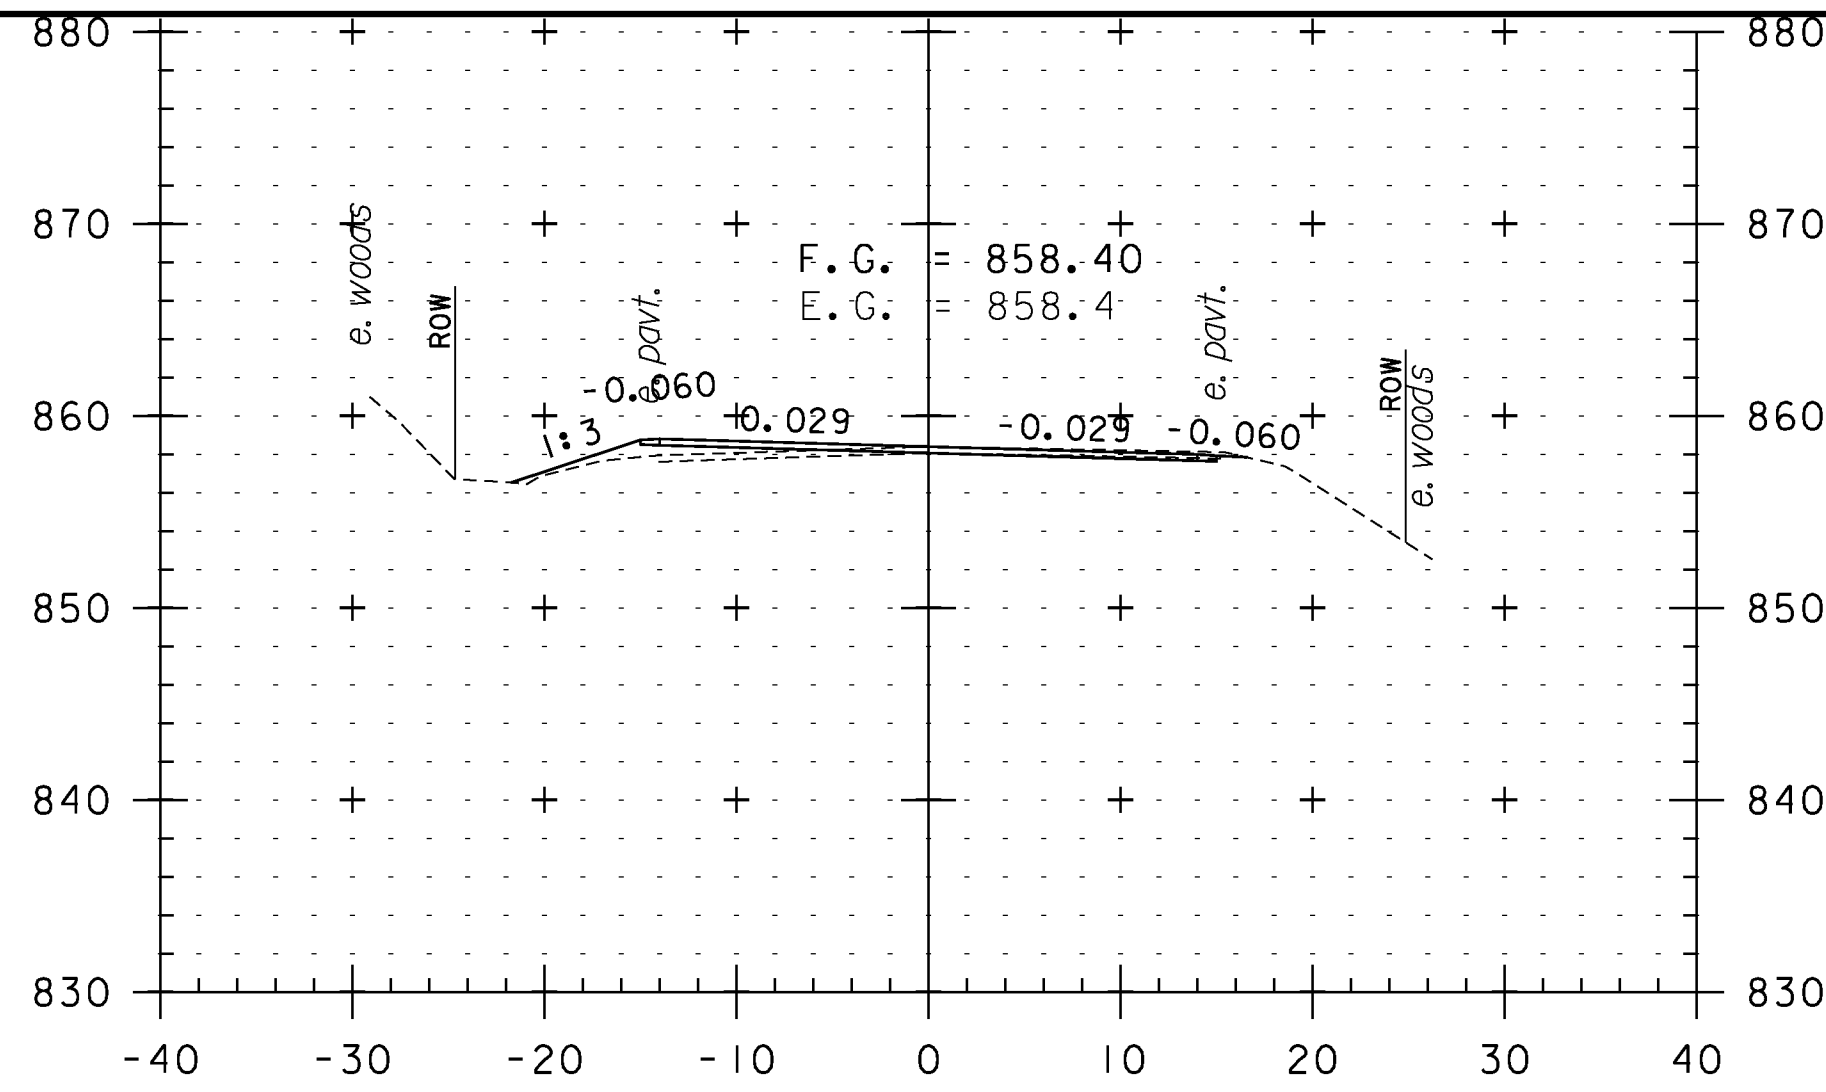


293+00

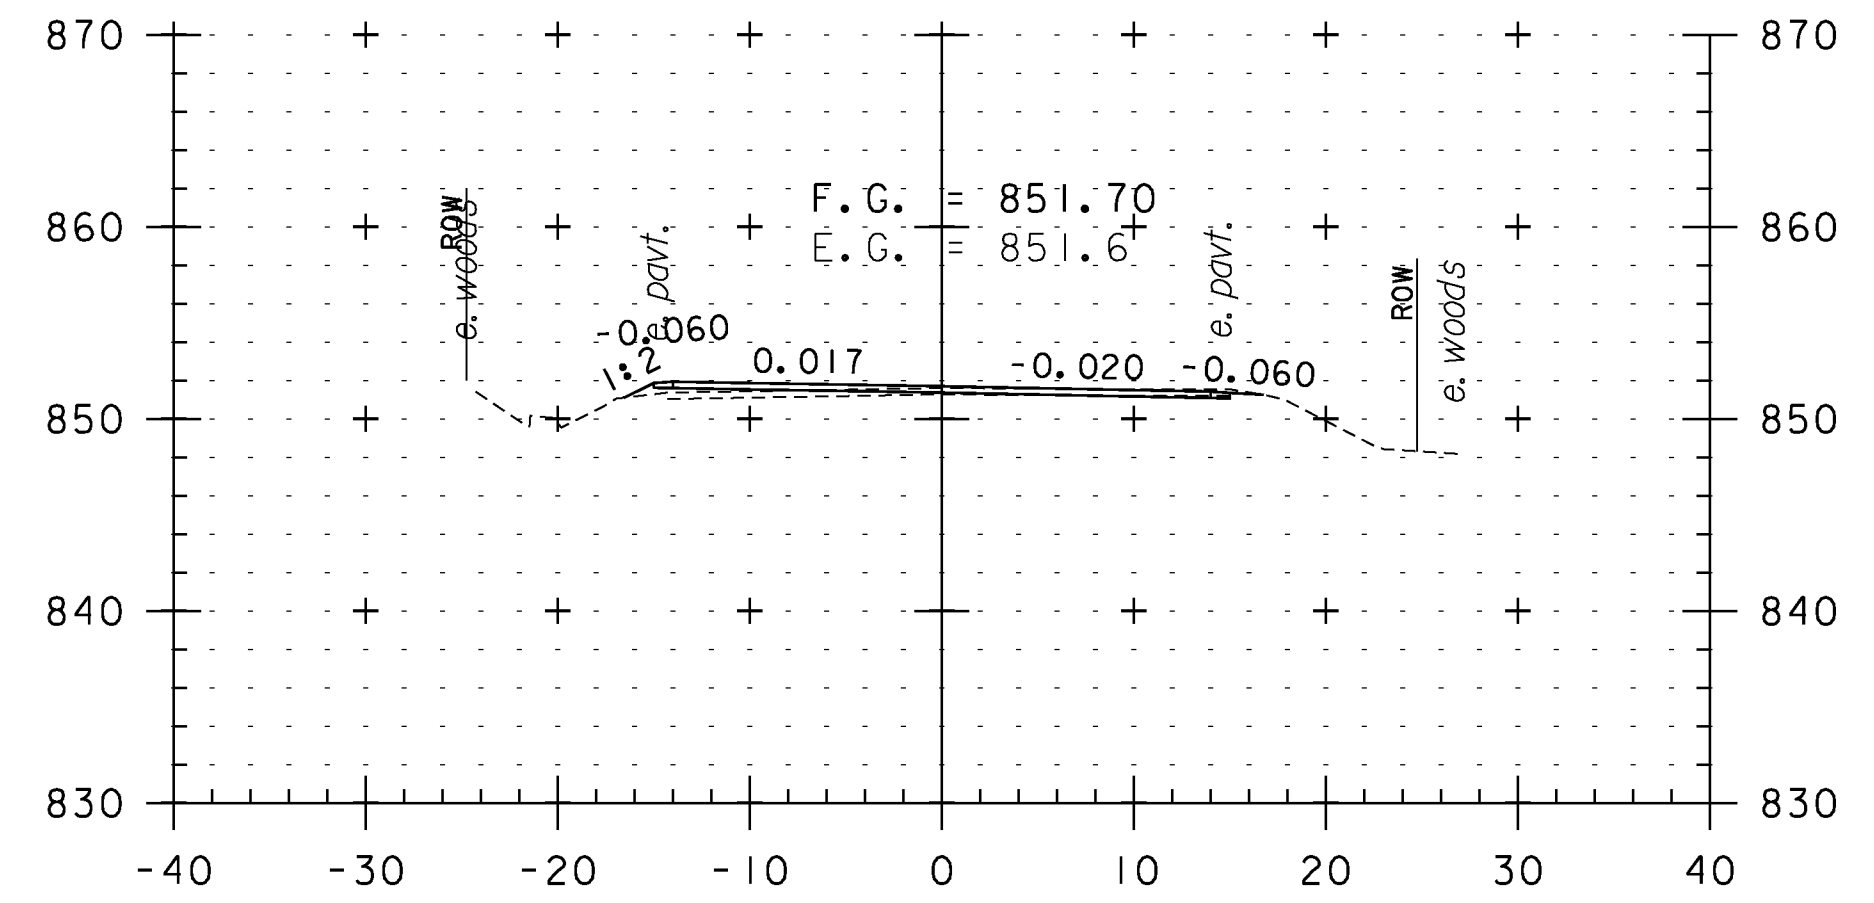


294+50

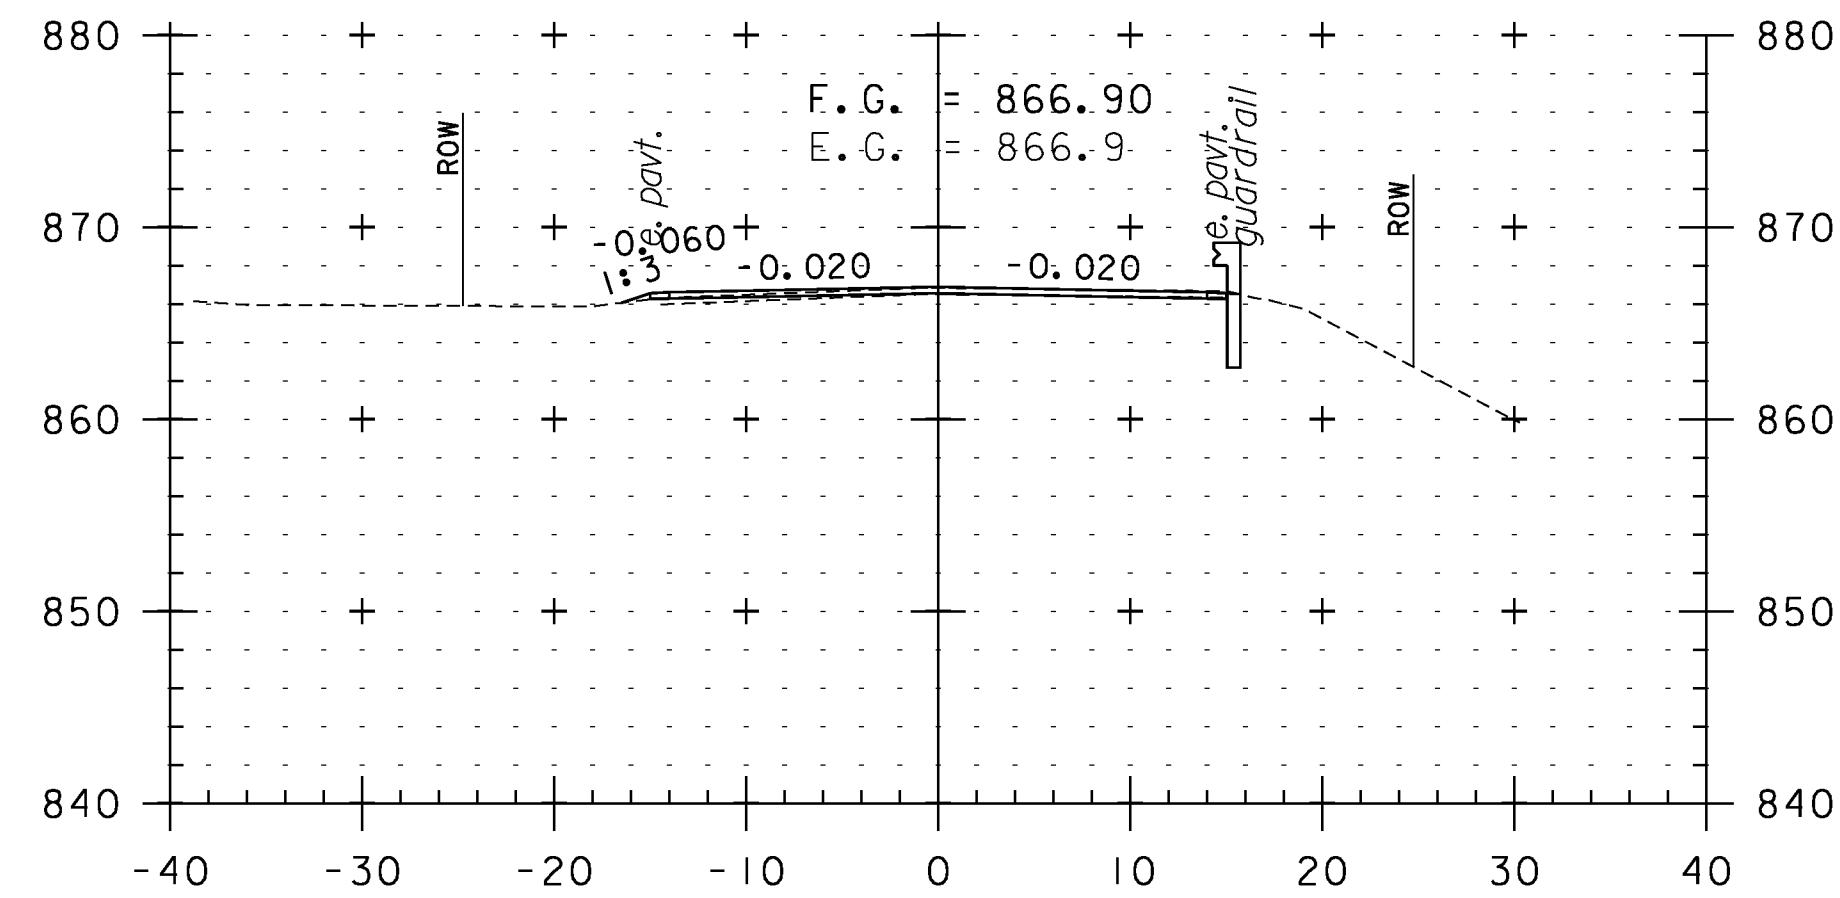


291+00

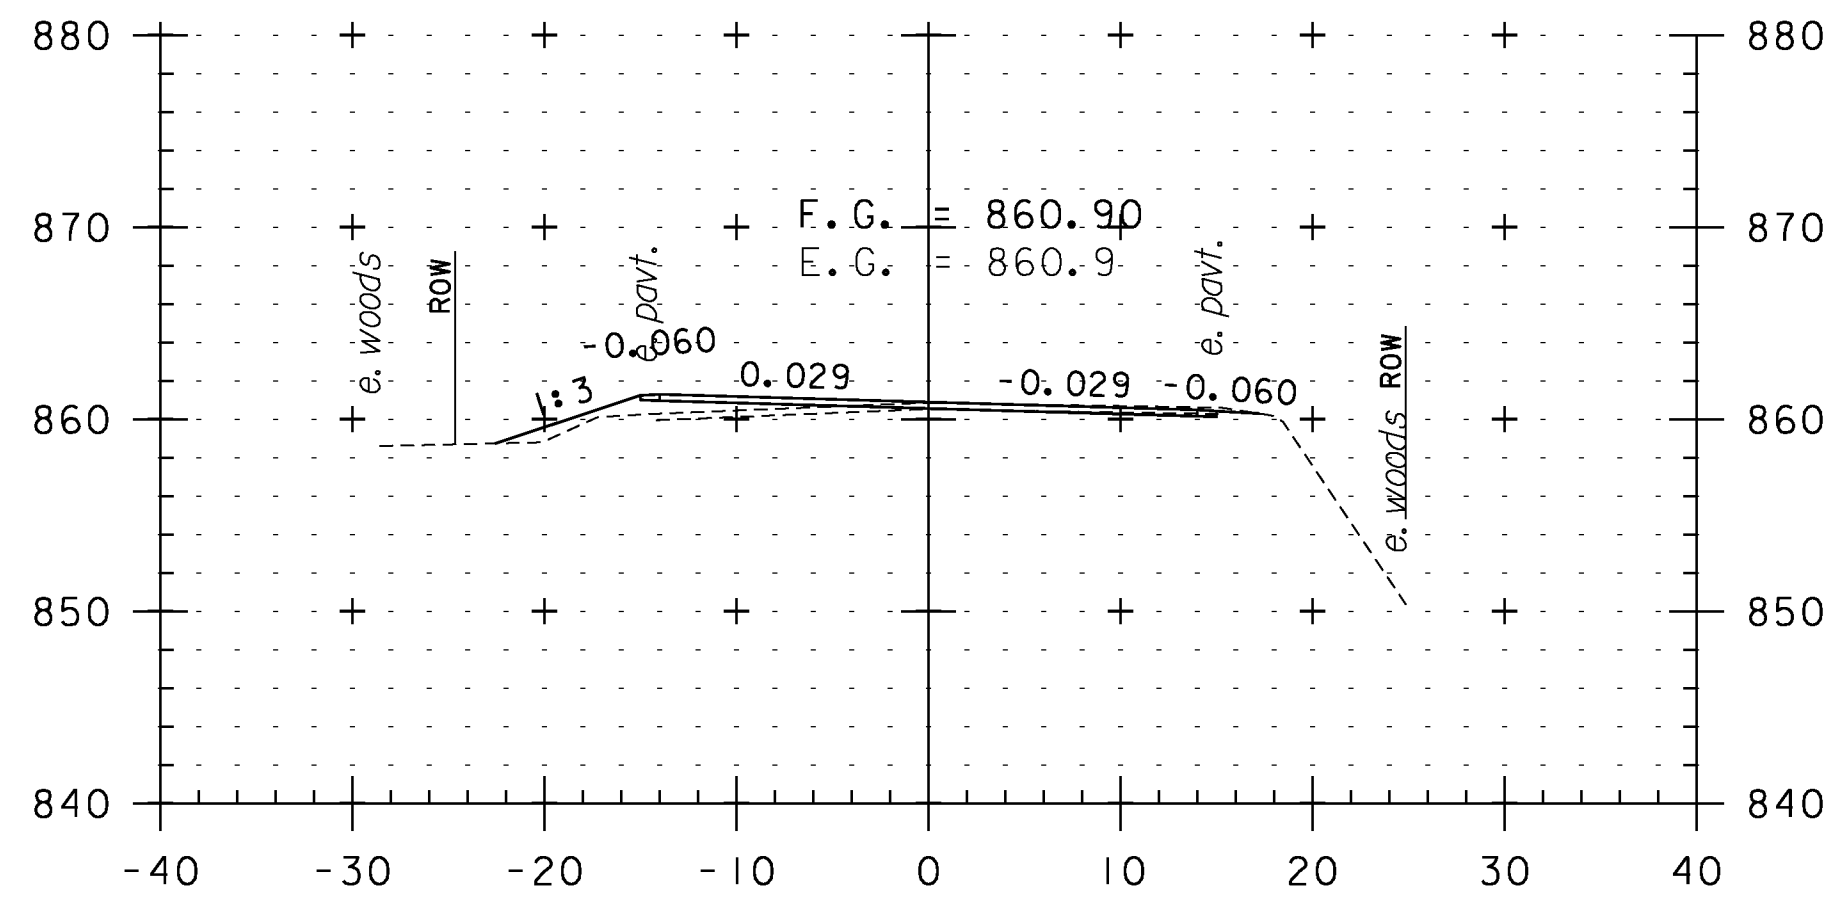


292+50

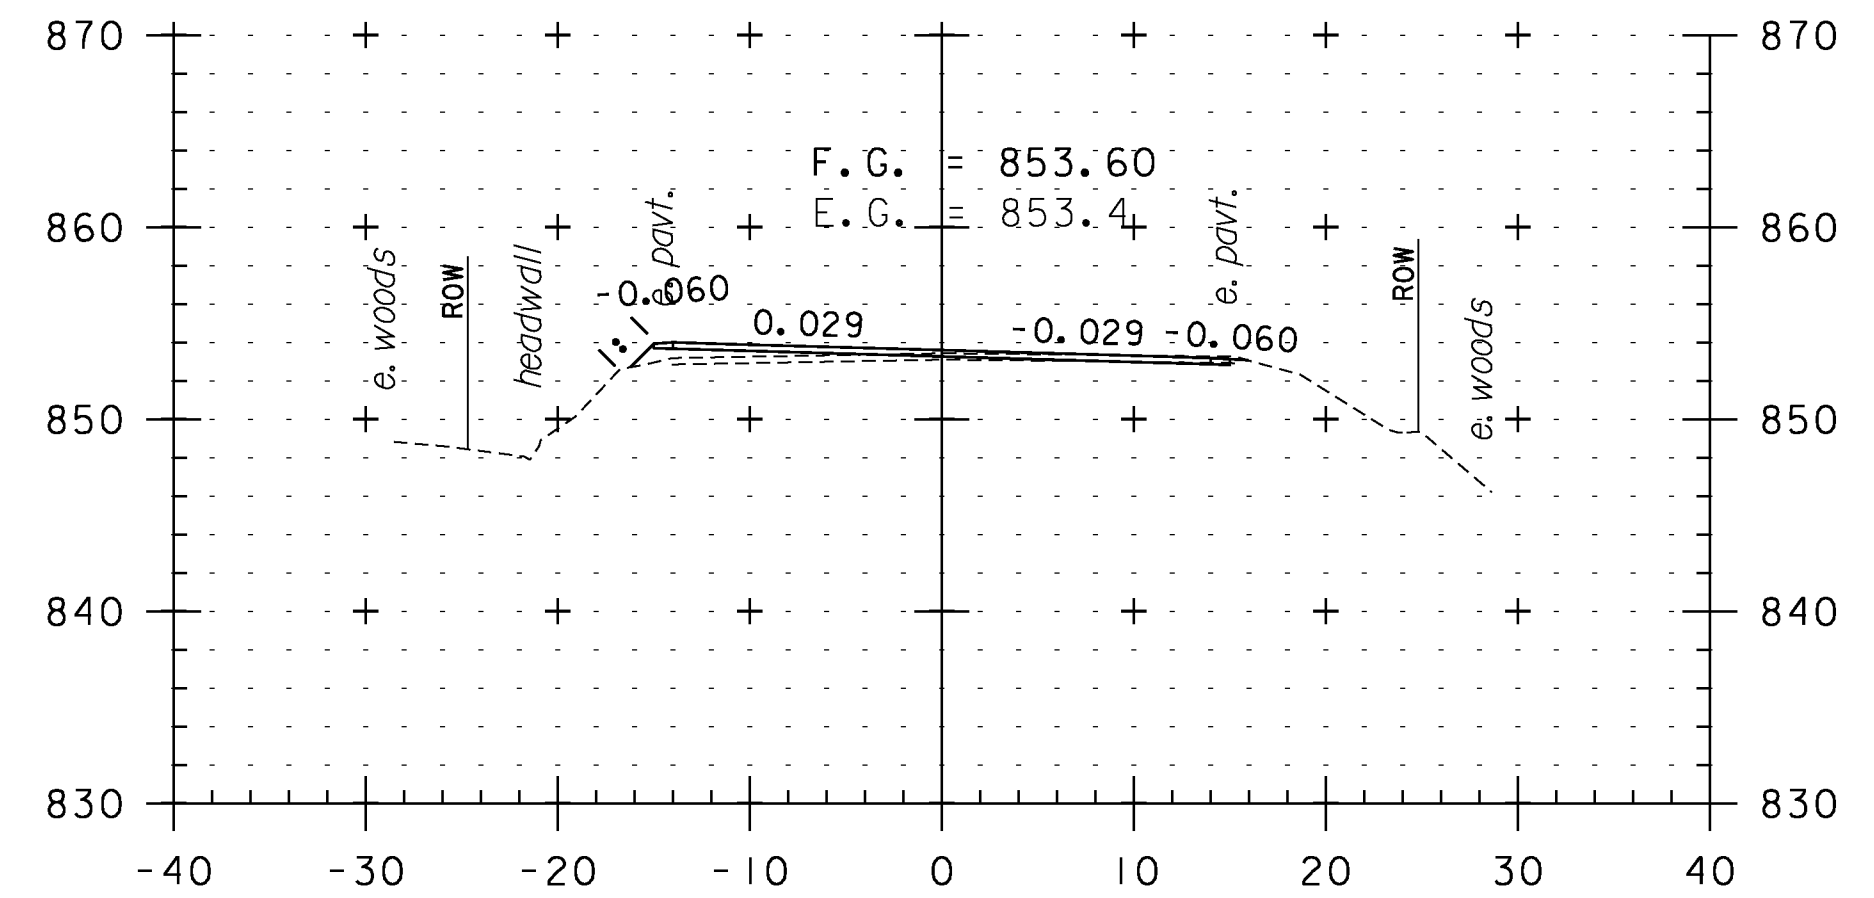


294+00

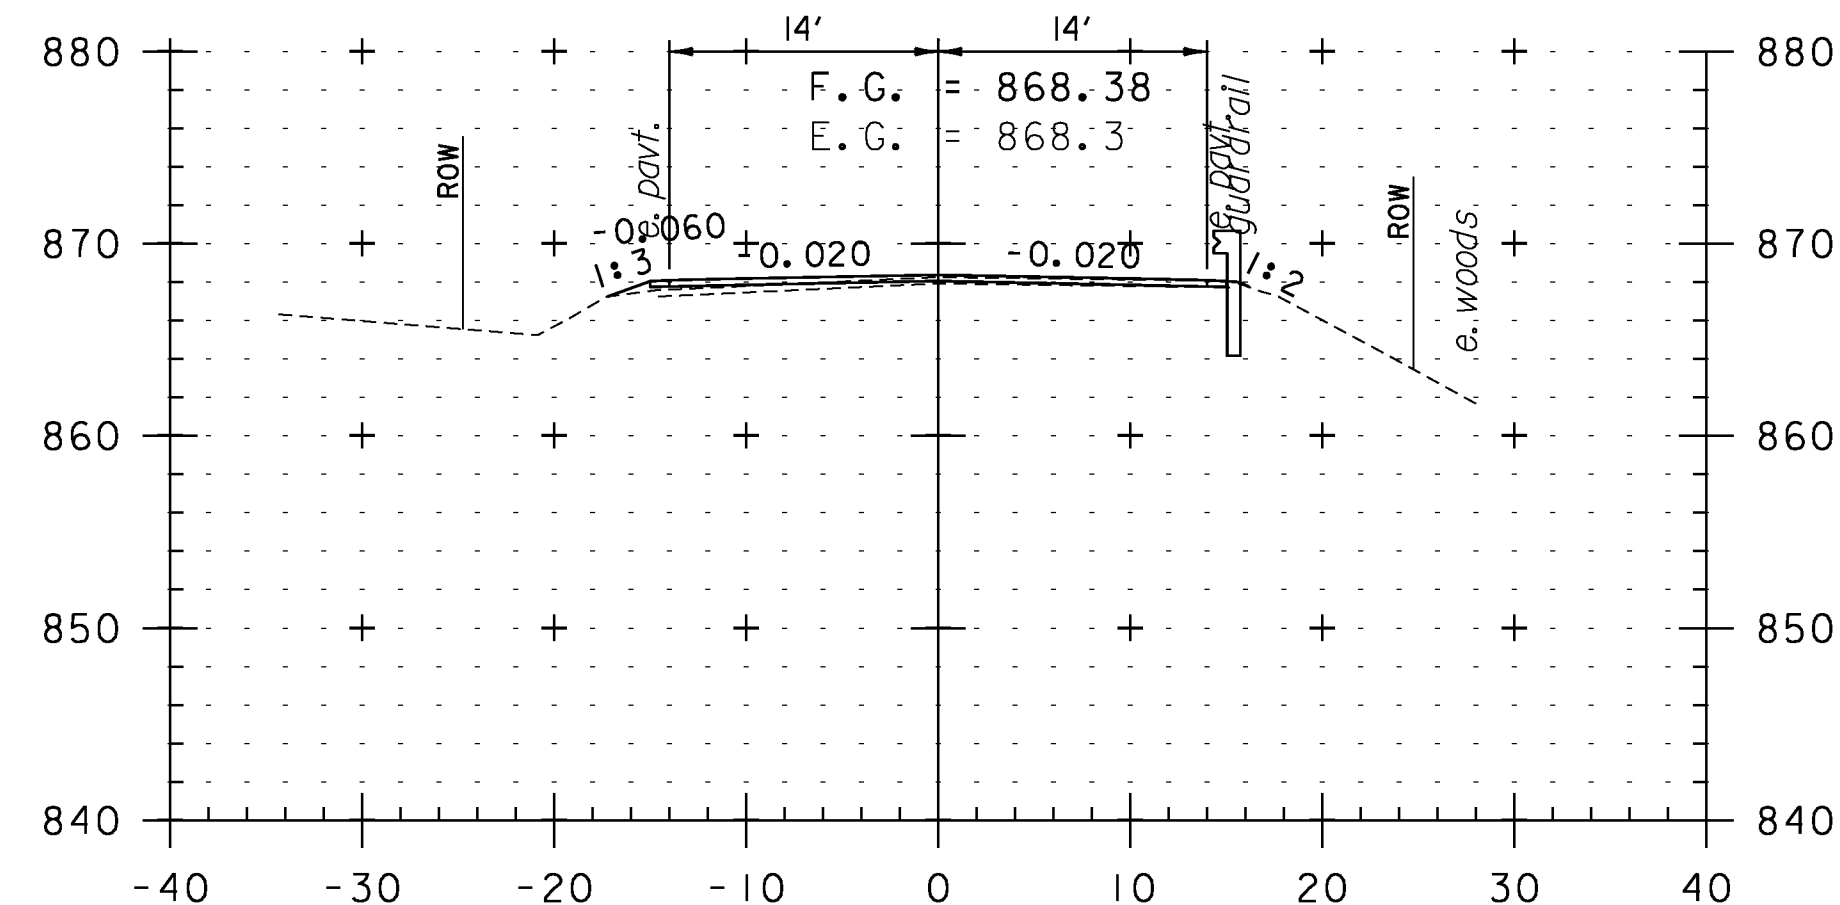

290+50

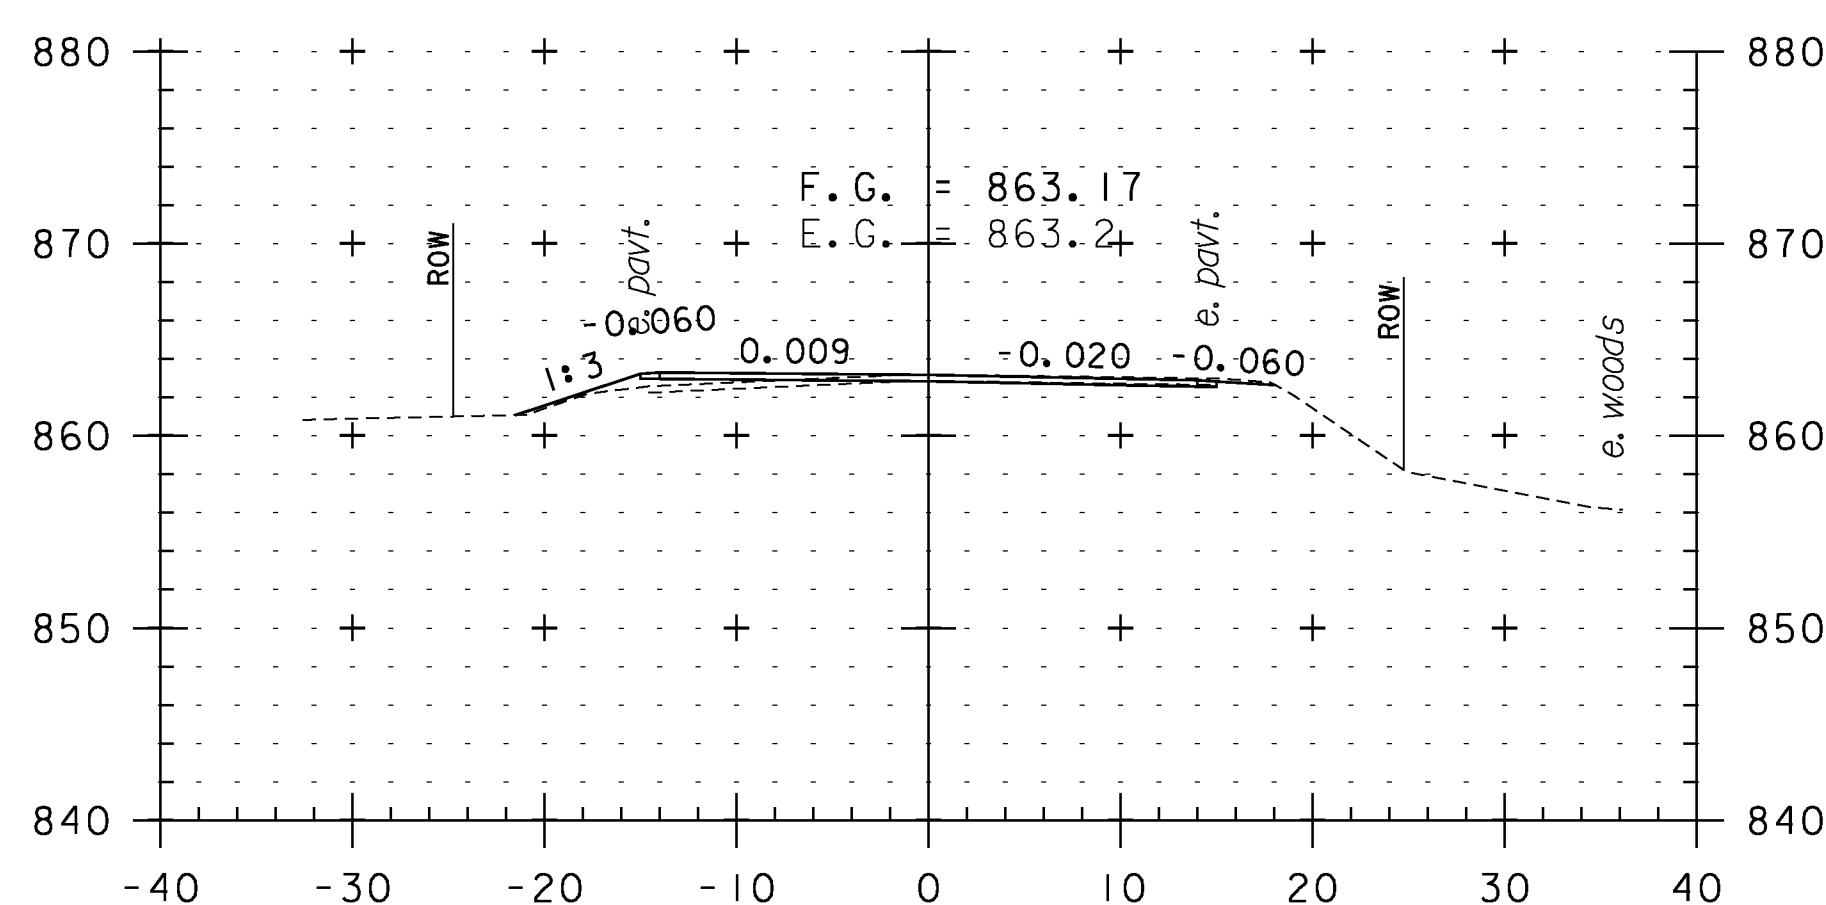

292+00

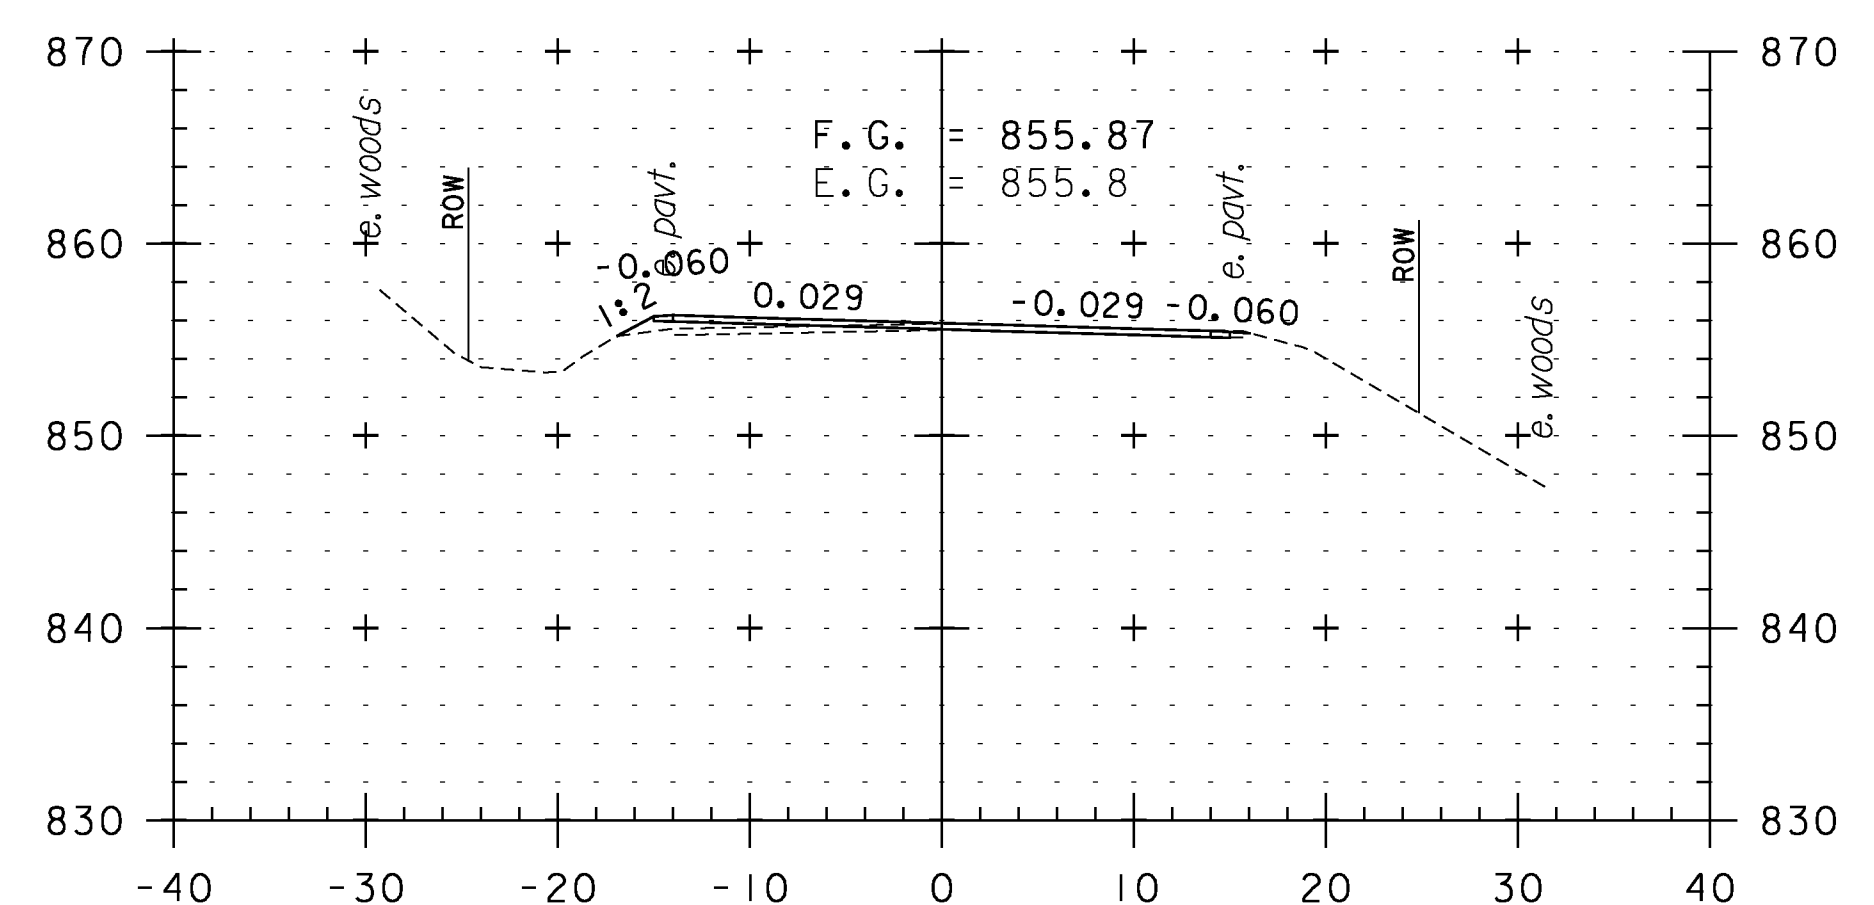

293+50

CROSS SECTION SHEET 53

PROJECT NAME:	WEATHERSFIELD
PROJECT NUMBER:	STP 2913(I)
FILE NAME:	I0c228
PROJECT LEADER:	PTS
DESIGNED BY:	NLL
IPARM FILE NAME:	pI0c228_I43
PLOT DATE:	2/7/2013
DRAWN BY:	WWG
CHECKED BY:	PTS
SHEET	143 OF 234



STA. 290+50 TO STA. 294+50