




300+50

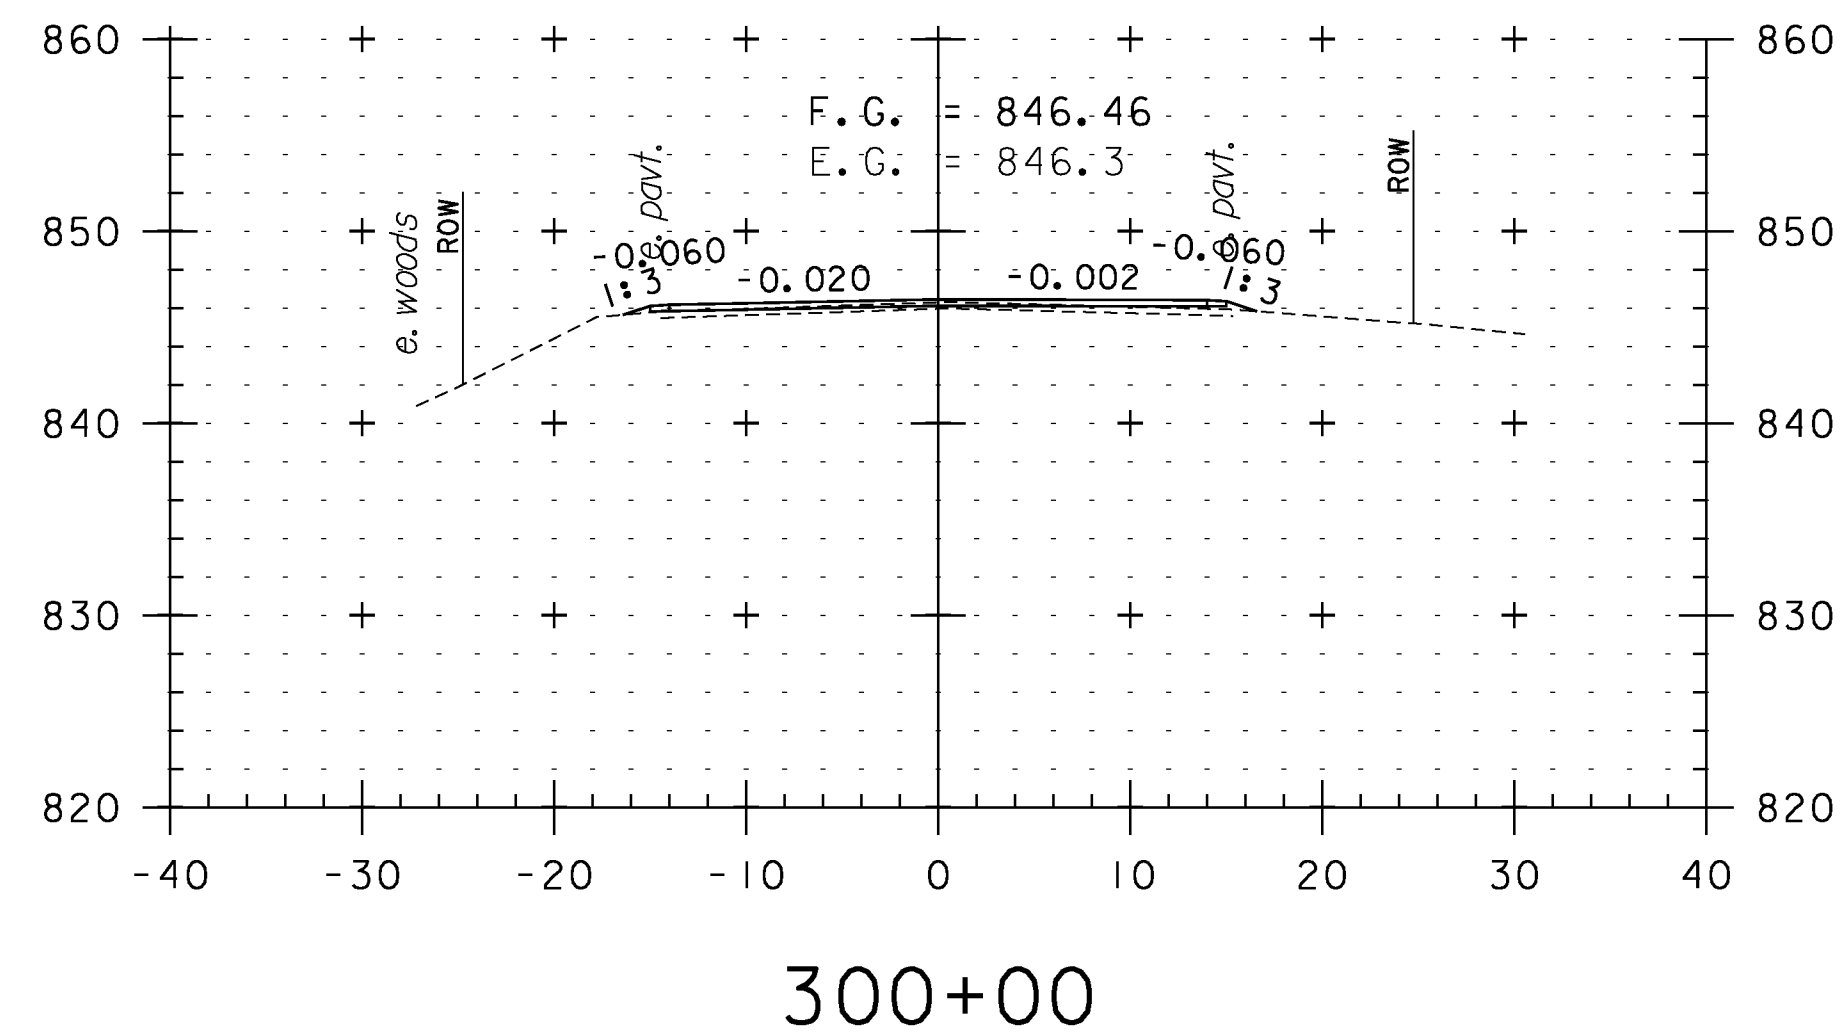


300+00

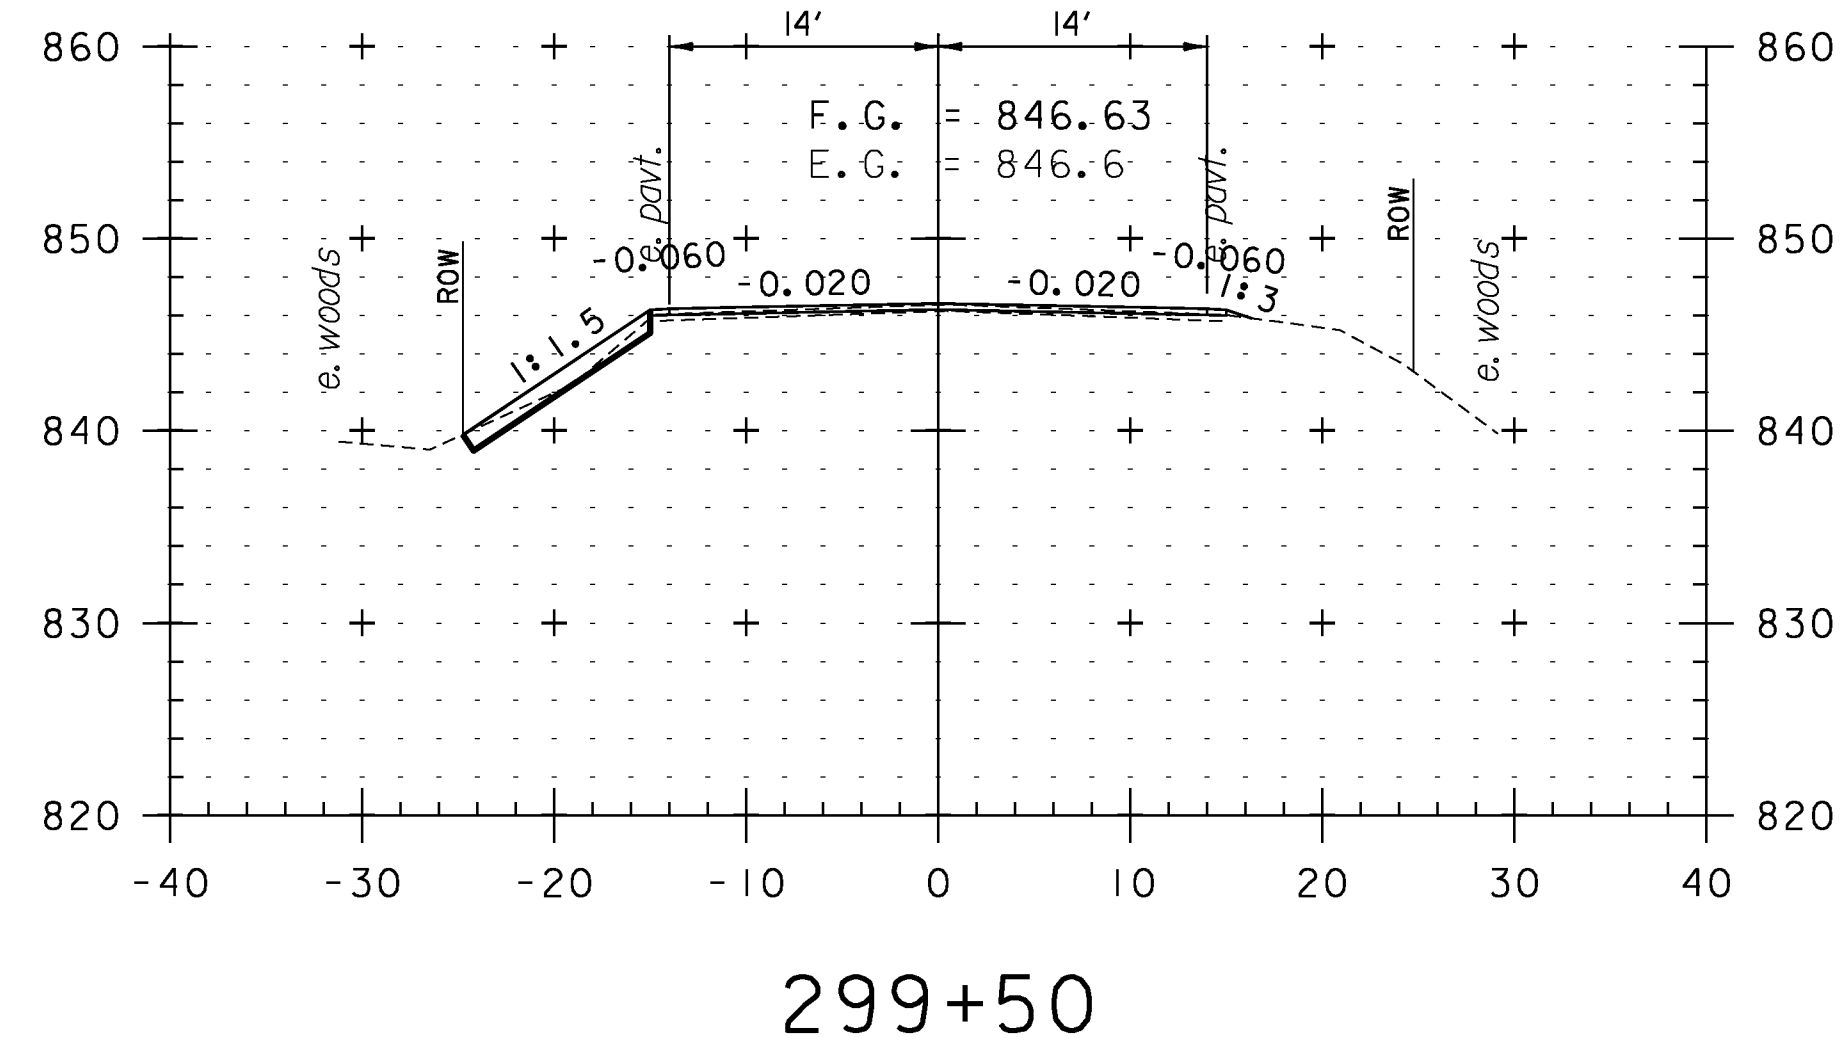


299+50

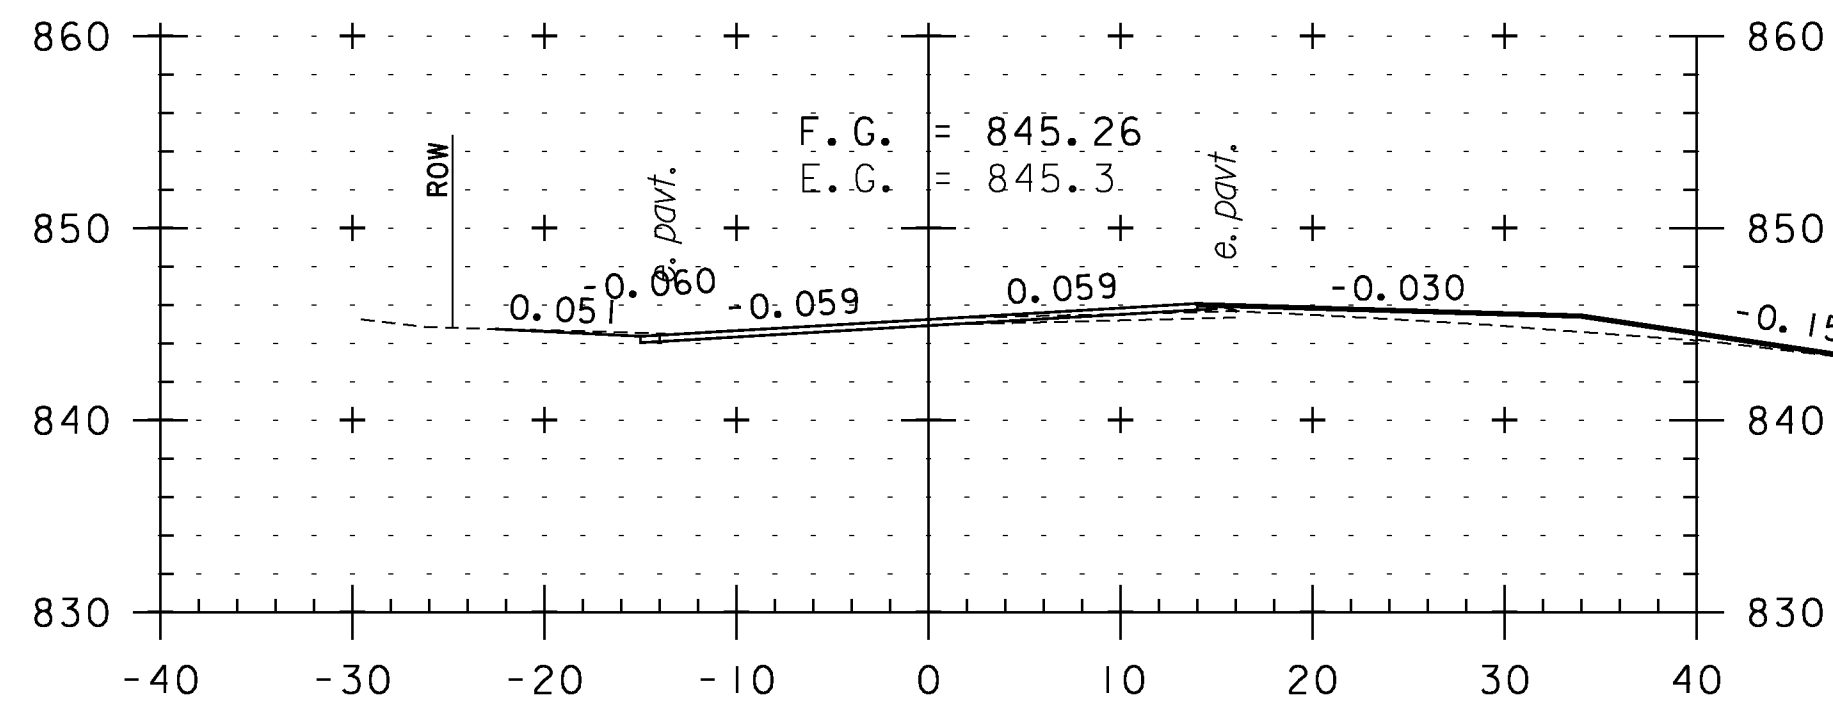


301+65  
TH 14

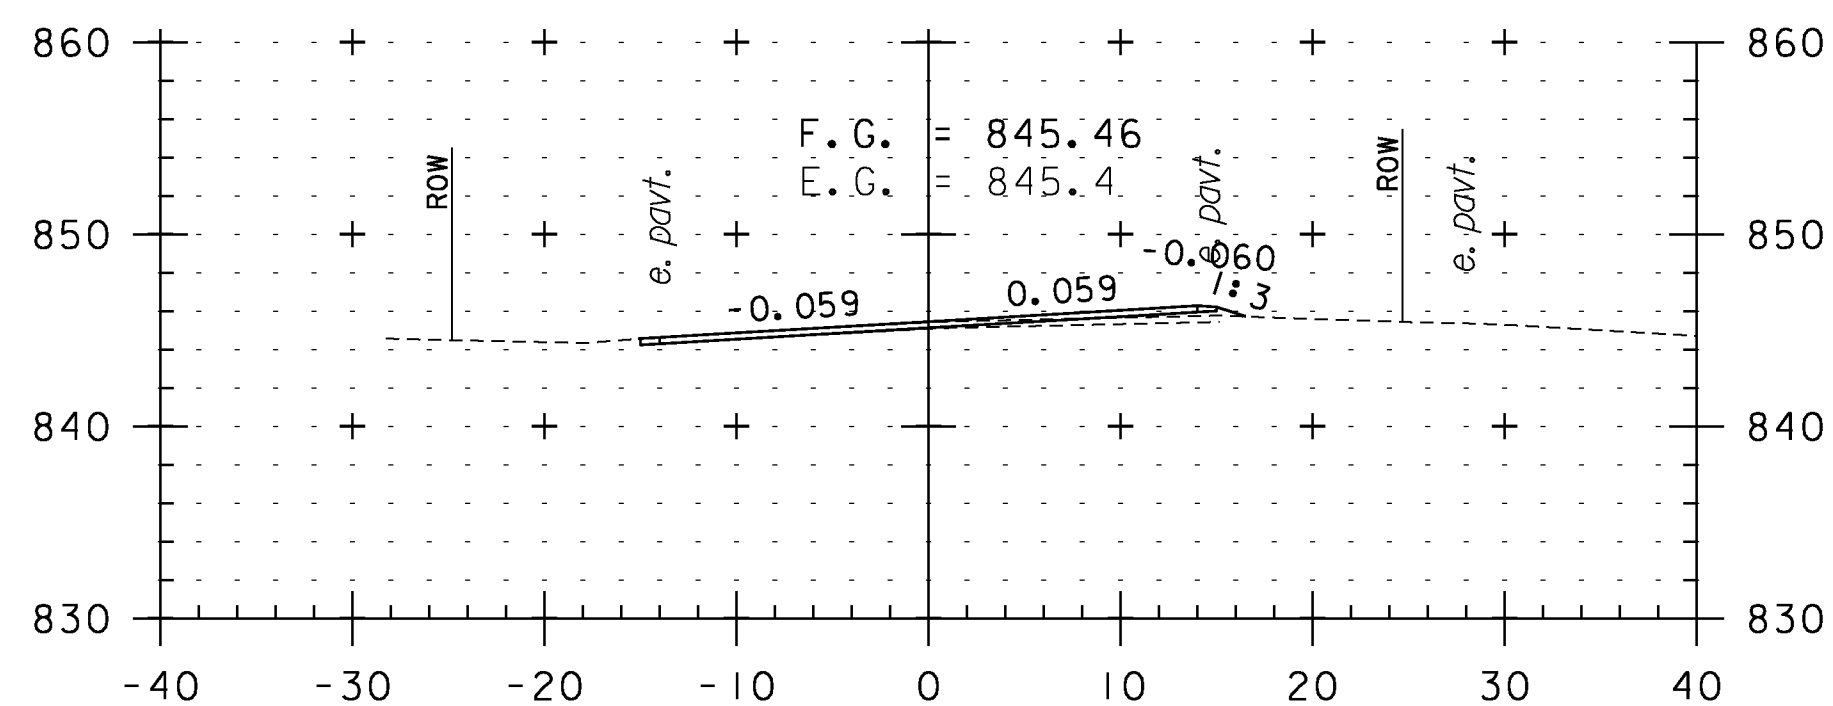


301+50

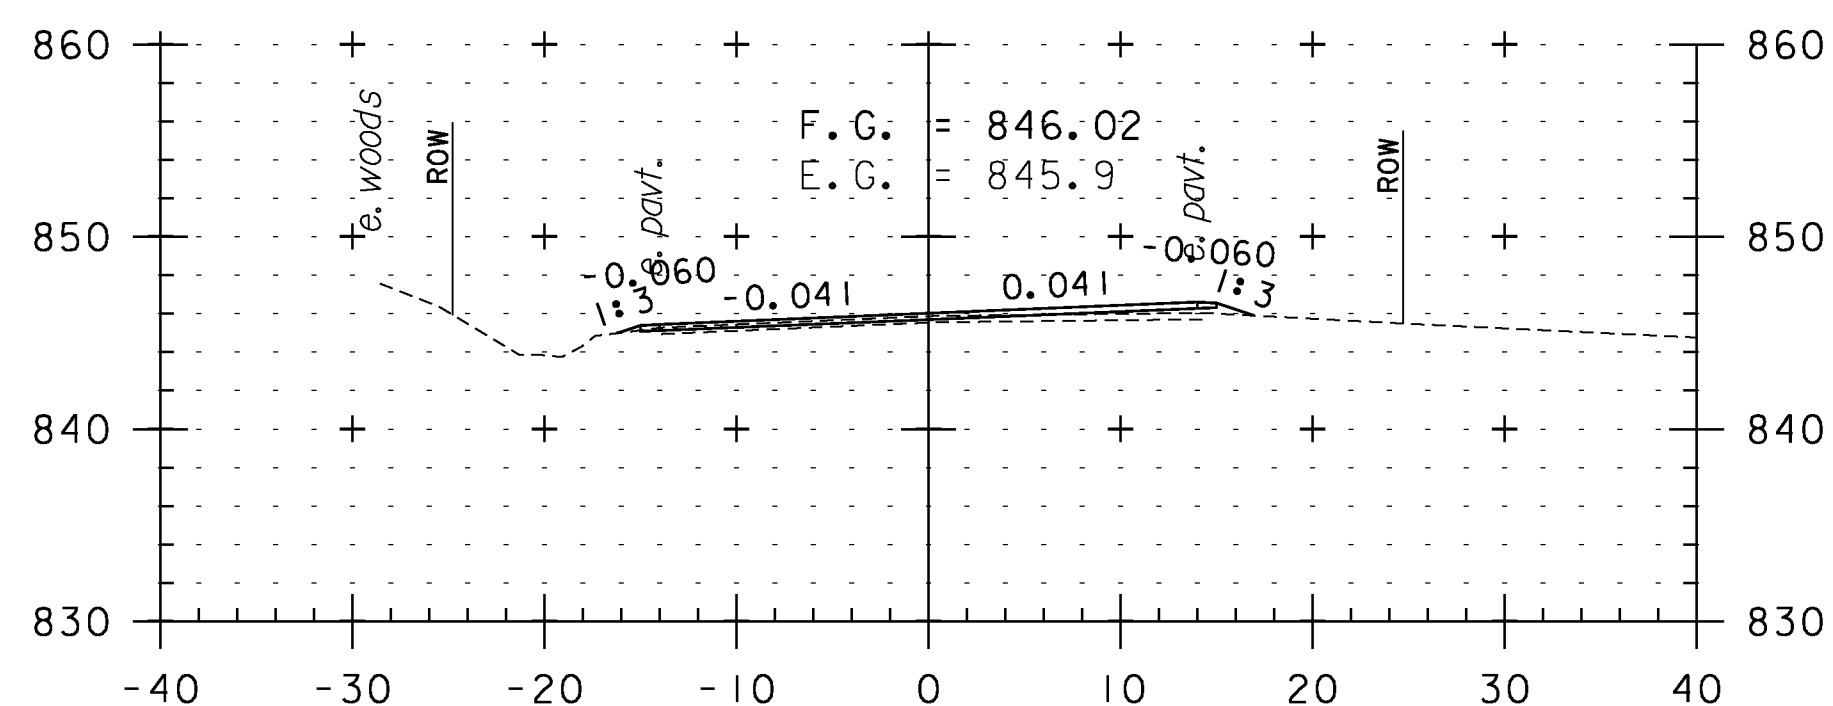


301+00

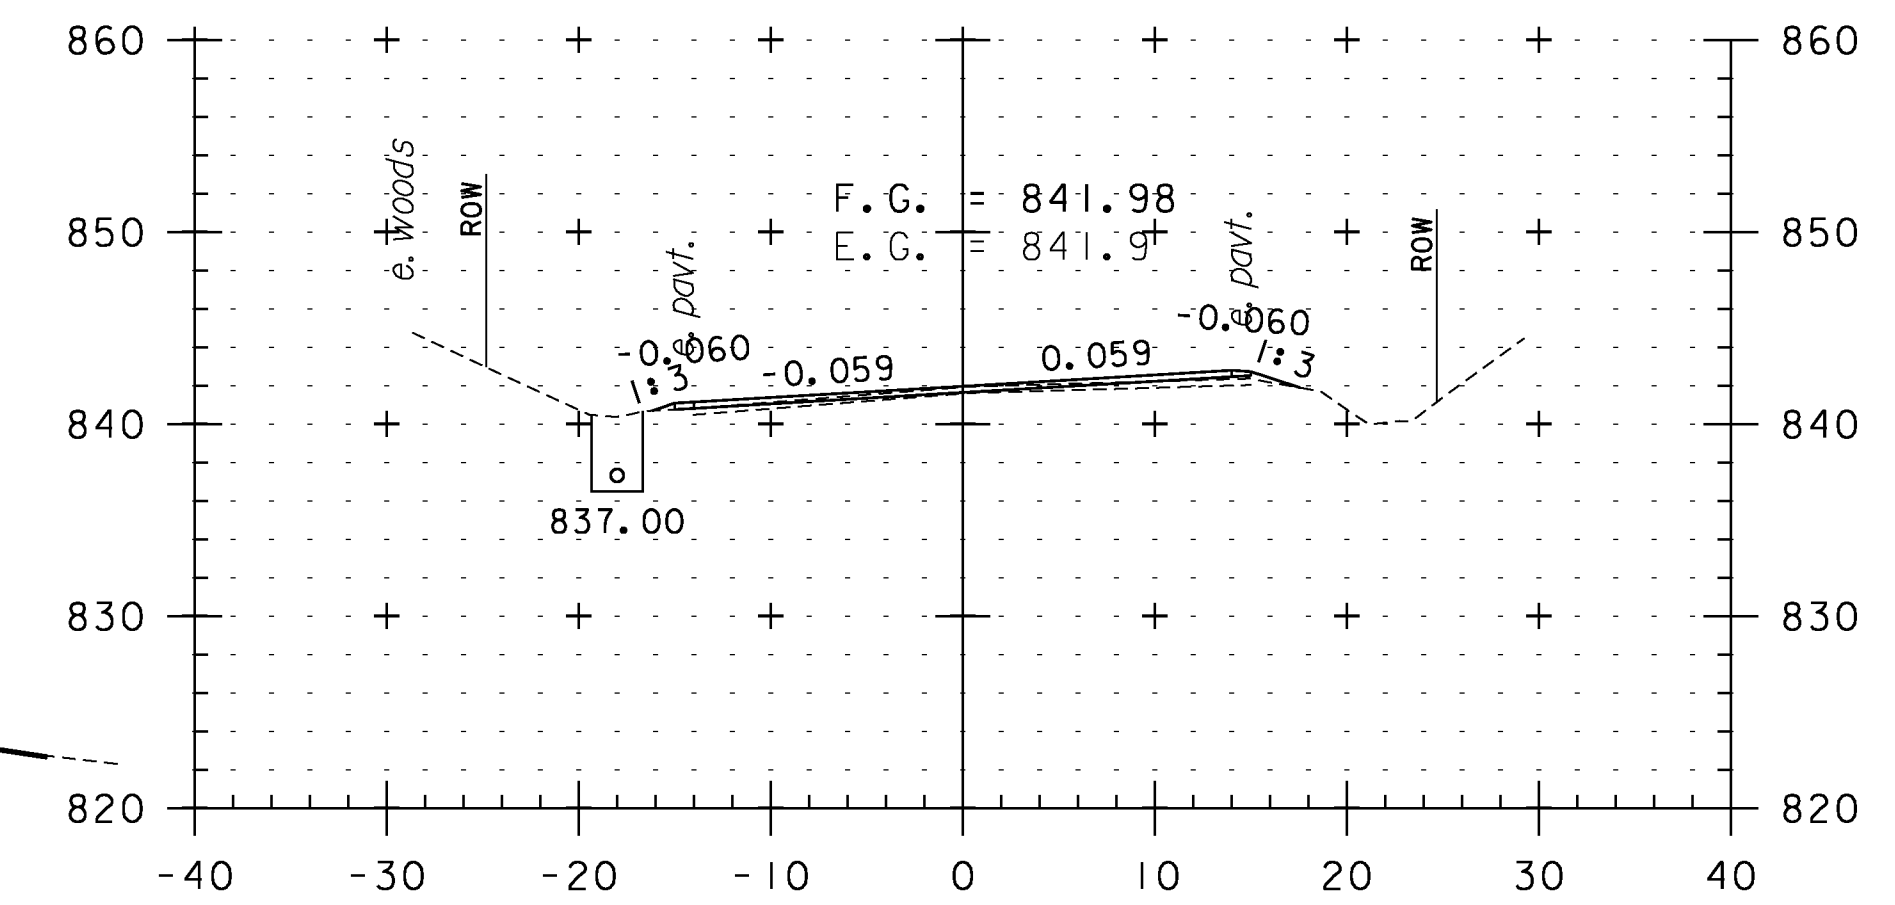

303+00

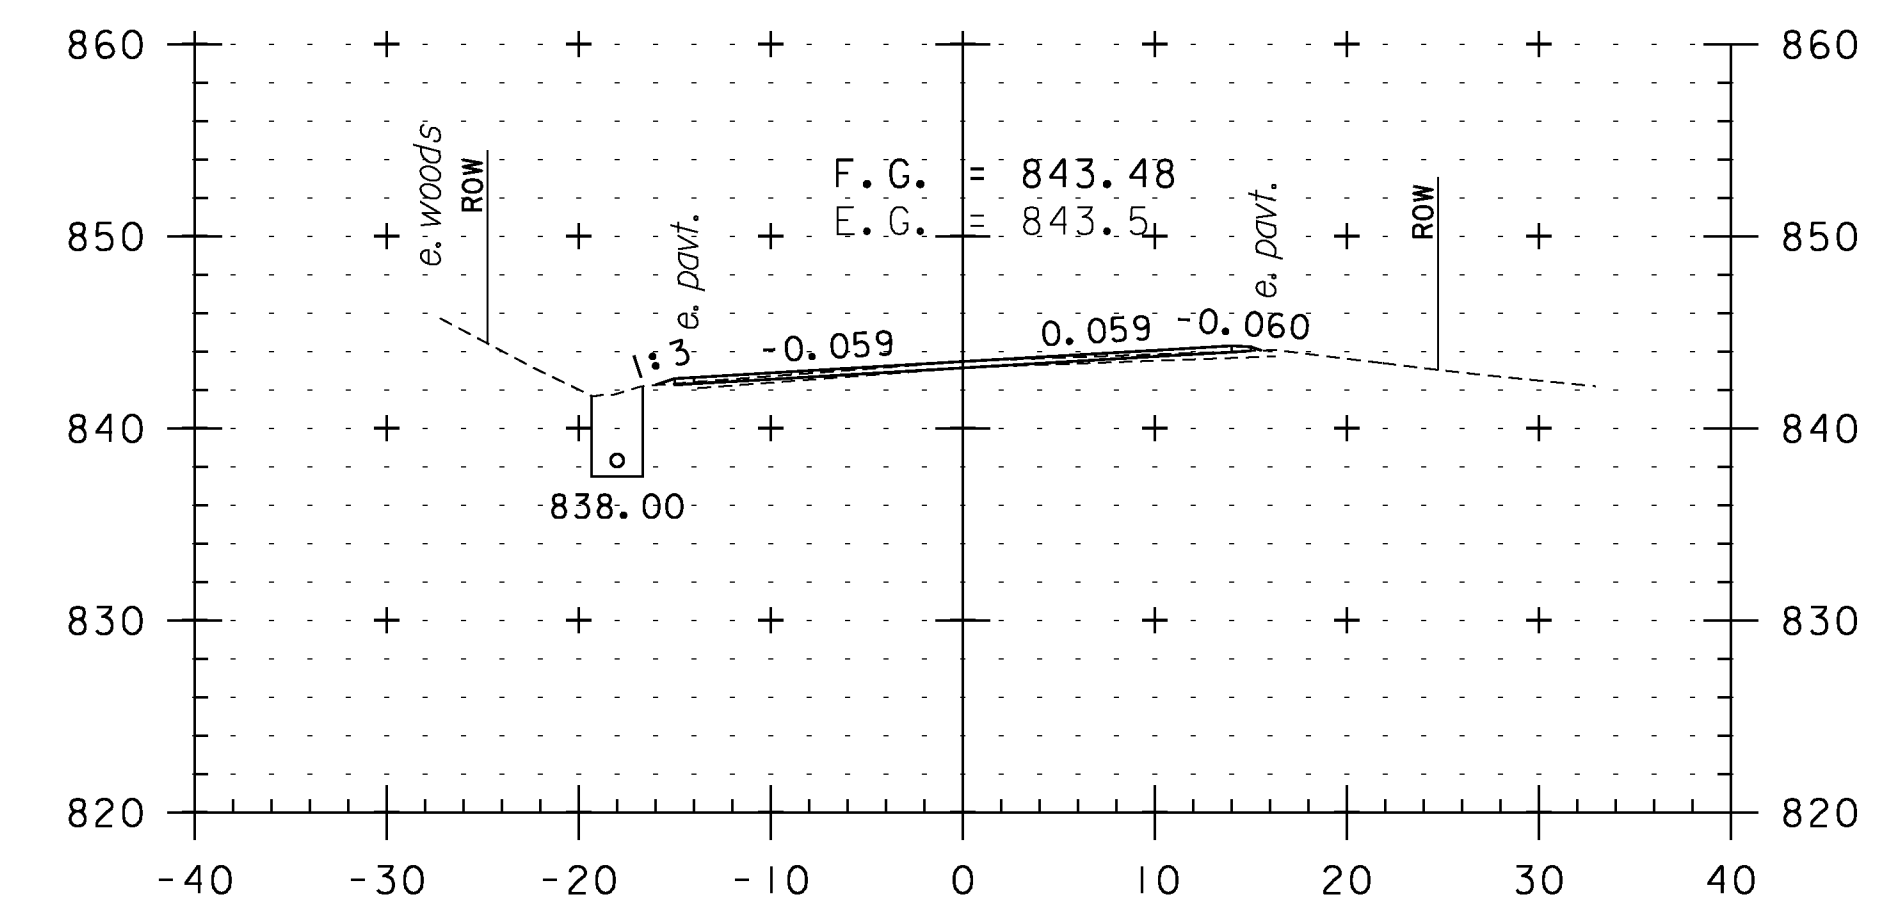

302+50

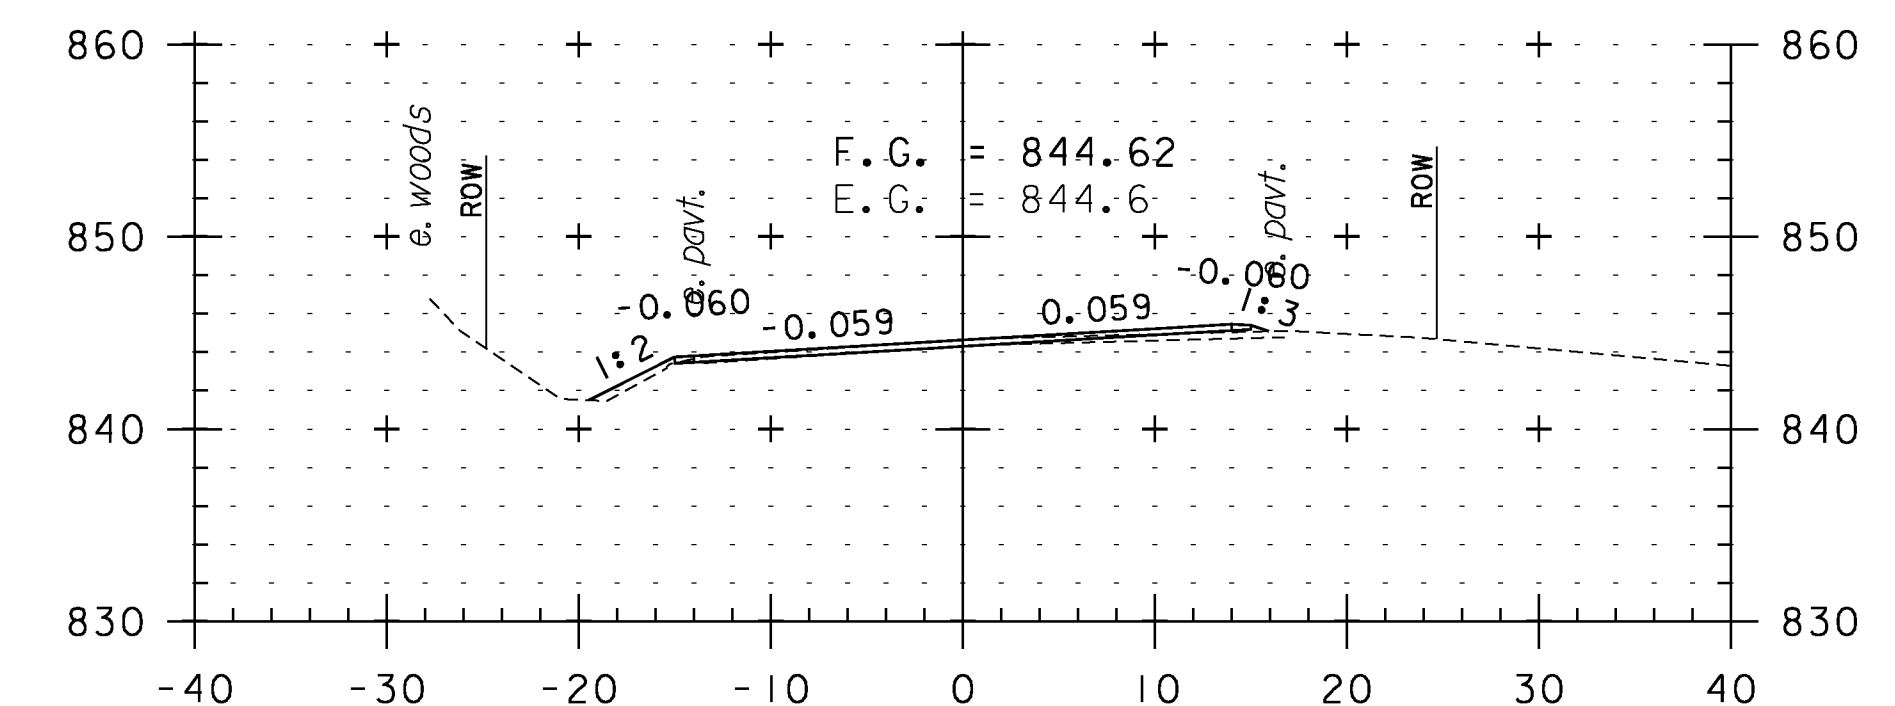

302+00

**CROSS SECTION SHEET 55**

PROJECT NAME: WEATHERSFIELD

PROJECT NUMBER: STP 2913(I)

FILE NAME: I0c228

PROJECT LEADER: PTS

DESIGNED BY: NLL


IPARM FILE NAME: pI0c228\_145

PLOT DATE: 2/7/2013

DRAWN BY: WWG

CHECKED BY: PTS

SHEET 145 OF 234

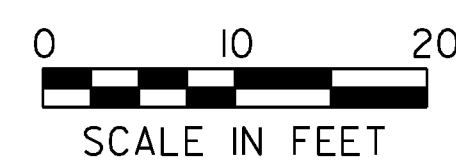

STA. 299+50 TO STA. 303+00