




315+50

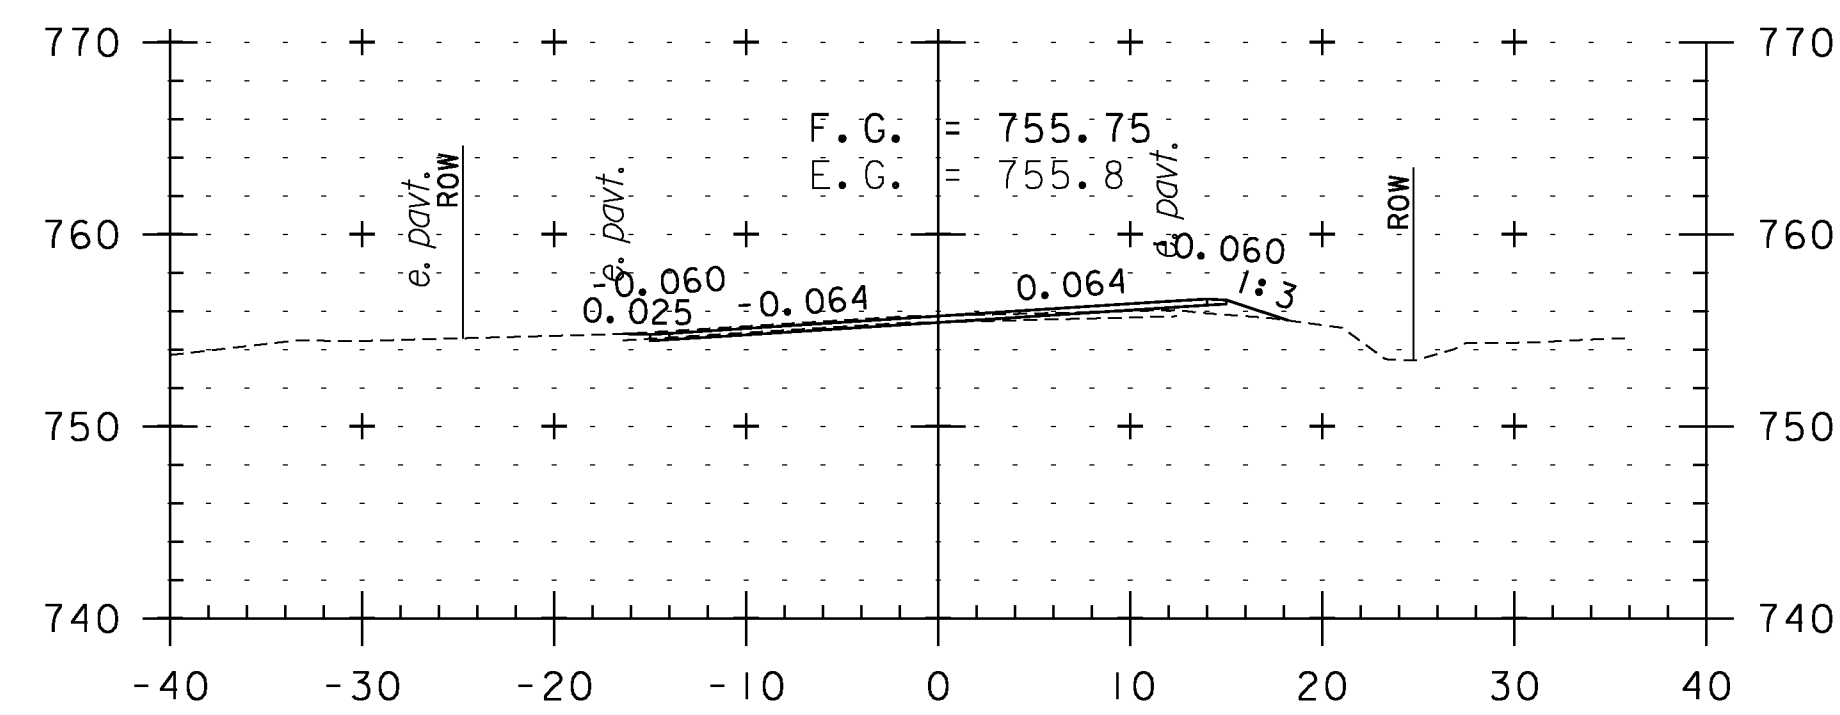


315+00

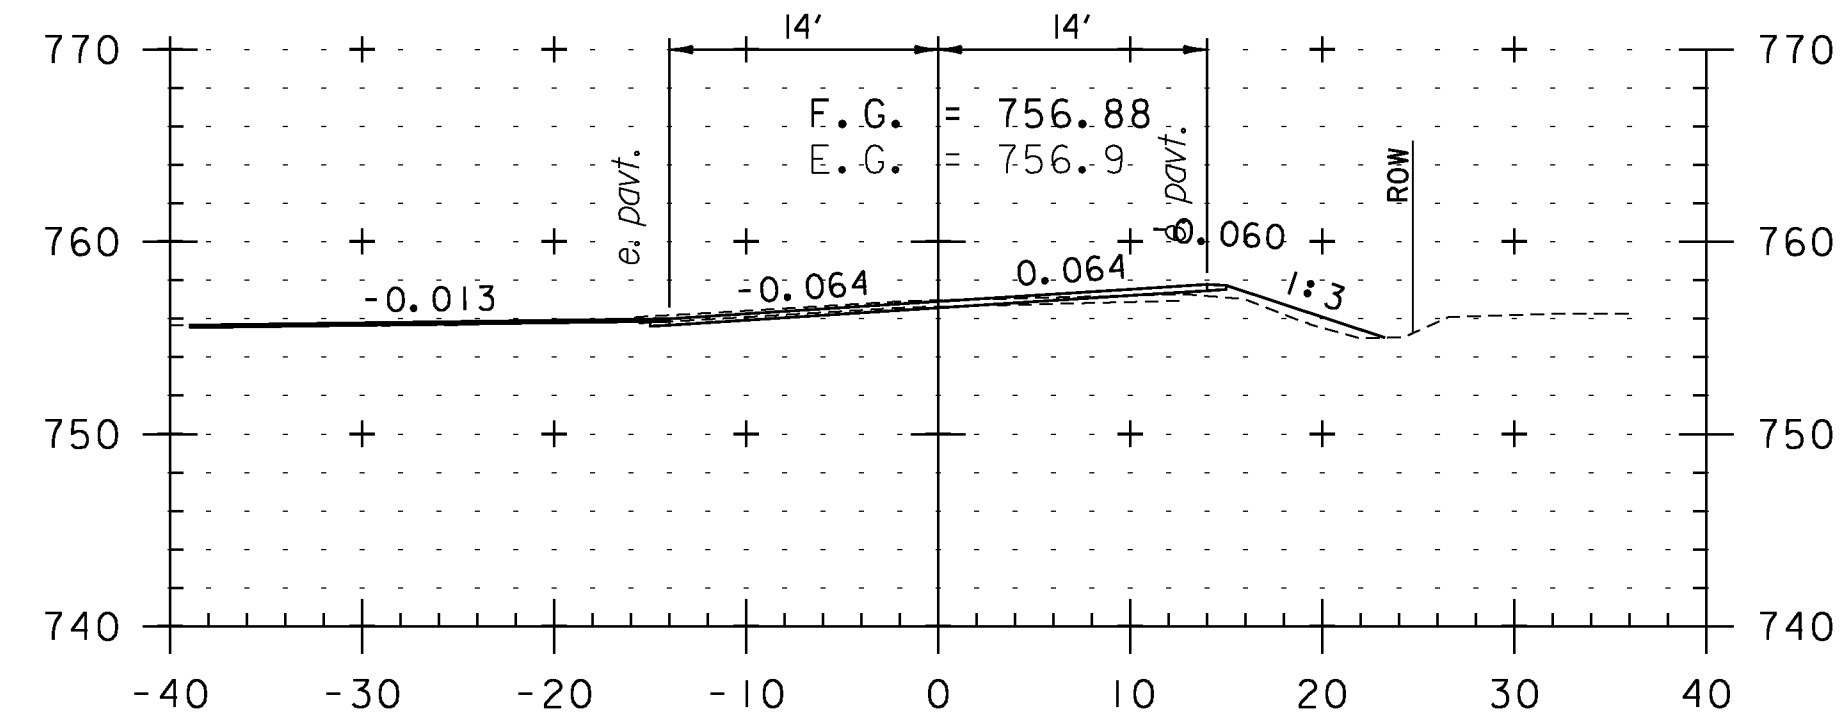


314+75  
TH 28

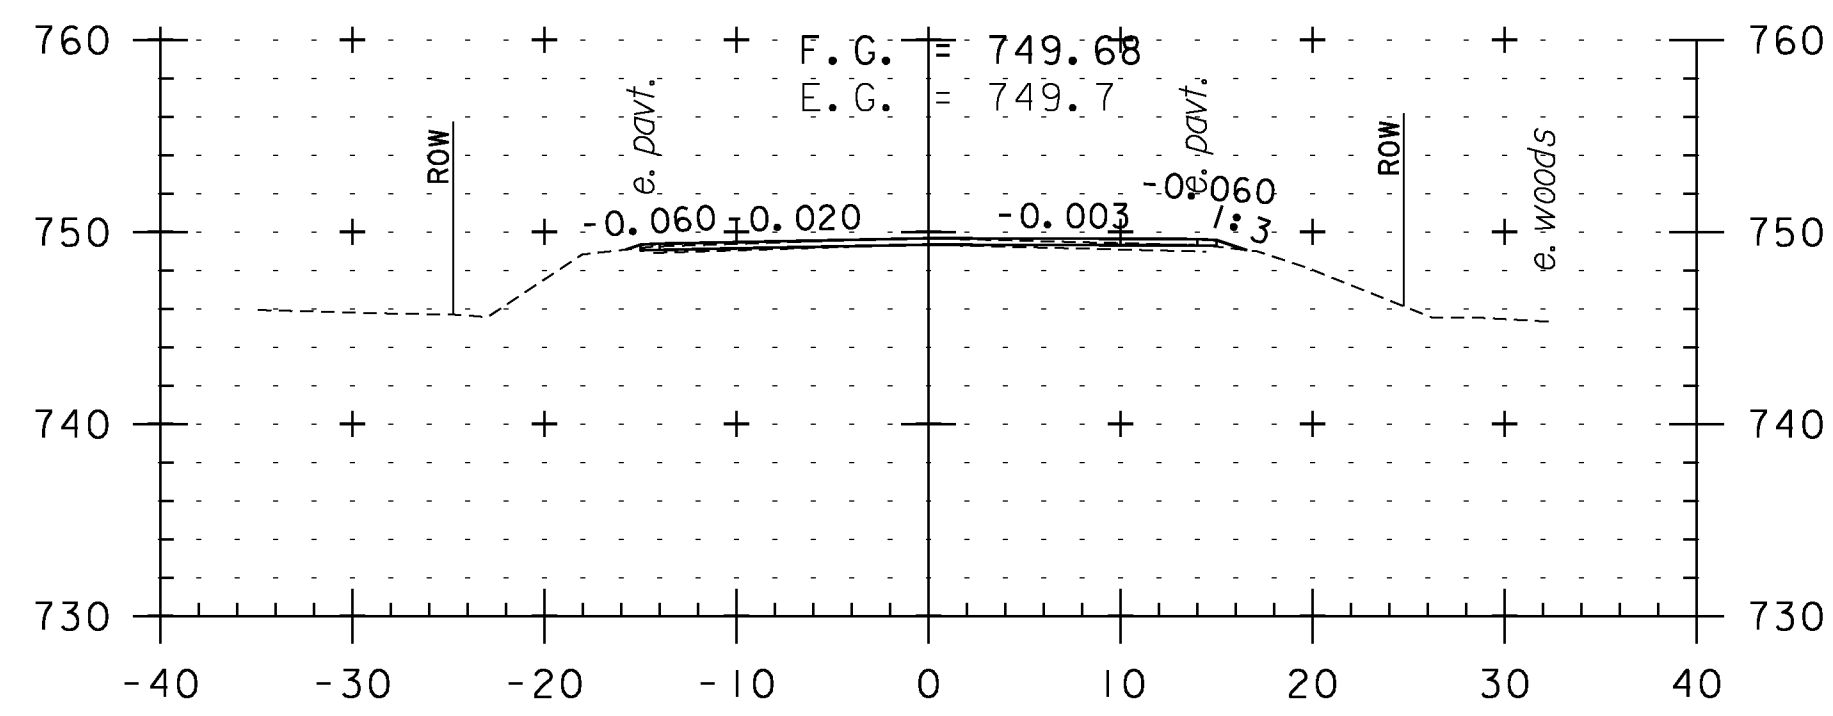


317+00

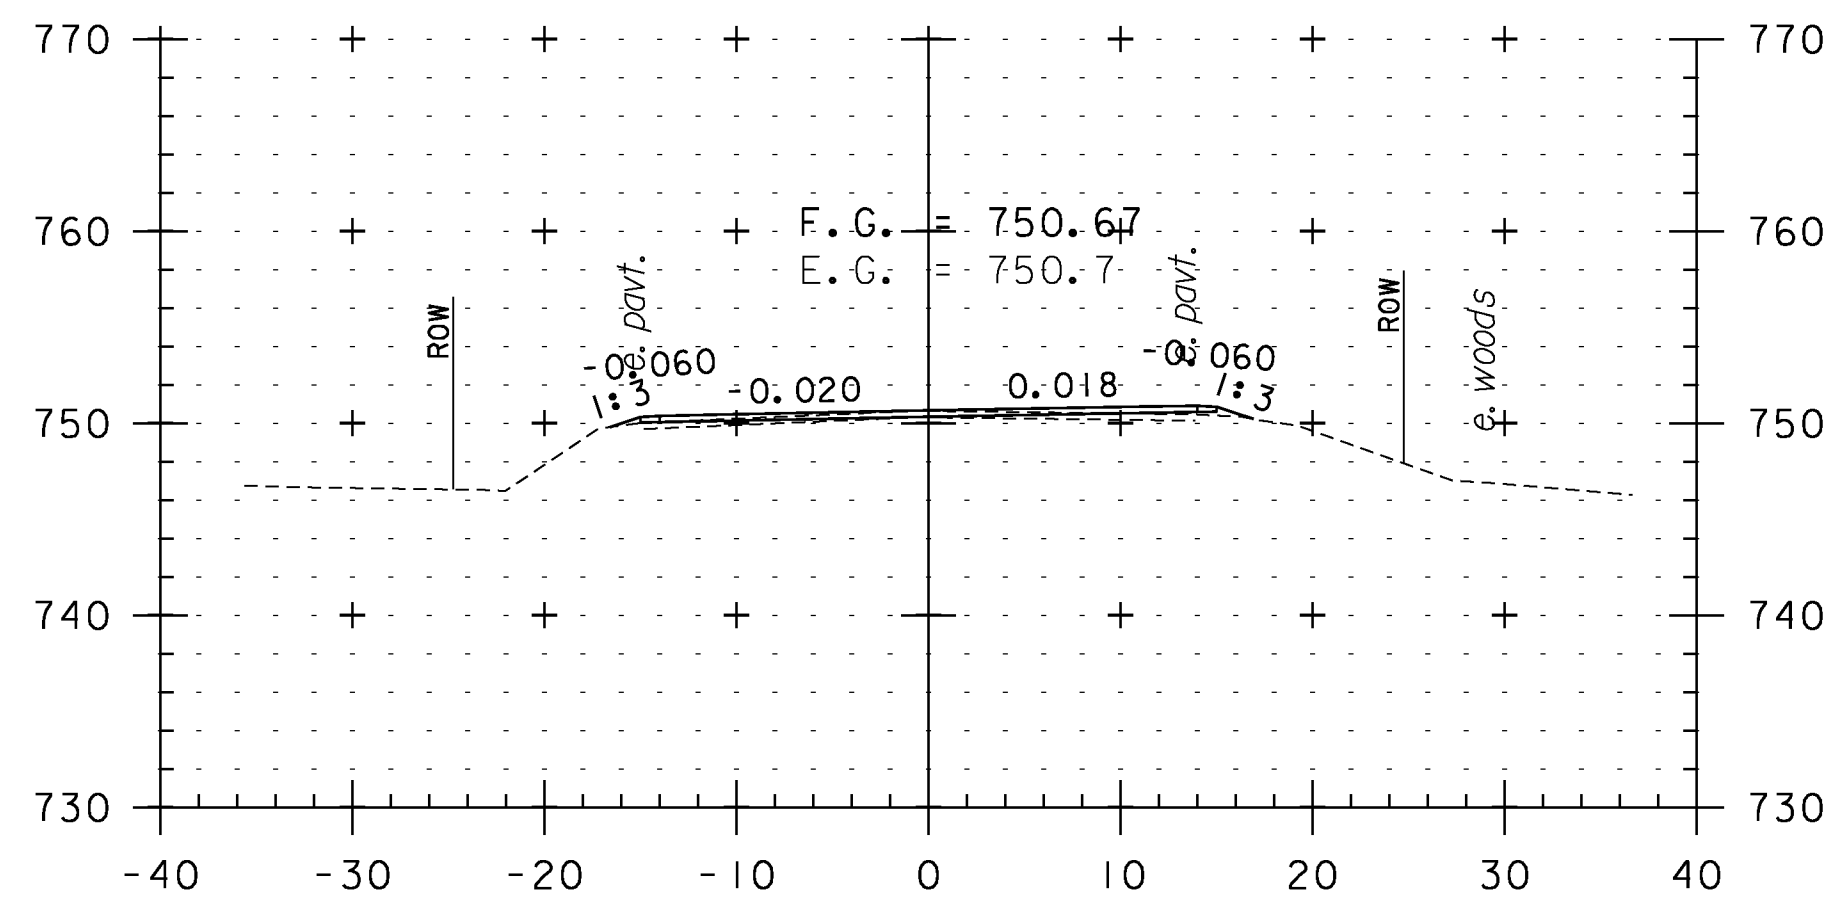


316+50

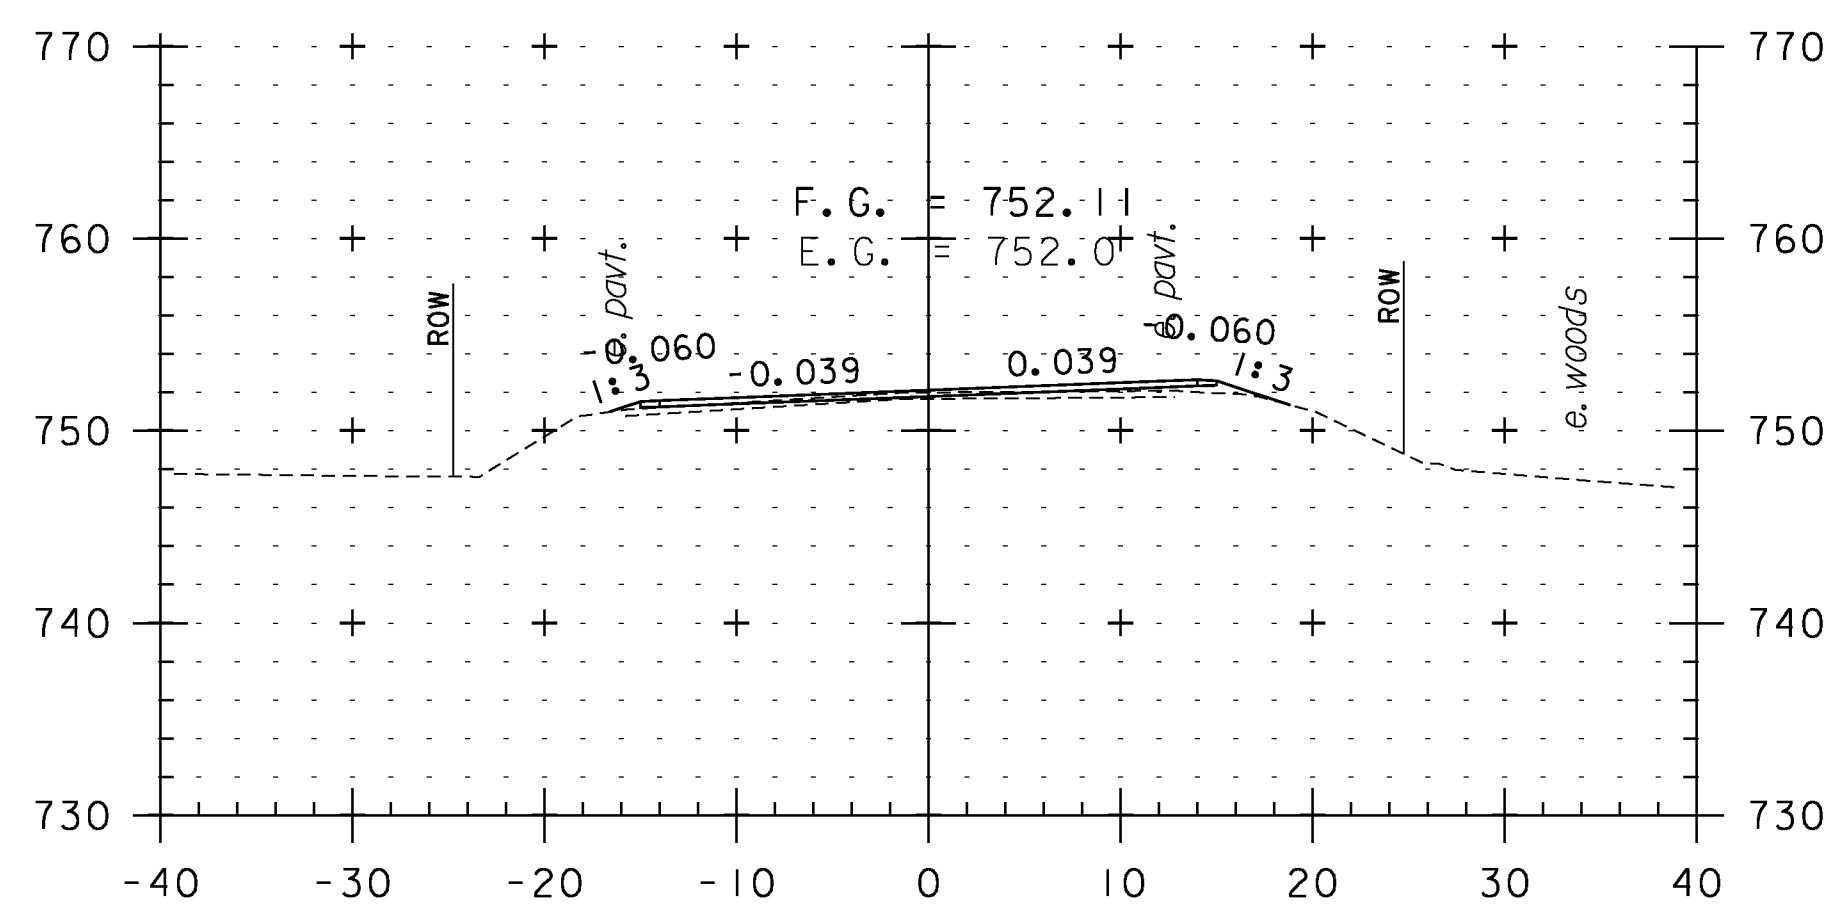


316+00

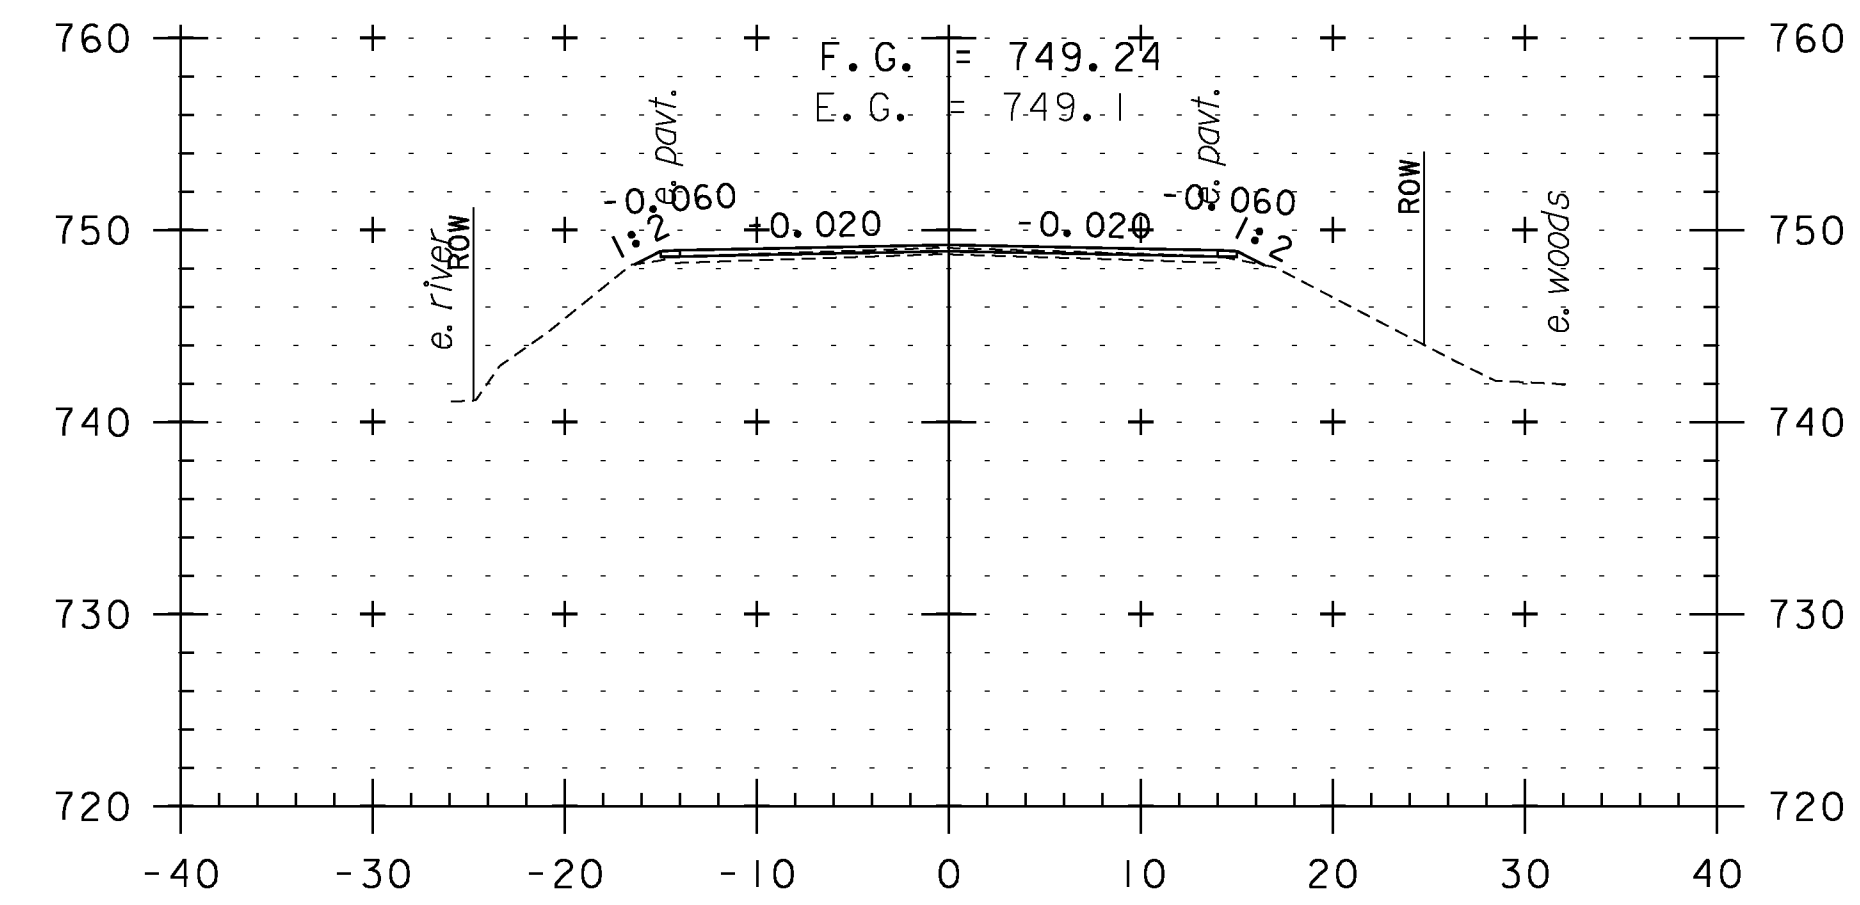

318+50

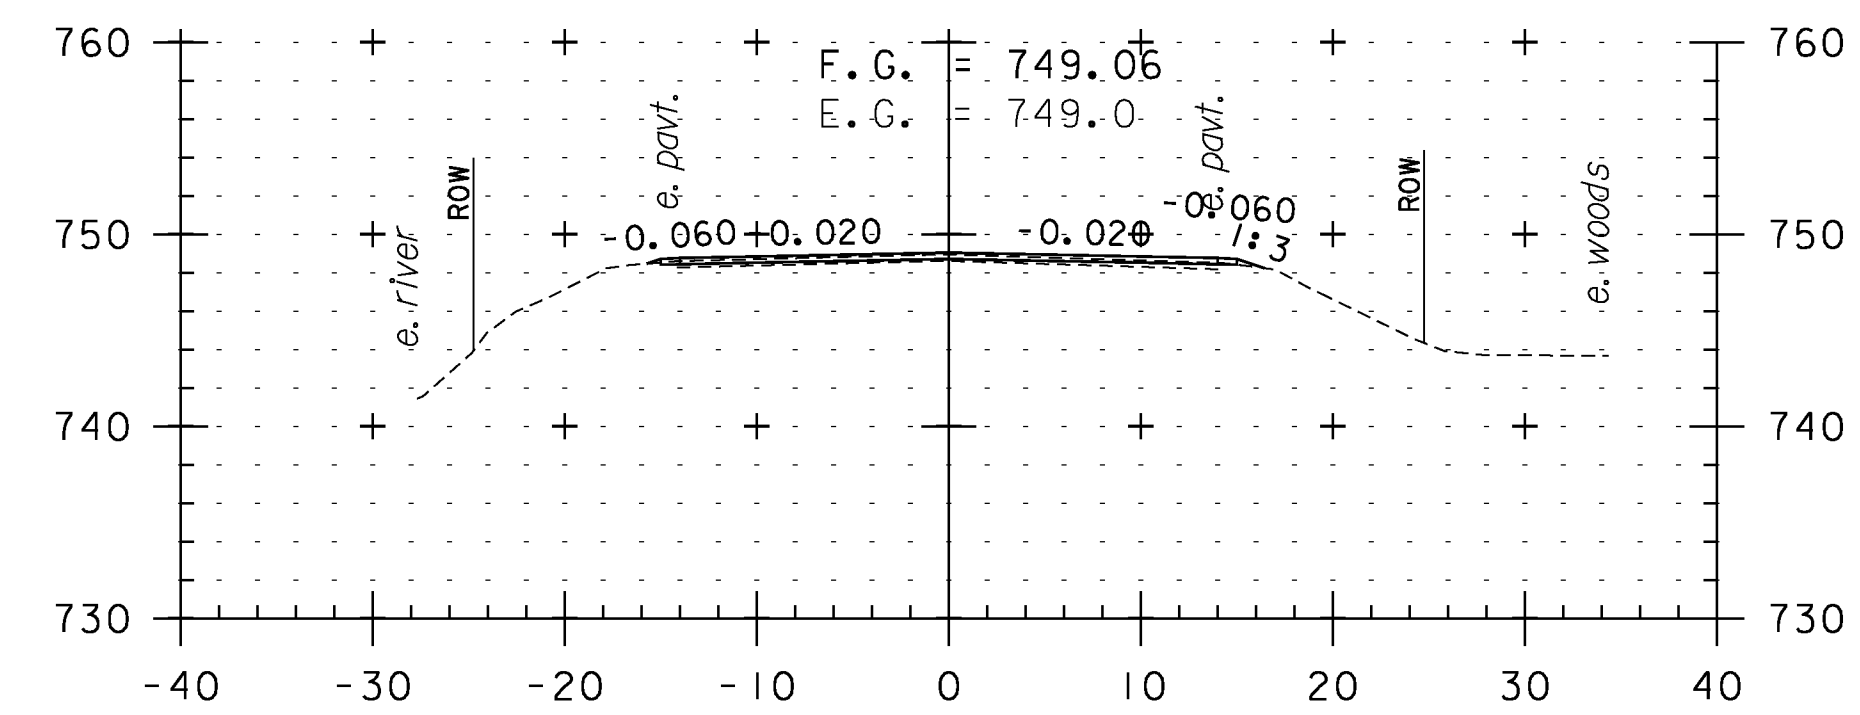

318+00

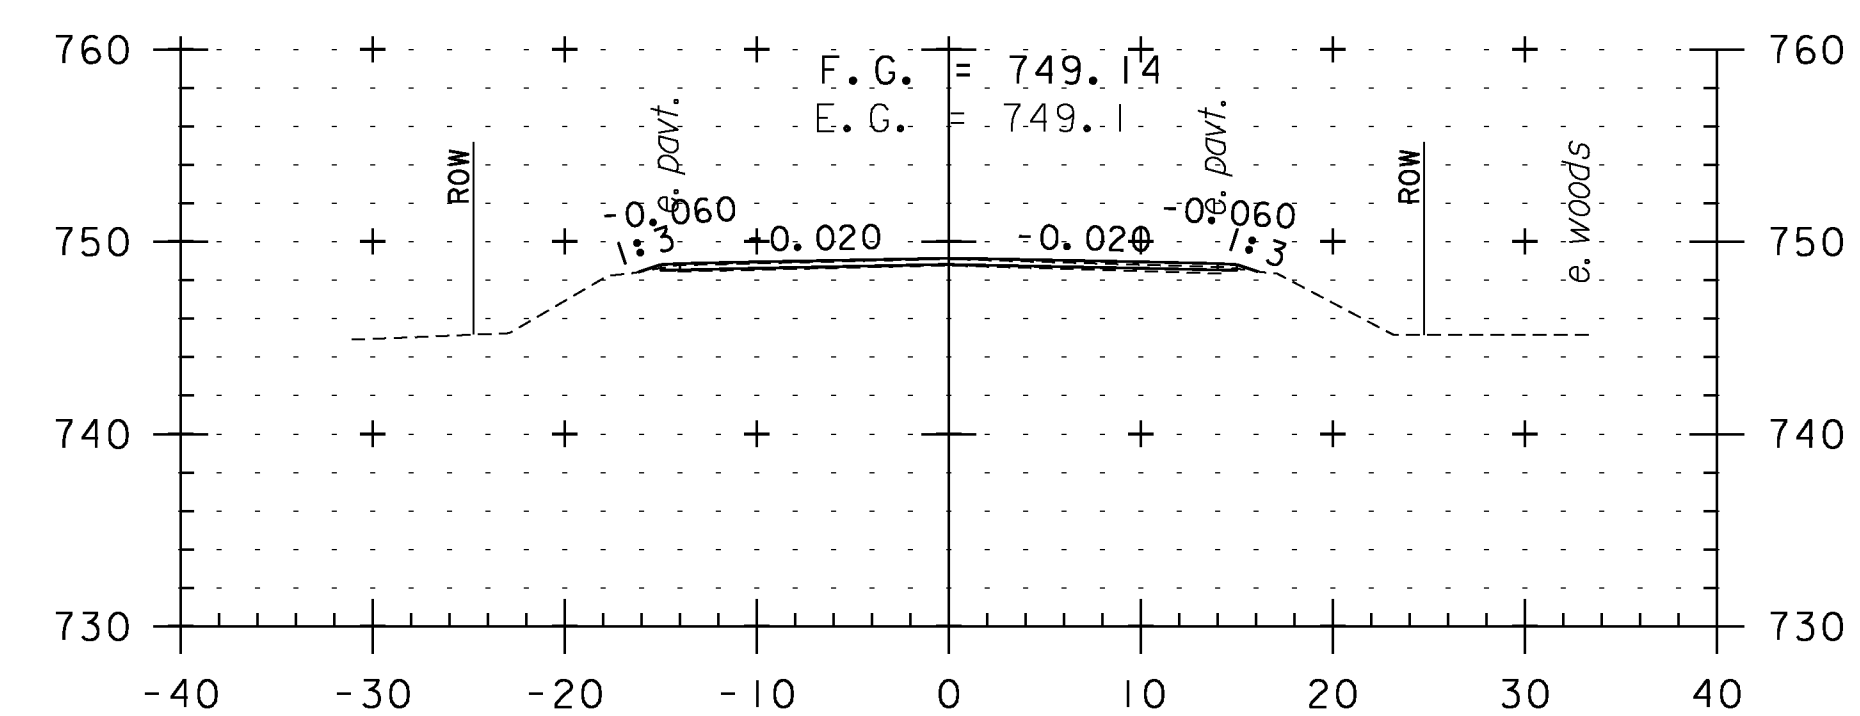

317+50

**CROSS SECTION SHEET 59**

PROJECT NAME: WEATHERSFIELD

PROJECT NUMBER: STP 2913(I)

FILE NAME: I0c228

PROJECT LEADER: PTS

DESIGNED BY: NLL


IPARM FILE NAME: pI0c228\_149

PLOT DATE: 2/7/2013

DRAWN BY: WWG

CHECKED BY: PTS

SHEET 149 OF 234

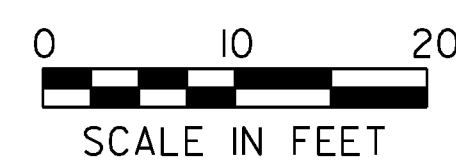

STA. 314+75 TO STA. 318+50