




324+00

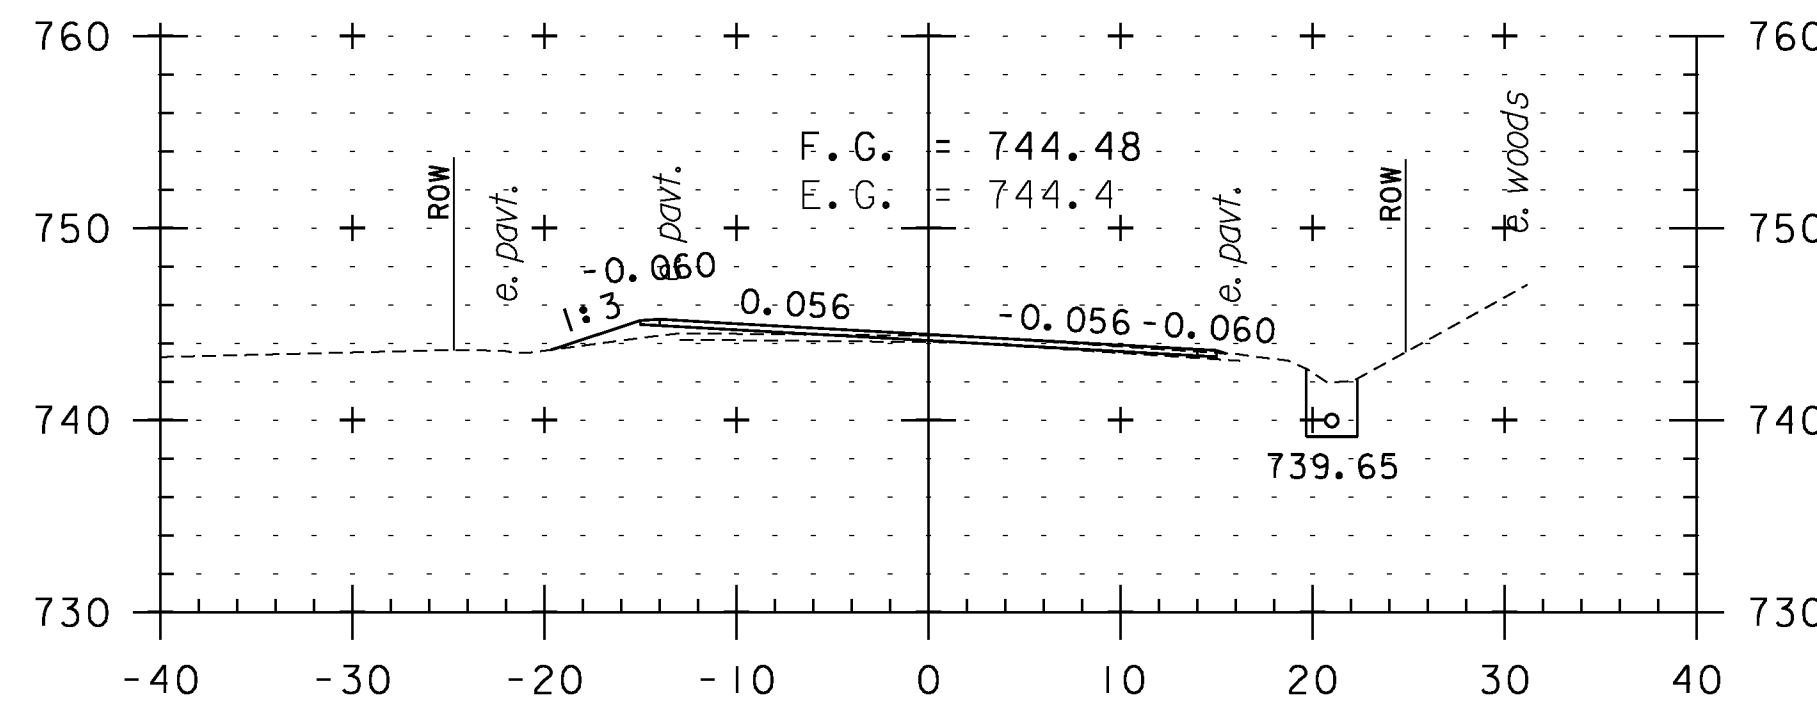


325+50

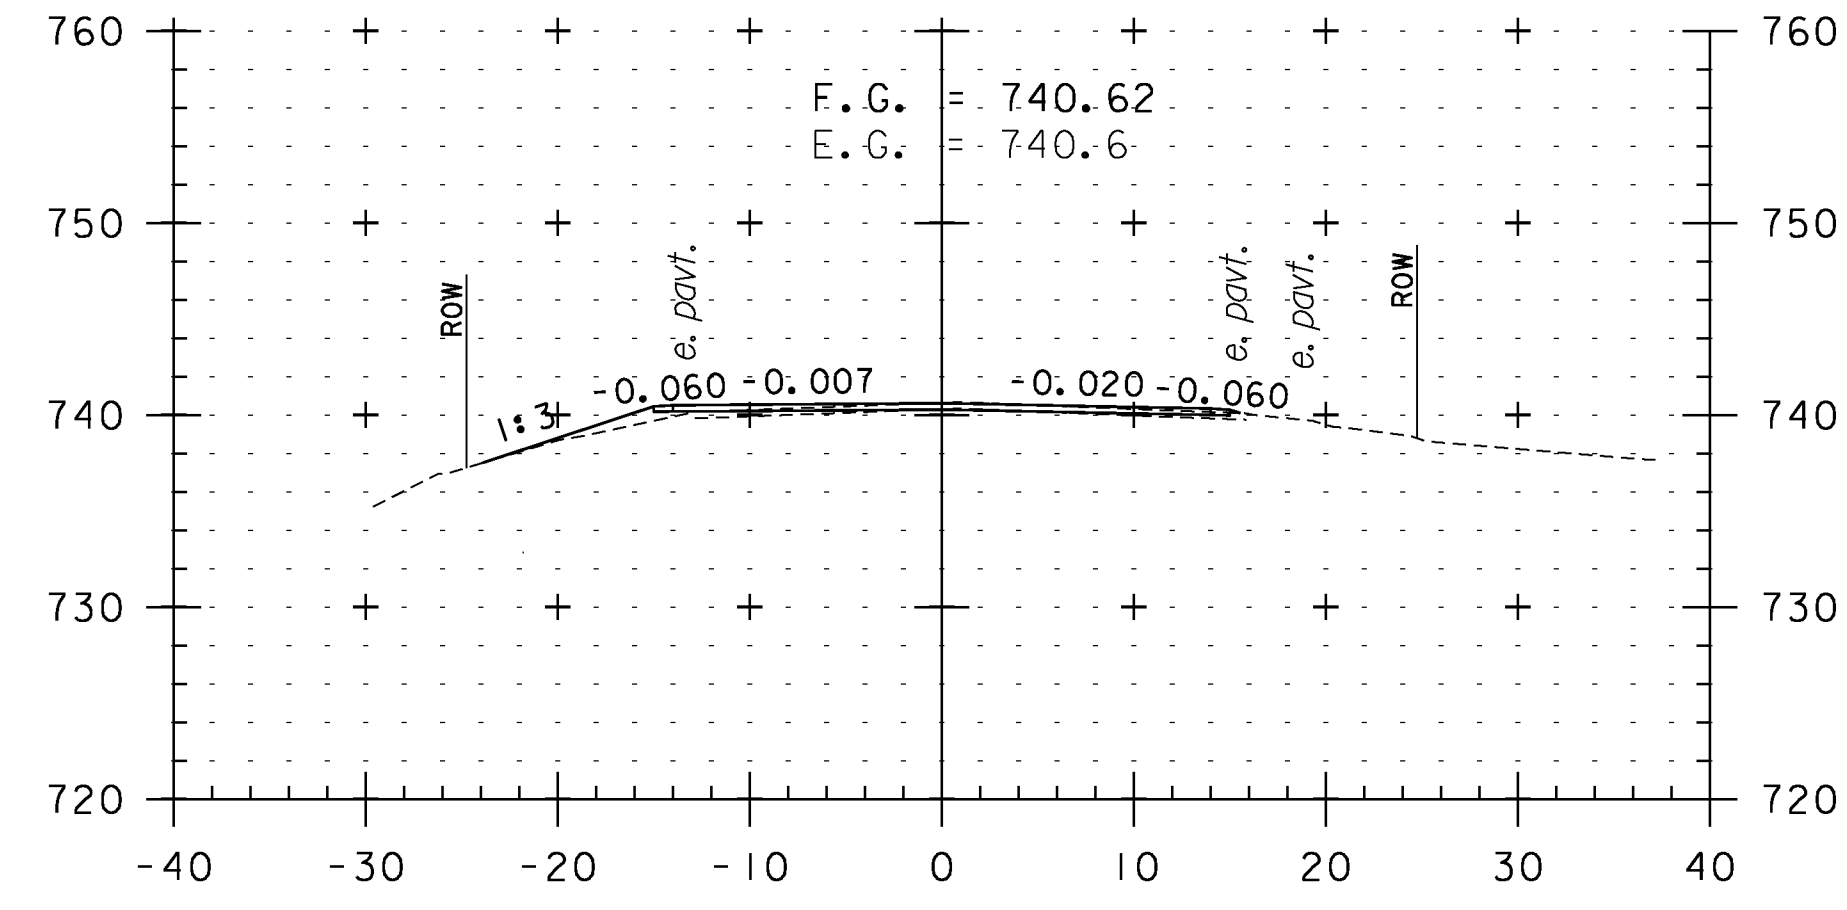


327+00

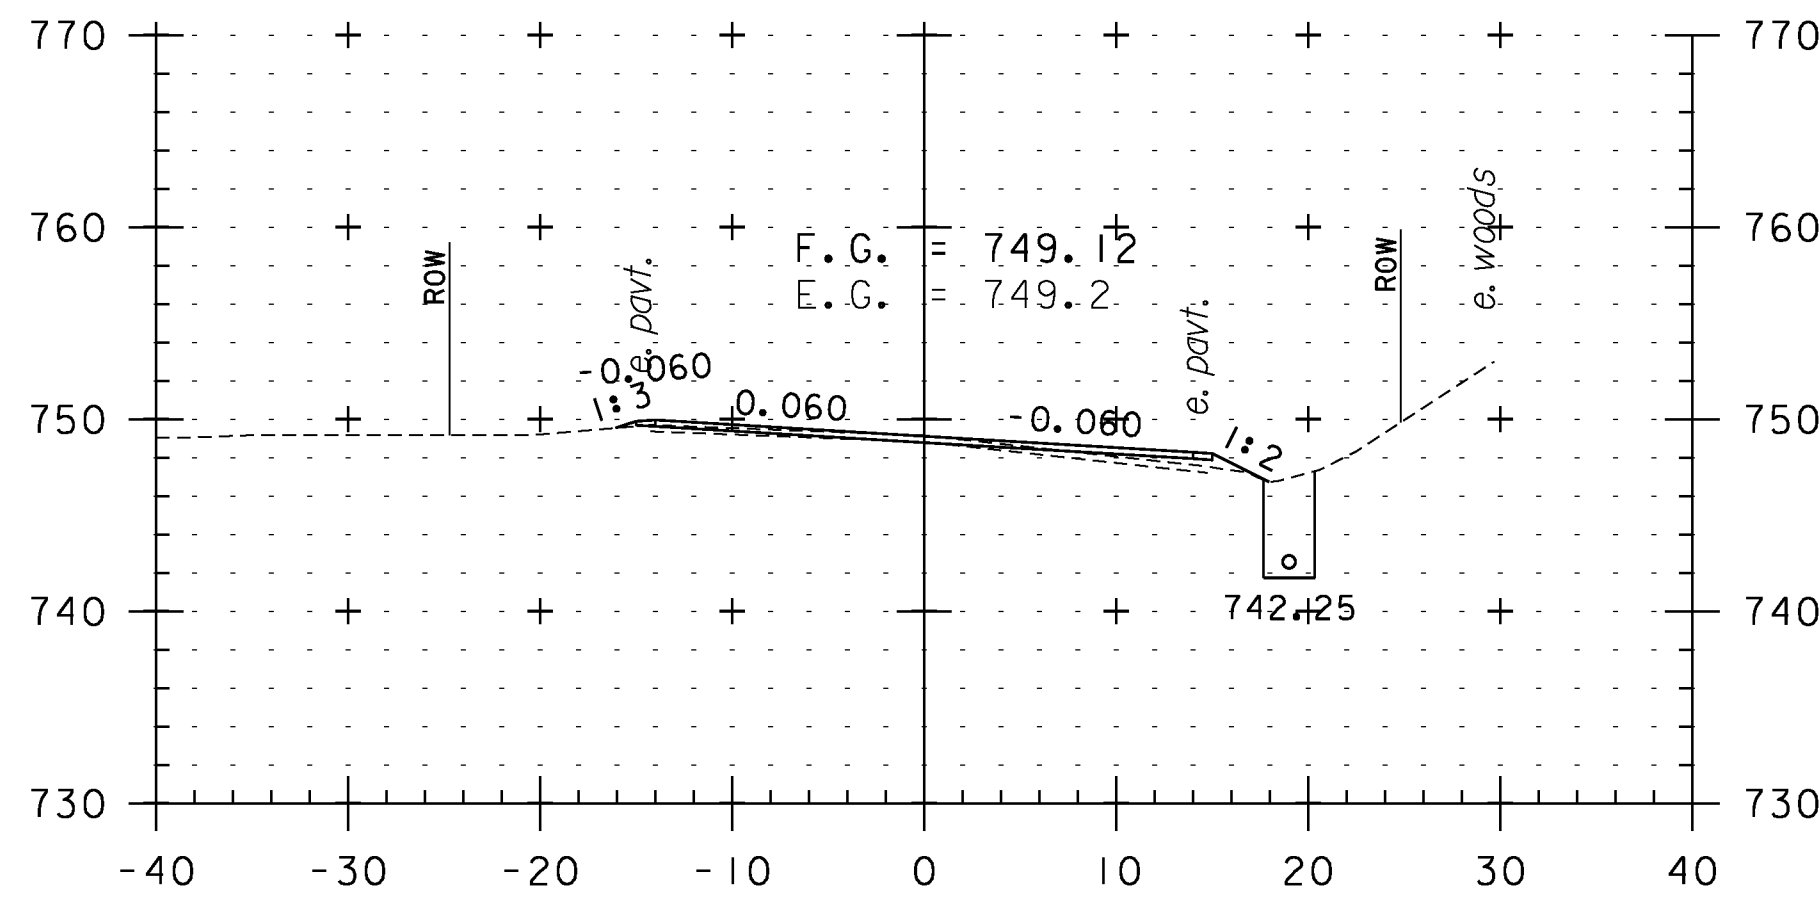


323+50

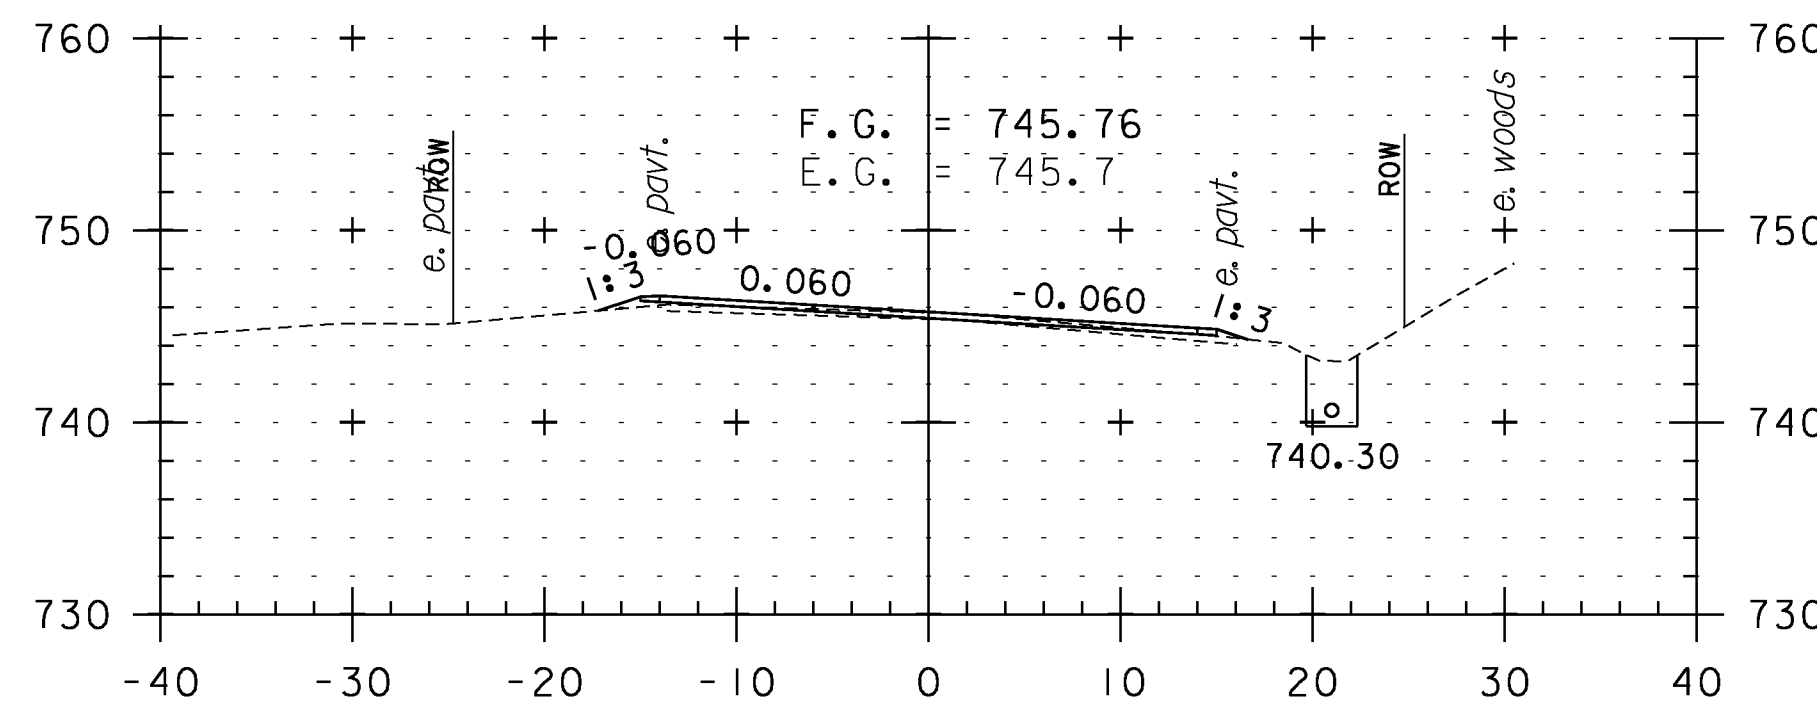


325+00

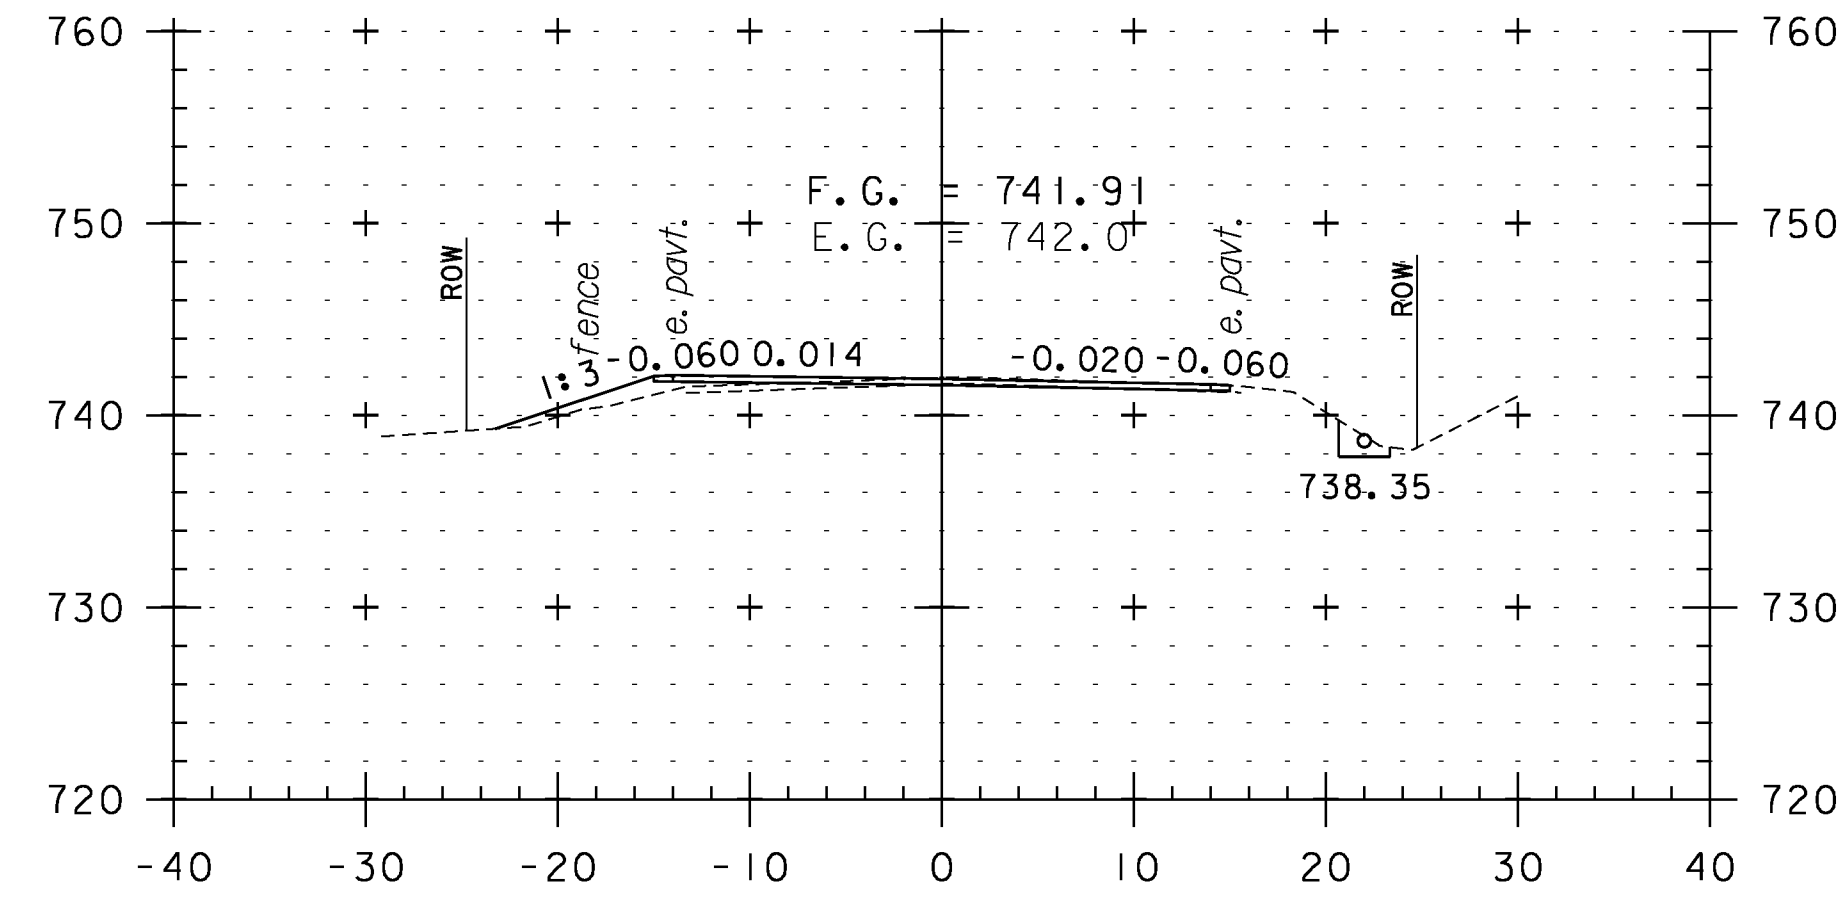


326+50

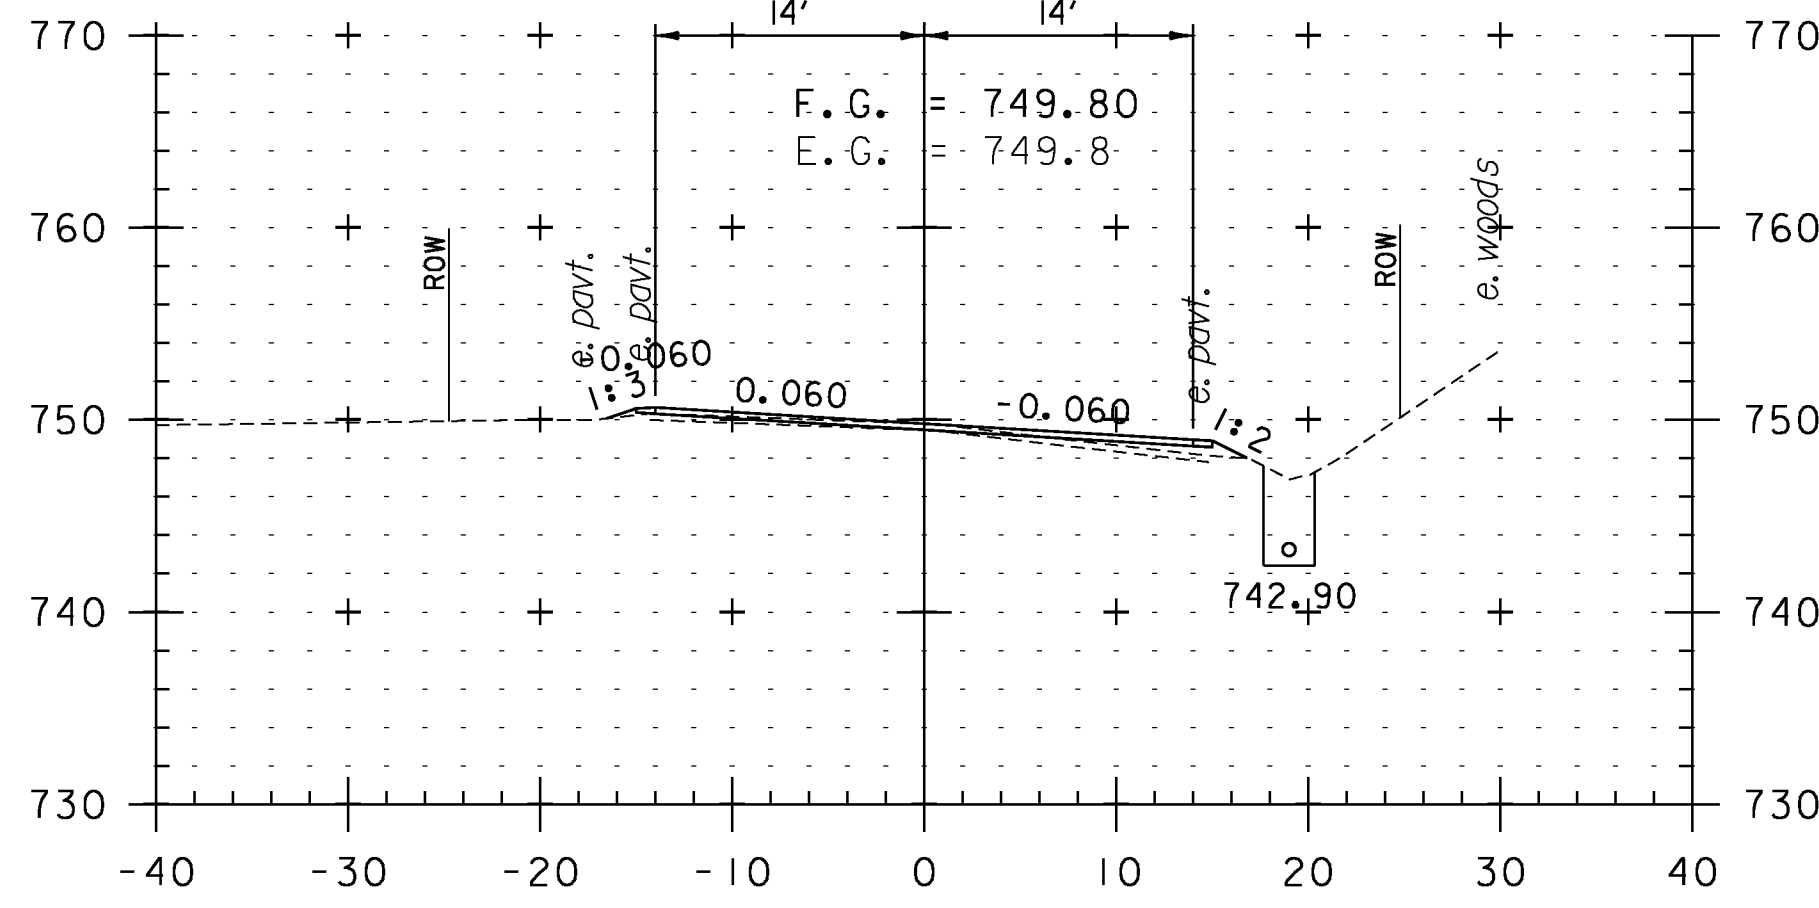

323+00

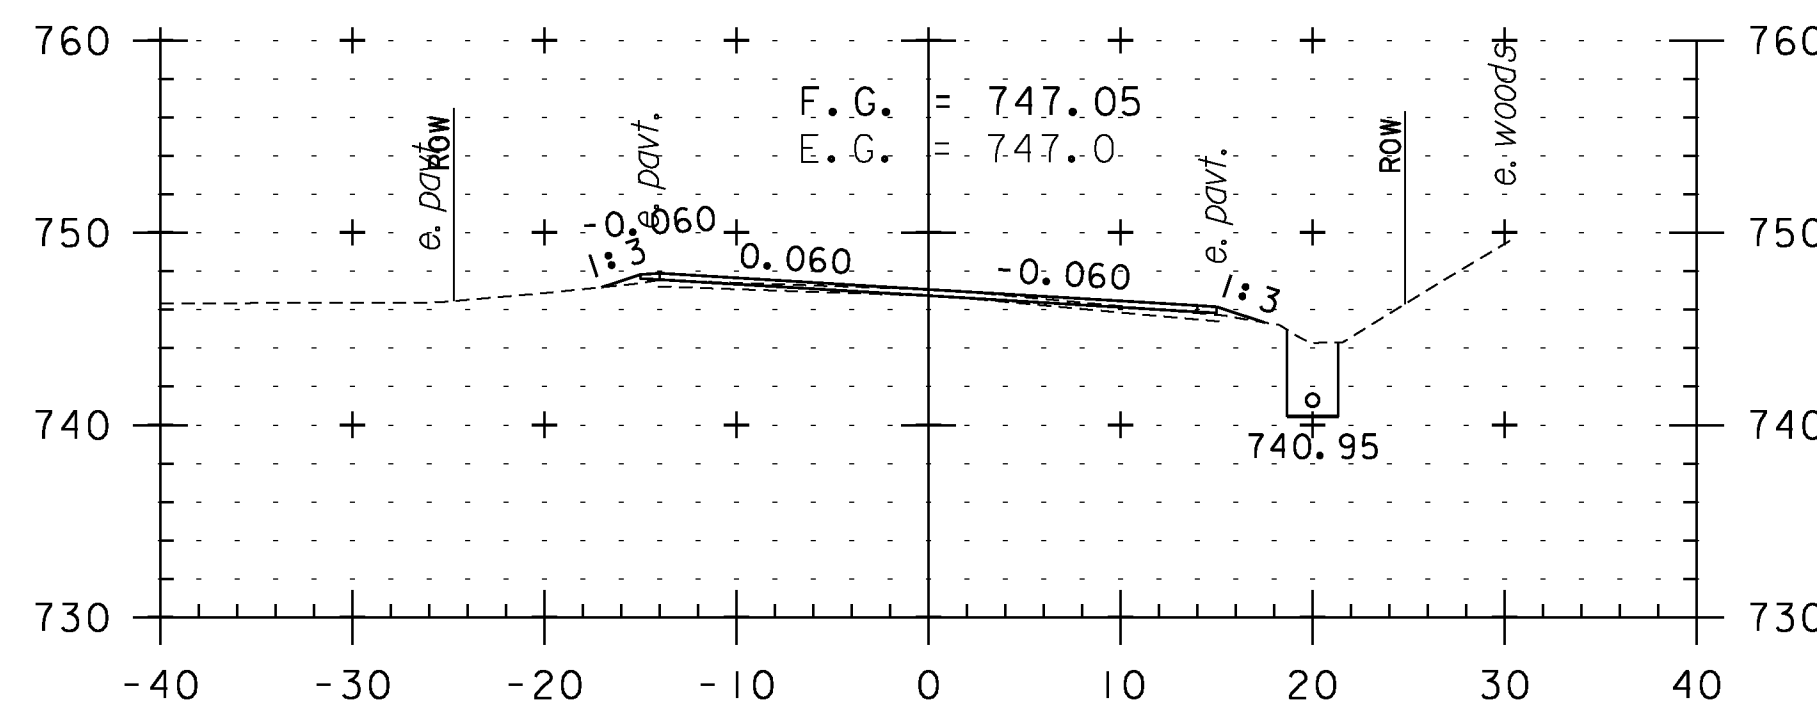


324+50

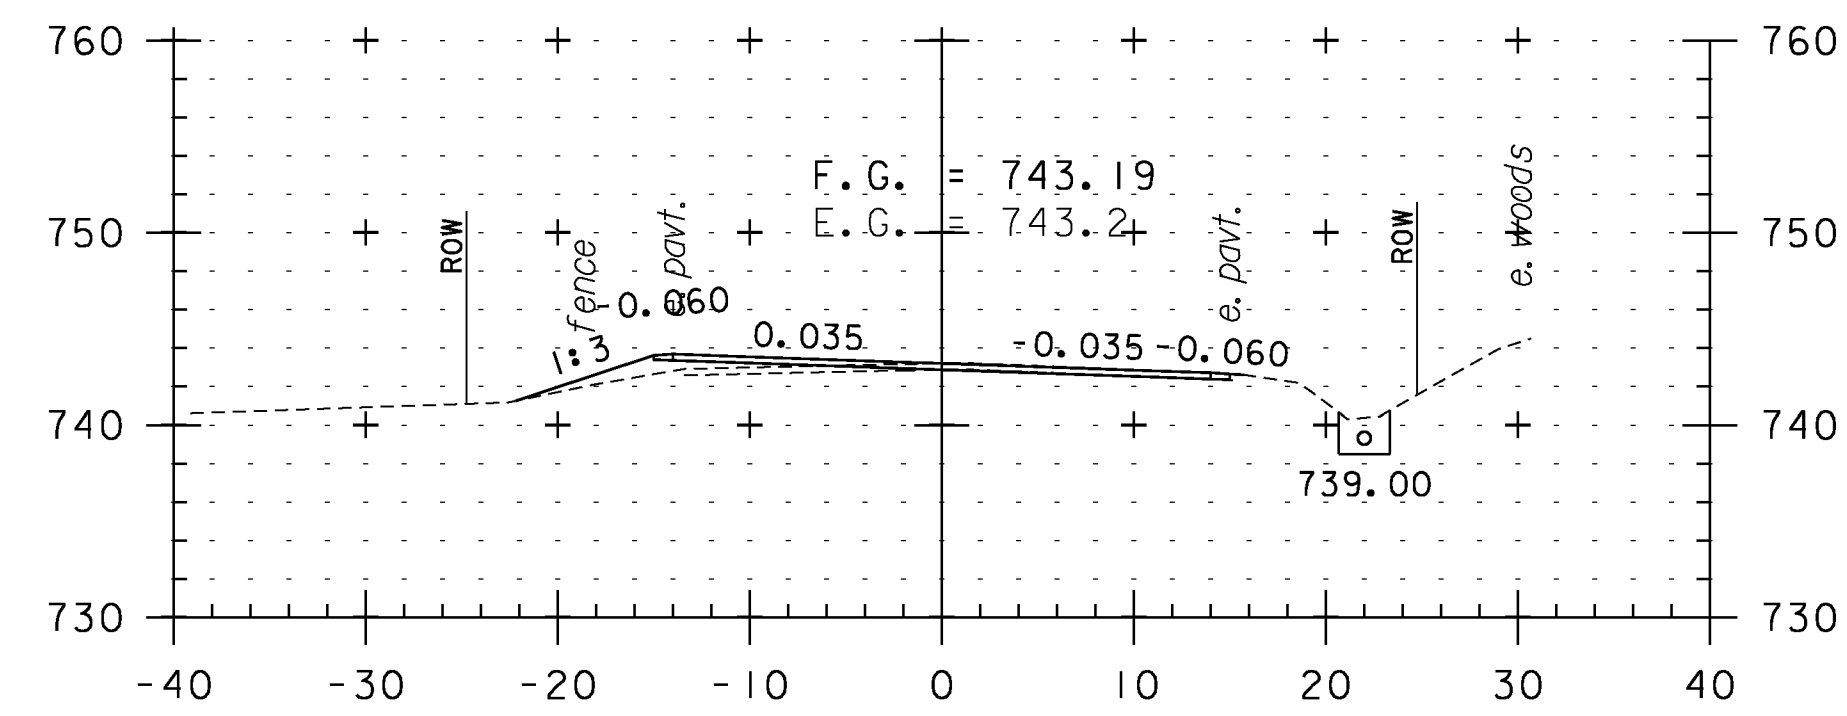

326+00

**CROSS SECTION SHEET 61**

PROJECT NAME: WEATHERSFIELD	PLOT DATE: 2/7/2013
PROJECT NUMBER: STP 2913(I)	DRAWN BY: WWG
FILE NAME: I0c228	CHECKED BY: PTS
PROJECT LEADER: PTS	SHEET 151 OF 234
DESIGNED BY: NLL	
IPARM FILE NAME: pI0c228_151	

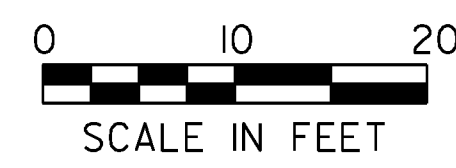

STA. 323+00 TO STA. 327+00