




344+00

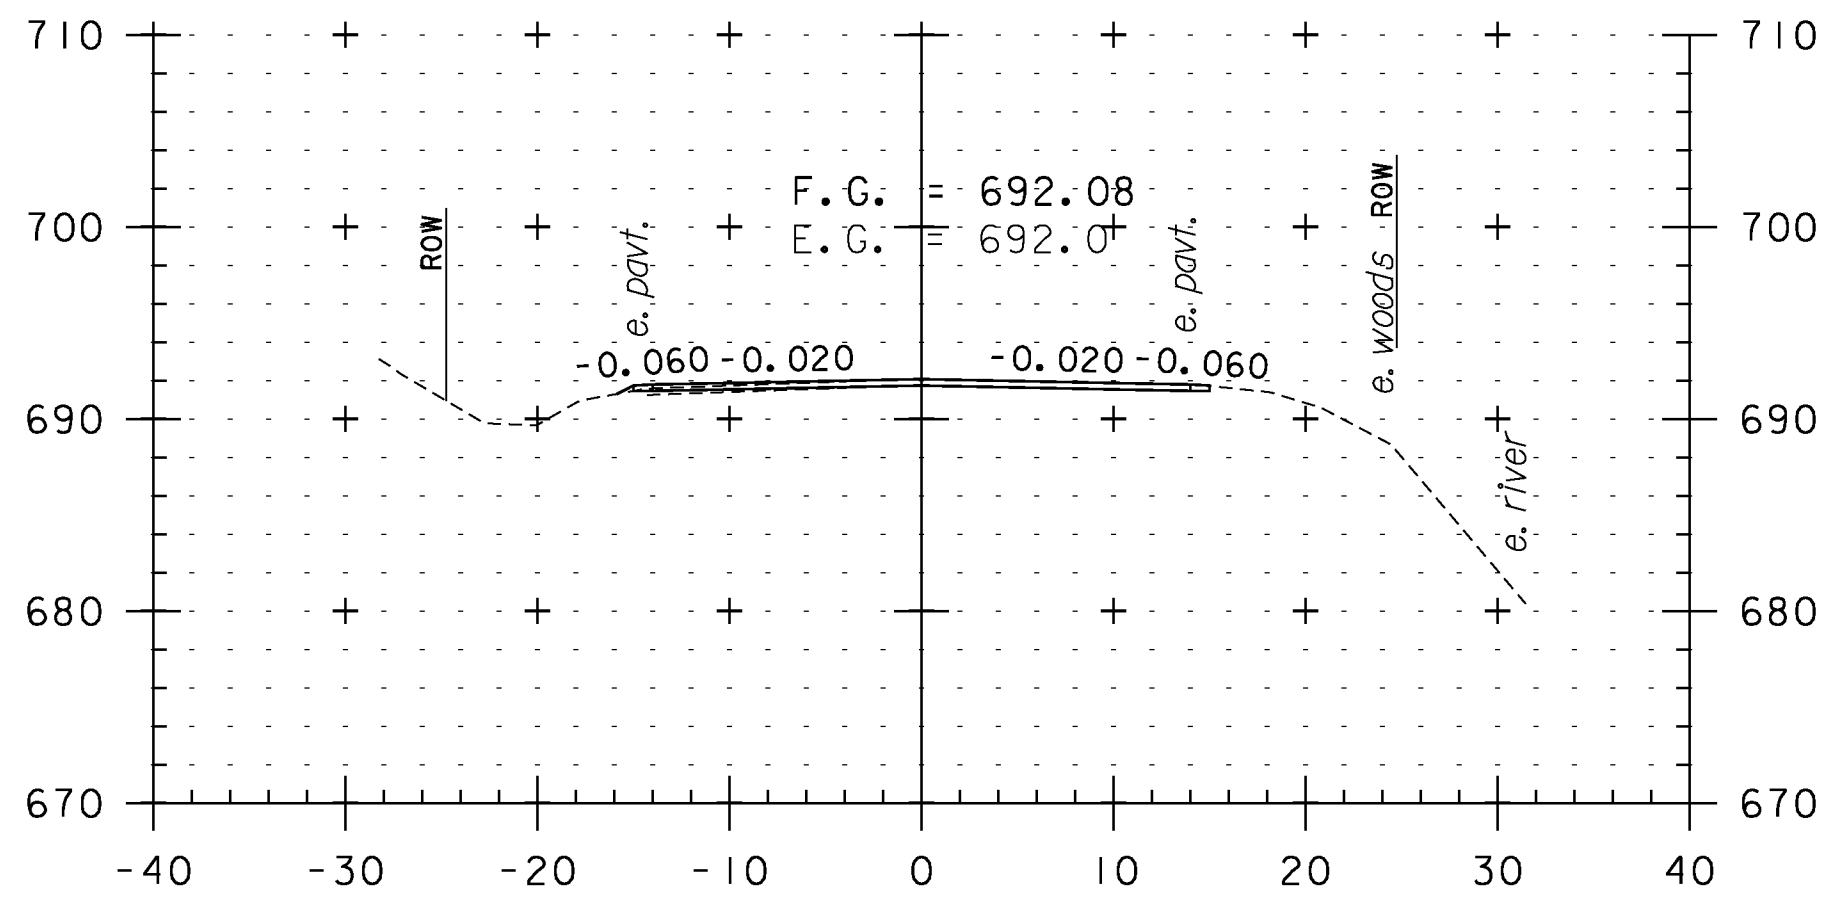


345+50

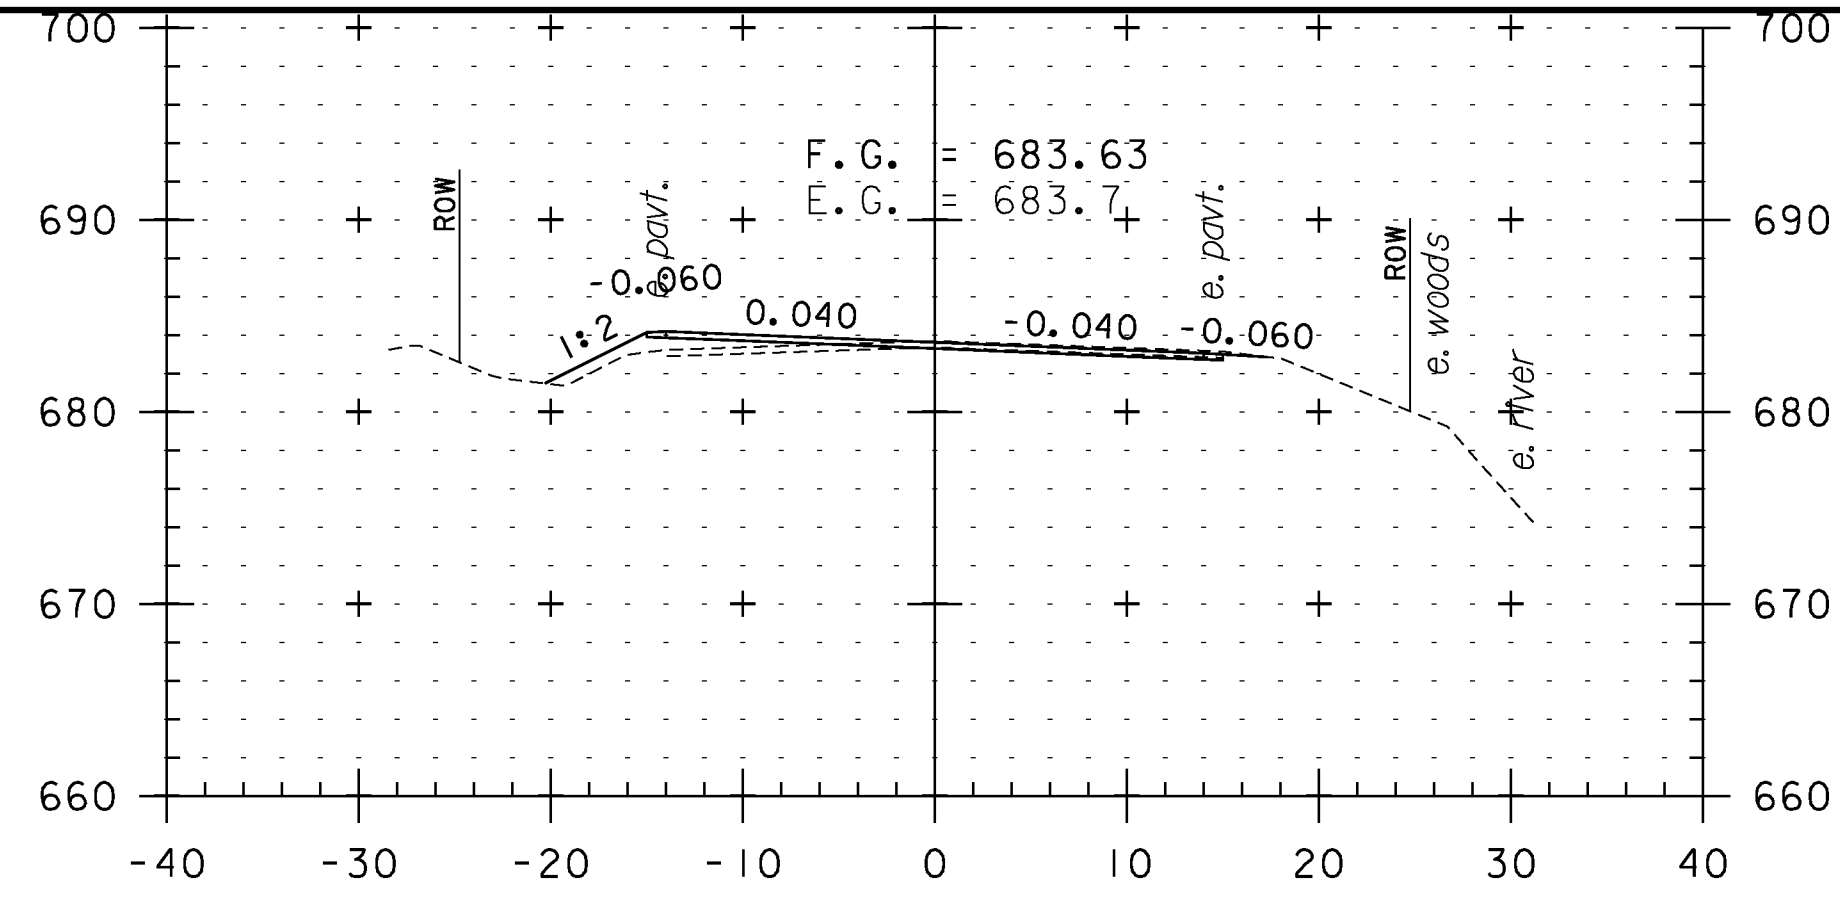


347+00

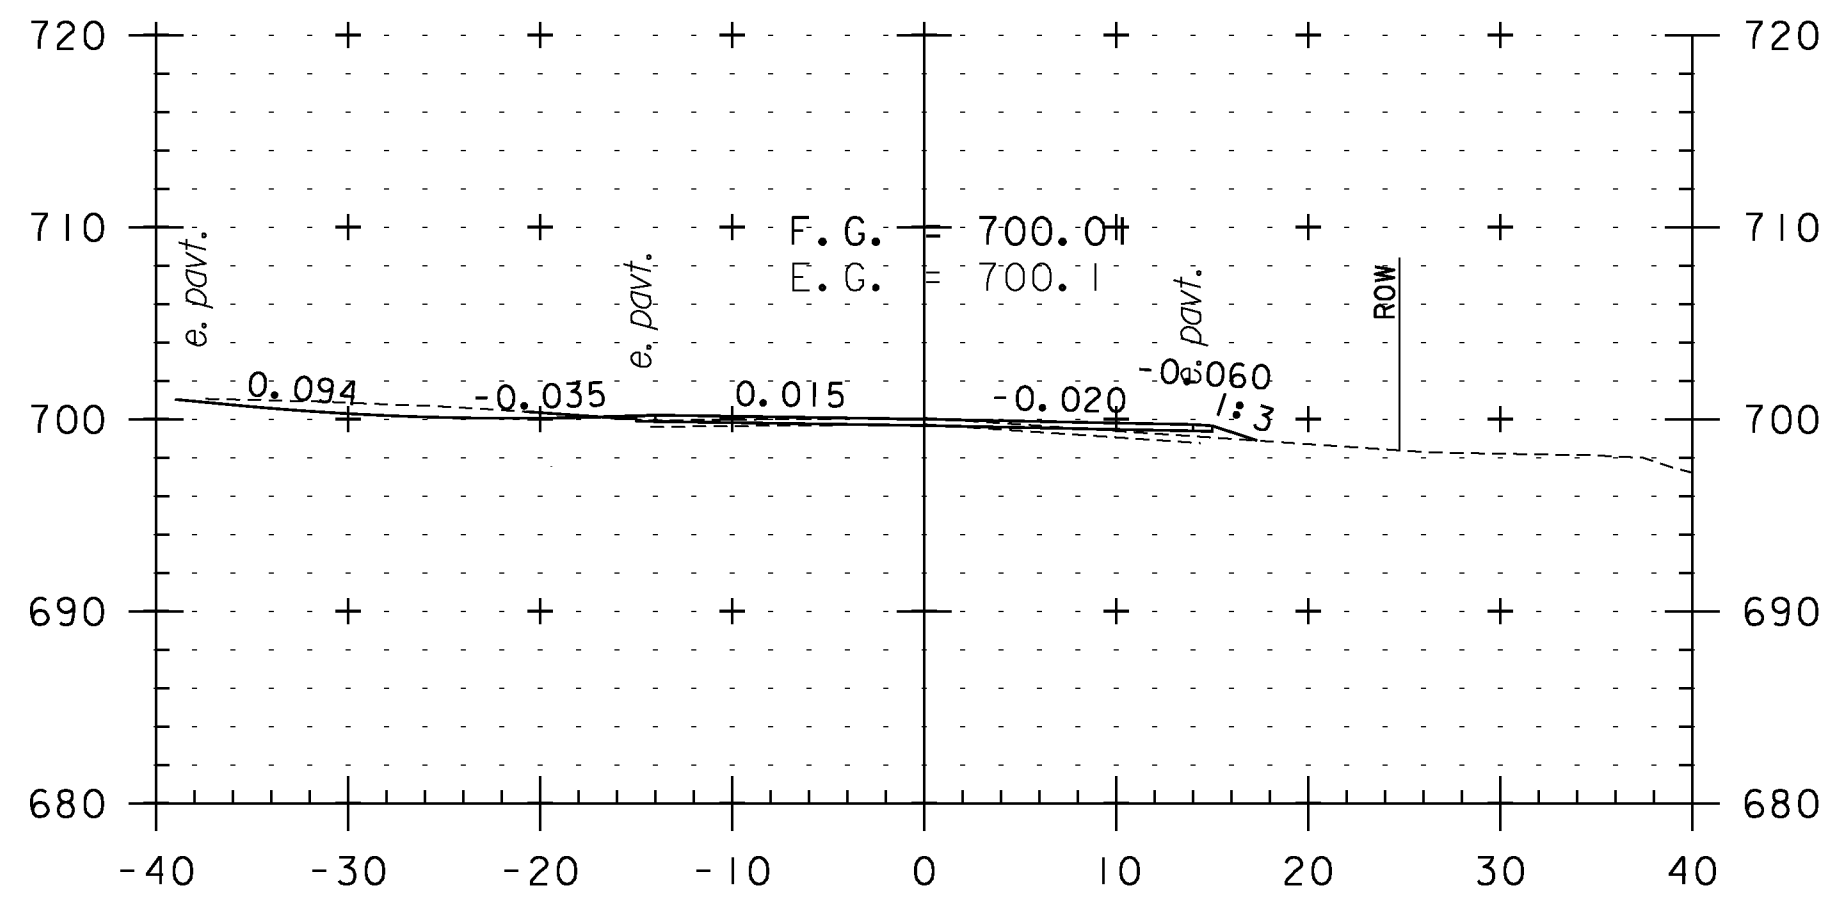


344+00
TH 37

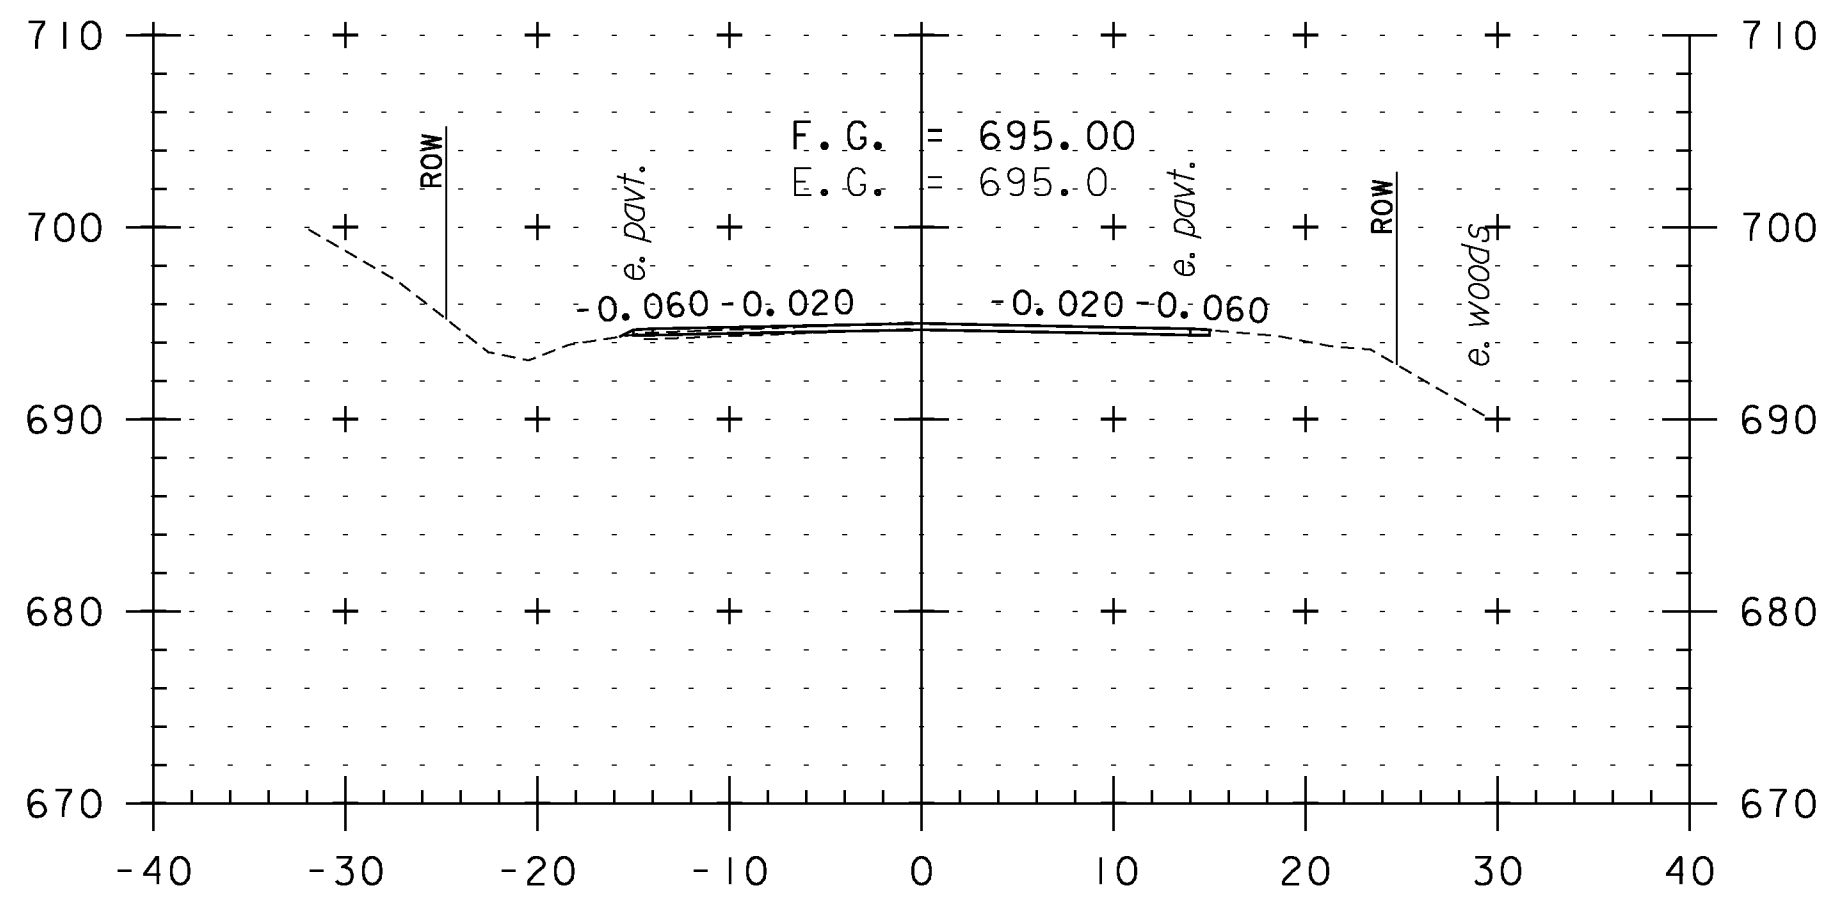


345+00

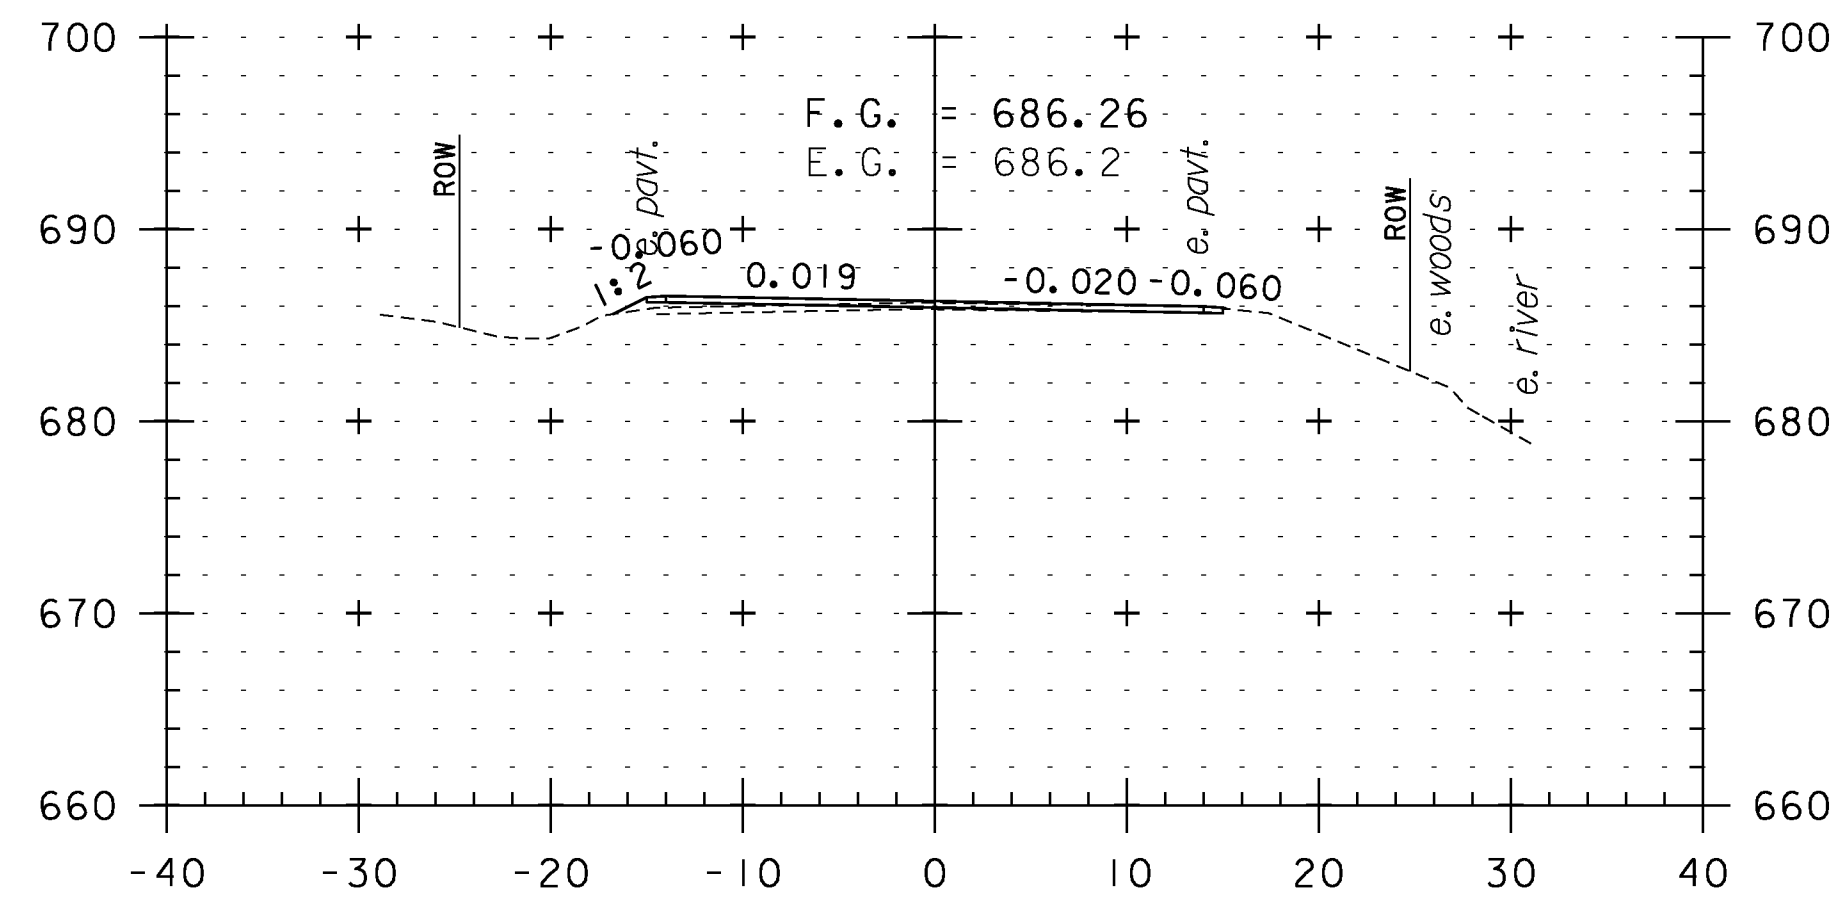


346+50

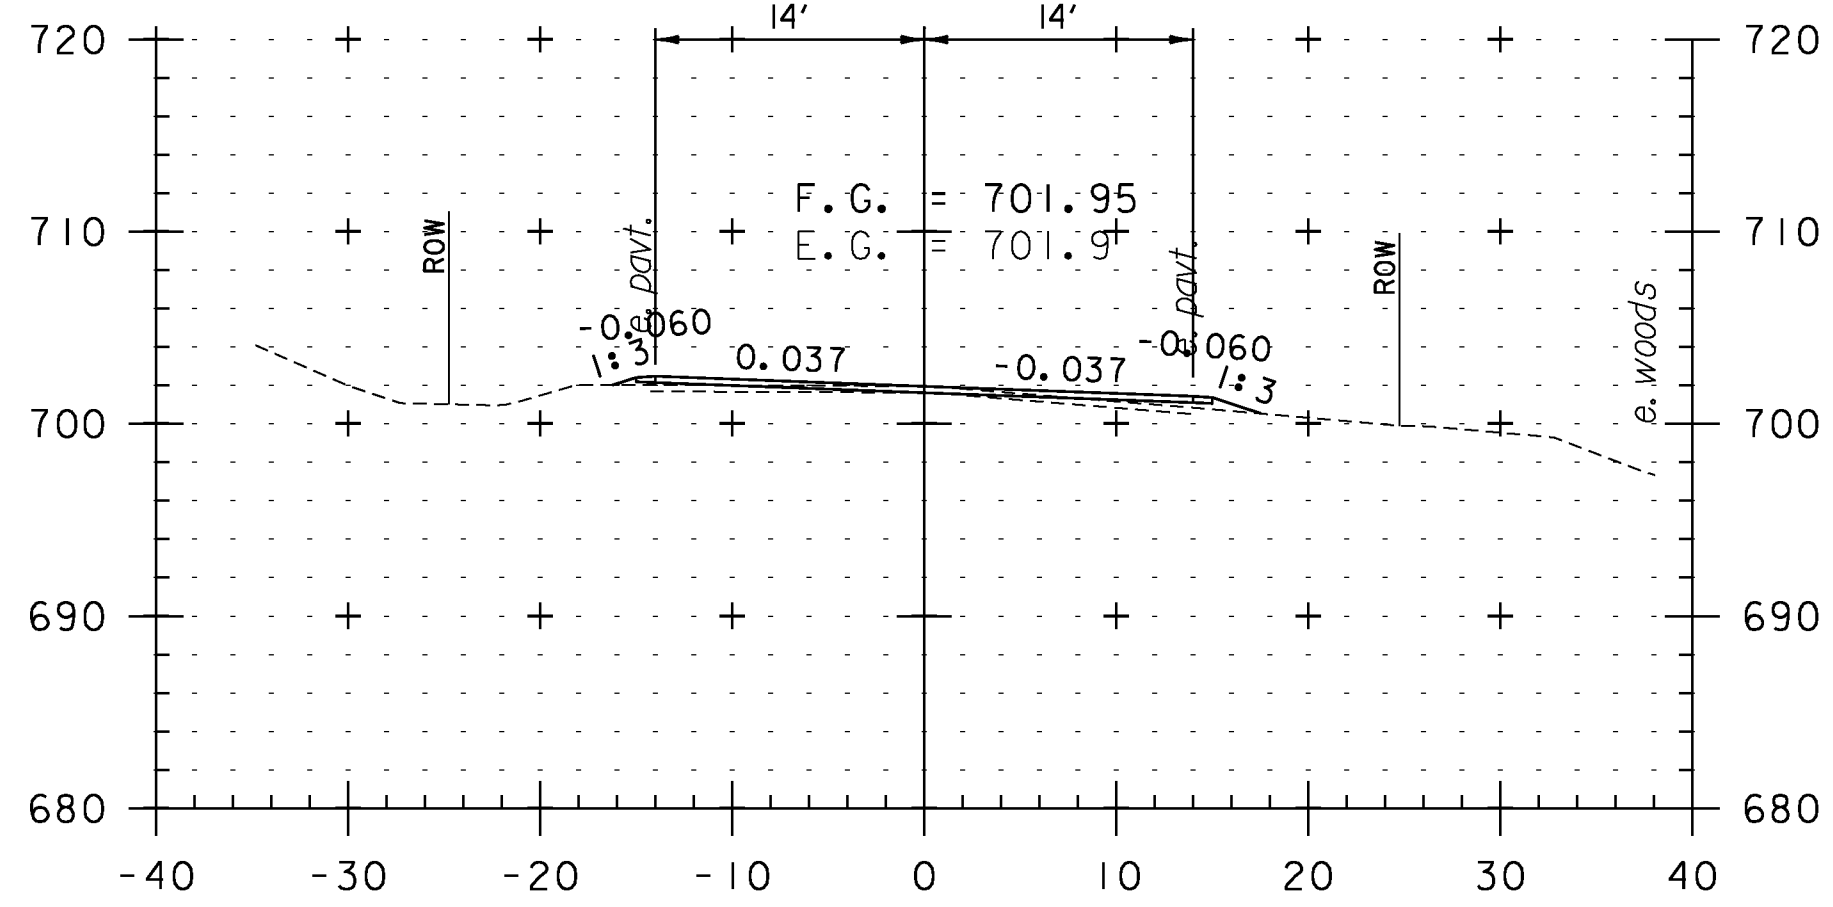

343+50

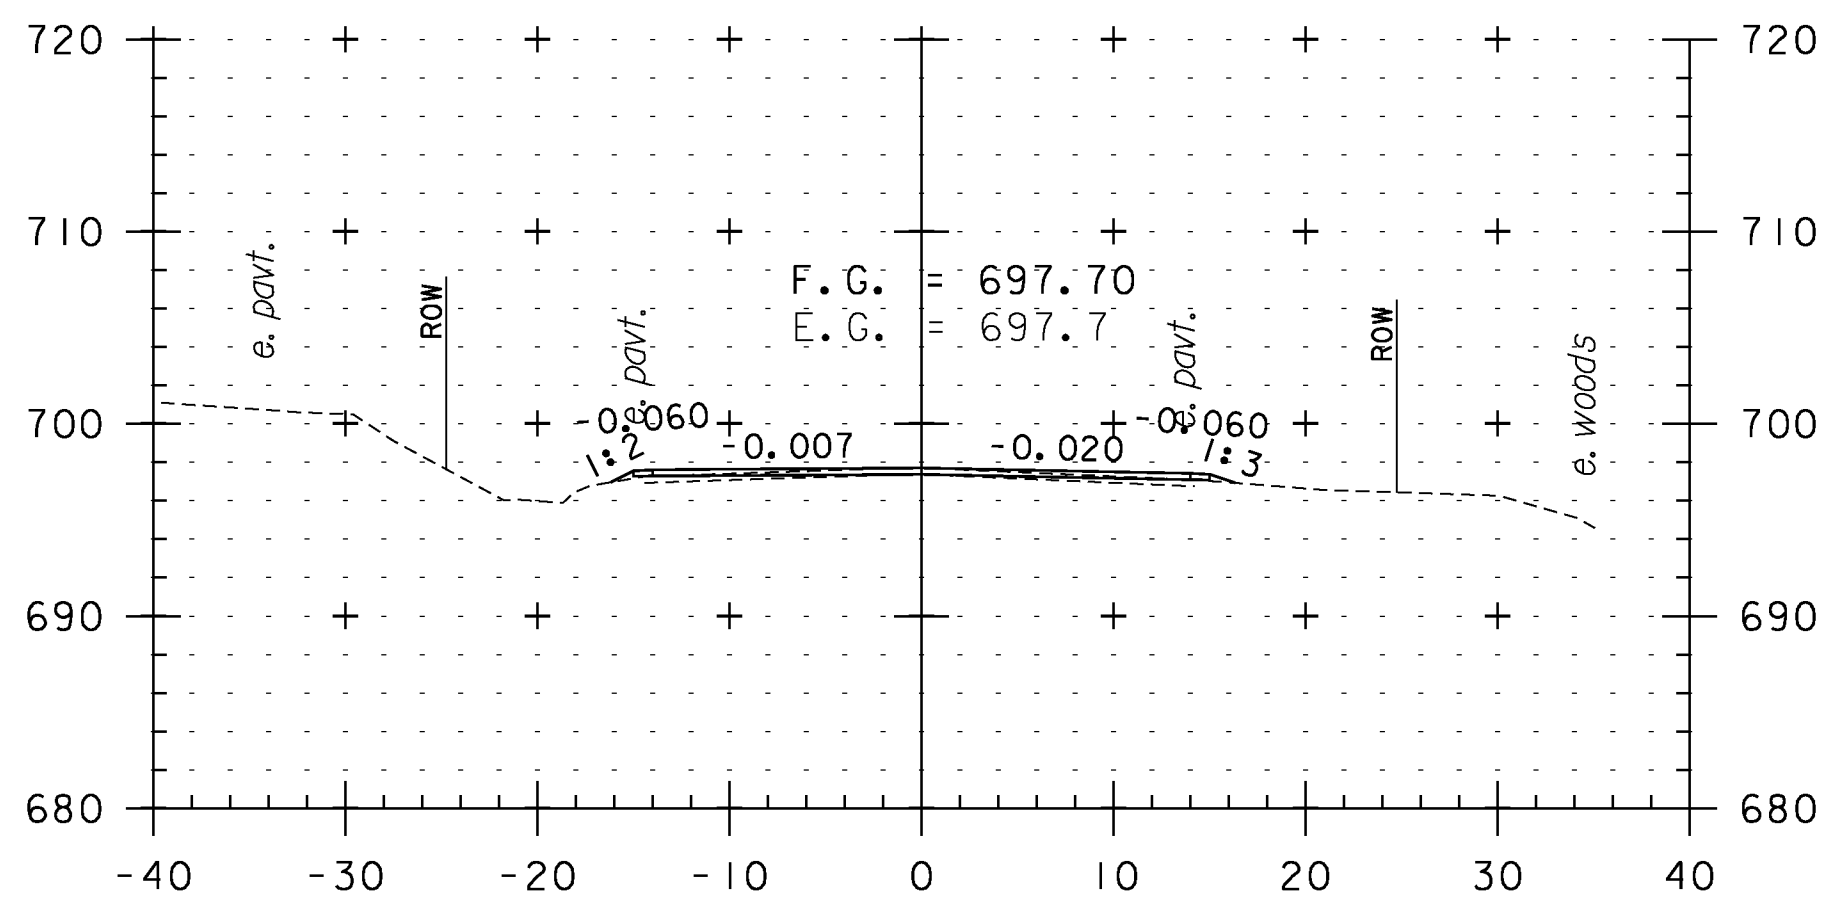

344+50

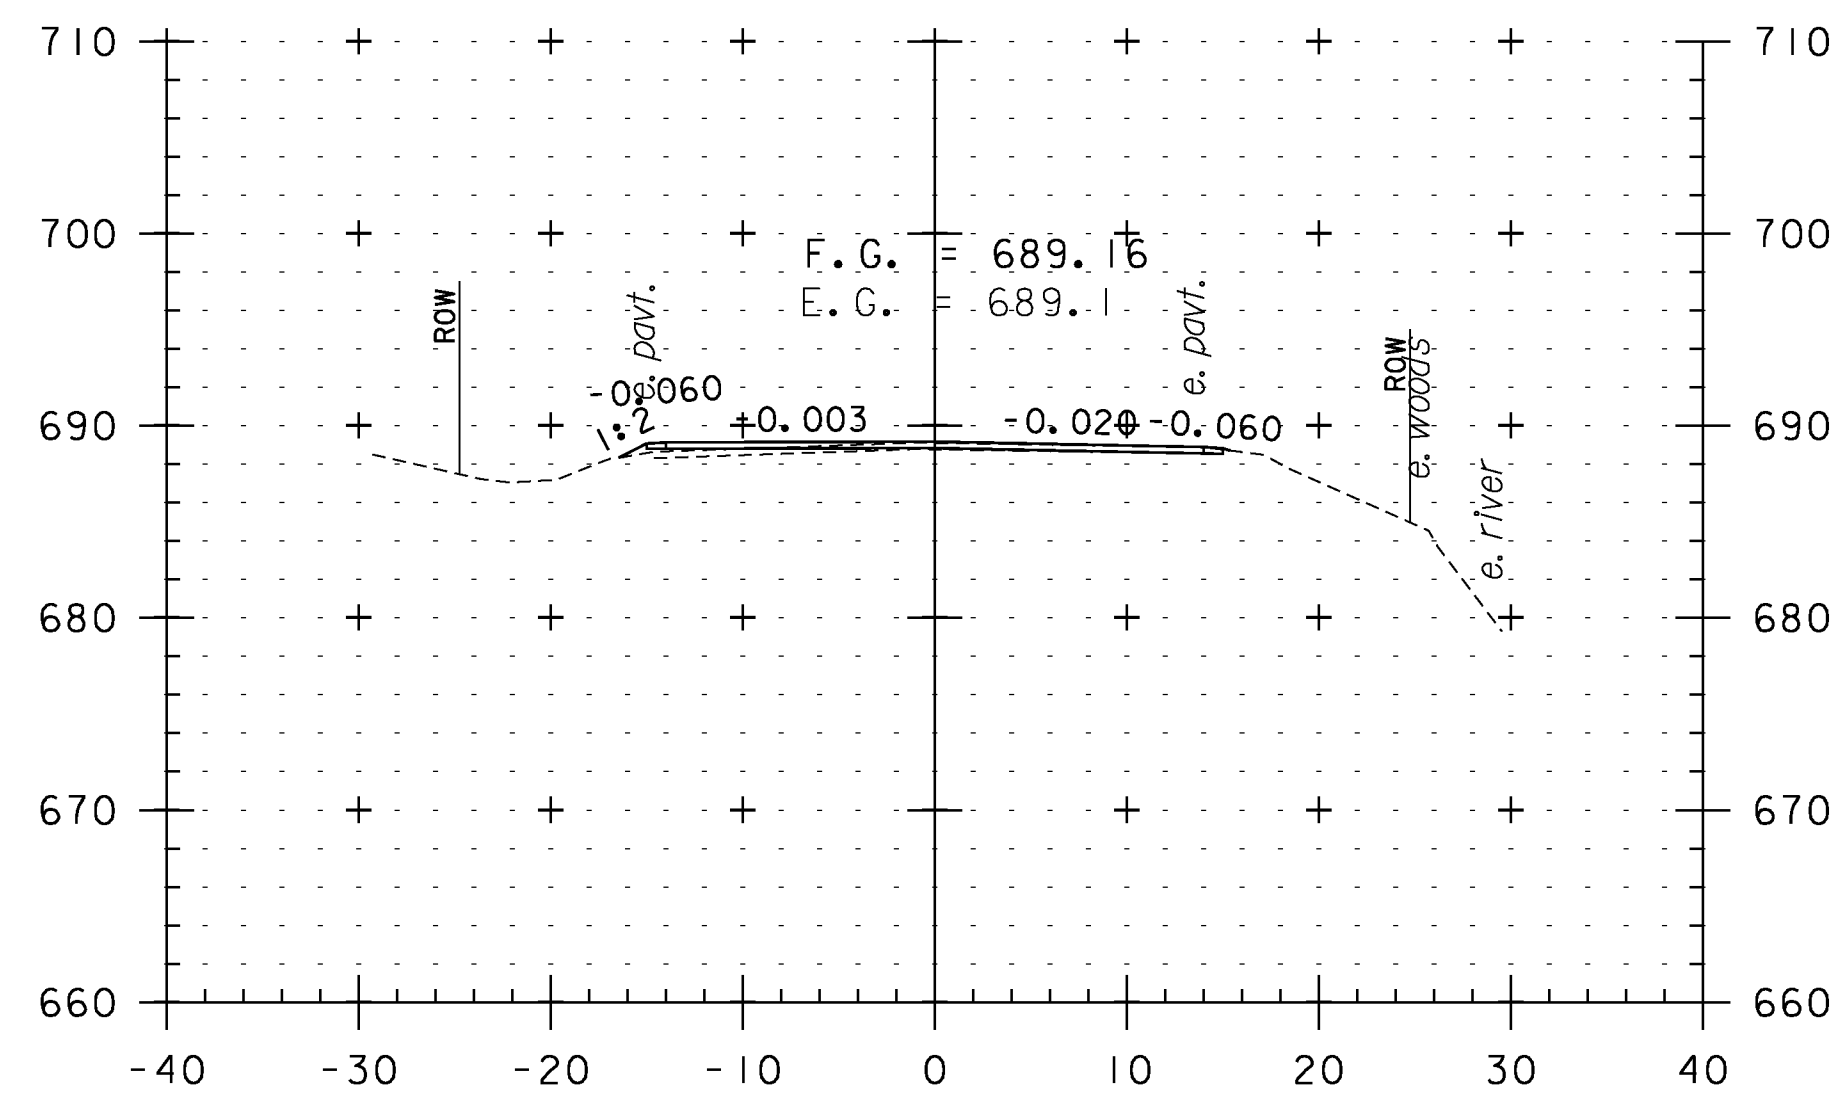

346+00

CROSS SECTION SHEET 66

PROJECT NAME: WEATHERSFIELD

PROJECT NUMBER: STP 2913(I)

FILE NAME: I0c228

PROJECT LEADER: PTS

DESIGNED BY: NLL

IPARM FILE NAME: pI0c228.i56

PLOT DATE: 2/7/2013

DRAWN BY: WWG

CHECKED BY: PTS

SHEET 156 OF 234



STA. 343+50 TO STA. 347+00