




348+50

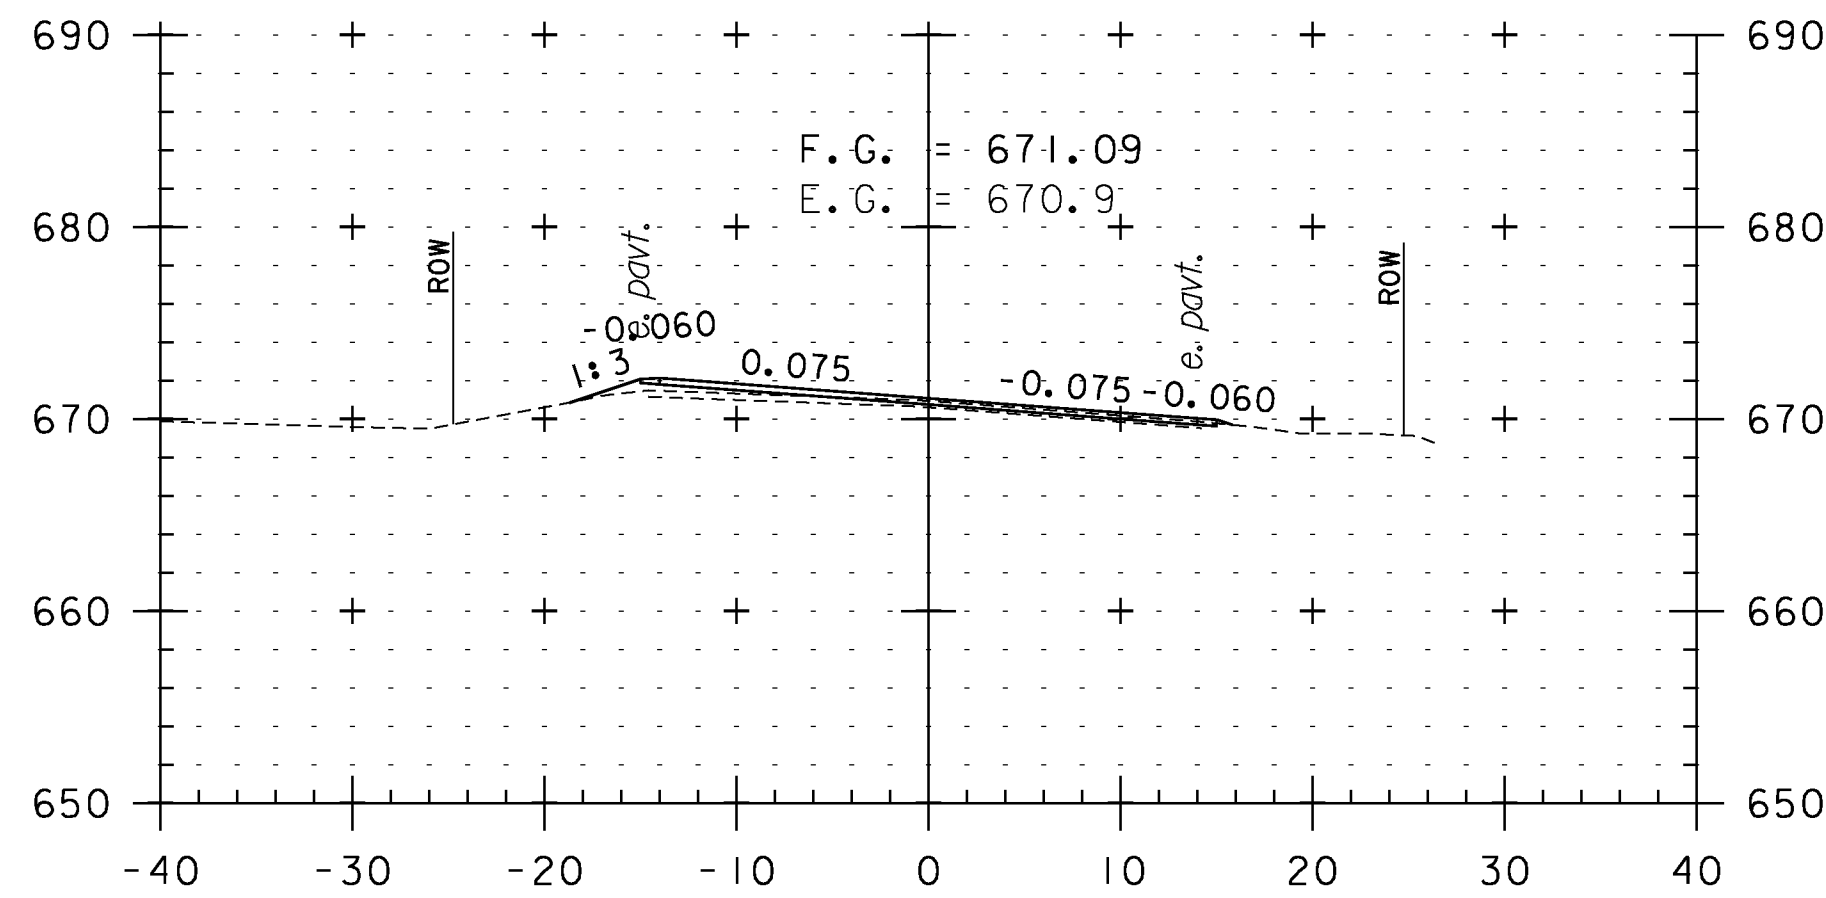


350+00

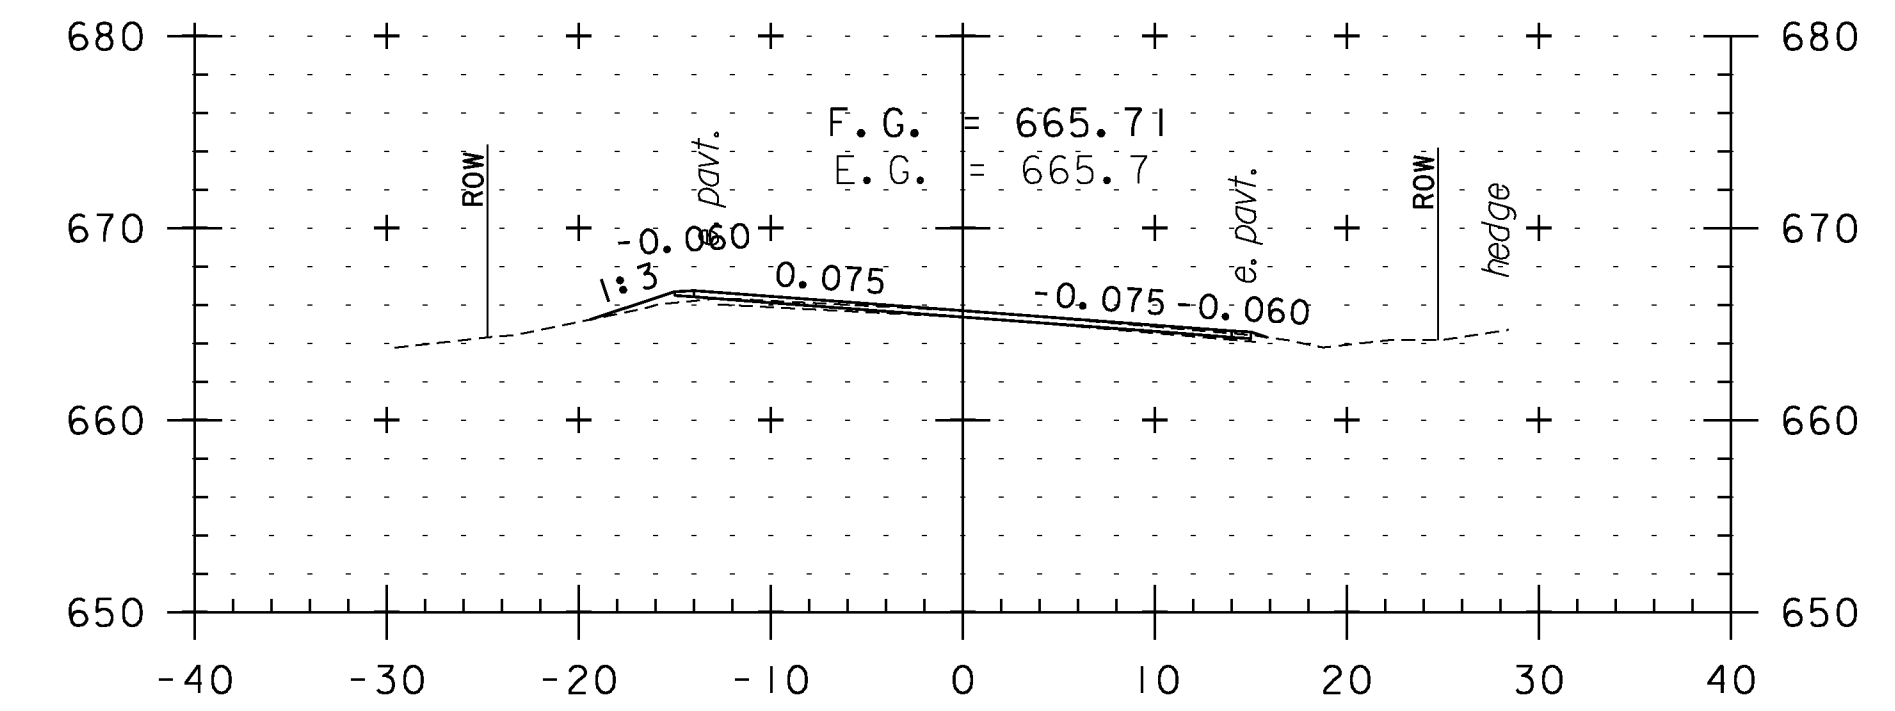


351+50

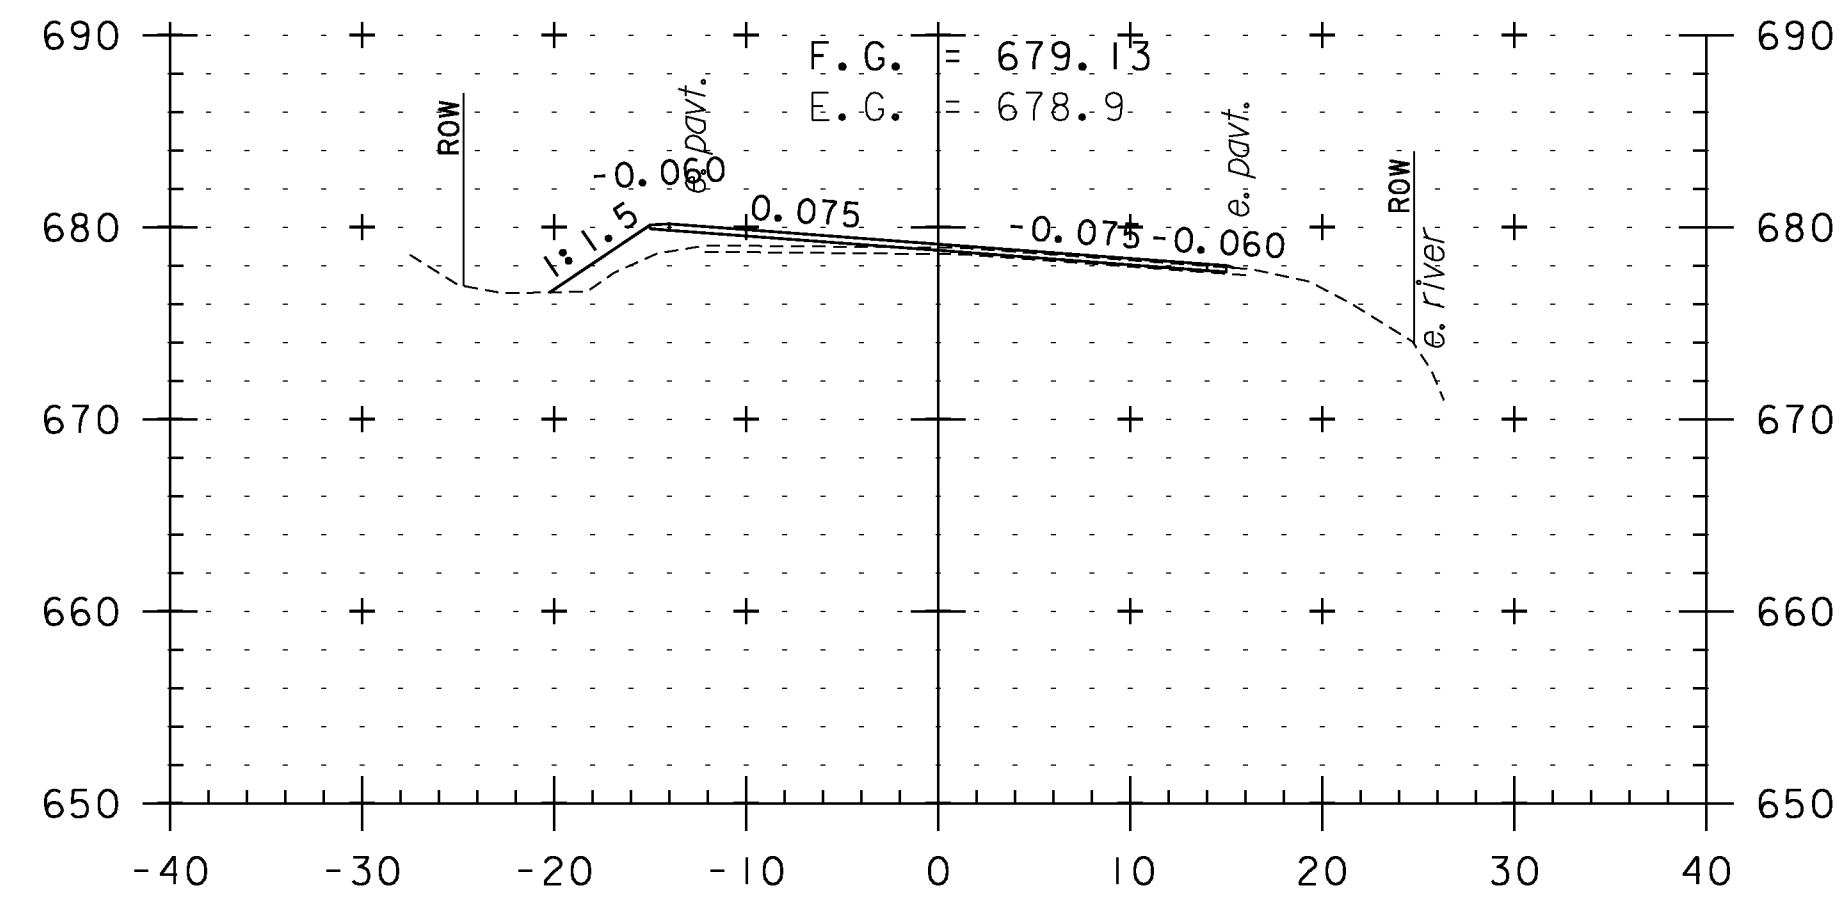


348+00

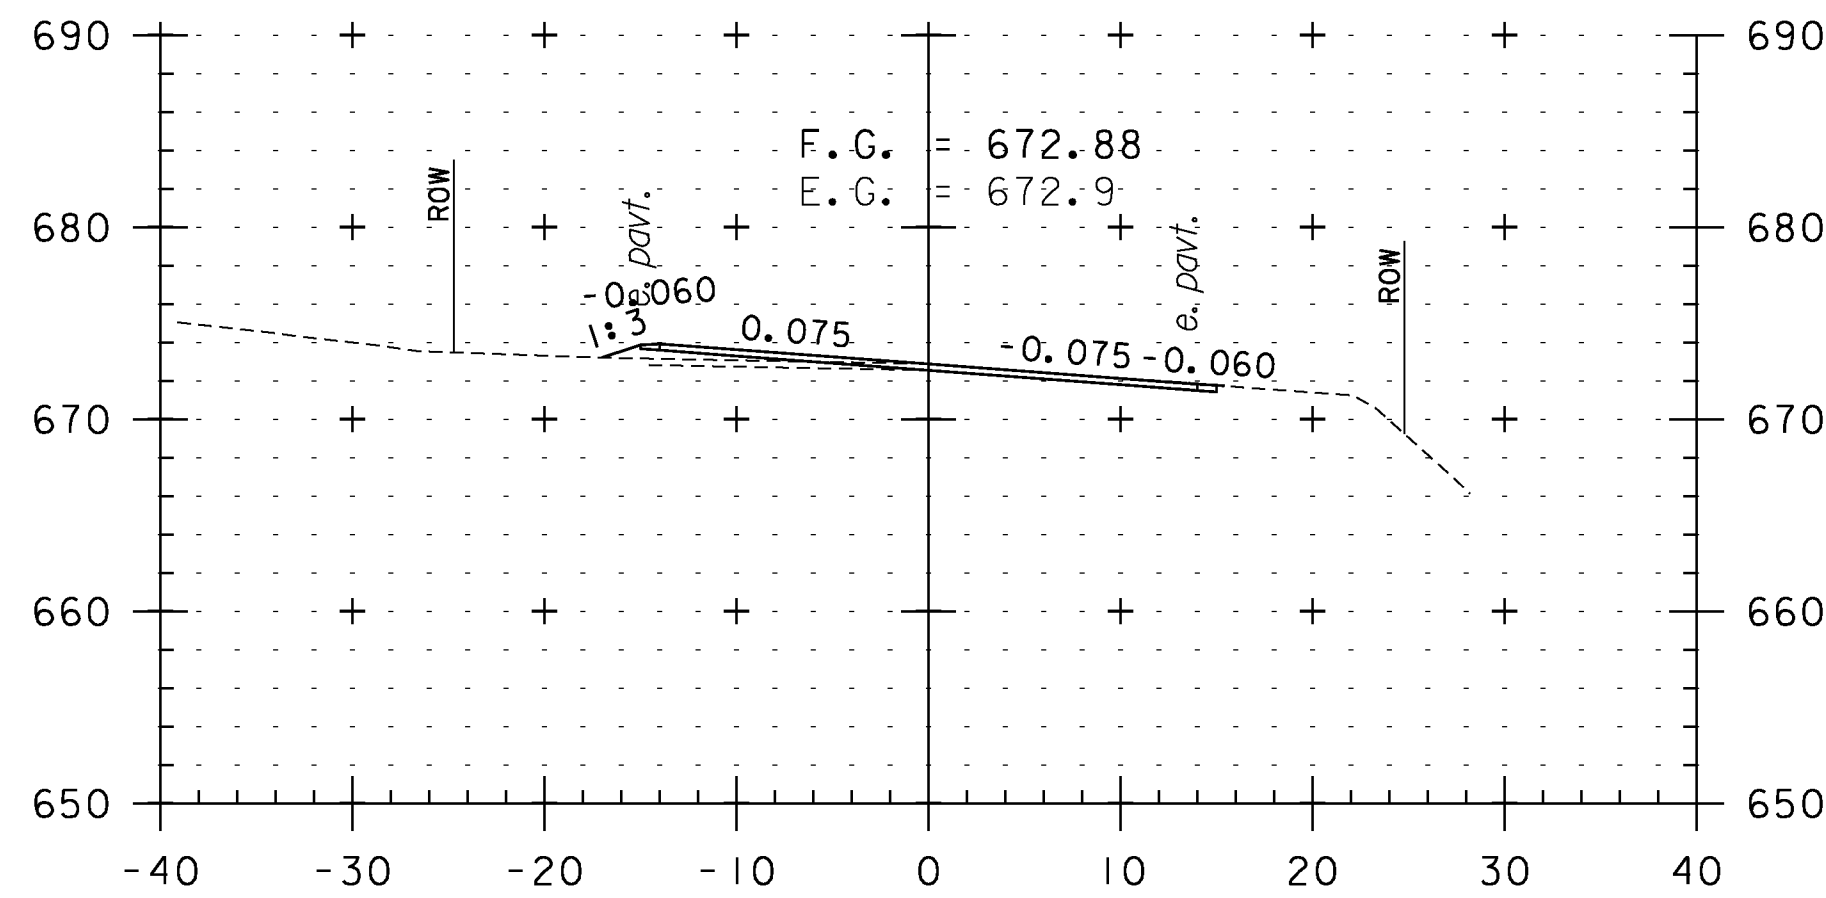


349+50

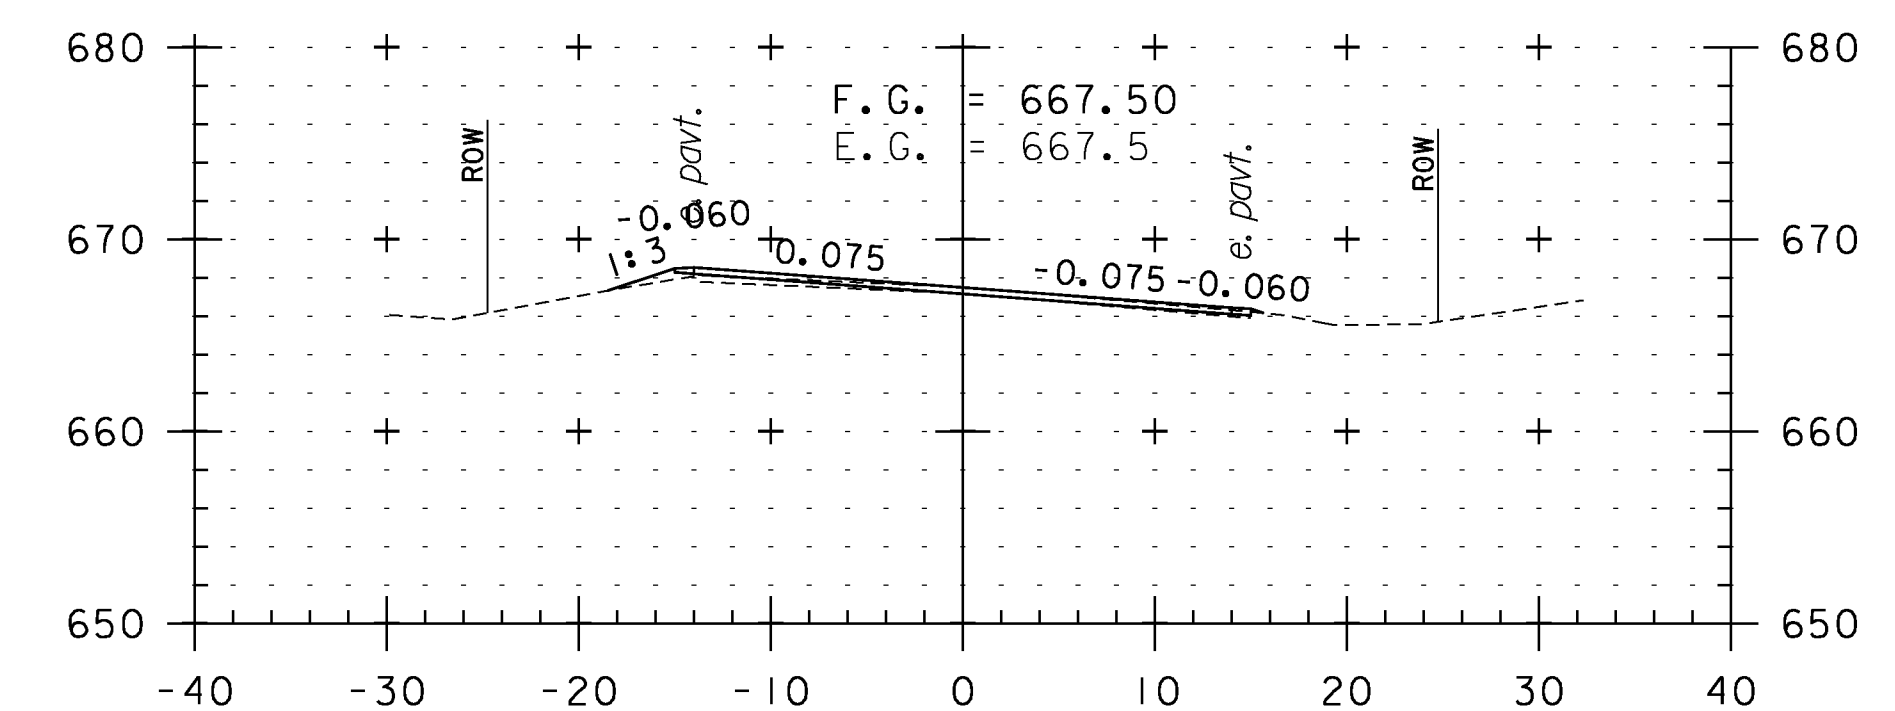


351+00

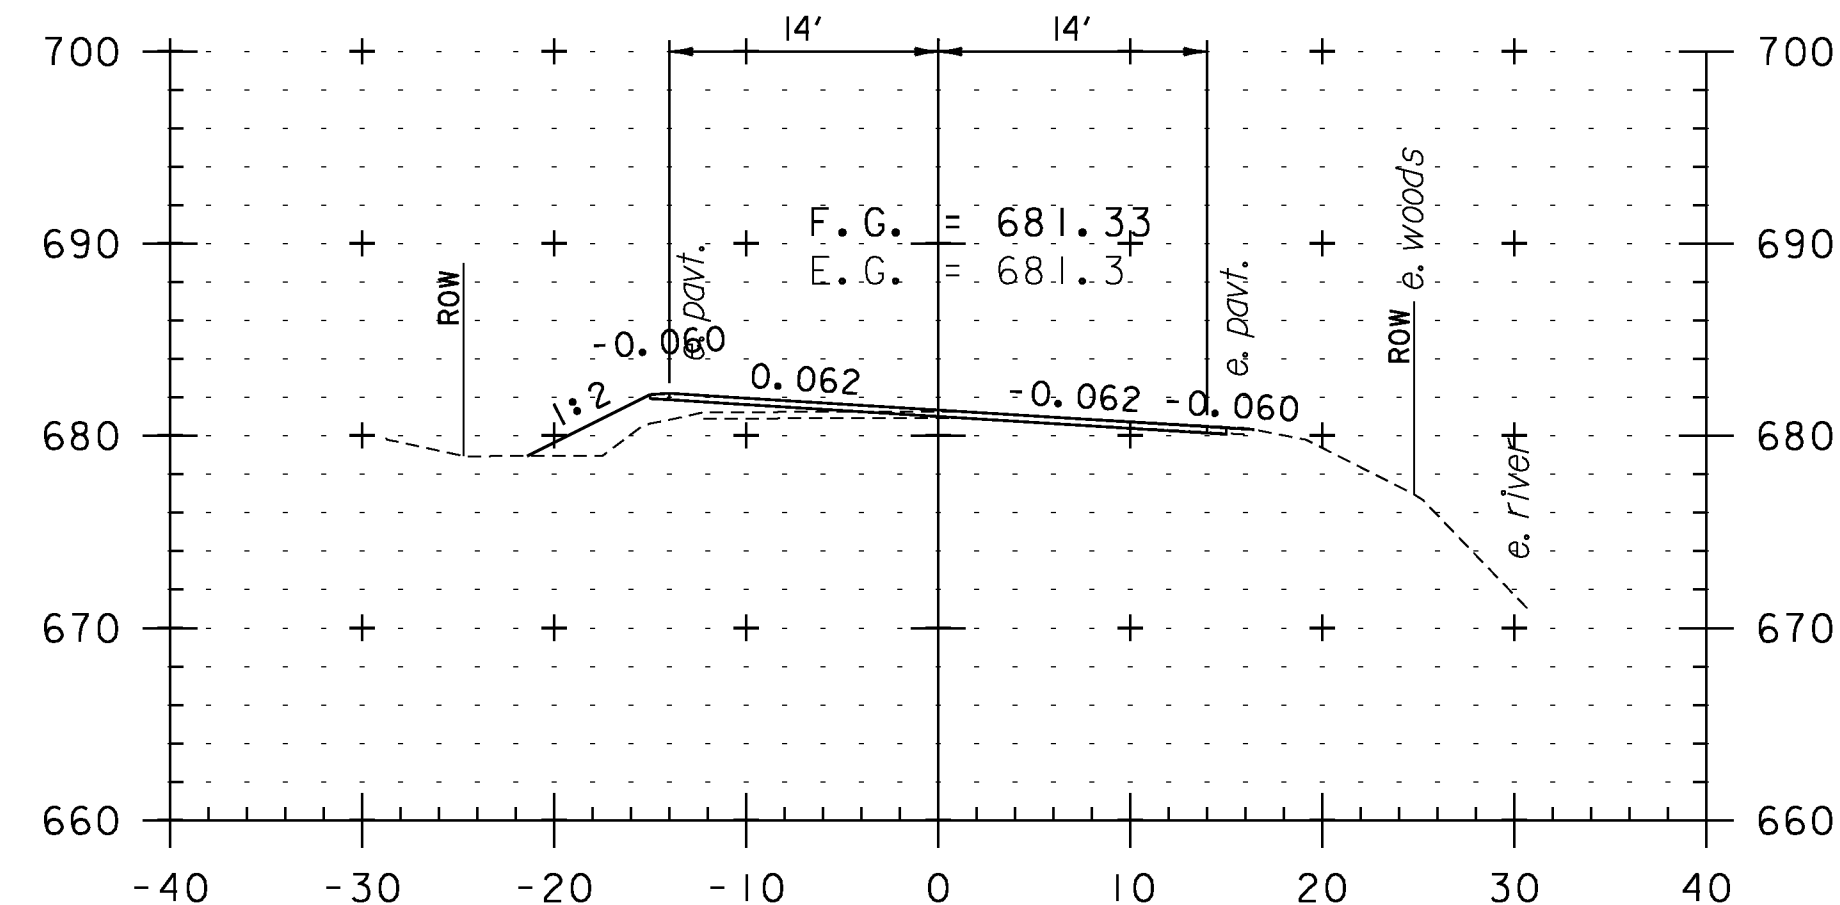

347+50

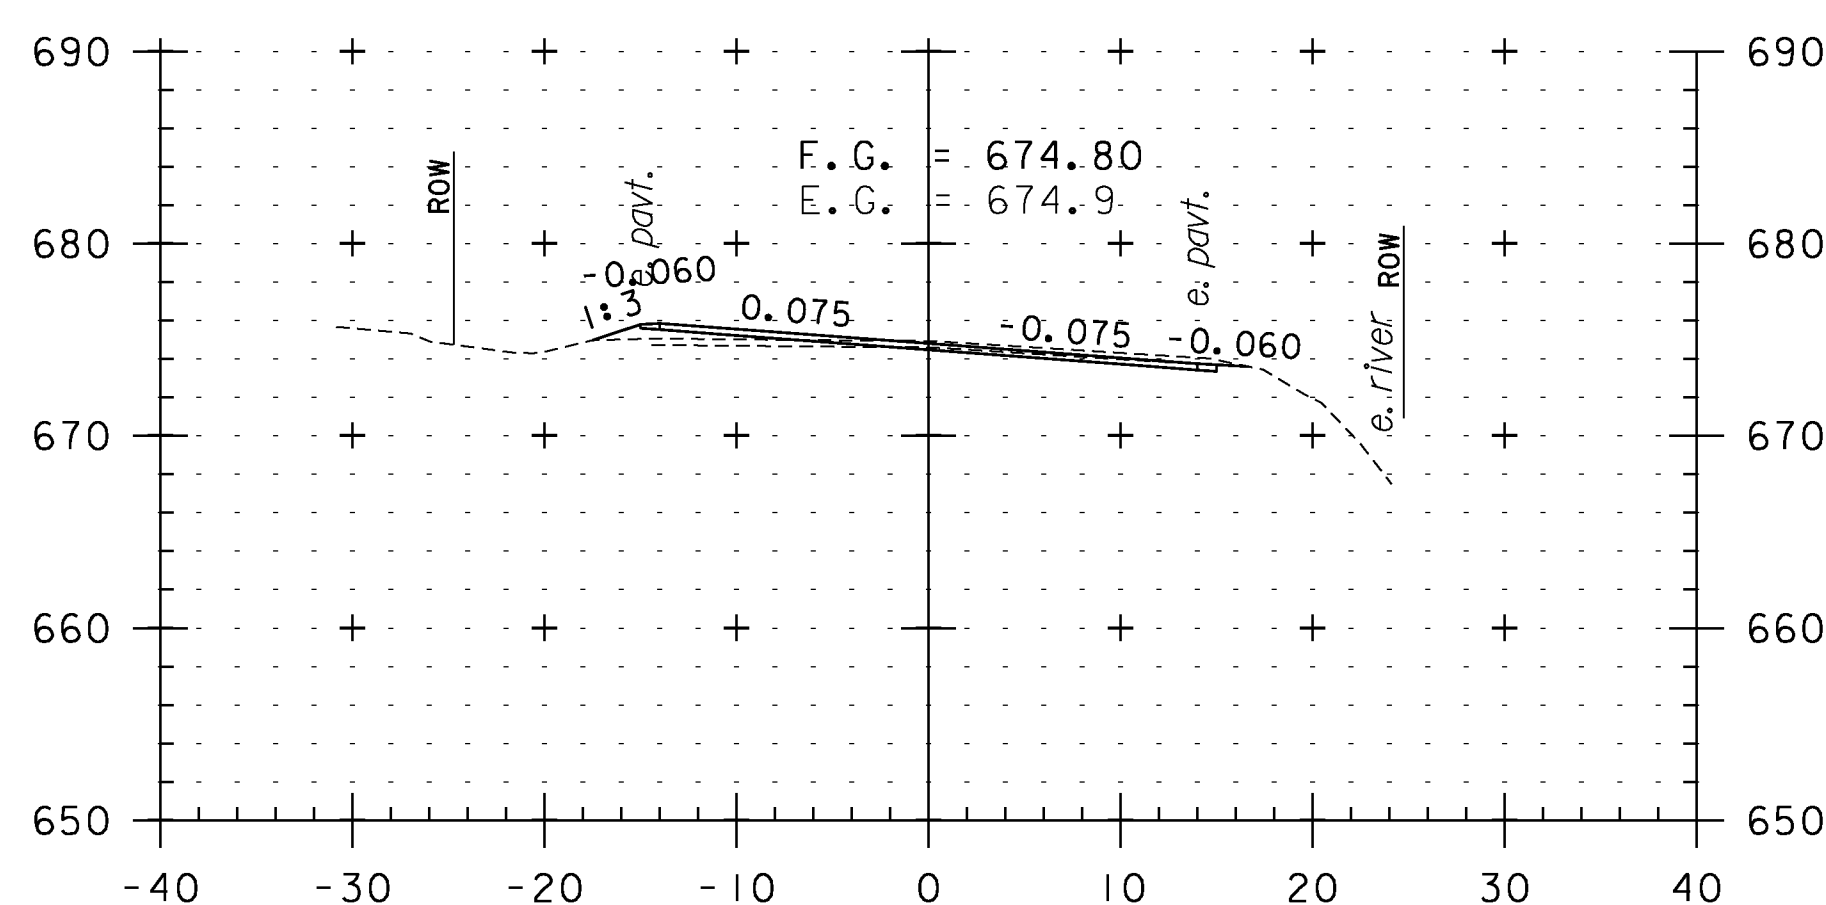

349+00

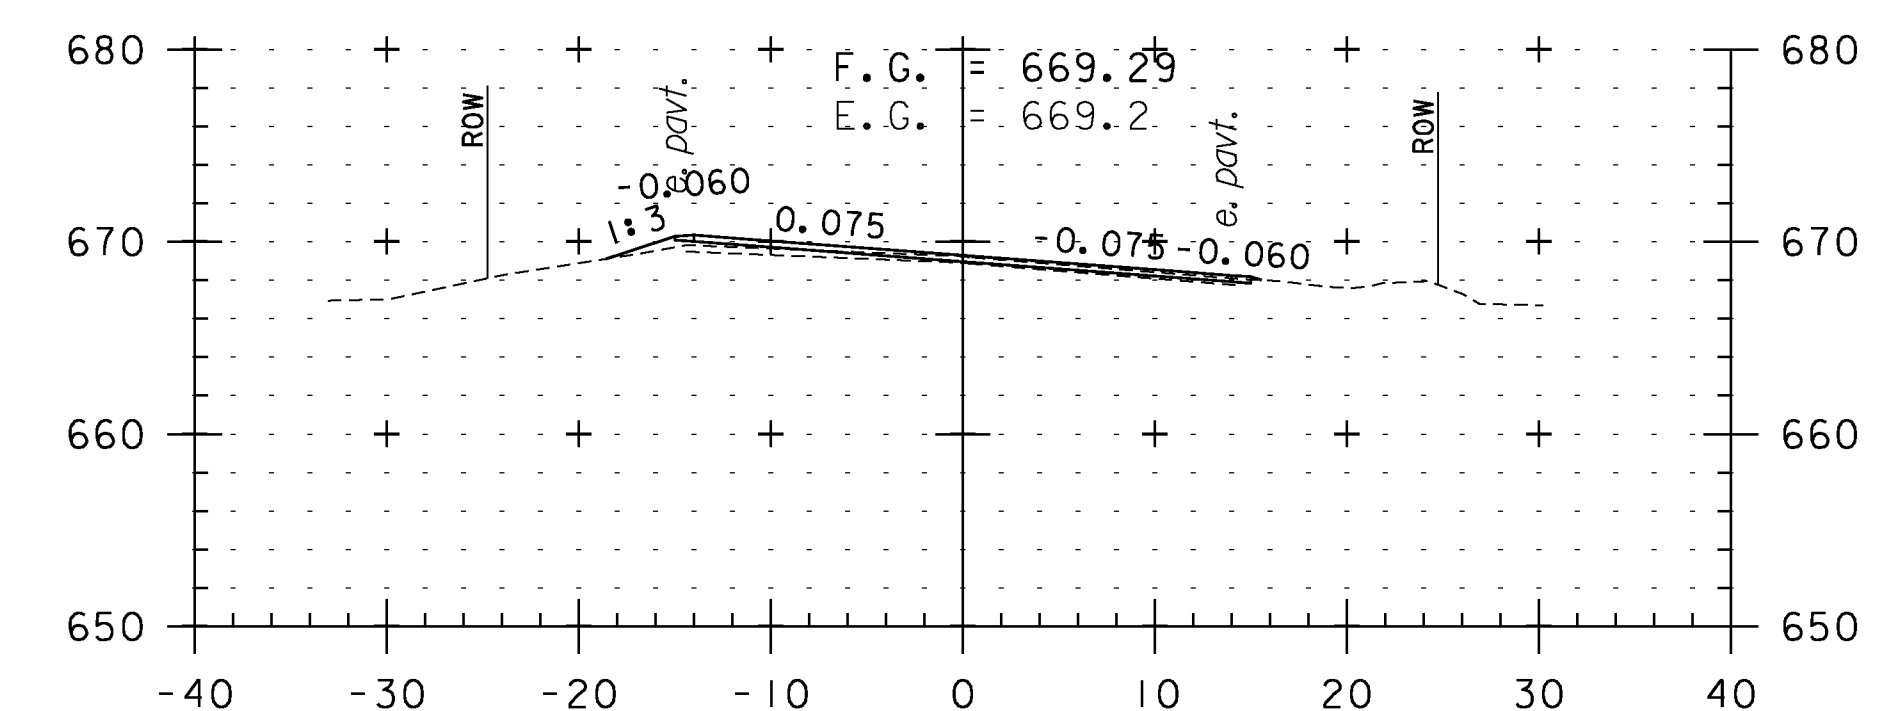

350+50

CROSS SECTION SHEET 67

PROJECT NAME: WEATHERSFIELD

PROJECT NUMBER: STP 2913(I)

FILE NAME: I0c228

PROJECT LEADER: PTS

DESIGNED BY: NLL


IPARM FILE NAME: pI0C228_I57

PLOT DATE: 2/7/2013

DRAWN BY: WWG

CHECKED BY: PTS

SHEET 157 OF 234

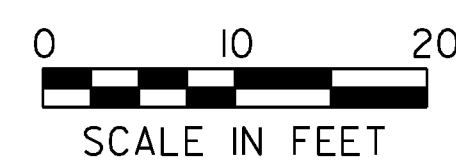

STA. 347+50 TO STA. 351+50