




365+50

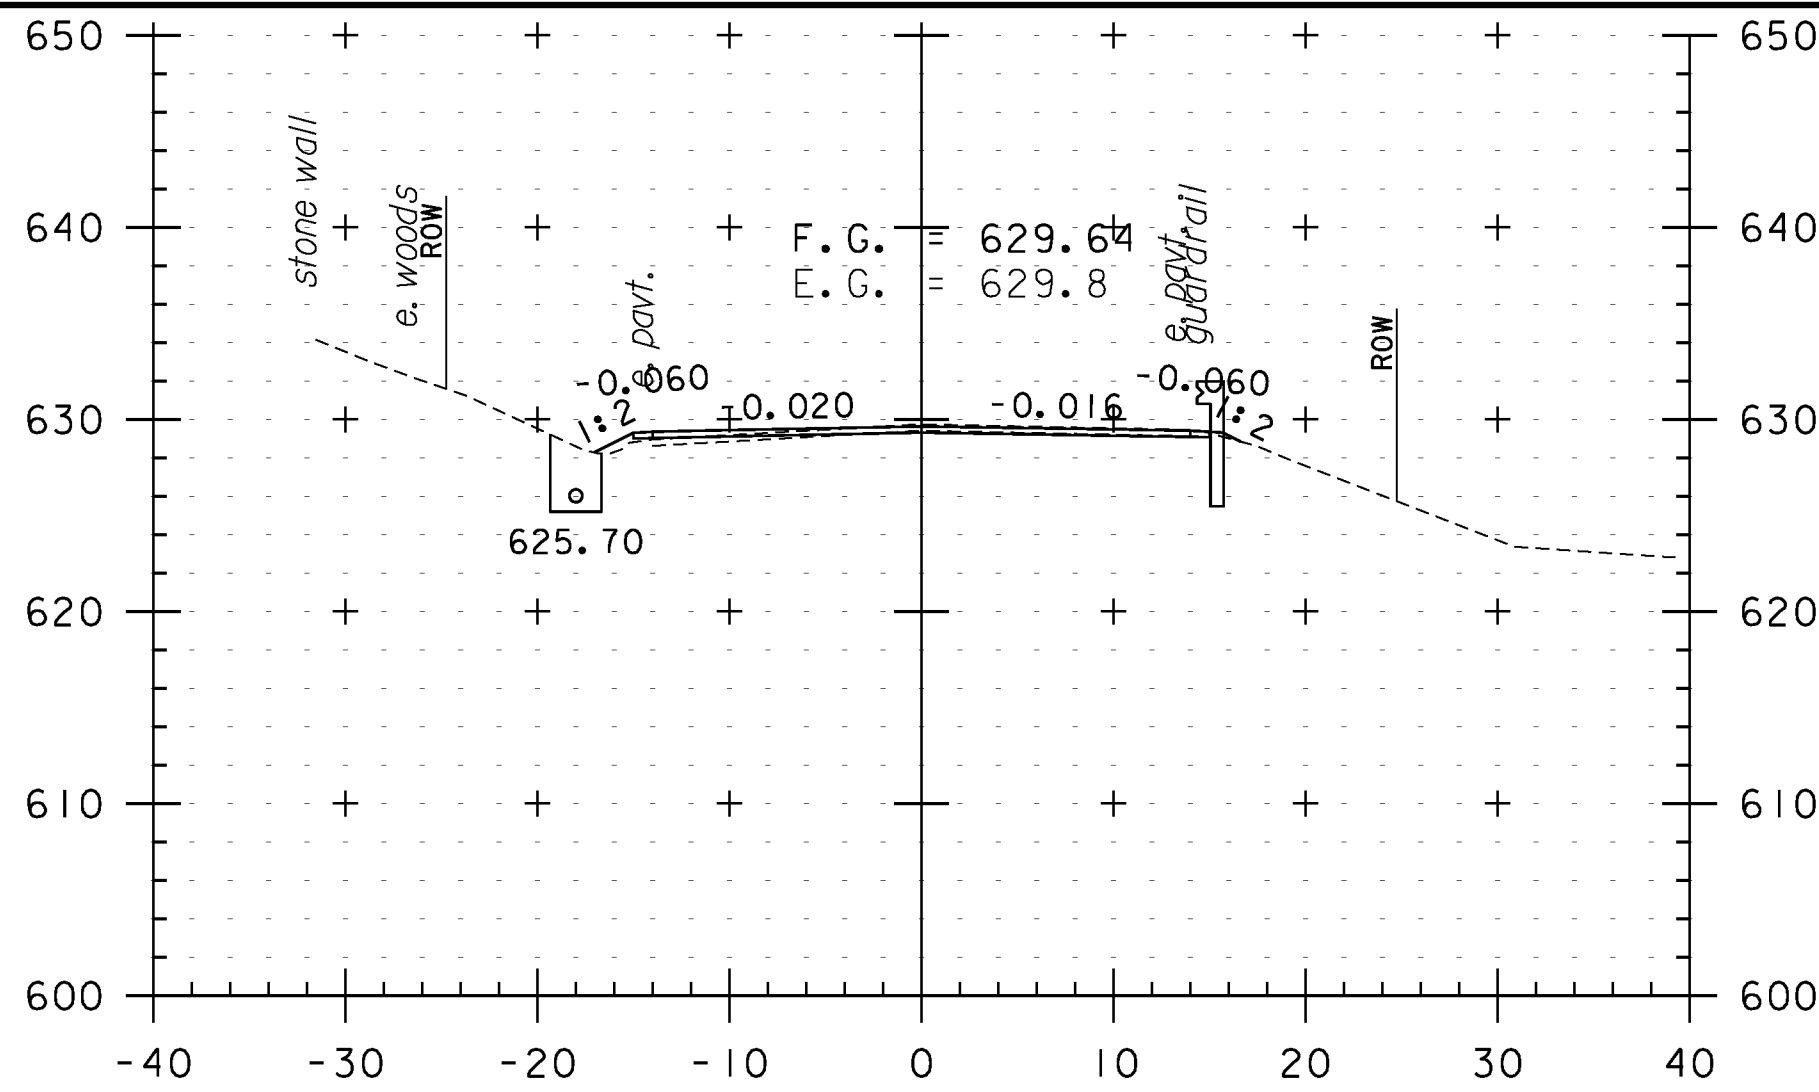


367+00

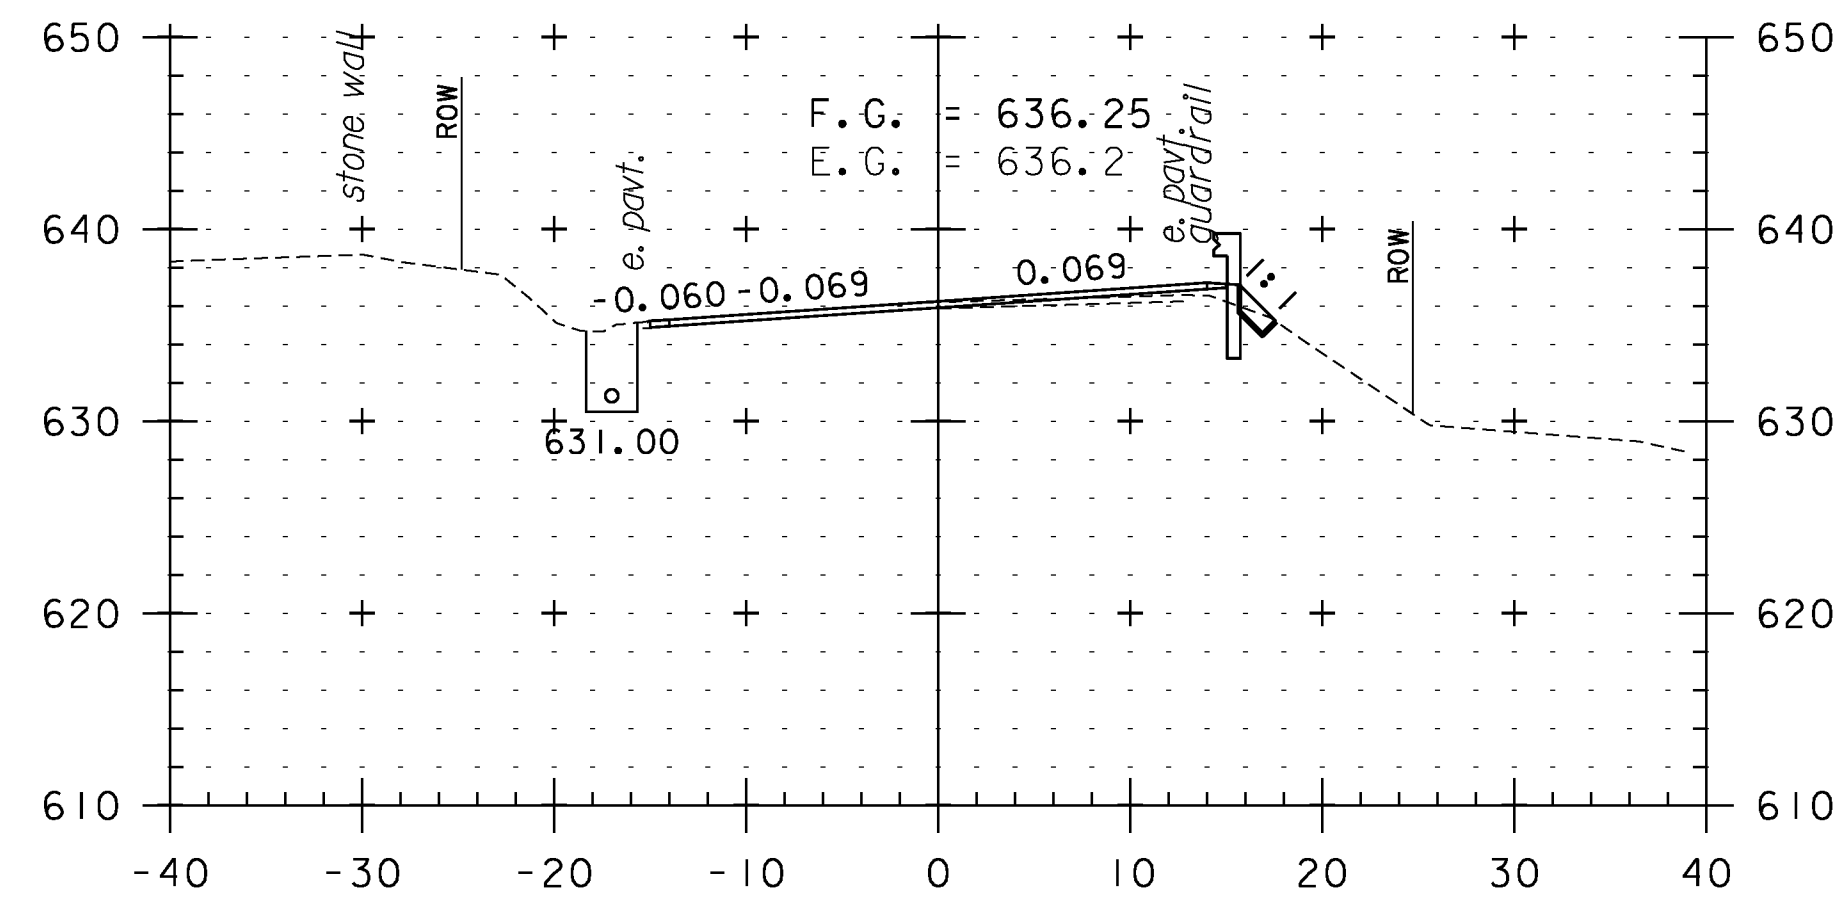


365+00

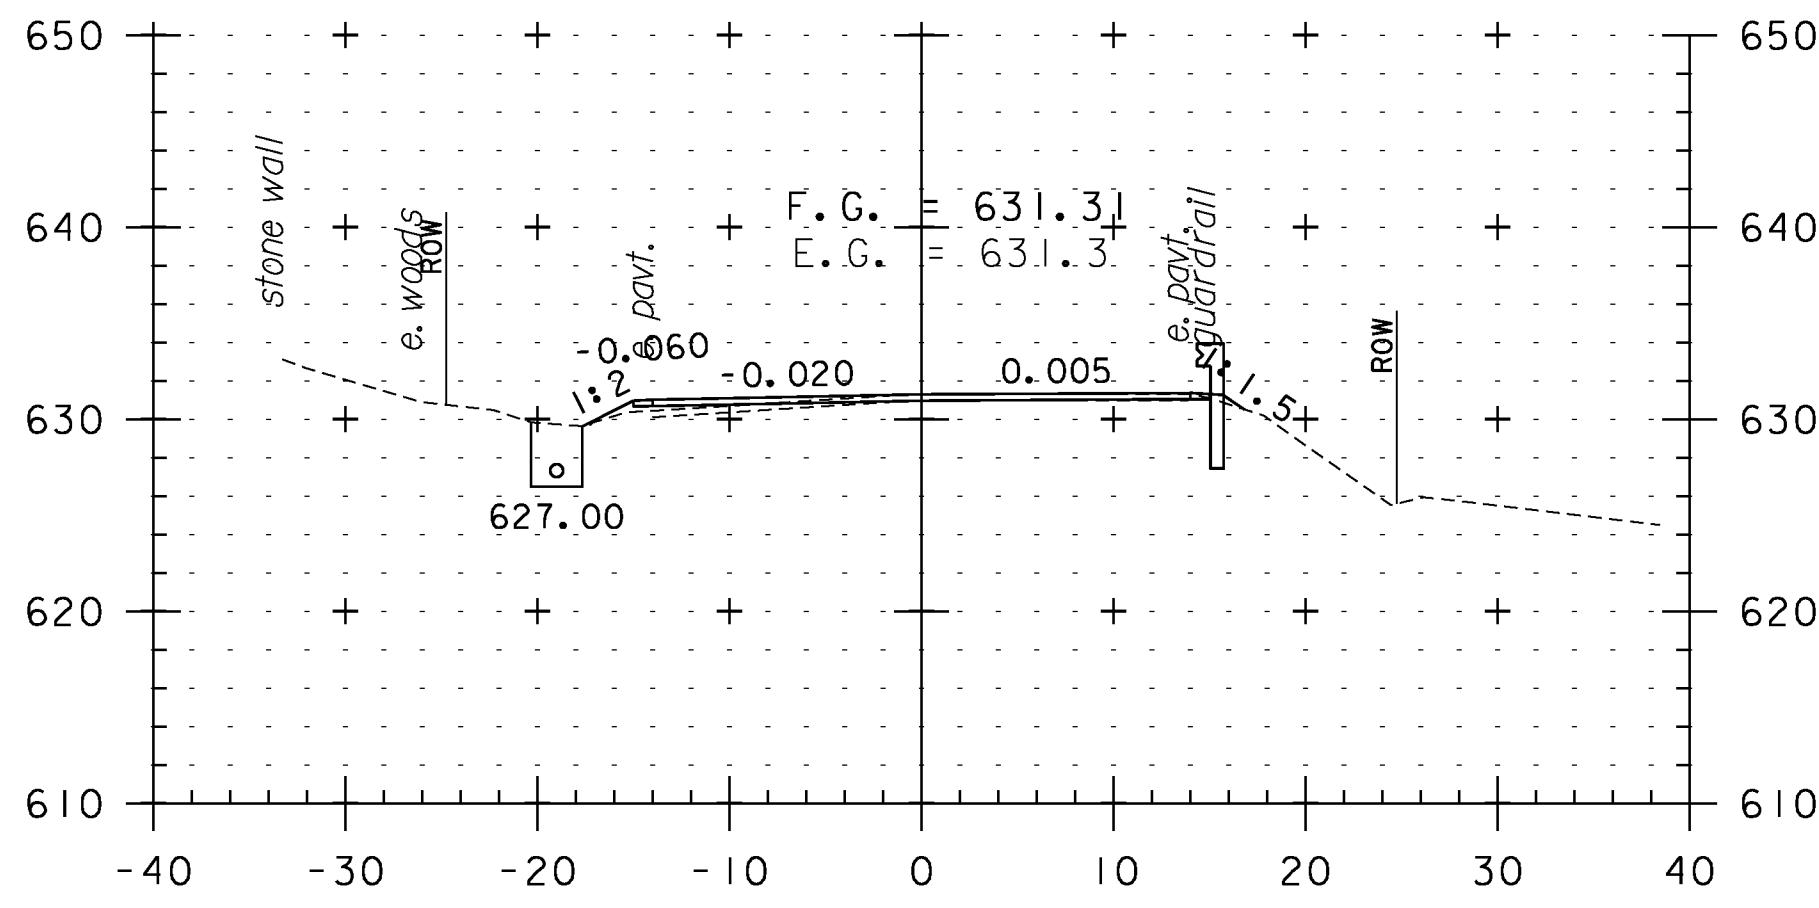


366+50

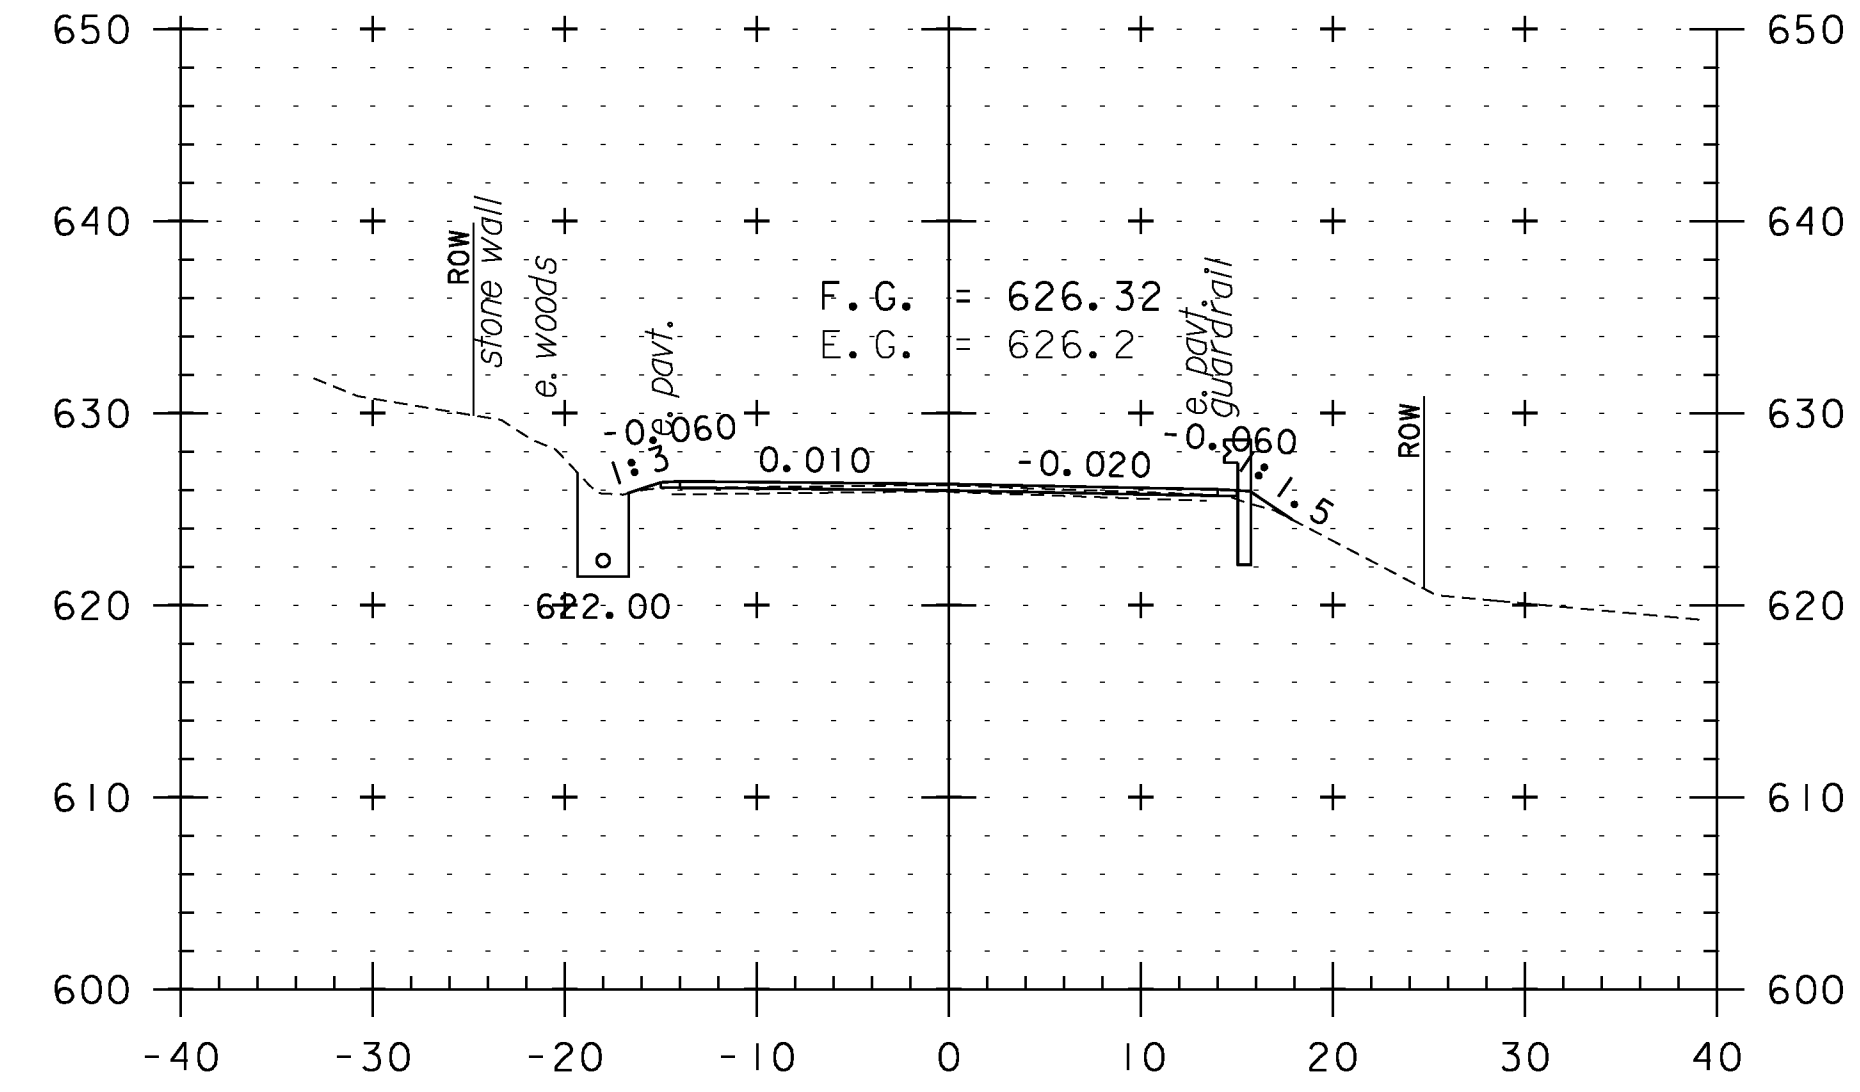


368+00

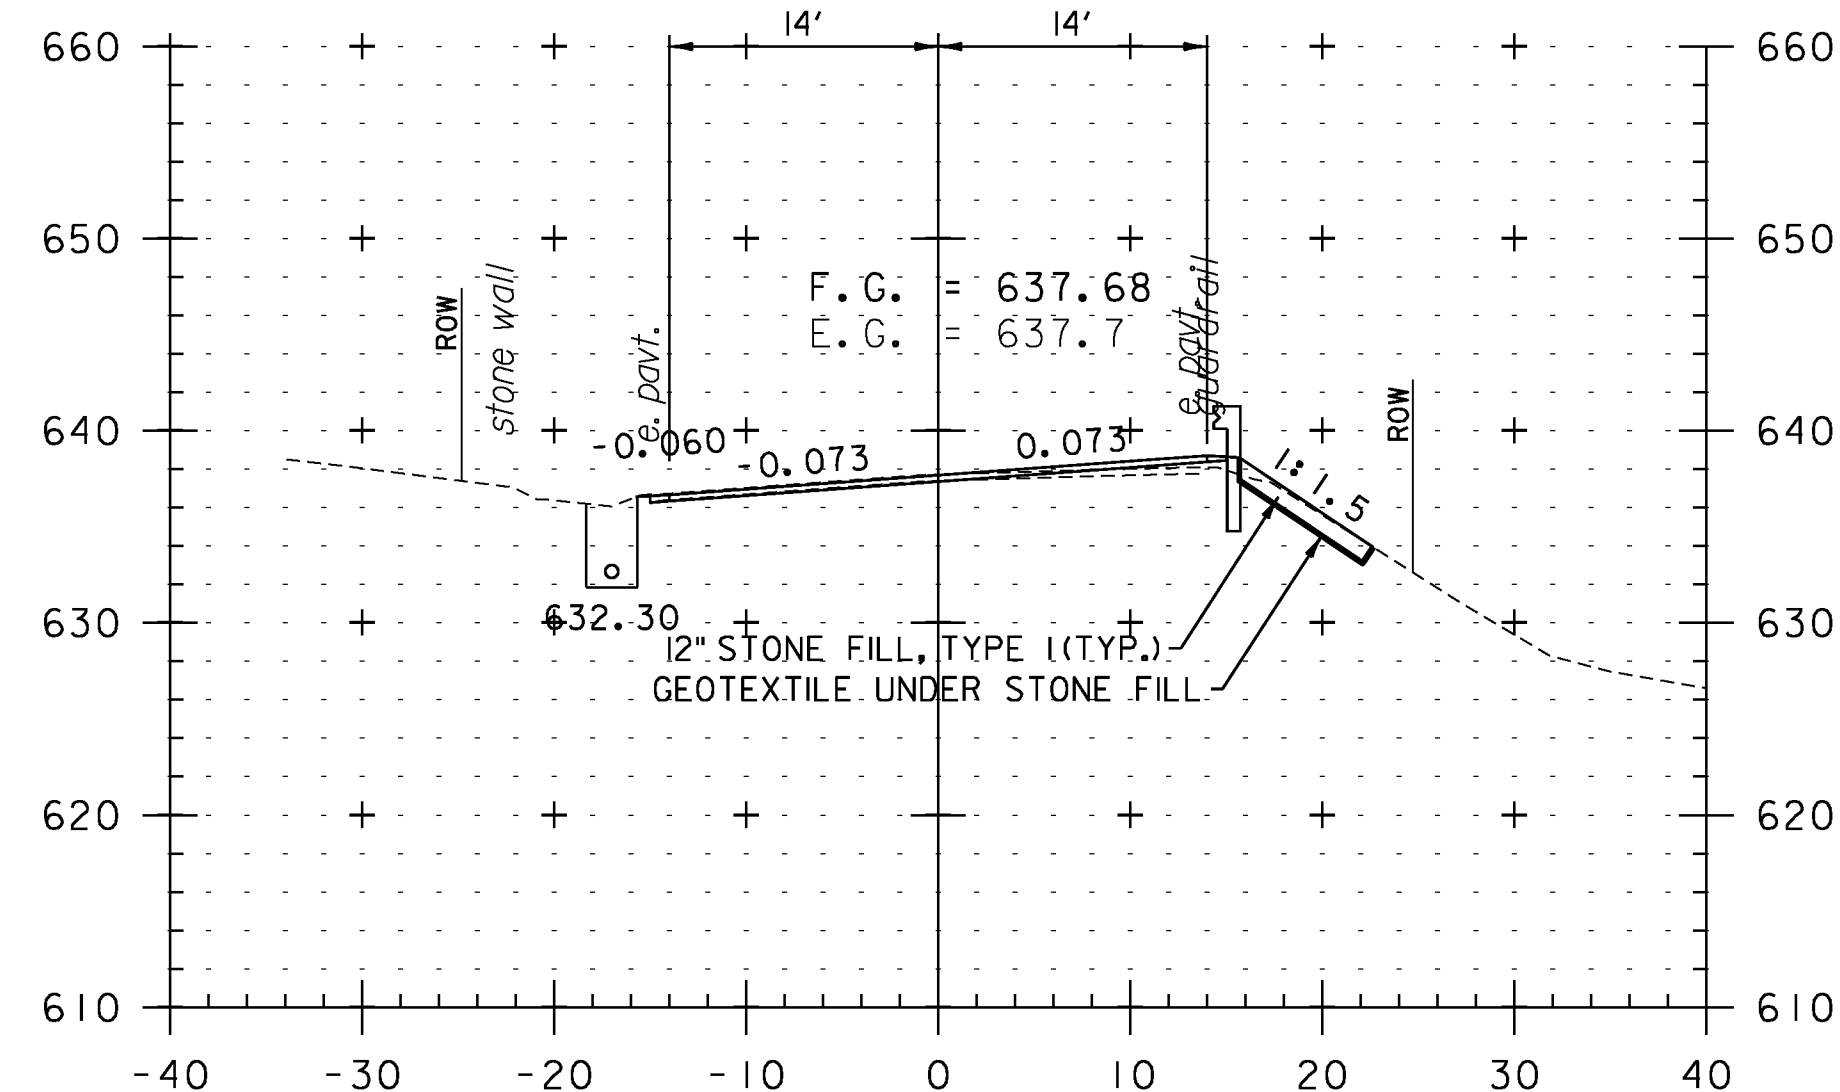

364+50

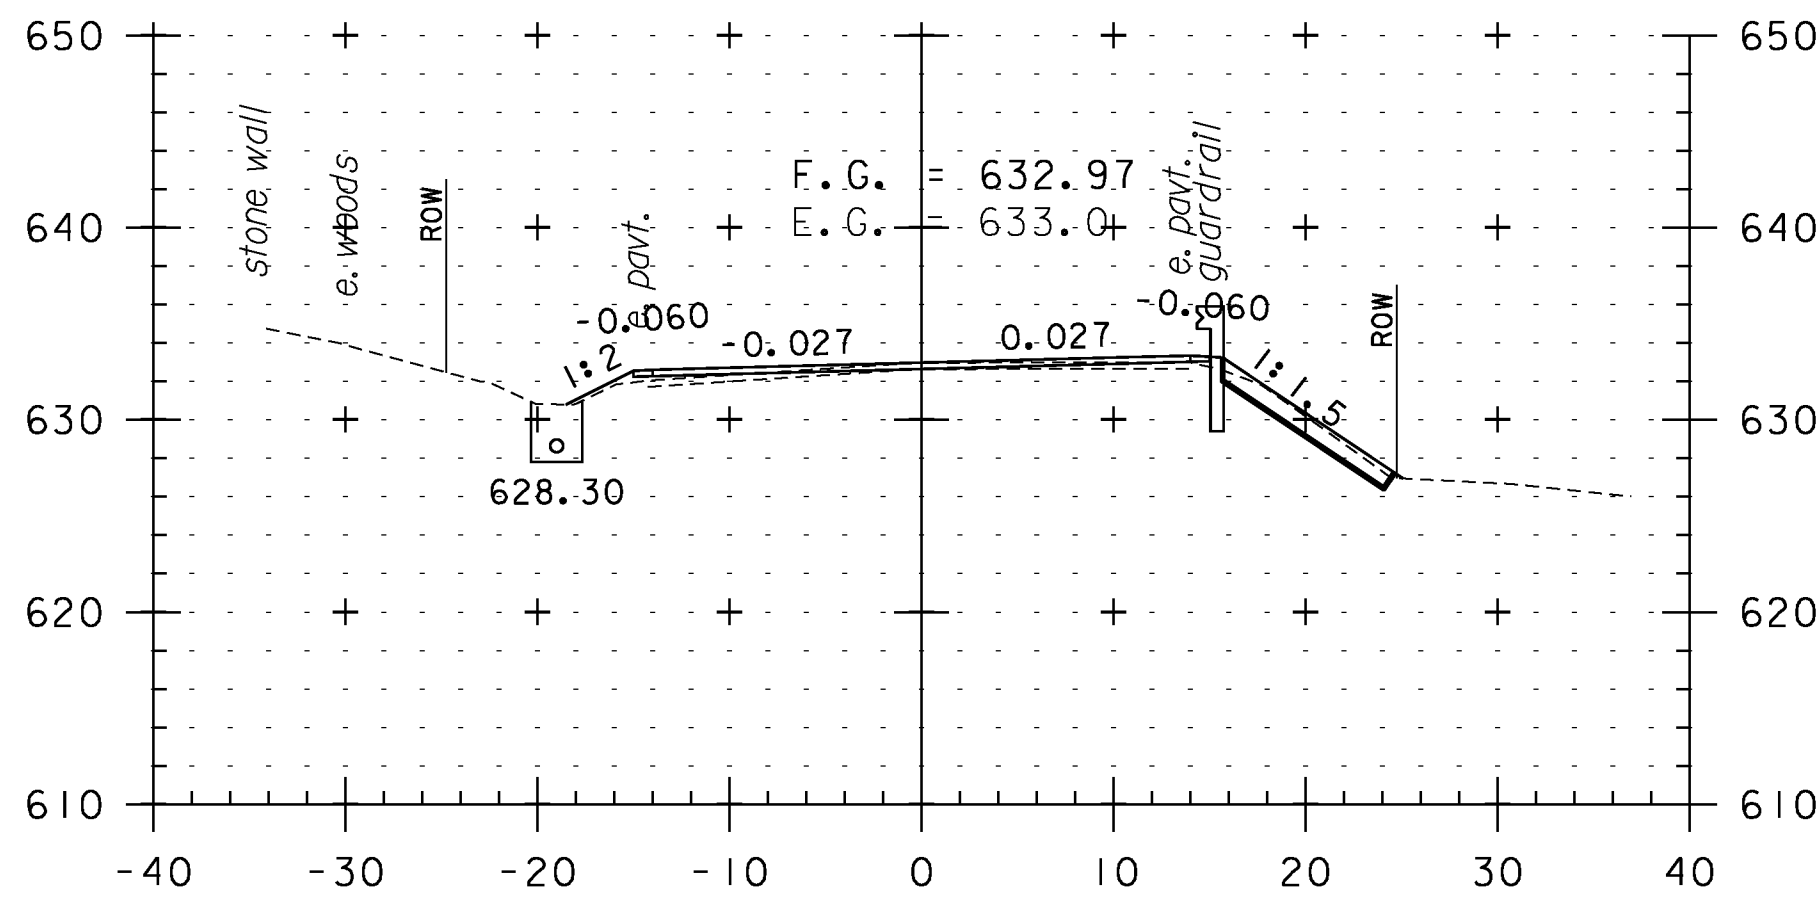

366+00

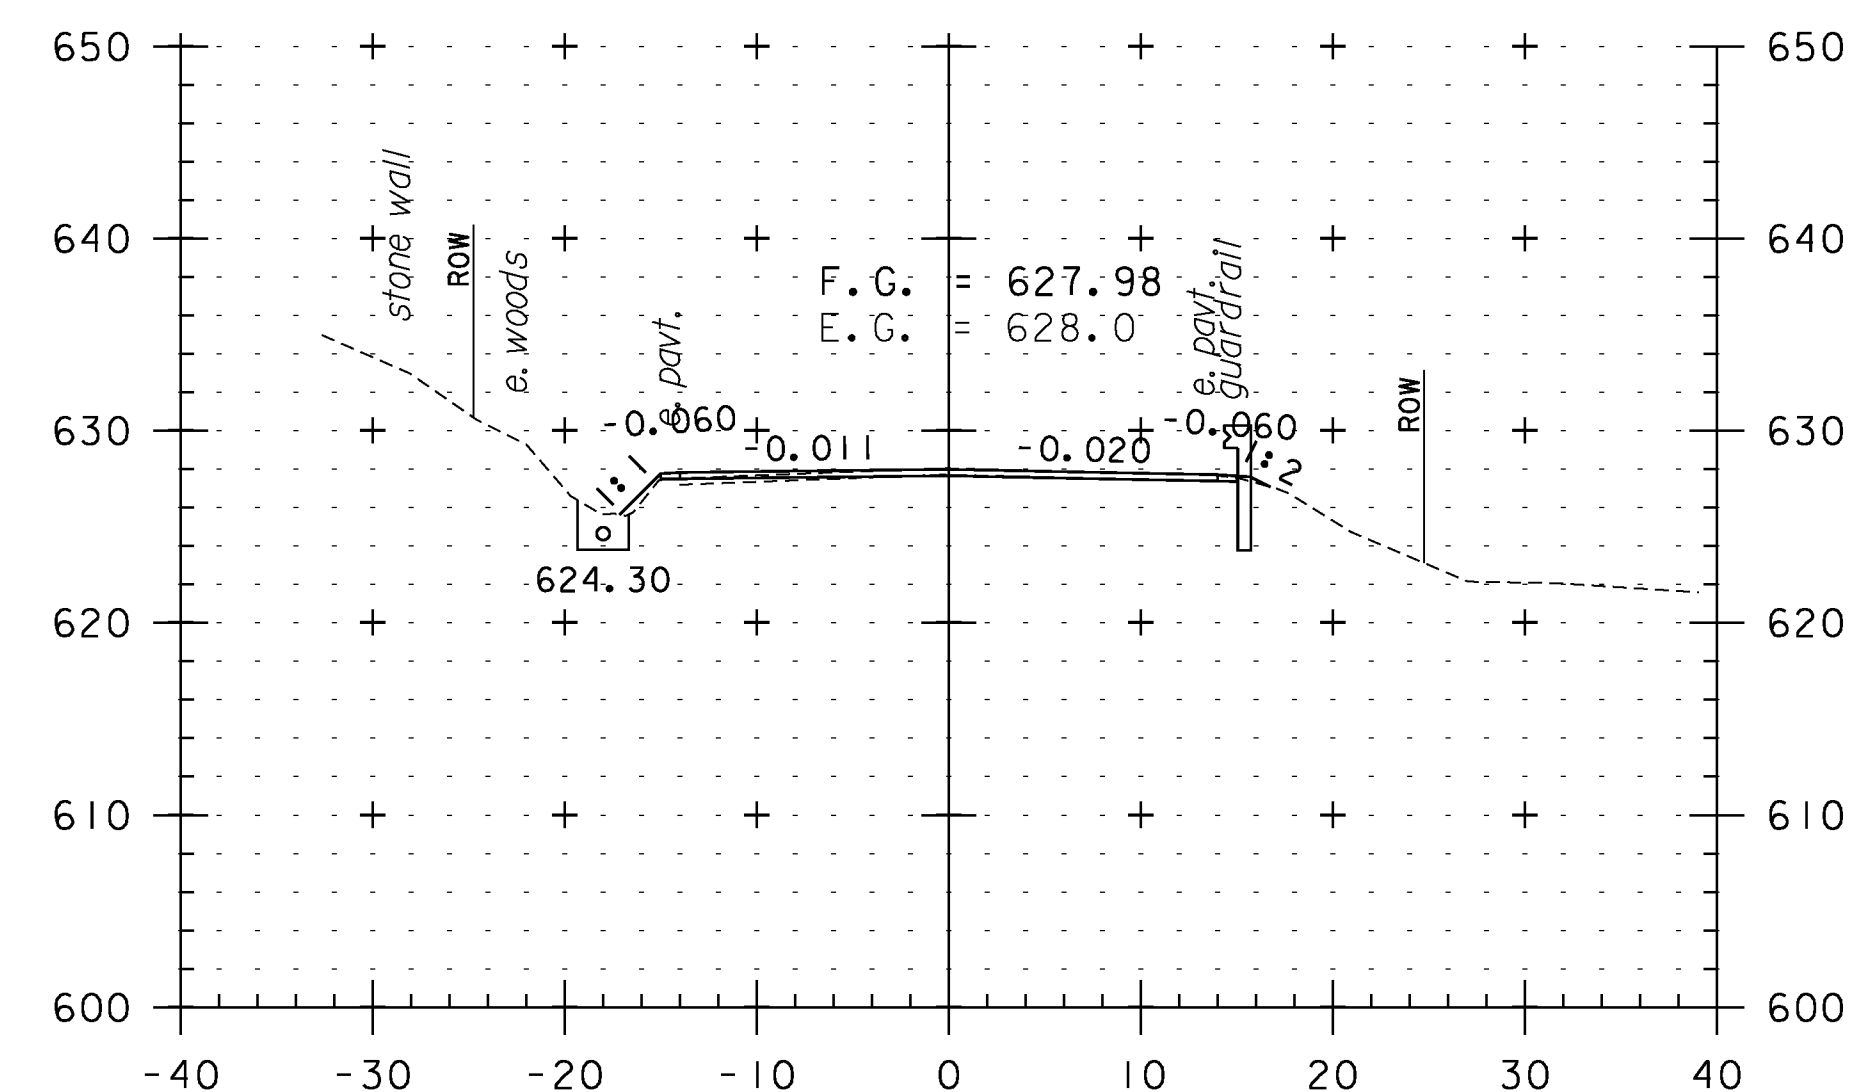

367+50

CROSS SECTION SHEET 71

PROJECT NAME: WEATHERSFIELD	PLOT DATE: 2/7/2013
PROJECT NUMBER: STP 2913(I)	DRAWN BY: WWG
FILE NAME: I0c228	CHECKED BY: PTS
PROJECT LEADER: PTS	SHEET 161 OF 234
DESIGNED BY: NLL	
IPARM FILE NAME: pI0c228_161	



STA. 364+50 TO STA. 368+00